


Breyting á olutanku.  
Jón HEILBRIGDSEFTINGUR  
HAFNARFIJARDUR  
OG KÖRVAOGSSV. DÍS  
Gardatoru 210 Garabæ  
K. Jónsson

C=COVER  
 B=BOTTOM  
 S=SLOPE  
 --- SEWER PIPE  
 --- COLD WATER PIPE  
 --- HOT WATER PIPE  
 --- COMPRESSED AIR PIPE  
 --- PIPE FOR USED OIL

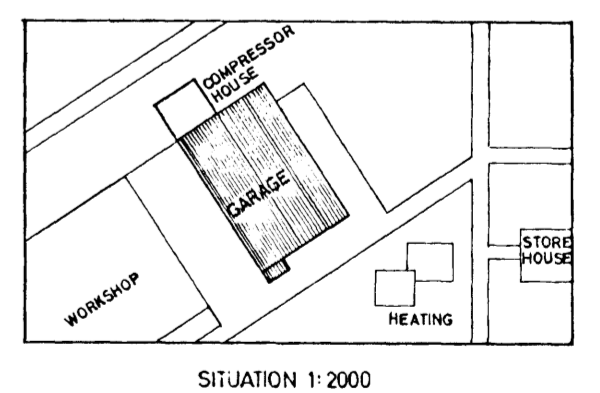

A	18.05.09	Olufutankur fjárlagður, Gringolfutanki batt við	EJ/MST
△	19.2.95	UP TO DATE	RV
△	4.2.70	INSTALLATIONS ADDED	DB
REV. No.	DATUM	REVISION	GEZ GEPR GEN.
<b>ICELANDIC ALUMINIUM COMPANY LTD.</b>			
<b>INSTALLATION DRAWING PIPES</b>		Masstab	Entrust
<b>GARAGE</b>		1:100	30.569 tu
<b>PLAN, SECTIONS</b>		Form	30.569 tu
<b>AS BUILT DRAWING</b>		Form	AO
Projektering: Schweizerische Aluminium AG ZÜRICH		No. löbunr. 150452A	7/10
		150452 IS 58	