



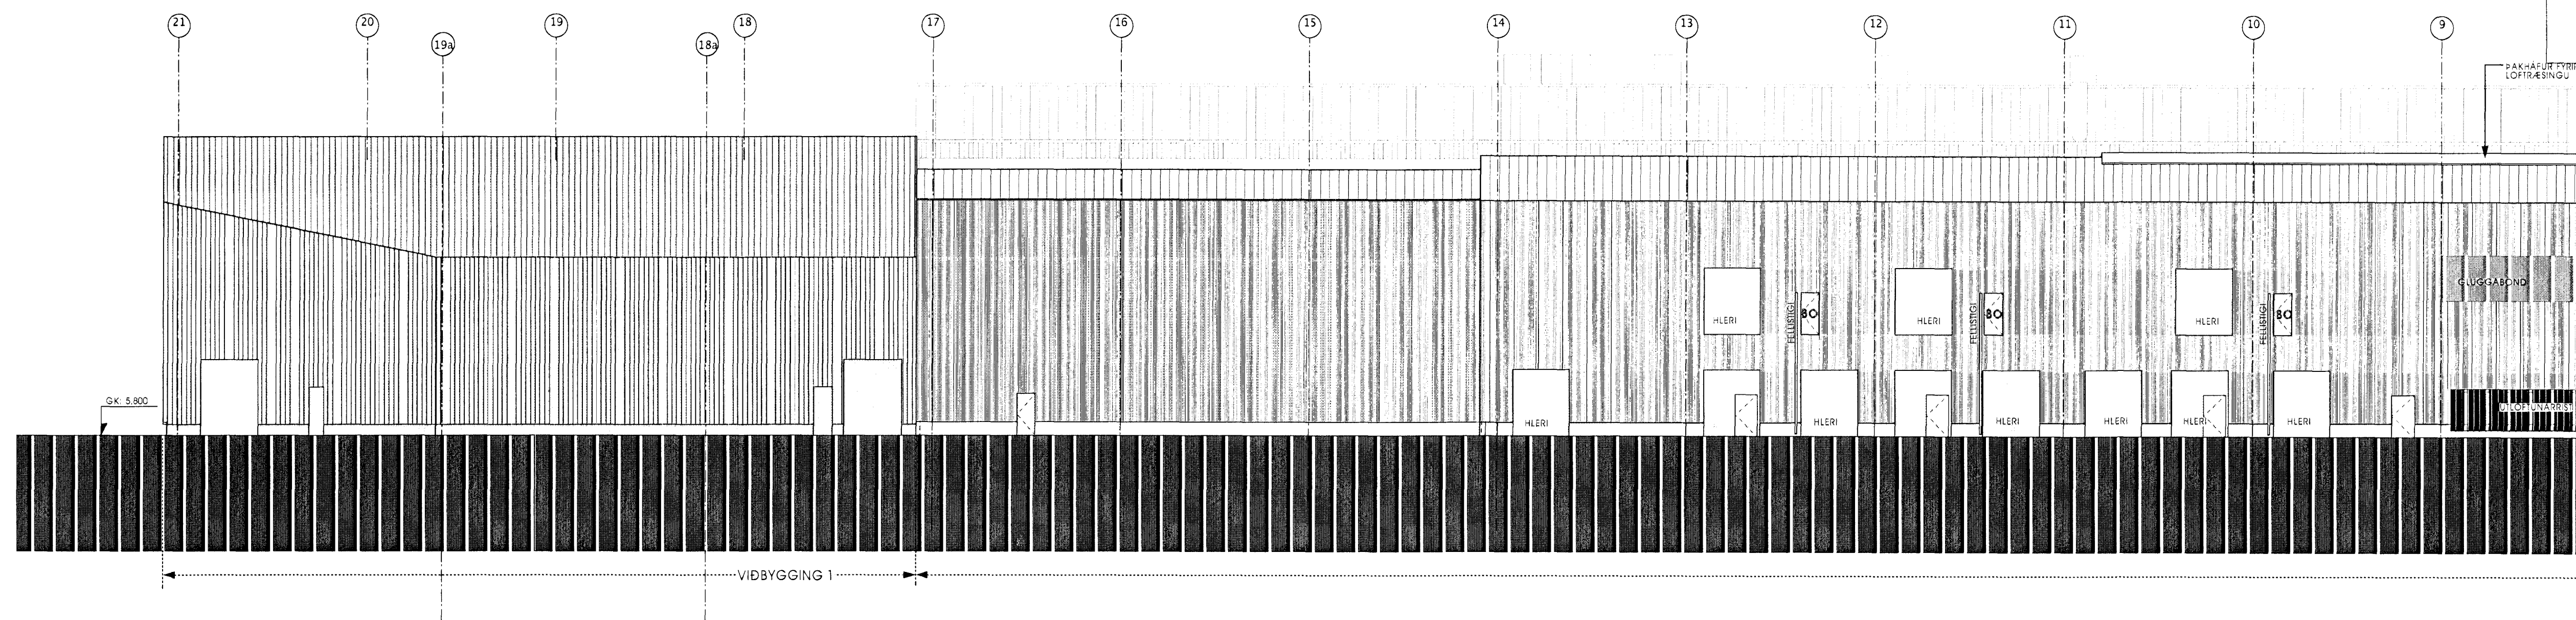


1 ÚTLIT NORÐUR - hluti 1
m.kv. 1:200

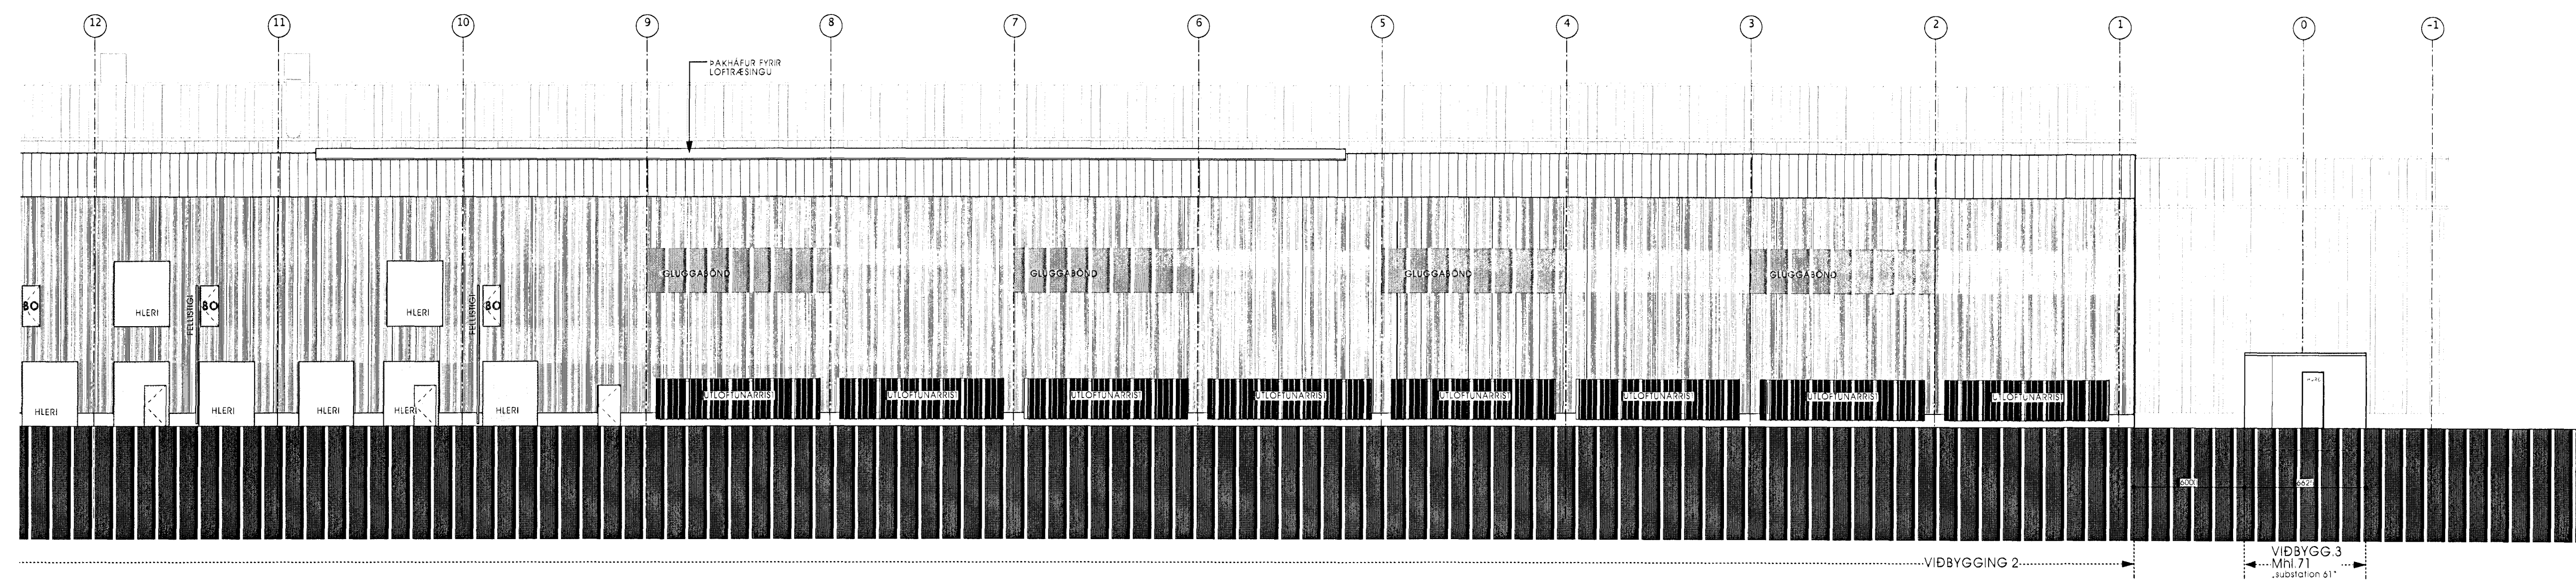


2 ÚTLIT NORÐUR - hluti 2
m.kv. 1:200

ATH:
HK= HÆÐAKÓTAR Á HÆSTU PUNKTUM
VIÐKOMANDI MANNVIRKIS
Í HÆÐARKERFI HAFNARFJARÐAR

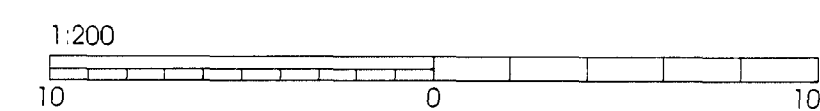


Skýringar:
Legend:

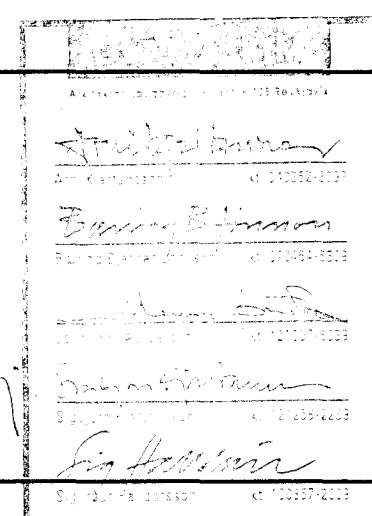

Útg. nr. Rev. no.	Lýsing Description	Dagsetning Date	HafnTón Des/Drw	Yfirl. Ckd	Nok. heim. Suppl. Ref.	Nok. heim. ISAL Ref.
B	AS BUILT	09.03.2012	SK	SK		
A	STÆKKUN Á STEYPUKÁLA HLUTA 1A	18.02.2011	BBJ	SK		

This drawing is the property of
Rio Tinto Alcan Iceland Ltd.
It may neither be copied nor made
available to others without permission of
Rio Tinto Alcan Iceland Ltd.
The receiver is liable for any misuse.
Stærð:
Format: A1
Mkv.:
Scale: 1:200
Dimensions without tolerances
according to ISO 2768-1 medium.

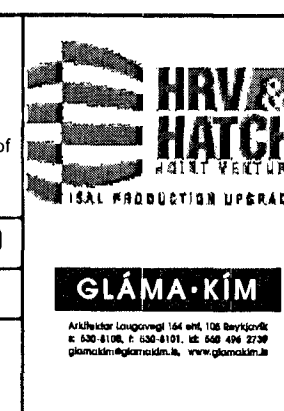

Dagsetning / Date
15.08.2010
Hannað / Designed
SK
Teikn / Drawn
UDM/BBJ
Verktaki / Supplier
GLÁMA-KÍM
Teikn nr. verktaka / Supplier drw. no.
A01.09
Samþykkt / Approved
Yfirl. / Chkd
SK
Hluti af: / Part of:

STÆKKUN STEYPUKÁLANS
ÚTLIT NORÐUR
Tag. teikningar
/ Dwg. type:
ADALUPPDRATTUR
Architectural Building Application
RioTintoAlcan
Alcan Iceland Ltd
Straumsvík
IS-222
Hafnarfirði
Ísland

Flokkur nr.:
Bláð nr.:
Næsta bl. nr.:
Kostn. nr.-Cnó. / Bun.nr.-Eq. no.
6010 01226
AKS
UL1
Teikn. nr. ISAL / Dwg. no. of ISAL
253309
Breyt./Rev.
A
ISAL Yfirfand og skráð, dags / ISAL Checked, date
ISAL Samþykkt, dags / ISAL Approval, date