



1 ÚTLIT VESTUR
mkv. 1:200

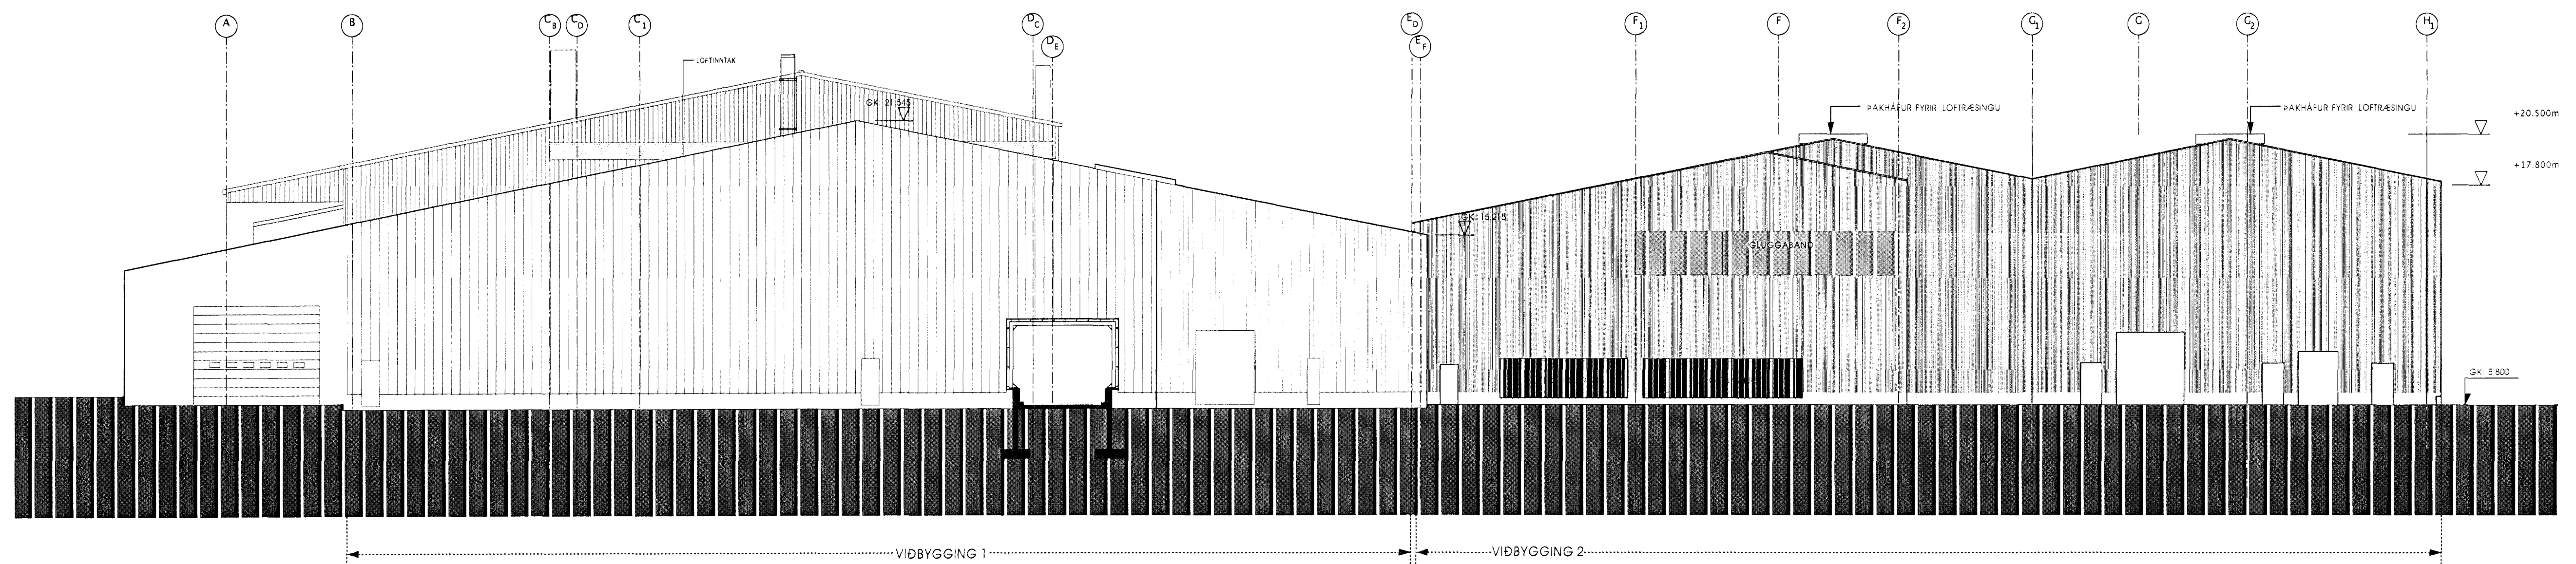


2 ÚTLIT AUSTUR / SNIÐ Í GEGNUM BYGGINGU 1
mkv. 1:200

ATH:
HK= HÆÐAKÓTAR Á HÆSTU PUNKTUM
VIÐKOMANDI MANNVIRKIS
Í HÆÐARKERFI HAFNARFJARÐAR

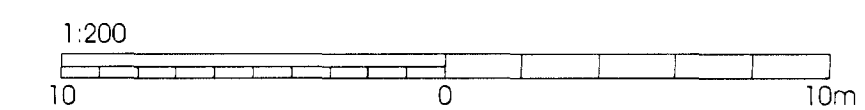

Skýringar:
Legend:

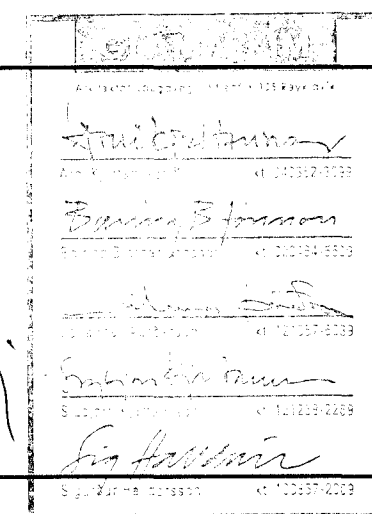

This drawing is the property of Rio Tinto Alcan Iceland Ltd. and handed out for personal use only. It may neither be copied nor made available to others without permission of Rio Tinto Alcan Iceland Ltd. The receiver is liable for any misuse.				
B	AS BUILT	09.03.2012	SK	SK
A	STÆKKUN Á STEYPUSKÁLA HLUTA 1A	18.02.2011	BBJ	SK
Dwg nr / Rev.no	Lýsing / Description	Dagsetning / Date	Höfundur / Des.Dwg	Yfir / Clid

HRVA HATCH
ISAL PRODUKTION UPRÁTTI

GLÁMA-KÍM

Dagsetning / Date: 15.06.2010
 Hönnuð / Designed: SK
 Teikni / Drawn: UDM/BBJ
 Verktaki / Supplier: **GLÁMA-KÍM**
 Teikn.nr verktaka / Supplier drw.no: **A01.08**
 Samþykkt / Approved: Yfir / Clid: SK

STÆKKUN STEYPUSKÁLANS
ÚTLIT AUSTUR OG VESTUR

Teikningar / Dwg. type: **ADALUPPDRÁTTUR**
Architectural Building Application

RioTinto Alcan

Frakkur nr. / Blað nr.: Næsta bl. nr.:
 Kostn.nr.-Corti. / Búnafr.Eq.no: 6010 01226
 AKS
 UL1
 Teikn.nr. ISAL / Drw.no of ISAL: 253308
 Breyti/Rev: A

ISAL Yfirfarið og skráð, dags / ISAL Checked, date
 ISAL Samþykkt, dags / ISAL Approval, date