


Samþykkt þann  
03 MAY 2012  
Þingingafulltrúinn í Hafnarfirði  
Fh. Sigurður Steinar Jónsson

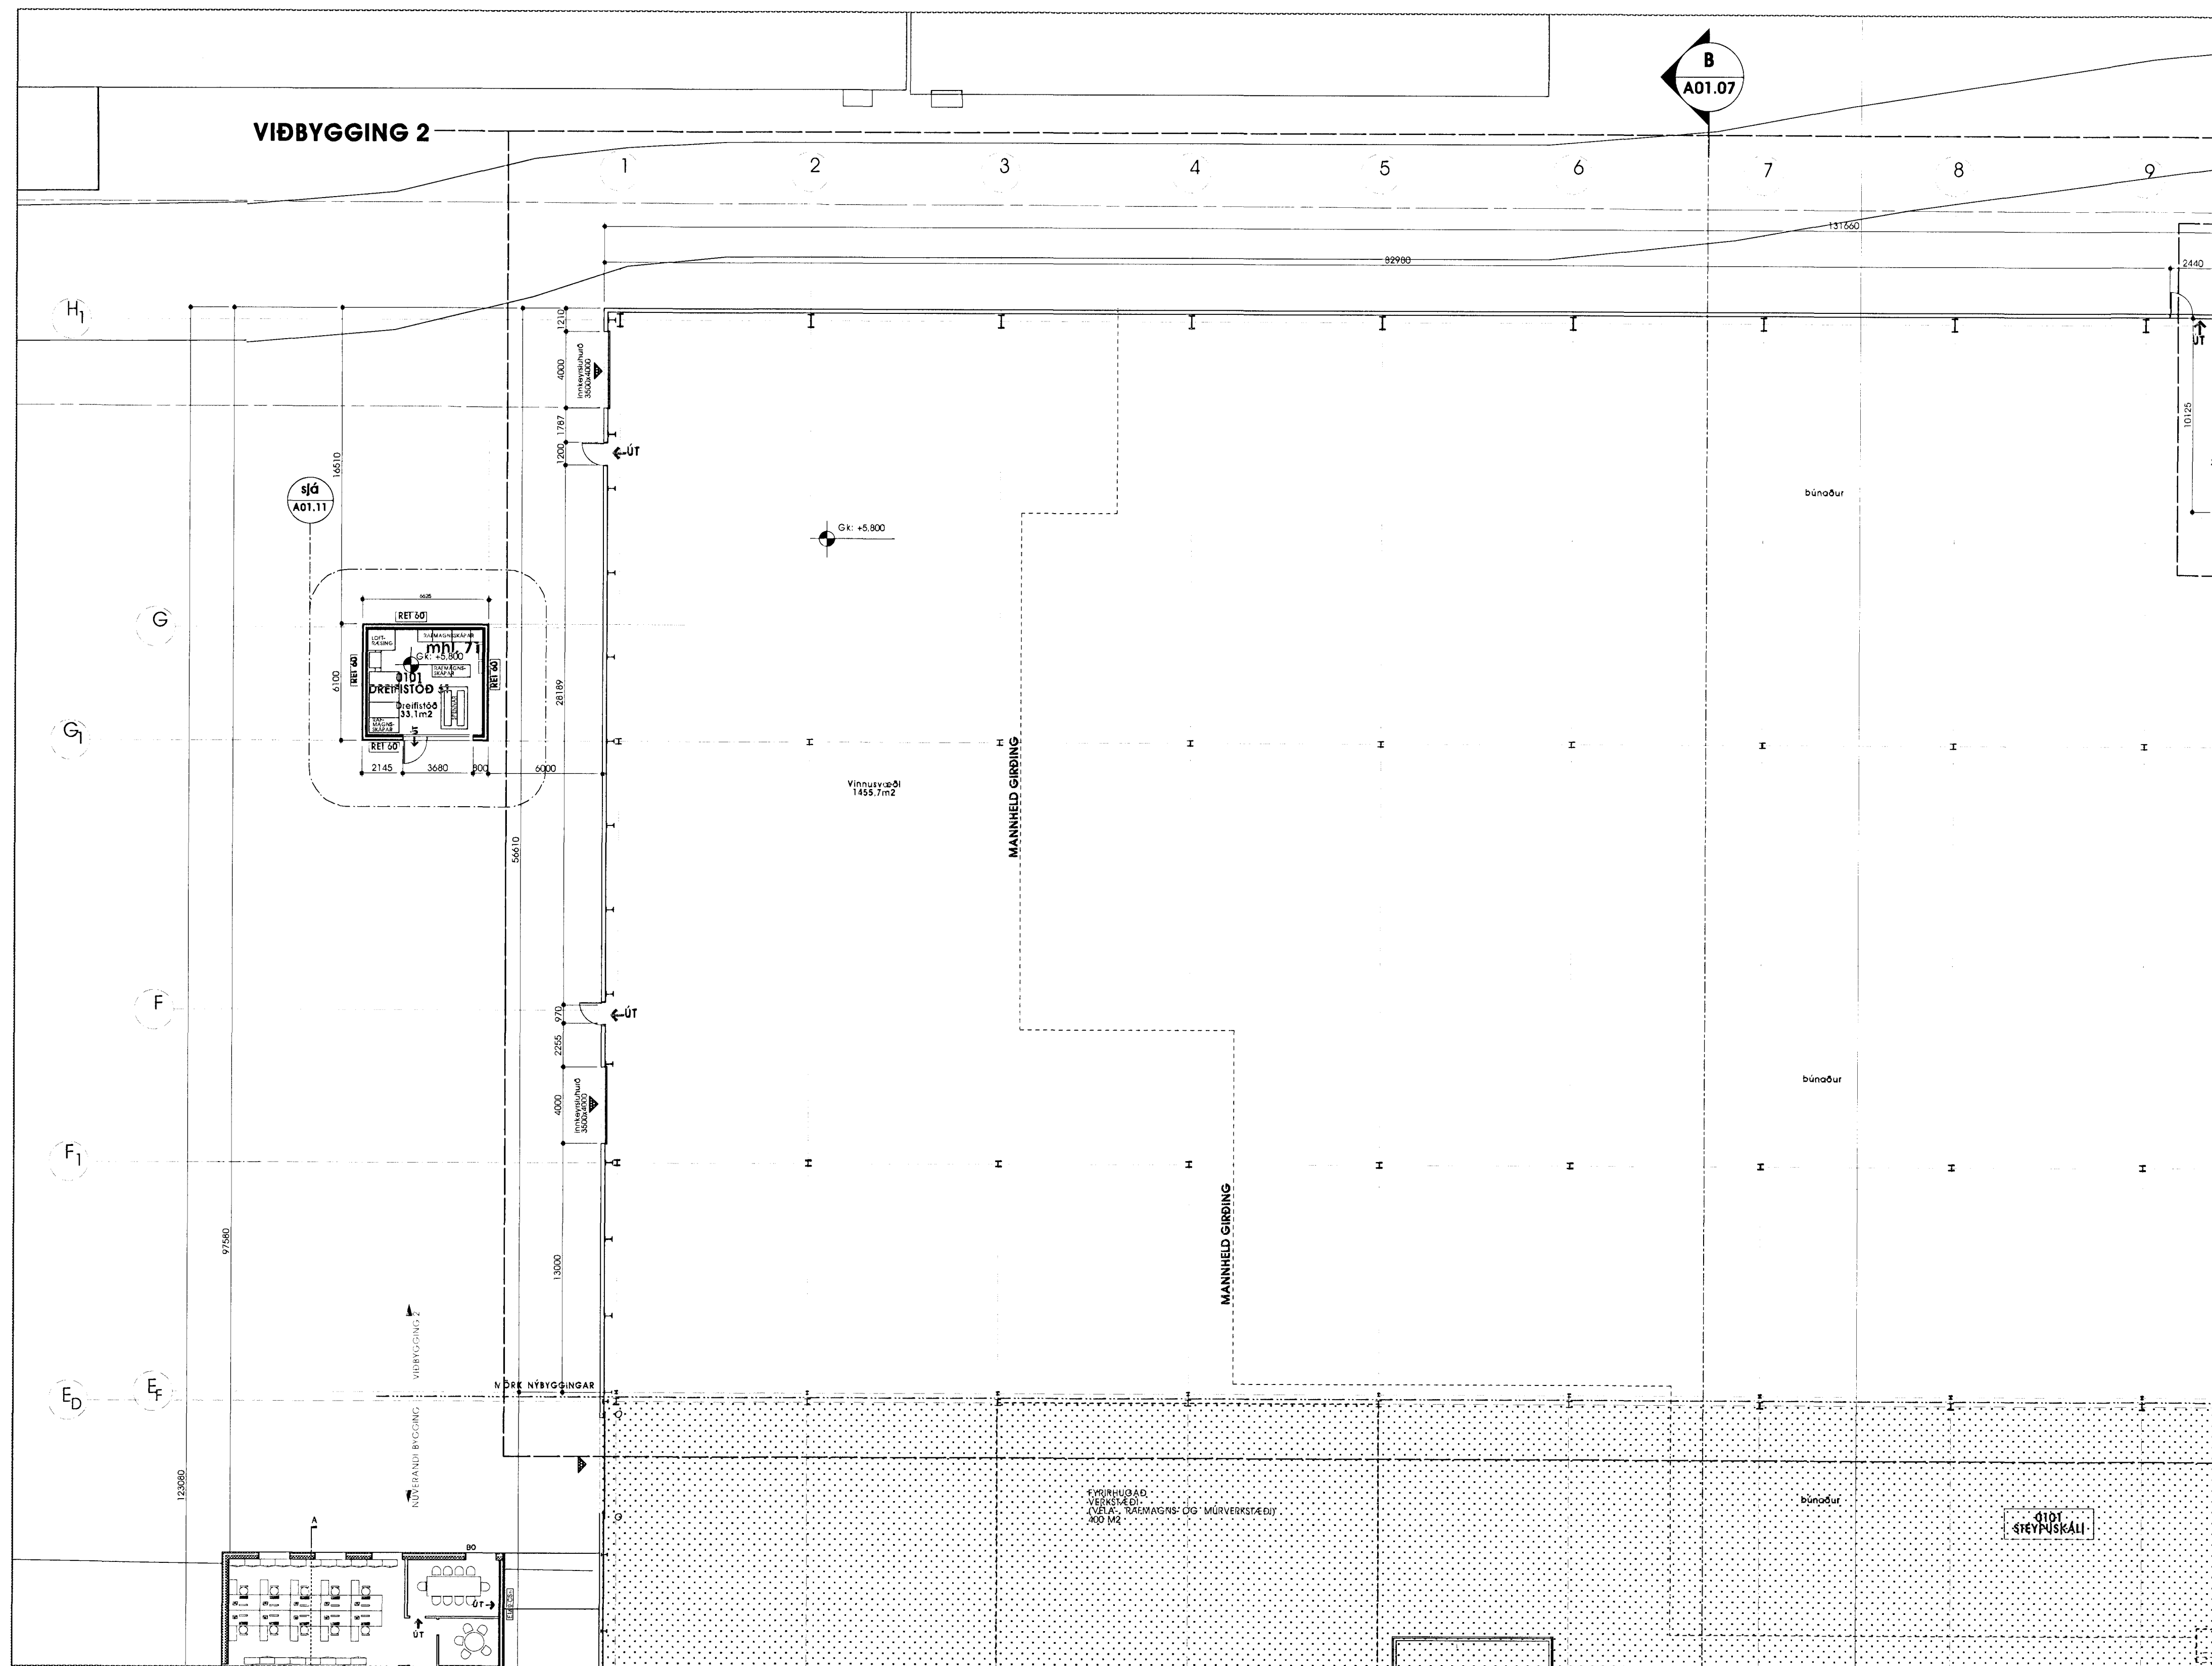

**1 GRUNNMYND 1.HÆÐ - VIBBYGGING 2 - HLUTI 1**  
mkv. 1:200

3.4.2012  
HELBRIGDISEFTRILITS  
HAFNARHÁNDAR-  
OG RÖNNVAGSSVÆDIS  
Gæðastofa 7 - 210 Garðabæ  
*P. Stefánsson*

28.03.2012  
*AI*

Skýringar: Legend:		This drawing is the property of Rio Tinto Alcan Iceland Ltd. and handed out for personal use only. It may neither be copied nor made available to others without permission of Rio Tinto Alcan Iceland Ltd. The receiver is liable for any misuse. Sheet: <b>A1</b> / Mkv.: 1:200 Dimensions without tolerances according to ISO 2768-1 medium.					Dagsetning / Date 15.08.2010 Hönnað / Designed SK Verktaki / Supplier GLÁMA-KÍM		Stækkun Steypuskálans GRUNNMYND 1.HÆÐ - VIBBYGGING 2 1. HLUTI		Flokkur nr.: 6010	Blað nr.: 01226	Næsta bl.:
		Verktaki / Supplier GLÁMA-KÍM		Tökn nr. / Dwg. type A01.05		Tökn nr. / Dwg. type ADALUPPRÁTTUR Architectural Building Application		Tökn nr. / Dwg. no. of ISAL 253305	Breyt./Rev. A				
A As built		09.03.2012	SK	SK	Notk heim ISAL Rel	Hluti af / Part of:	ISAL Yfirfand og skráð, dags / ISAL Checked, date ISAL Samþykkt, dags / ISAL Approval, date						