



Samþykkt hann
 03 MAY 2012
 Byggingafulltrúinn / Hafi...
 E.h. Sigurður Steinar Jónsson

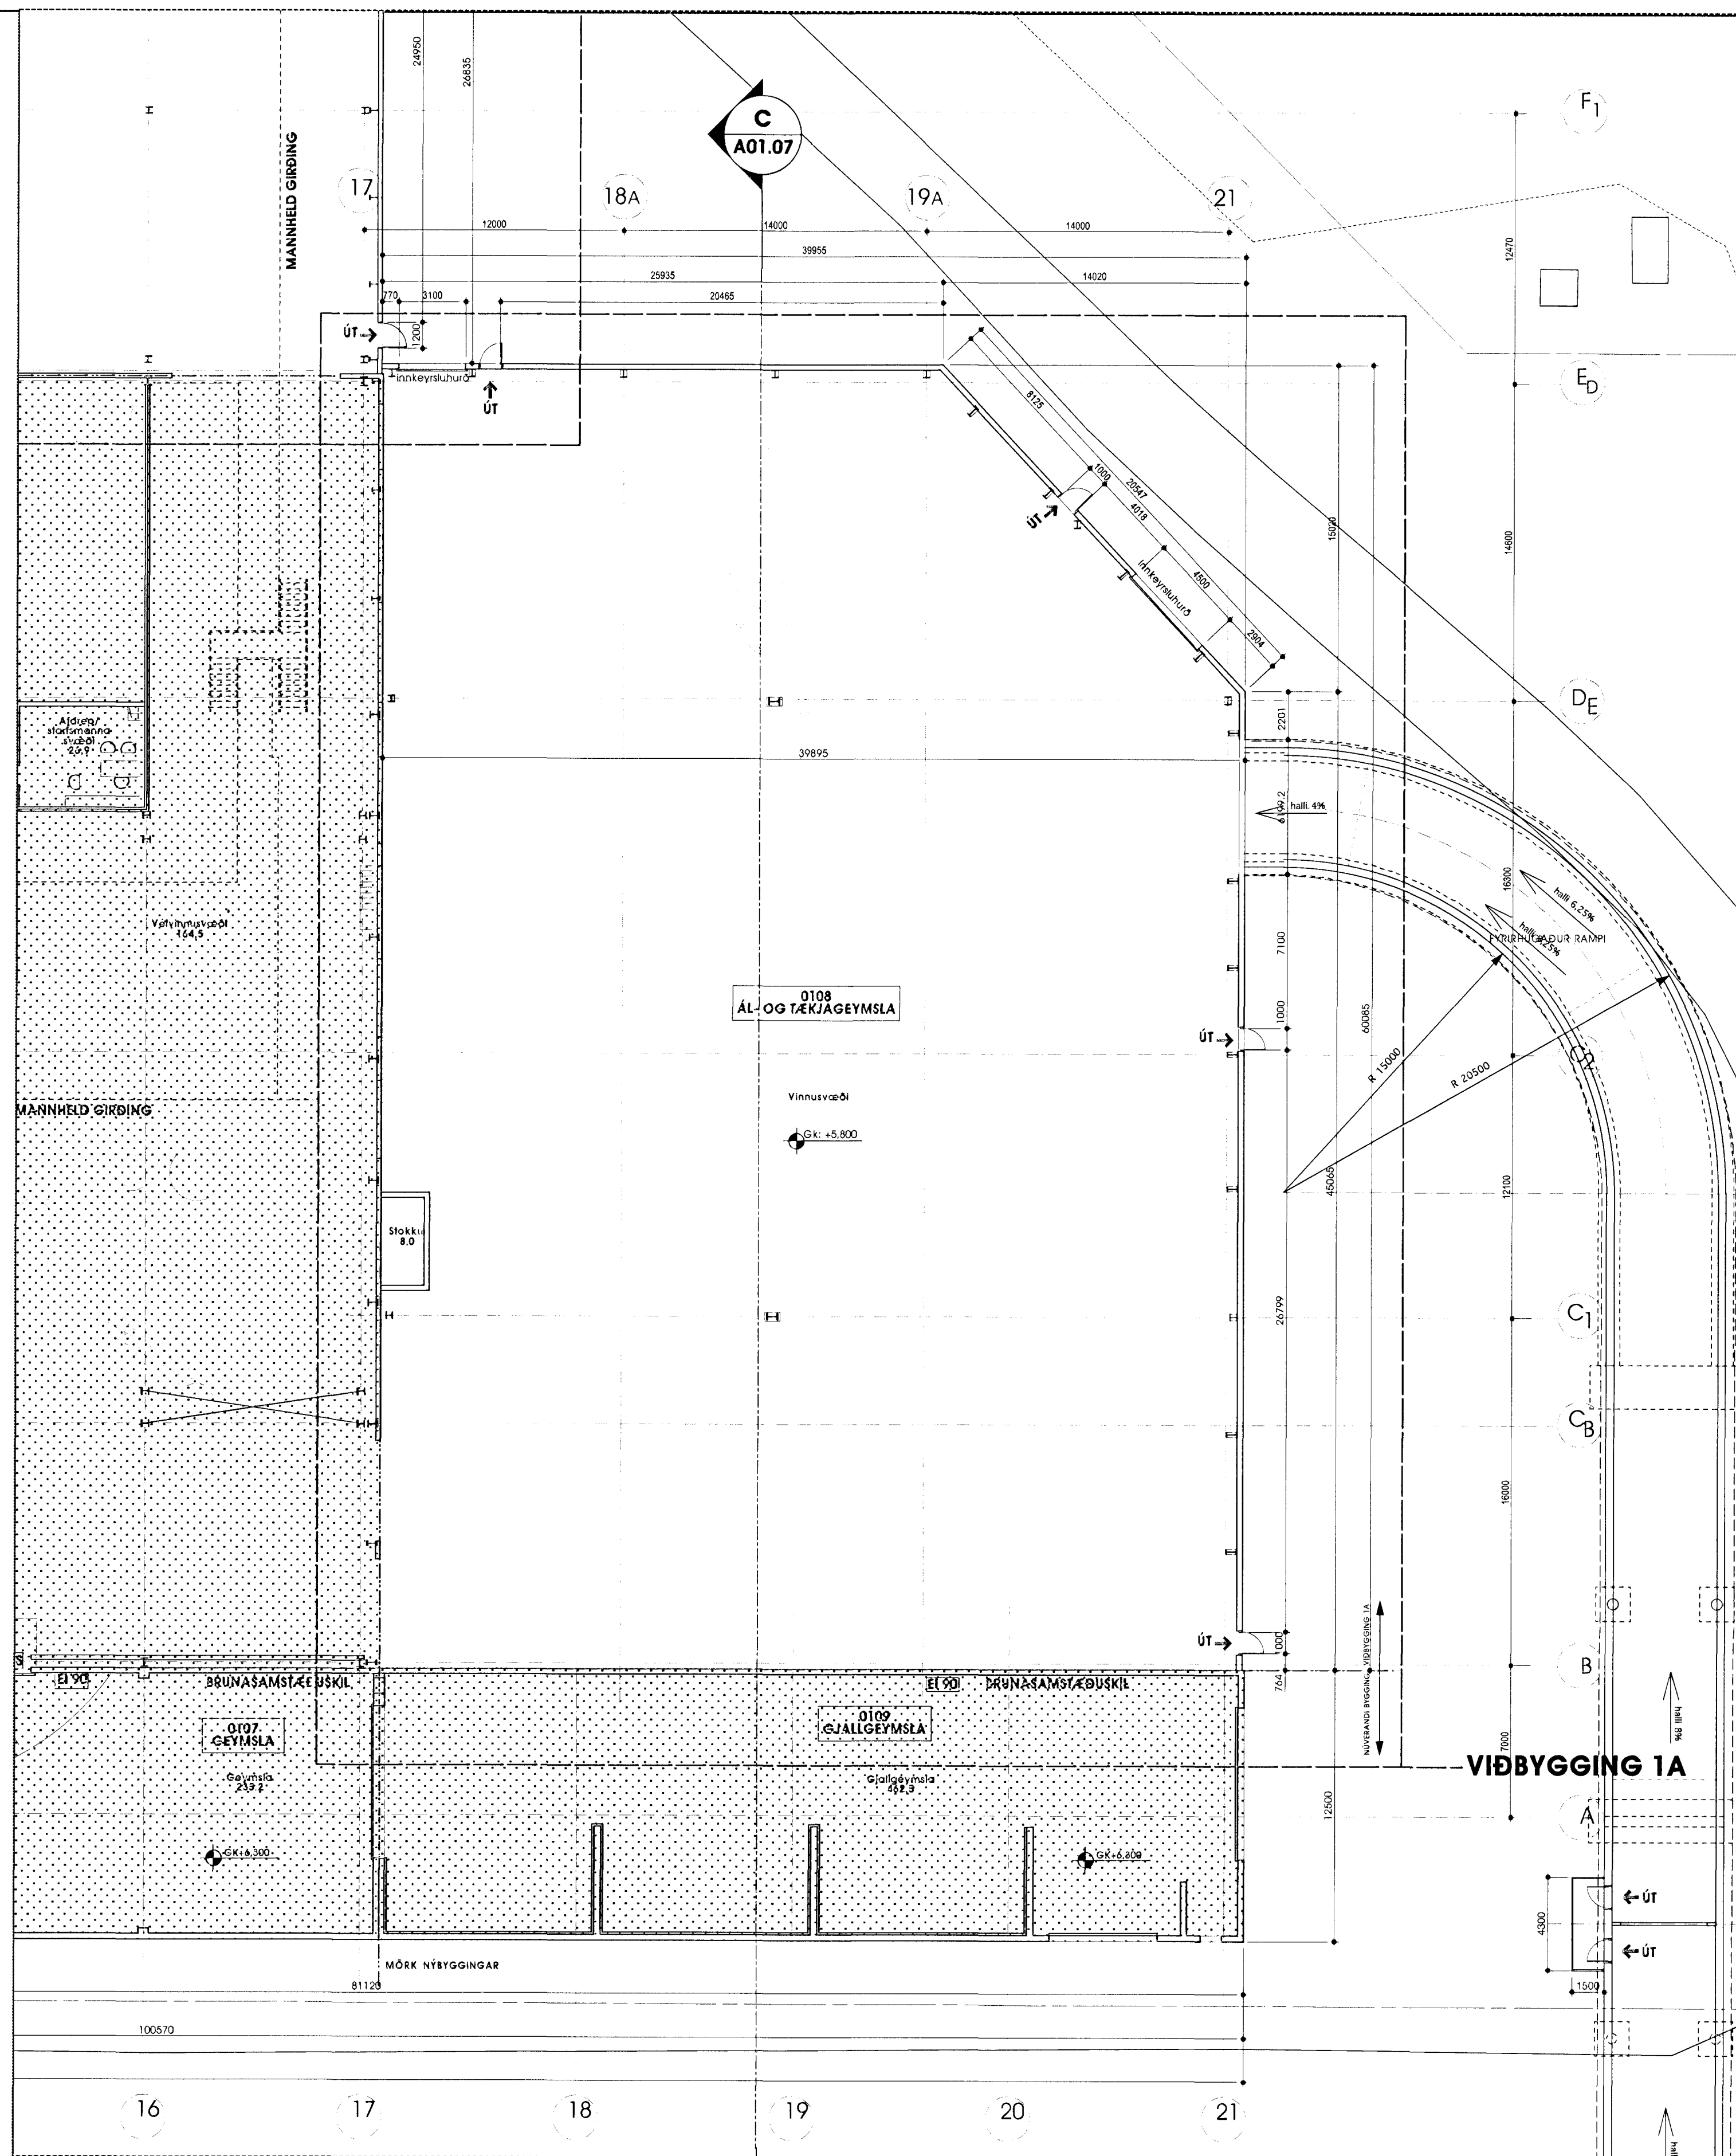

1 GRUNNMYND VIÐBYGGING 1A
 mkv. 1:200

24.03.2012
 HELMIGDISEFTURLIÐ
 HÆNARHÁRDAR-
 OG KORAVOKSVAÐIS
 Garðstorg 7 - 110 Garðabý
 Hauksson

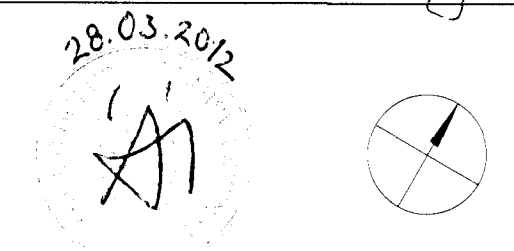

Skýringar:
 Legend:

C:\Users\lilja\Desktop\As built teikningahaus.dwg

Sigurður Steinar Jónsson
 41-10297-229

Fig. nr. / Rev. no.	Description	Dagsetning / Date	Han/Tkn / Des/Drw	Yfir / Chkd	Nótk. heim / Suppl. Rel.	Nótk. heim / ISAL Rel.
1A	STÆKKUN Á STEYPUKÁLA HLUTA 1A	18.02.2011	BBJ	SK		
1B	As built	09.03.2012	SK	SK		

This drawing is the property of Rio Tinto Alcan Iceland Ltd and handed out for personal use only. It may neither be copied nor made available to others without permission of Rio Tinto Alcan Iceland Ltd. The receiver is liable for any misuse.
 Stærð / Format: A1 Mkv. / Scale: 1:200
 Dimensions without tolerances according to ISO 2768-1 medium.



Dagsetning / Date	15.06.2010
Hannað / Designed	SK
Teikn / Drawn	UDM/BBJ
Verktaki / Supplier	GLÁMA-KÍM
Teikn.nr./verktaka / Supplier dwn.no.	A01.04
Samþykkt / Approved	Yfir / Chkd SK
Hluti af / Part of:	

STÆKKUN STEYPUKÁLANS
 GRUNNMYND - VIÐBYGGING 1A
RioTintoAlcan
 ISAL Alcan Iceland Ltd
 Sýrumsvík
 IS-222 Hafnarfjörður
 Iceland

Flokkur nr. / Class no.	6010
Bláð nr. / Bun. nr. / Eq. no.	01226
Teikn nr. / ISAL / Dwn. no. of ISAL	253304
Breyt. / Rev.	A