




Samþykkt þann
 04 APR 2012
 Byggingafulltrúinn / Hafnarfrófi
 Fh. Sigurður Steinar Jónsson

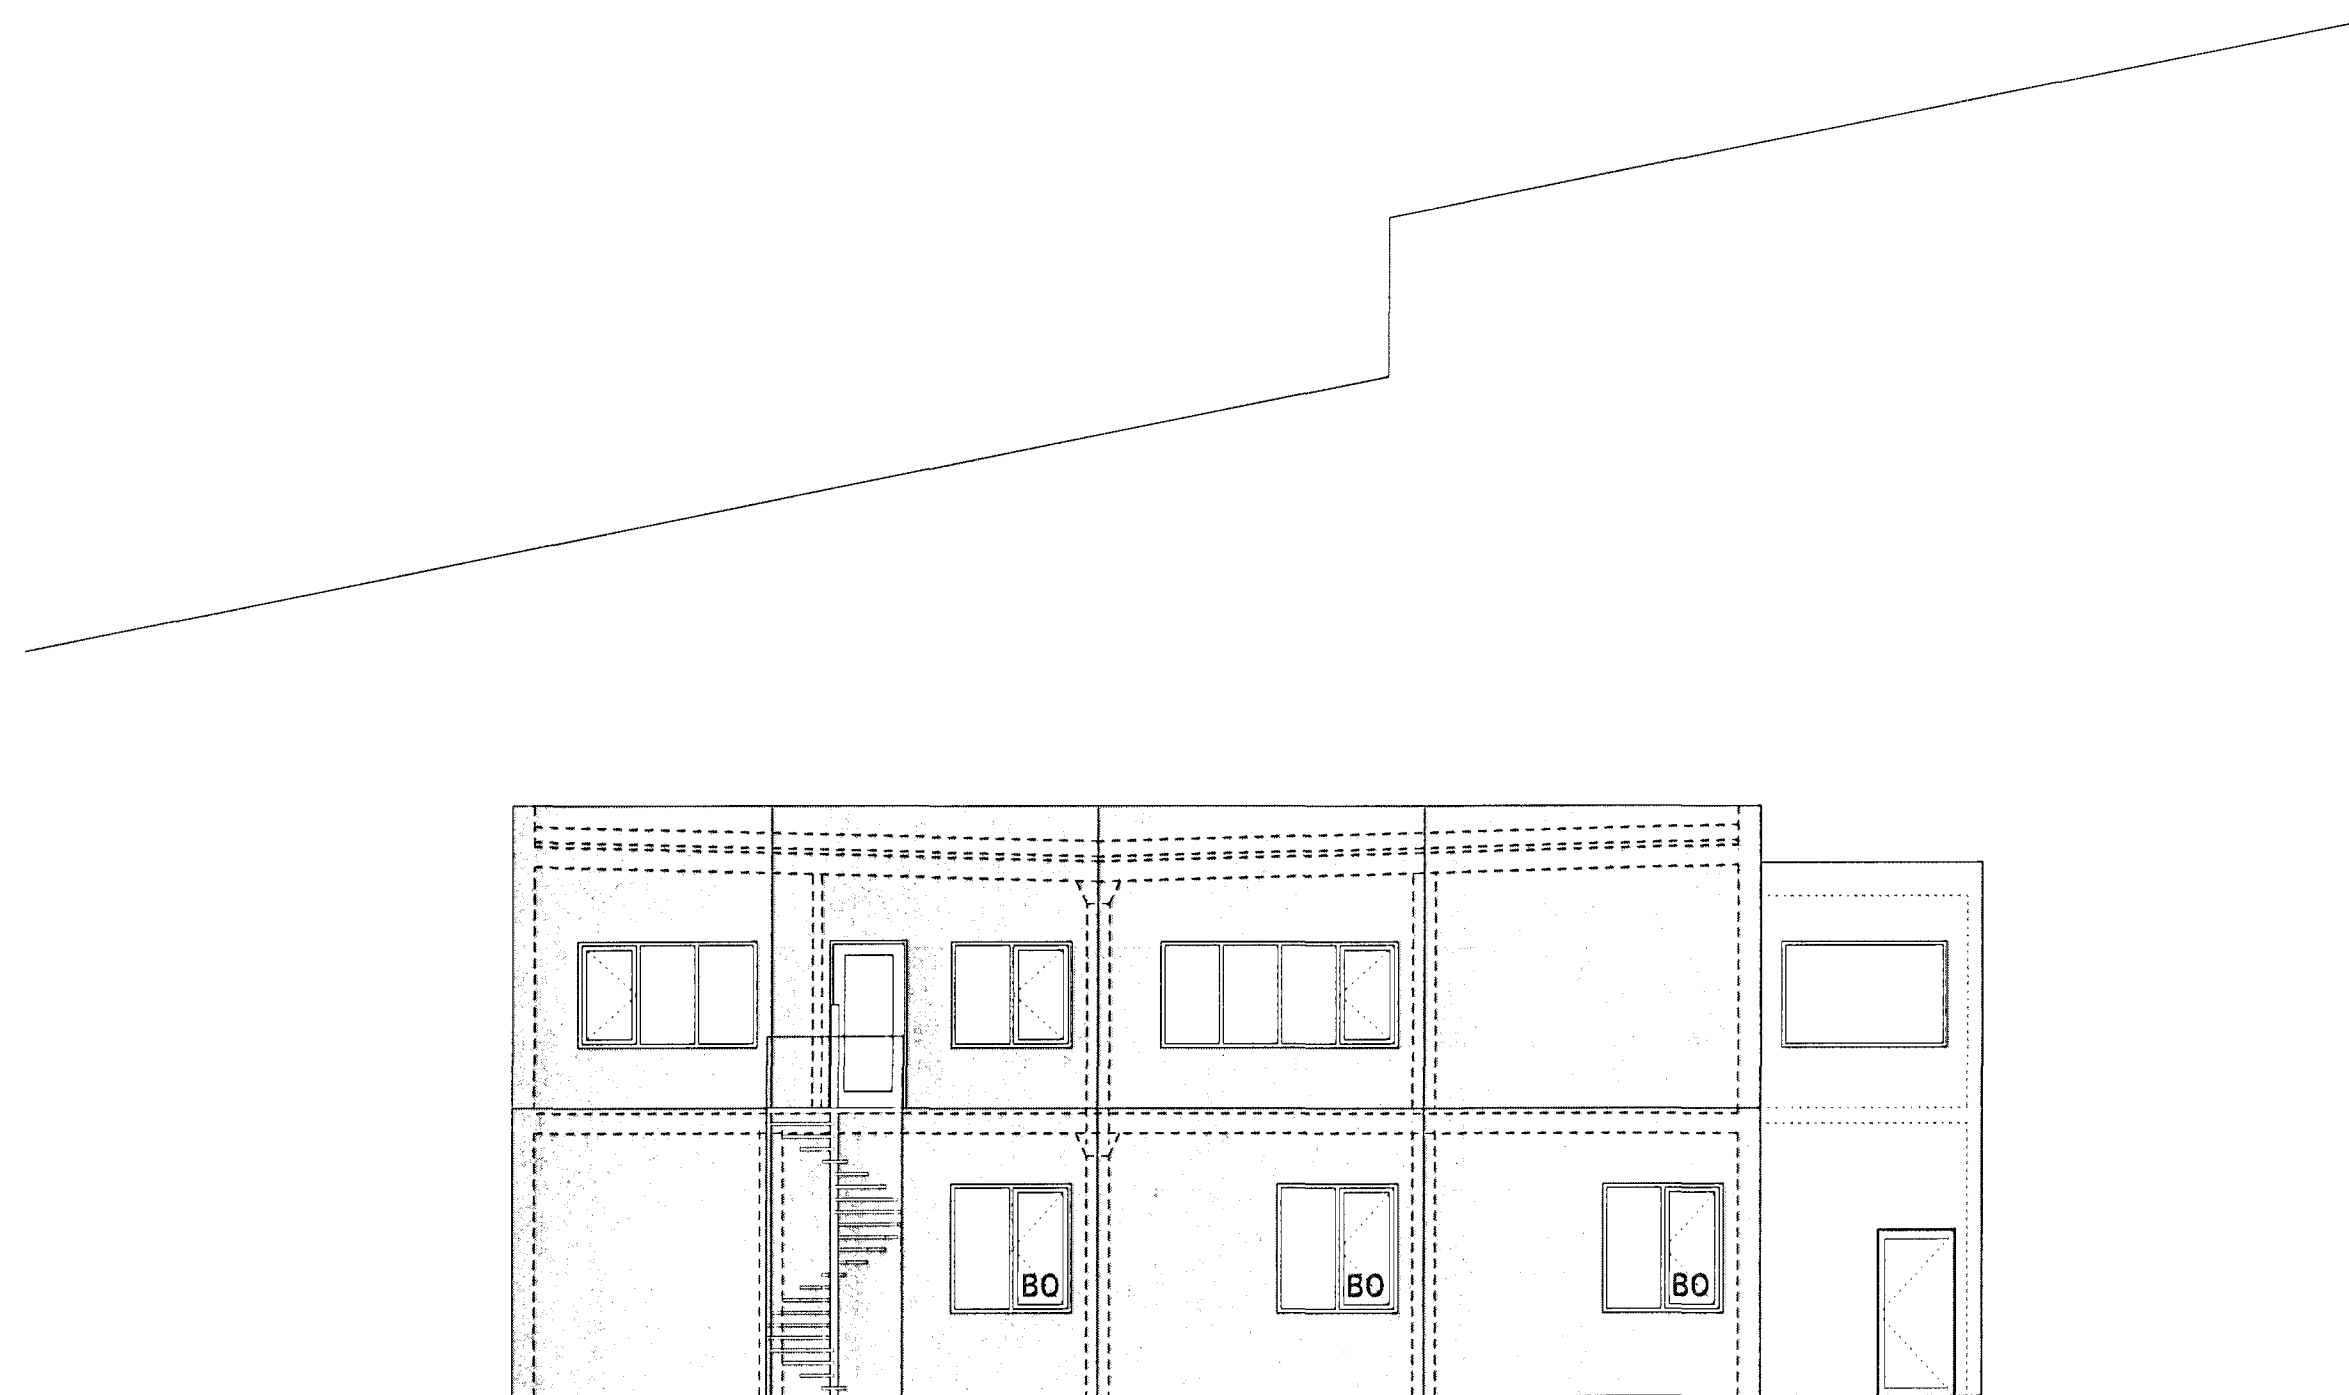


1 ÚTLIT VESTUR
 mkv. 1:100

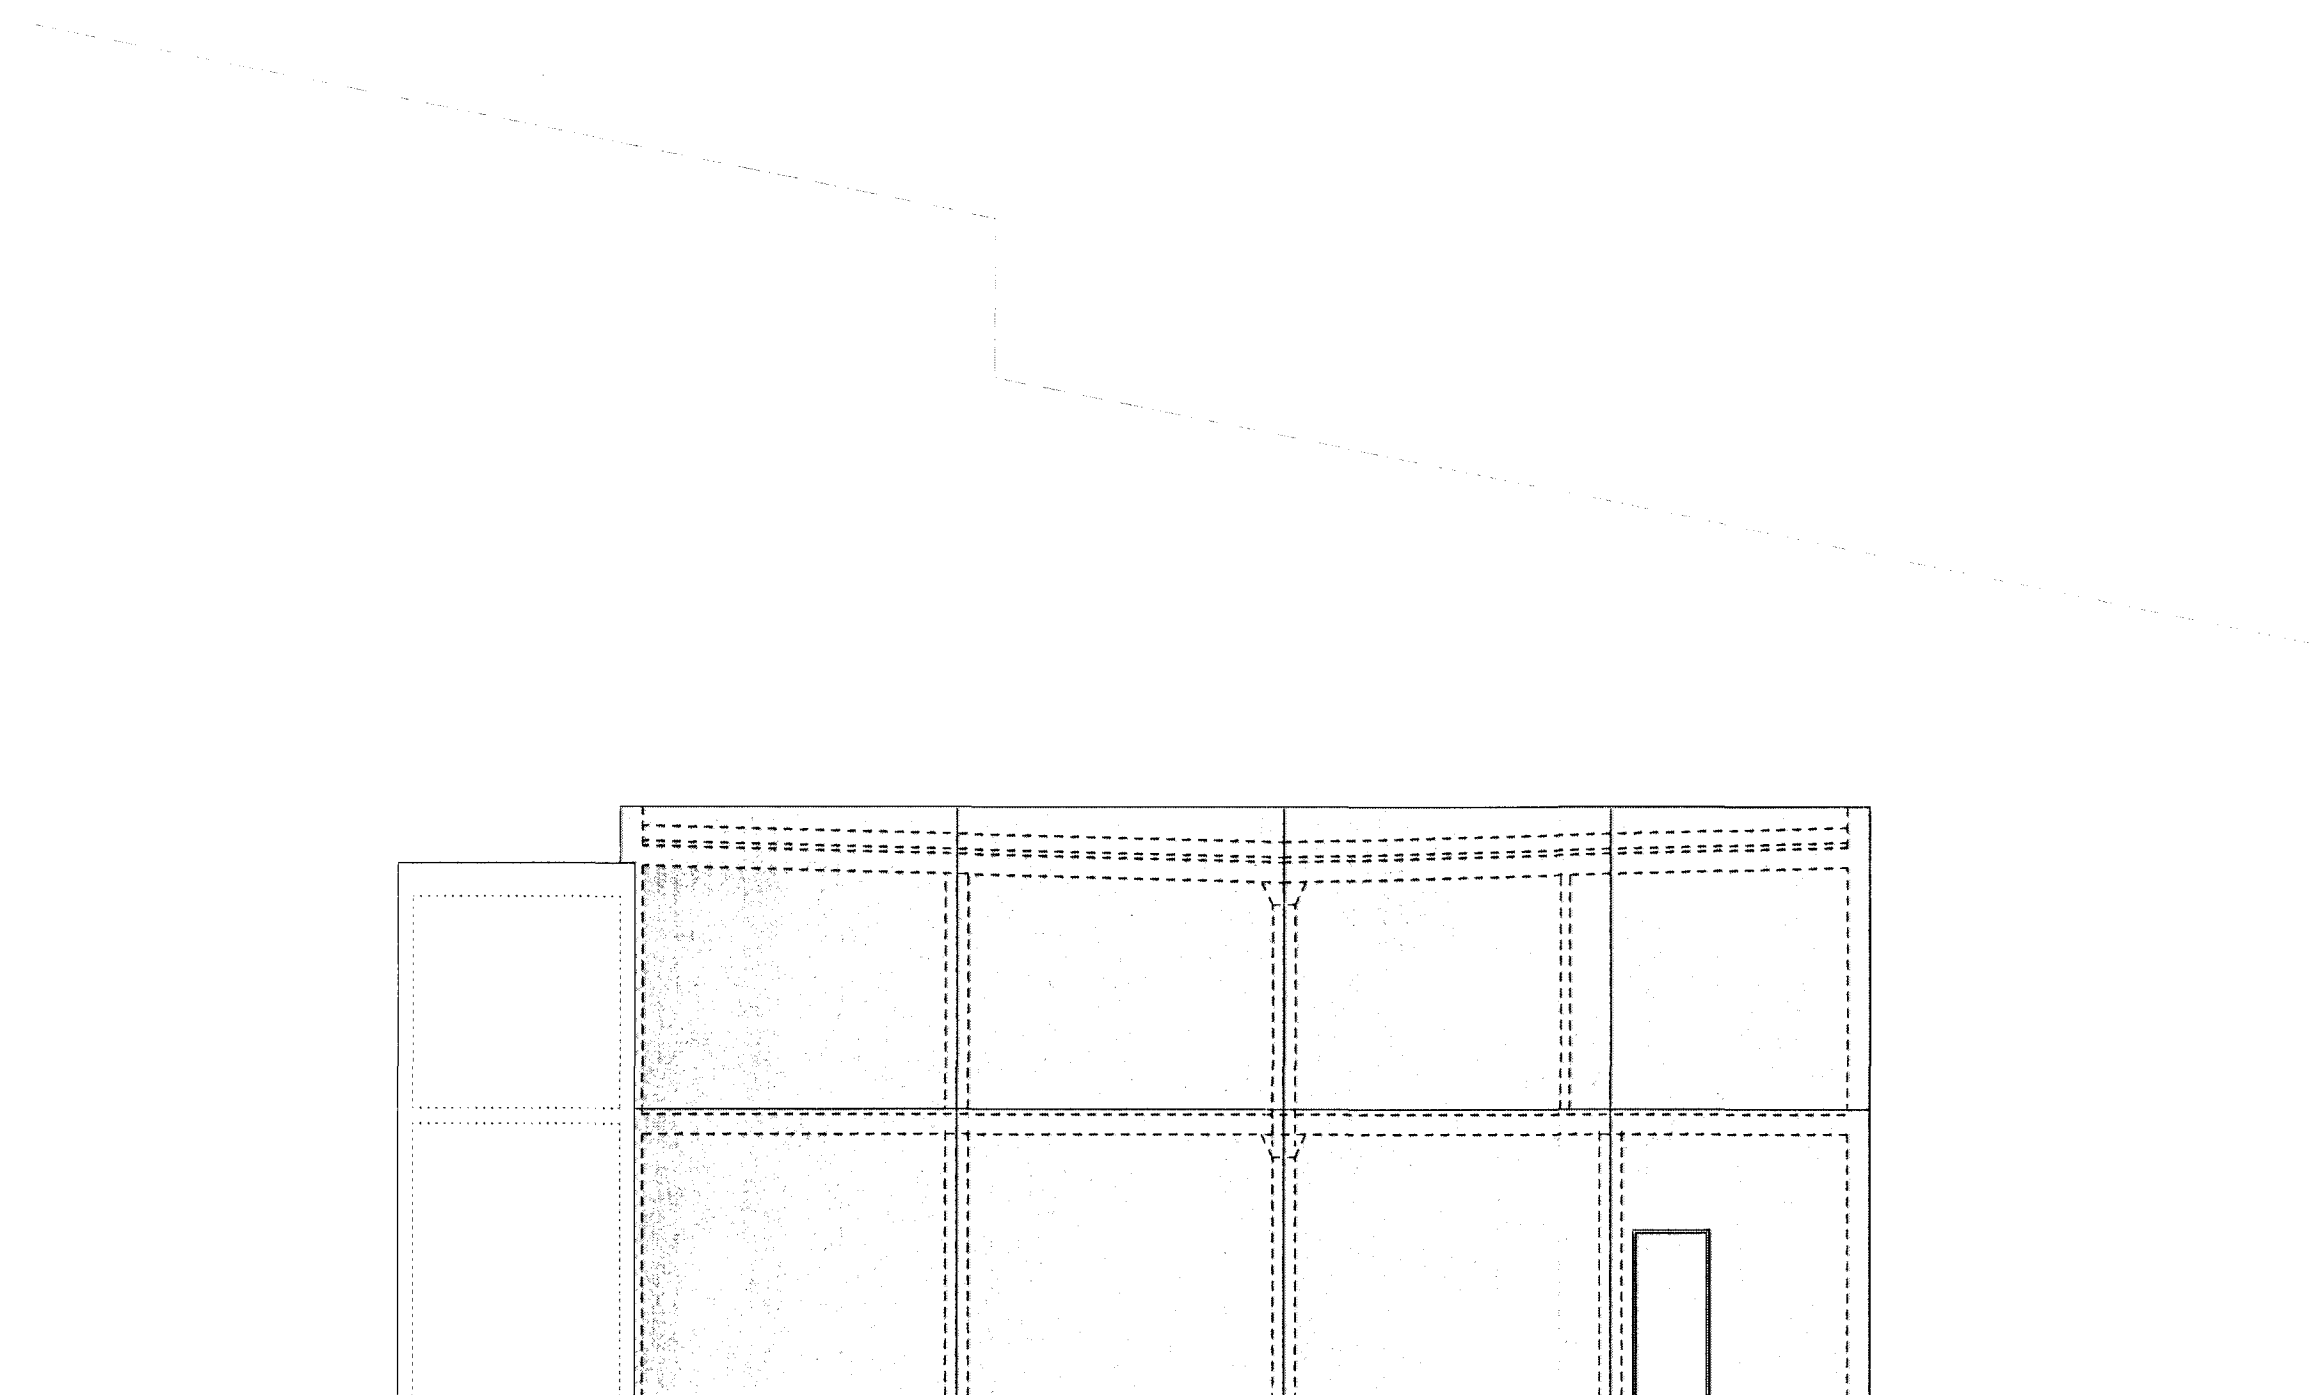

2 ÚTLIT AUSTUR
 mkv. 1:100

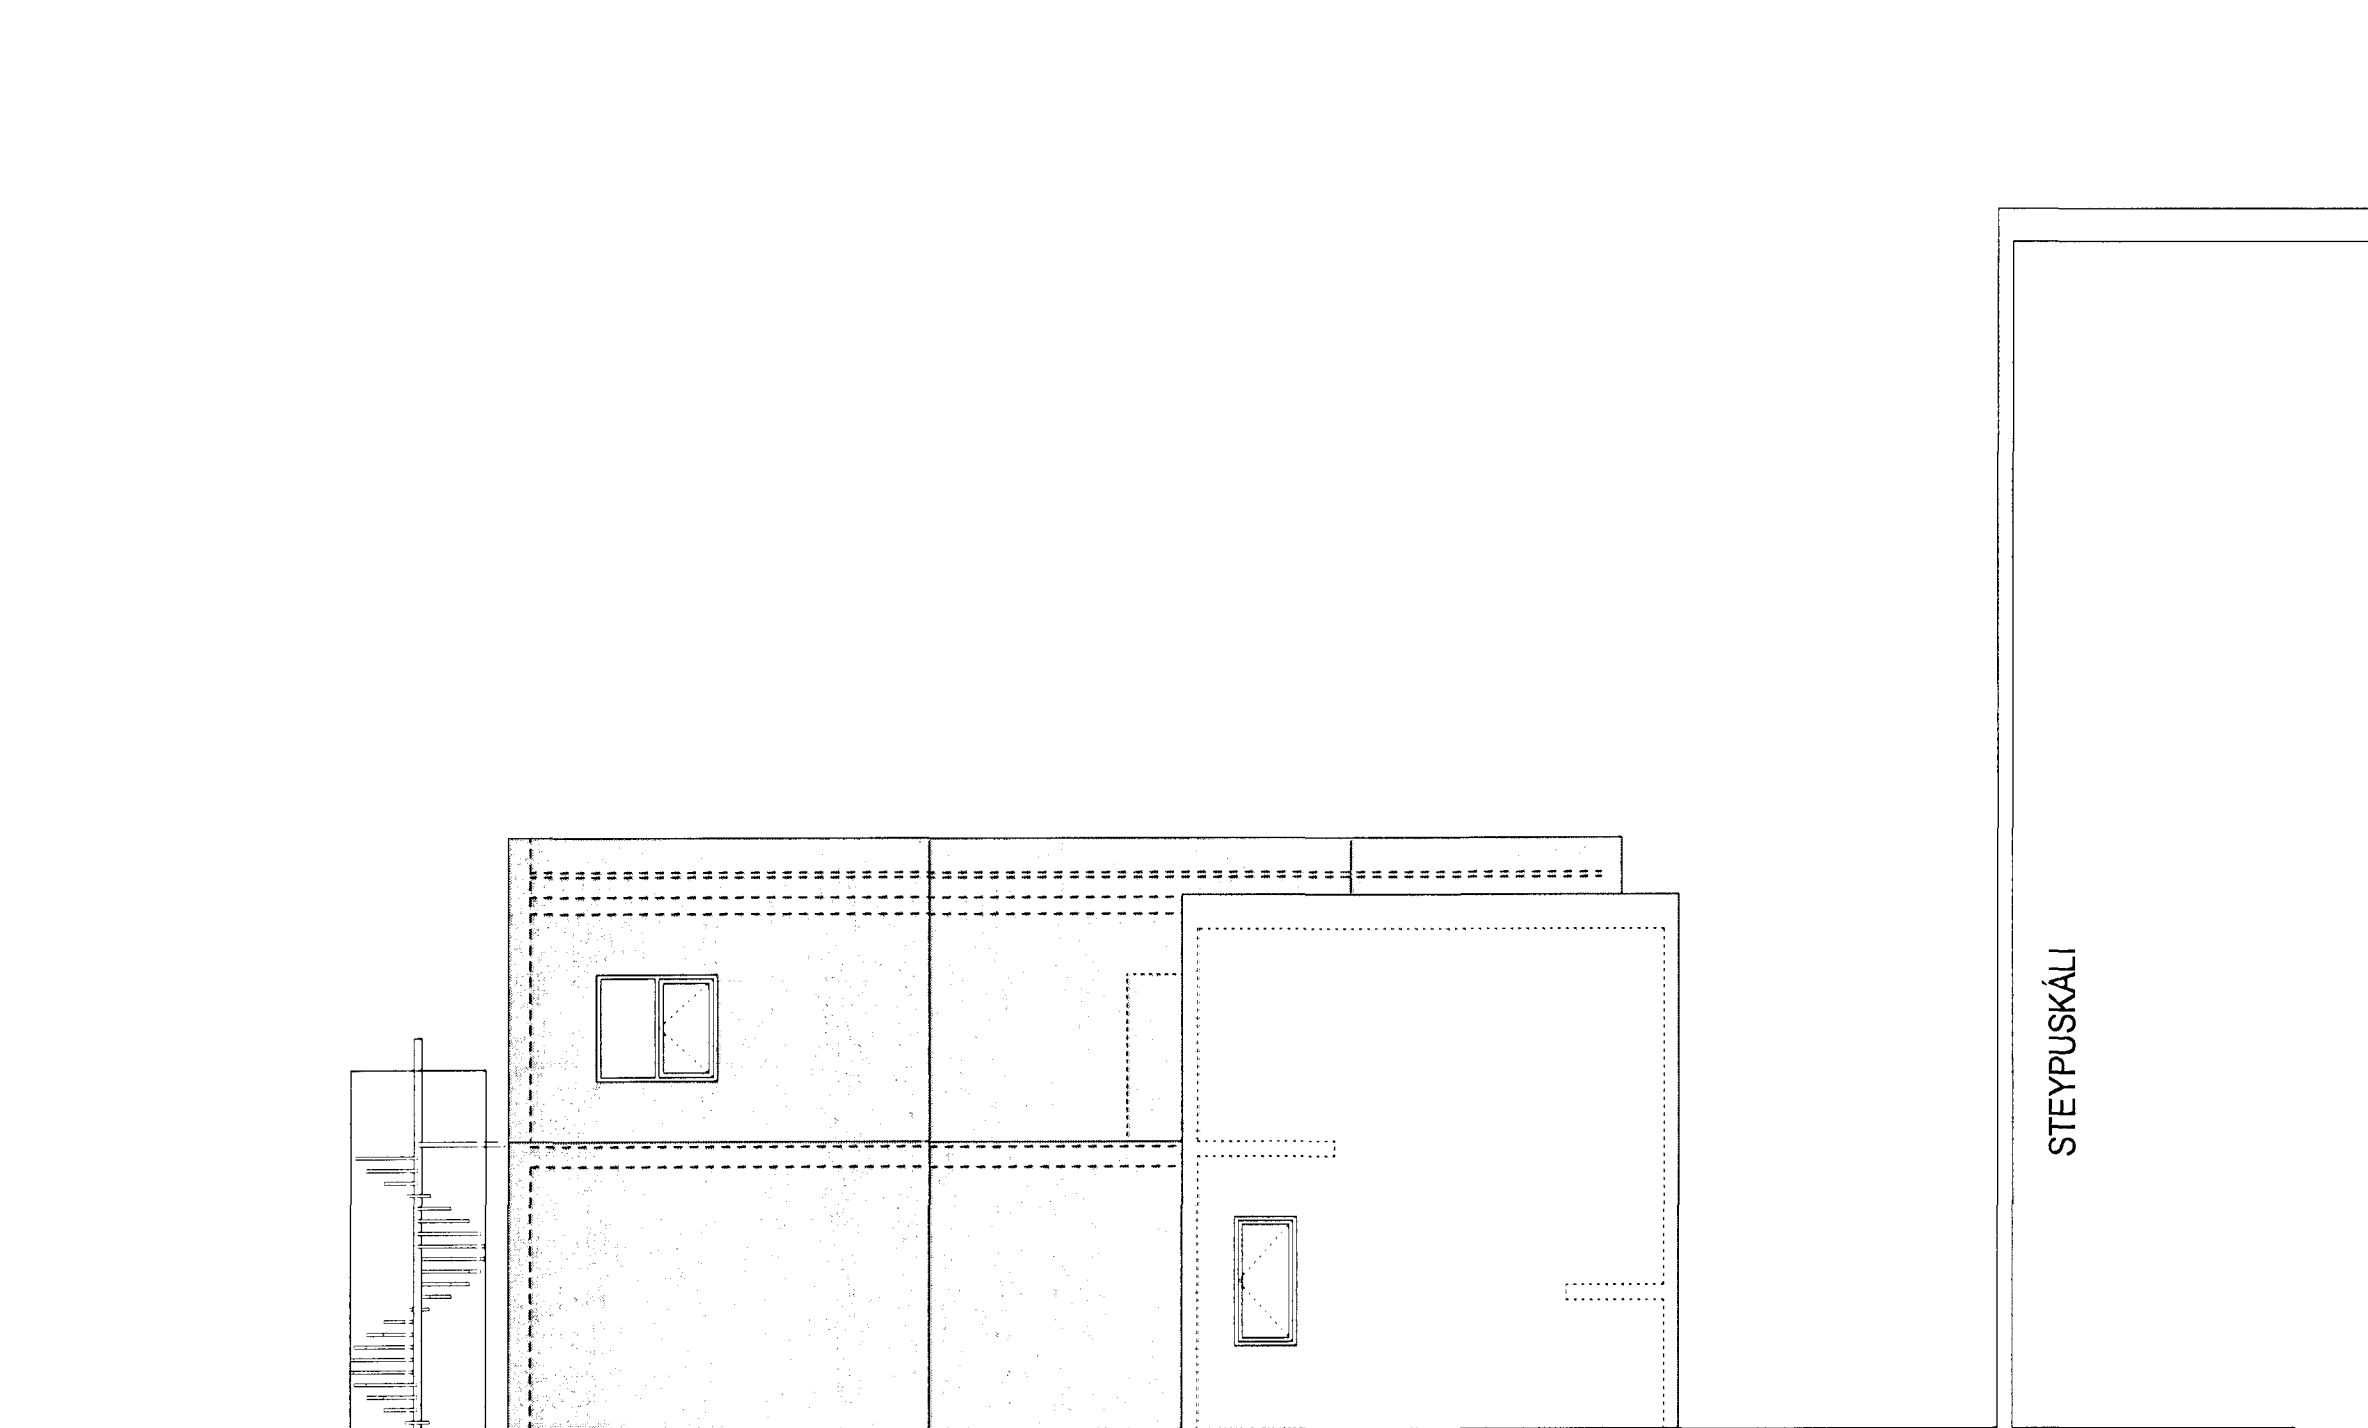


3 ÚTLIT SUÐUR
 mkv. 1:100

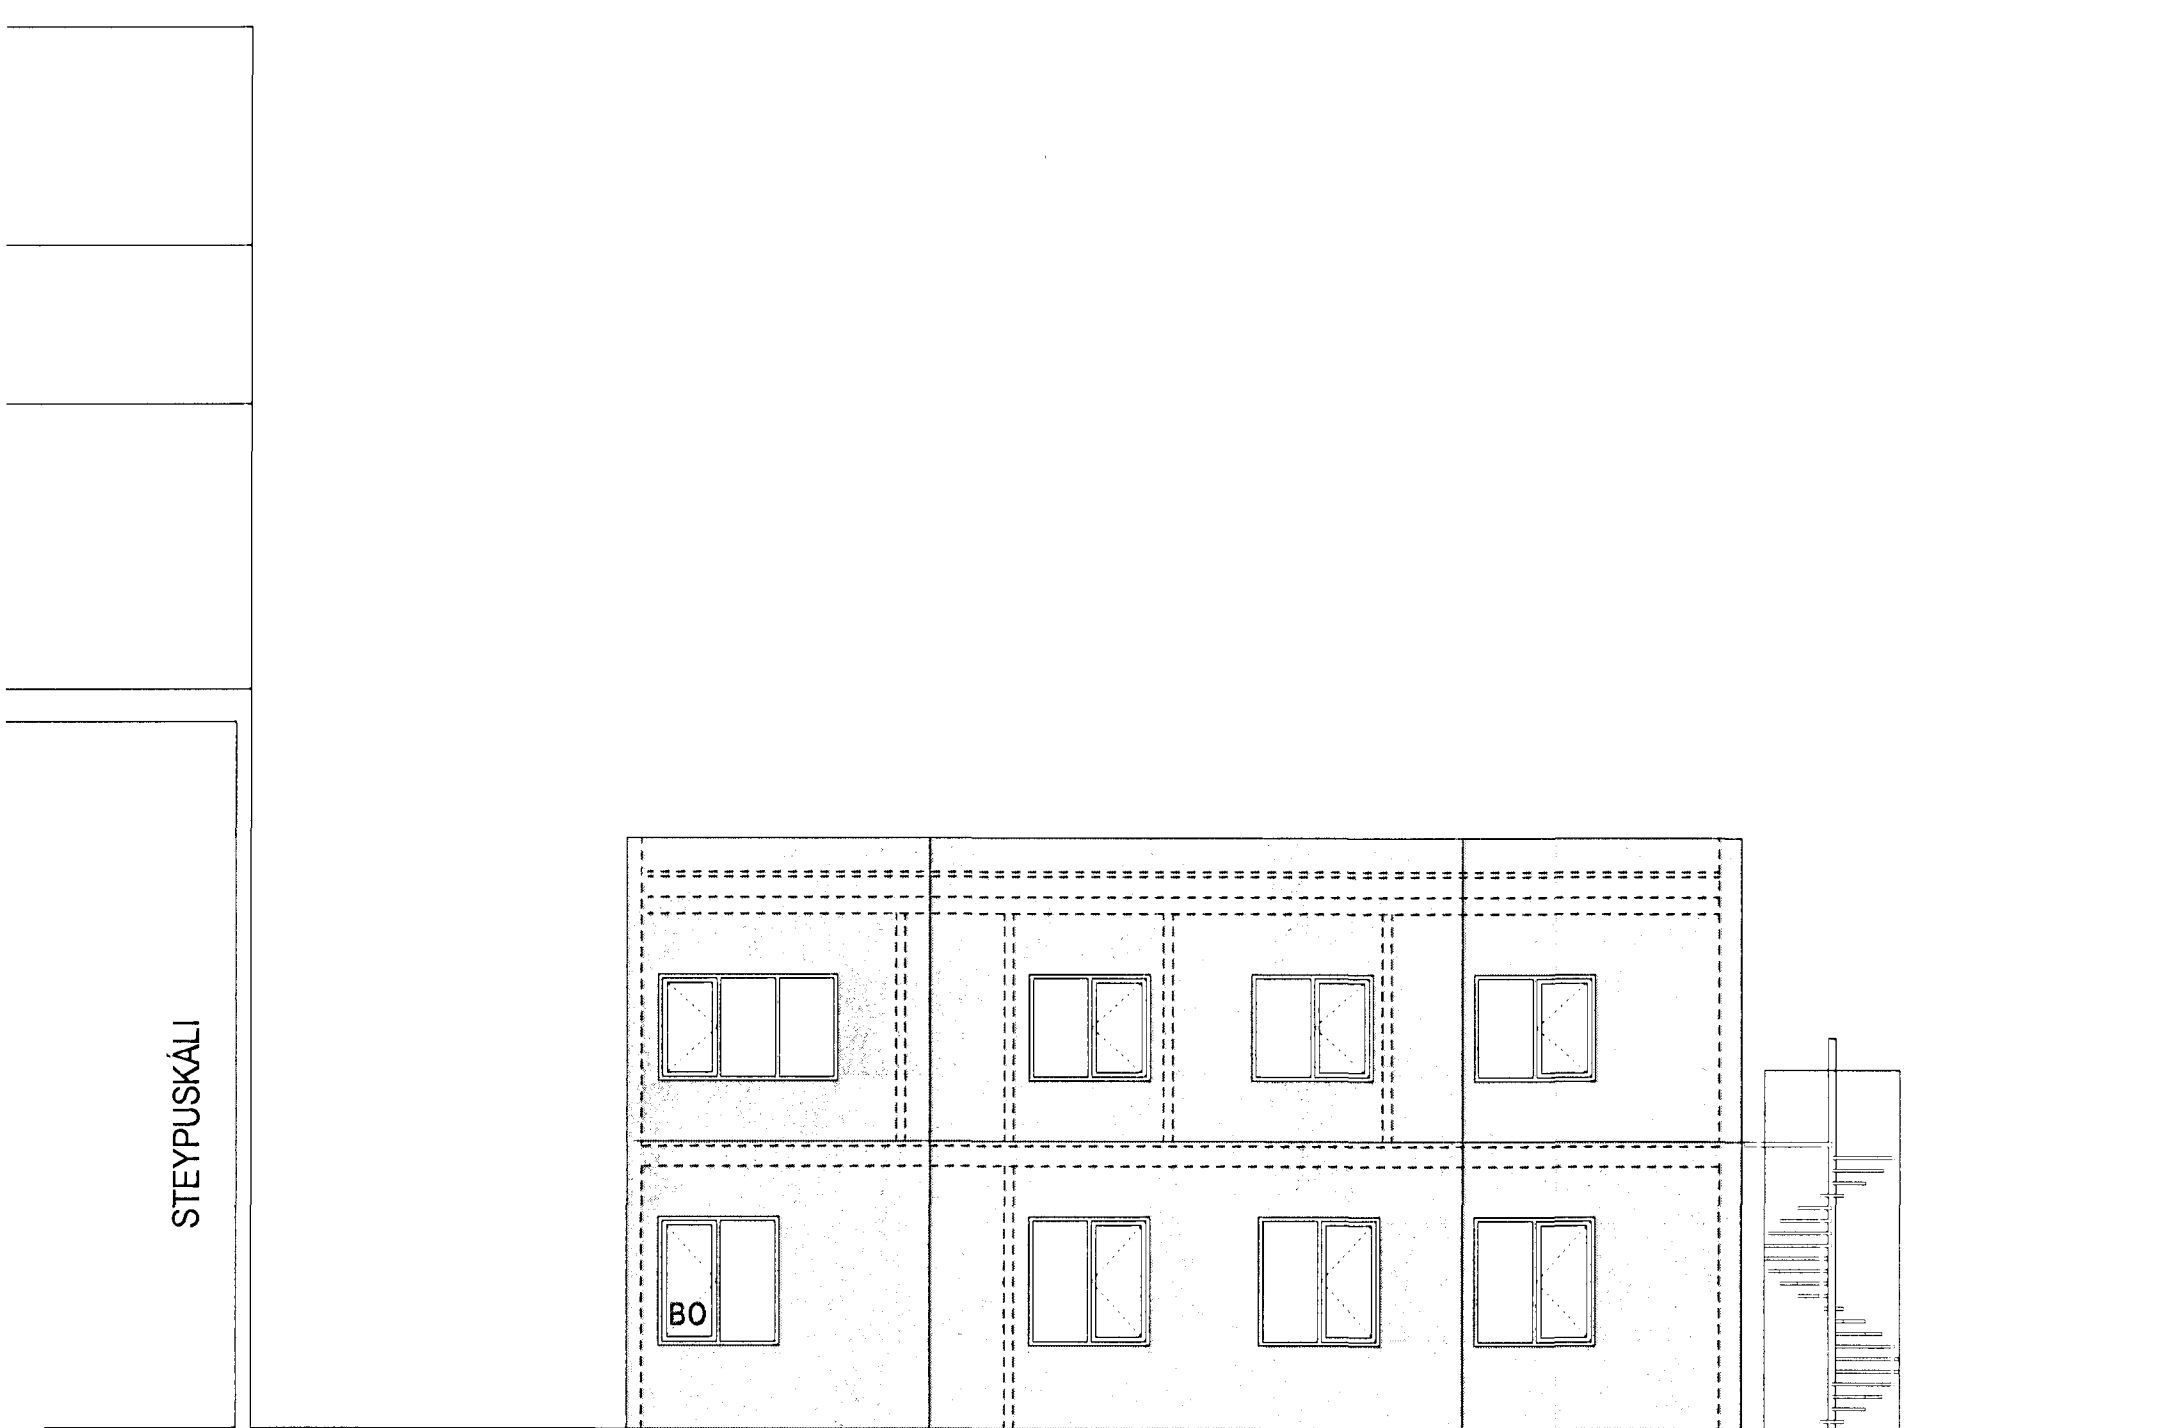

4 ÚTLIT NORÐUR
 mkv. 1:100

14.03.2012
 /
 A1

Skýringar:
 Legend:

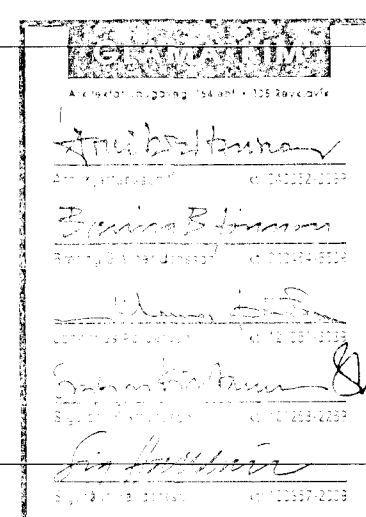

| | | | | | |
|--------|---------------------------|------------|---------|------|-----------|
| B | Þætt við hurð á vesturhlö | 8.07.2011 | BBJ | SK | |
| C | As Built | 07.03.2012 | SK | SK | |
| | | | | | |
| | | | | | |
| Útg nr | Lýsing | Dagsetning | Han/Tkn | Yfir | Notk heim |
| Rev no | Description | Date | Des/Drw | Chk | Suppl Rel |

This drawing is the property of Rio Tinto Alcan Iceland Ltd. and handed out for personal use only. It may neither be copied nor made available to others without permission of Rio Tinto Alcan Iceland Ltd. The receiver is liable for any misuse.
 Stærð: A1 Mkv.: 1:100
 Format: A1 Scale: 1:100
 Dimensions without tolerances according to ISO 2768-1 medium.



| | | | | | |
|---|------------|---------------------------|--------|---------------|-----|
| Dagsetning / Date | 08.02.2011 | Hannað / Designed | SK/BBJ | Teikn / Drawn | BBJ |
| Verktaki / Supplier | GLAMA-KIM | Teg teikningar / Dwg type | A01.05 | Yfir / Chkd | SK |
| Teikn. nr. / Vertaka / Supplier drw no. | A01.05 | Samþykkt / Approved | SK | | |
| Hlut af / Part of | | | | | |

STEYPUKÁLI, ÞJÓNUSTUBYGGING
 ÚTLIT

AÐALUPPRÁTTUR
 Architectural Building Application

Rio Tinto Alcan

Alcan Iceland Ltd
 Strámsvik
 IS-222 Hafnarfjörður
 Iceland

Flokkur nr.: Blað nr.: Næsta bl. nr.:
 Kostn. nr. - Cano. / Blán nr. - Eq. no.
 6010 16963

Teikn. nr. ISAL / Drw. no. of ISAL Breyt./Rev.
 256855 A

ISAL Yfirfarið og skráð, dags / ISAL Checked, date ISAL Samþykkt, dags / ISAL Approval, date