



Samþykkt þann
 04 APR 2012
 Byggingafulltrúgvin (Hafnarvegur 2)
 Fh. Sigurður Steinar Jónsson

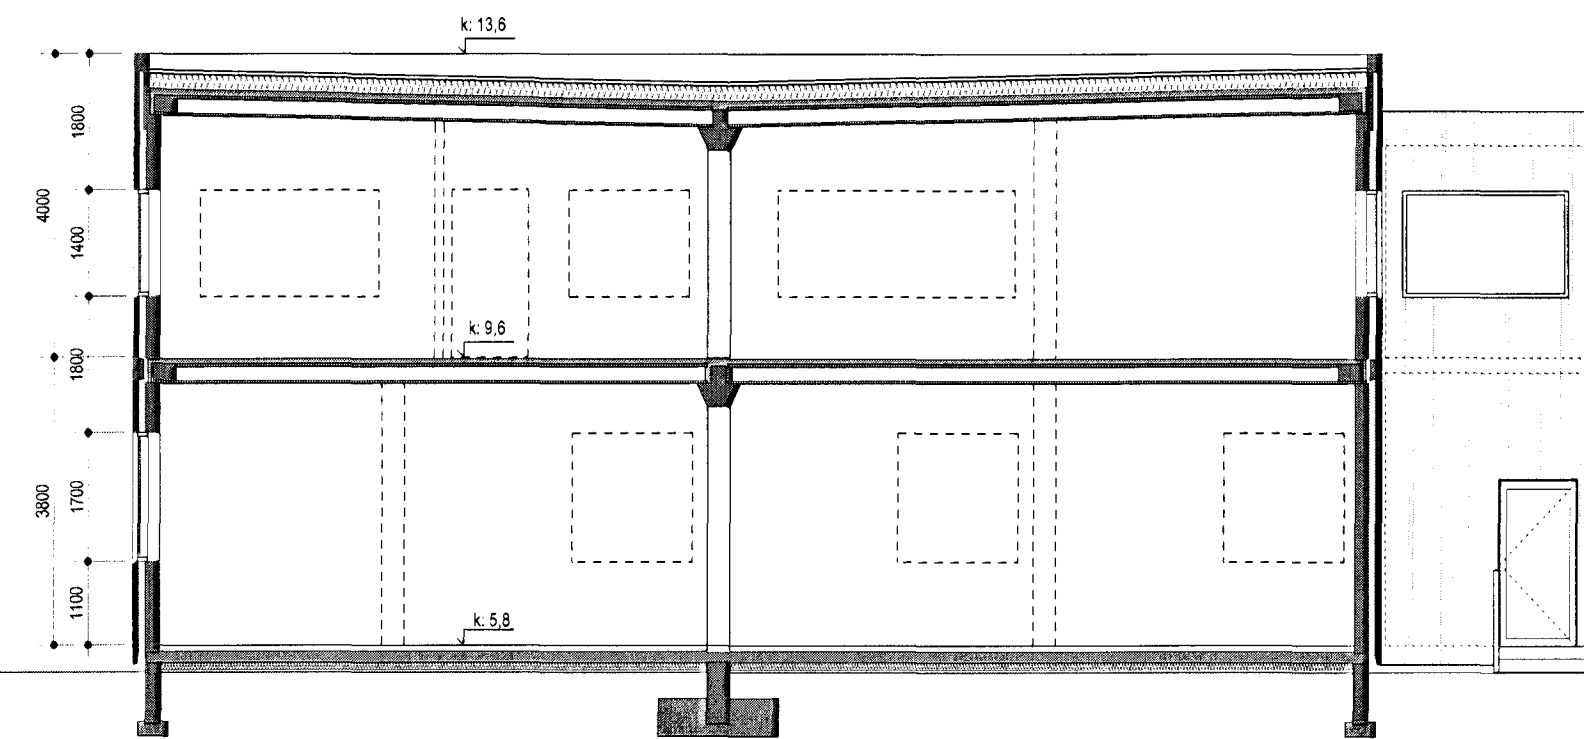

SKURÐUR AA

1 SKURÐUR AA
 mkv. 1:100

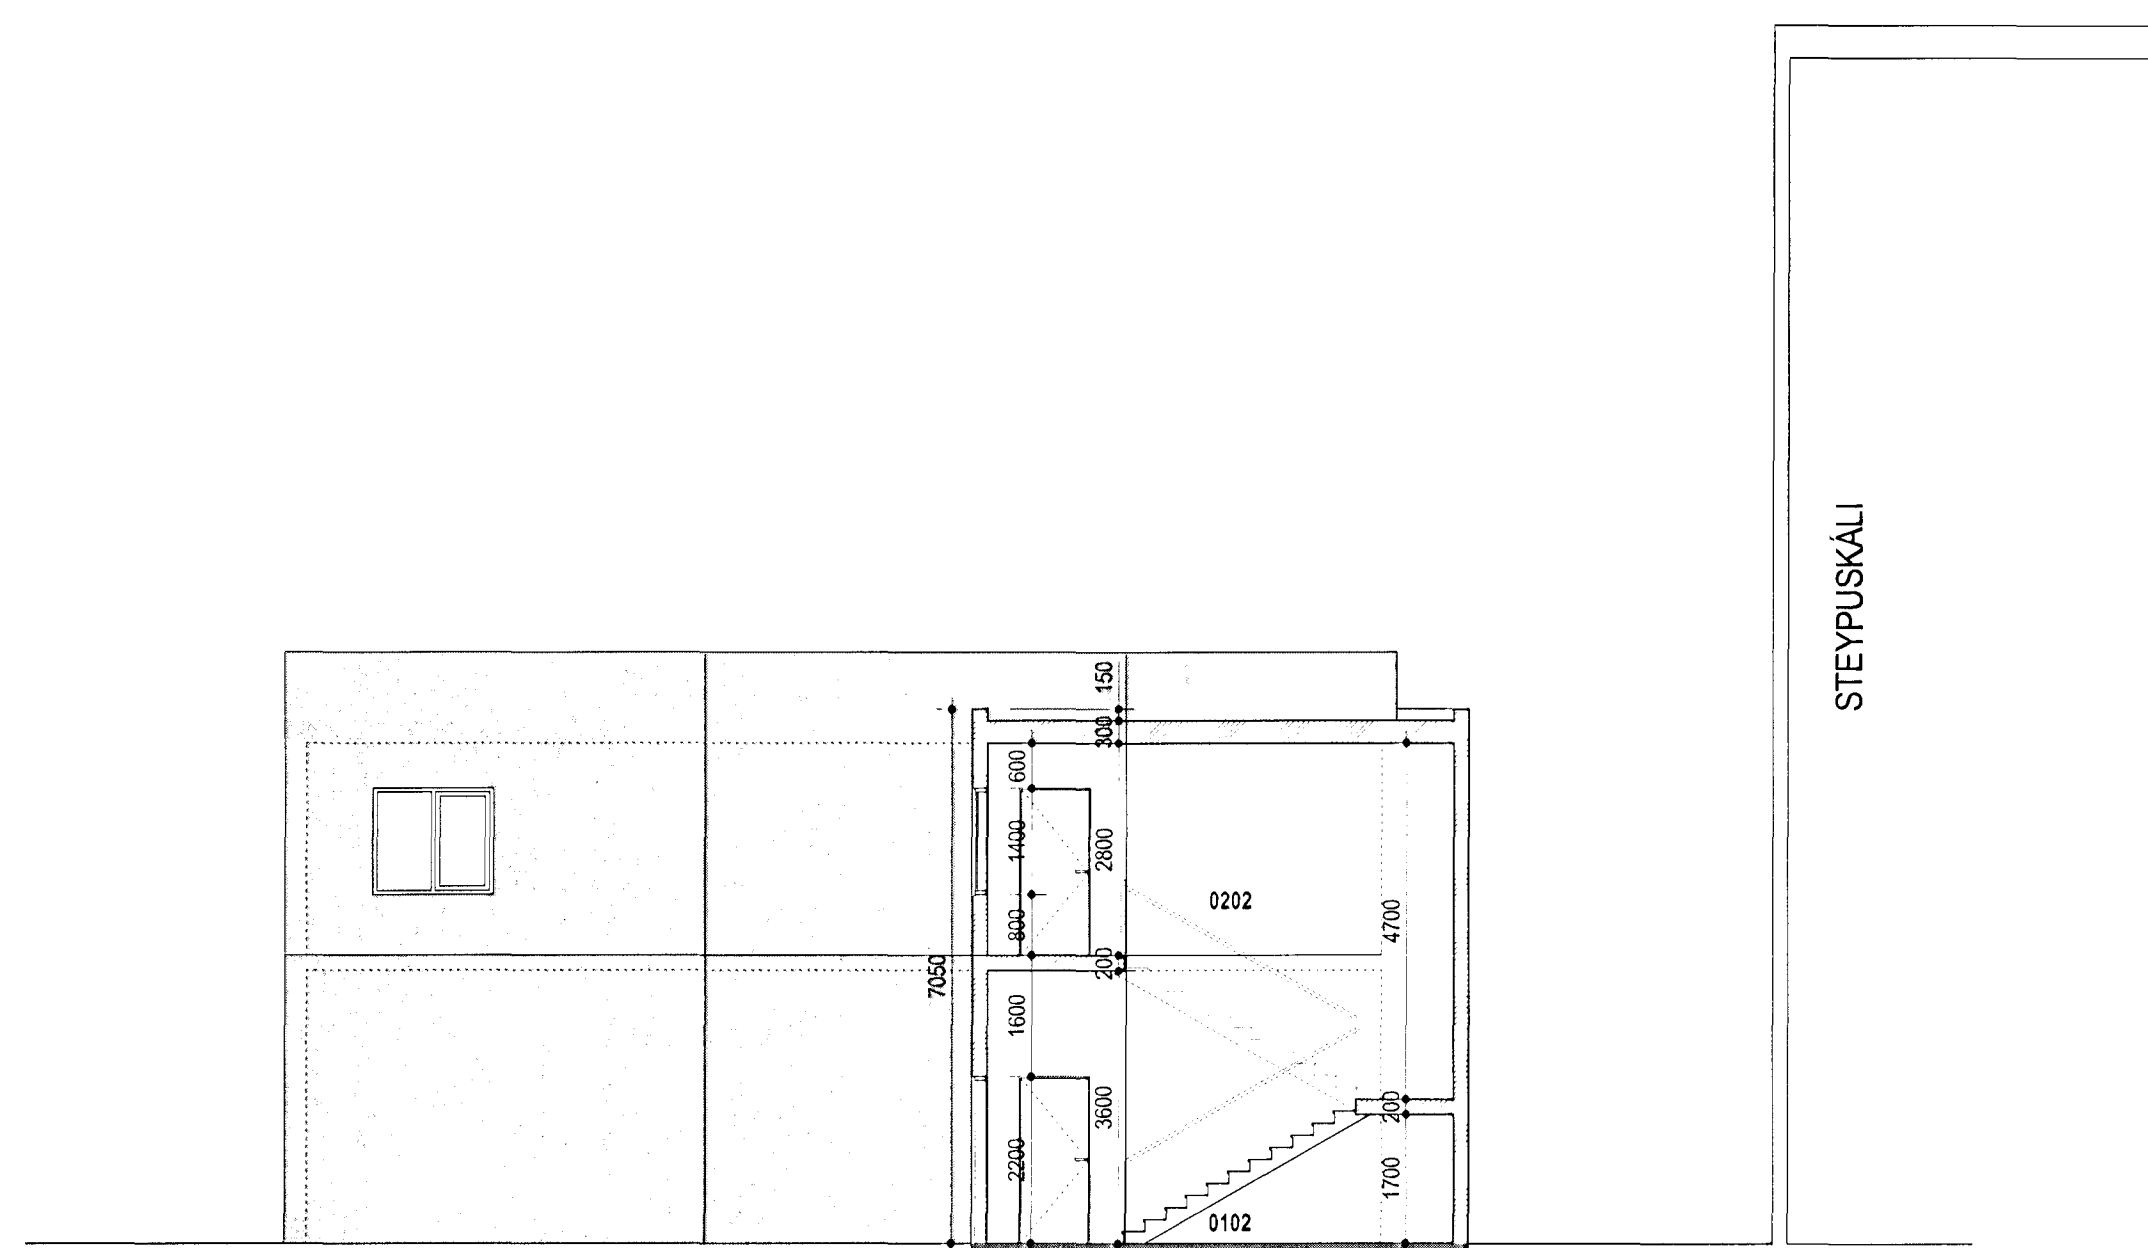


STEYPUKÁLI

2 SKURÐUR BB
 mkv. 1:100

14.03.2012
 A1

Skýringar:
 Legend:

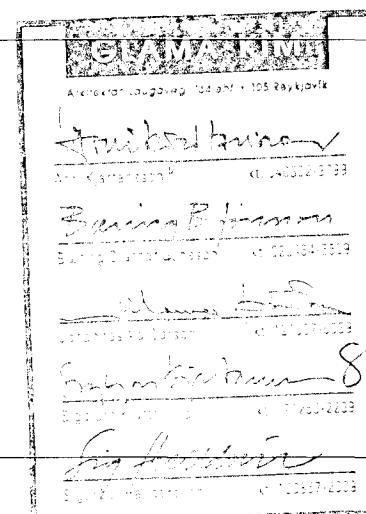

A	Útveggir þykktir	19.04.2011	BBJ	SK
B	As Built	07.03.2012	SK	SK

This drawing is the property of Rio Tinto Alcan Iceland Ltd. and handed out for personal use only. It may neither be copied nor made available to others without permission of Rio Tinto Alcan Iceland Ltd. The receiver is liable for any misuse.



Dagsetning / Date	08.02.2011
Hannað / Designed	SK/BBJ
Teikn / Drawn	BBJ

Verktaki / Supplier	GLAMA-KIM
Teikn.nr.verktaka / Supplier drw.no.	A01.04
Samþykkt / Approved	Yfirf./Chkd SK


STEYPUKÁLI, ÞJÓNUSTUBYGGING
 SKURÐIR

Teikningar / Dwg type: AÐALUPPRÁTTUR
 Architectural Building Application

Flokkur nr. / Class no.	6010
Bláð nr. / Sheet no.	16963

Kostn.nr.-Cono. / Bún.nr.-Eq.no	AKS UL6
---------------------------------	---------

Dwg nr / Rev.no	Lýsing / Description	Dagsetning / Date	Han./Tkn / Des./Dwn	Yfir / Chkd	Notk heim / Suppl Ret	Notk heim / ISAL Ret

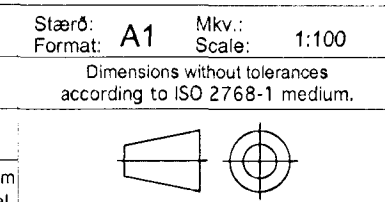

Teikn.nr.verktaka / Supplier drw.no.	A01.04
Samþykkt / Approved	Yfirf./Chkd SK

RioTintoAlcan

ISAL Teikn.nr. / ISAL Drw.no. of ISAL	256854
Breyti./Rev.	A