


Samþykkt þann
 04 APR 2012
 Byggingafulltrúnaði Hafnarfjarðar
 E.h. Sigurður Steinar Jónsson

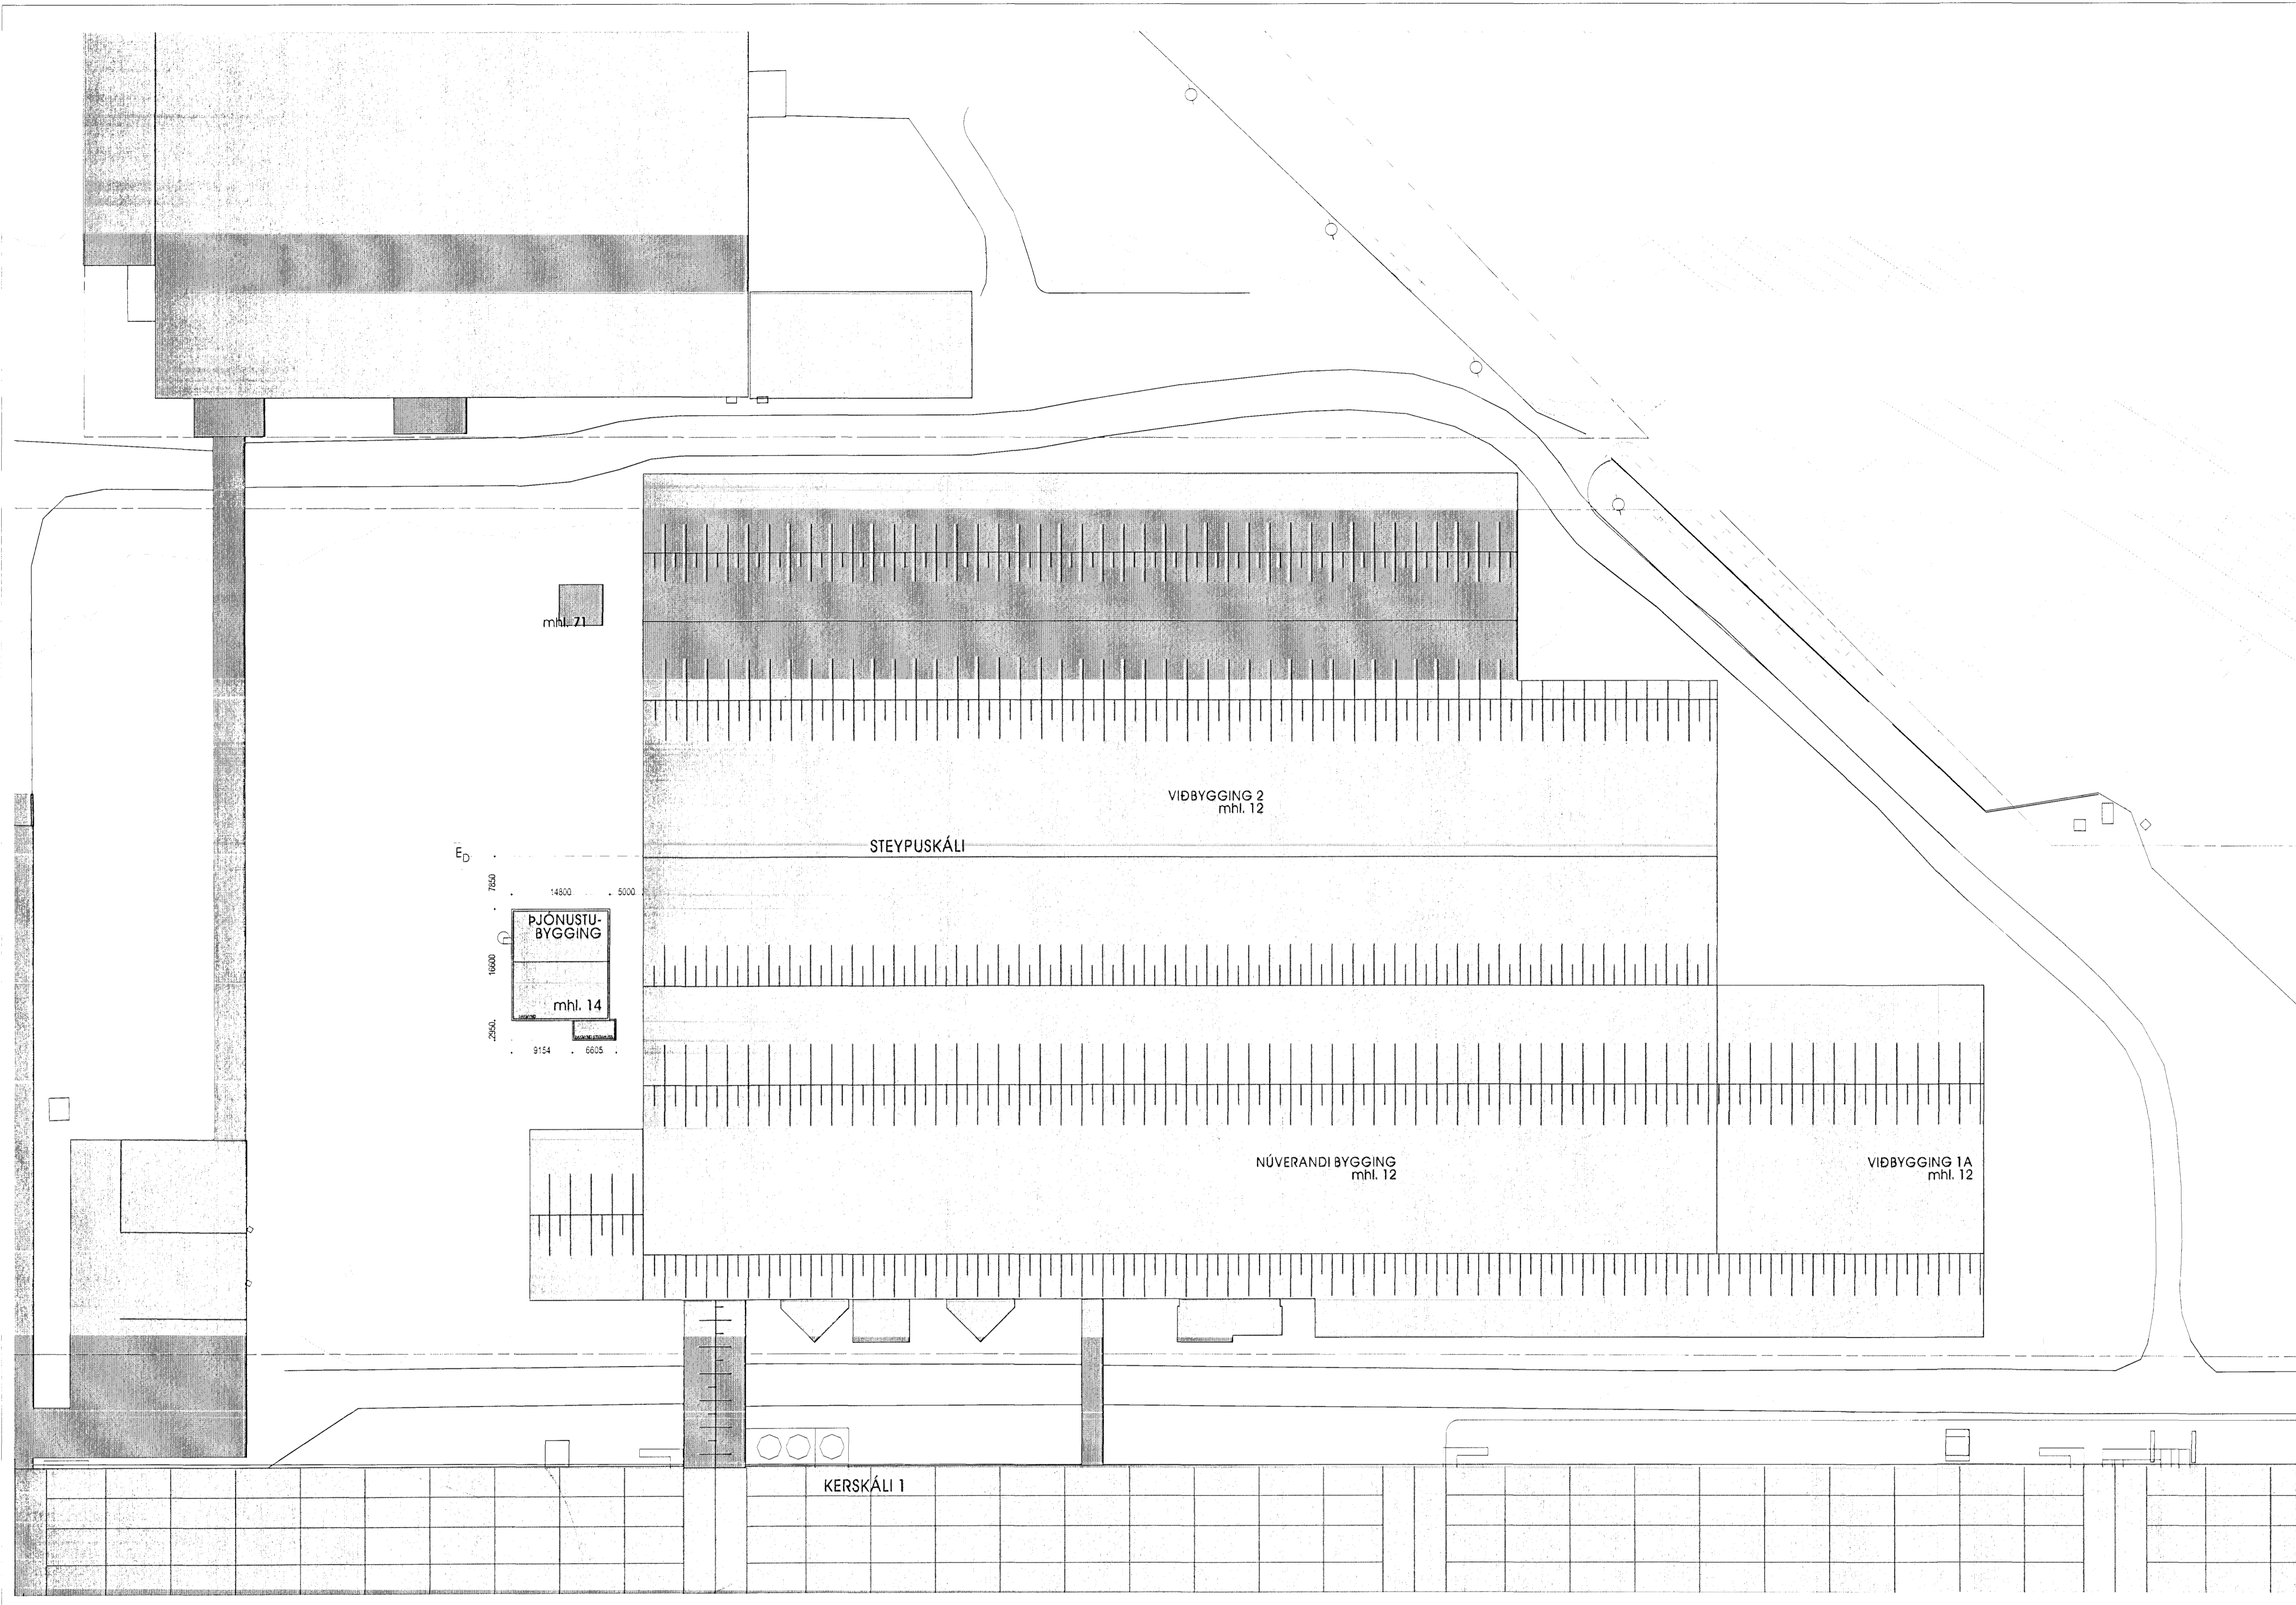


16.3.2012
 HEILBRIGÐISFRUMIT F.
 HANNAHJARDAR-
 OG KÖNNUNARSTEDIS
 Garðatorgi 7 210 Gardabæ
 K. Stefánsson

14.03.2012
 H

1 AFSTÖÐUMYND
 mkv. 1.500

Skýringar:
 Legend:

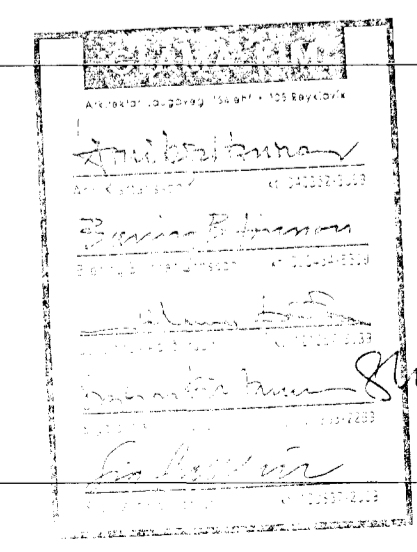

A	As Built	07.03.2012	SK	SK
Útg nr	Lýsing	Dagsetning	HanTkn	Yfir
Rev no	Description	Date	Des/Dwg	Chd
			Nösk heim	Nösk heim
			Suppl Ref.	ISAL Ref.

This drawing is the property of Rio Tinto Alcan Iceland Ltd. and handed out for personal use only. It may neither be copied nor made available to others without permission of Rio Tinto Alcan Iceland Ltd. The receiver is liable for any misuse.

Stavó. Format: A1 Mkv. Scale: 1:500
 Dimensions without tolerances according to ISO 2768-1 medium.



Dagsetning / Date: 08.02.2011
 Hanna / Designed: SK/BBJ
 Teikn / Drawn: BBJ
 Verktaki / Supplier: GLÁMA-KÍM
 Teikn nr. verktaka / Supplier drw. no: A01.02
 Samþykkt / Approved: Yfir / Chkd SK

STEYPUKALI, PJONUSTUBYGGING
 AFSTÖÐUMYND
 AÐALUPPRÁTTUR
 Architectural Building Application
RioTinto Alcan

Flokkur nr.: Blað nr.: Næsta bl. nr.:
 Kostn. nr. - Cno. / Bú. nr. - Eq. no: 6010 16963
 AKS UL6
 ISAL Teikn nr. ISAL / Drw. no. of ISAL: 256852
 Breyt/Rev: A