



1 GRUNNMYND LAGNAKJALLARA  
m.kv. 1:500

2 ÞAKMYND  
m.kv. 1:1000

28.03.2012  
HEILBRIGÐISEFTIRLIT  
HAFNARFRÁUNAR-  
OG KÖNNINGSSVÆÐIS  
Gardagur 7 - 210 Gardube  
K. Steinar Jónsson

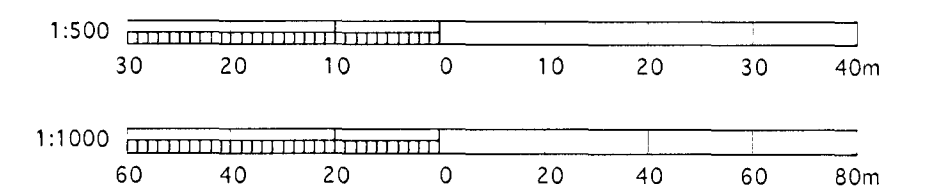


Skýringar:  
Legend:

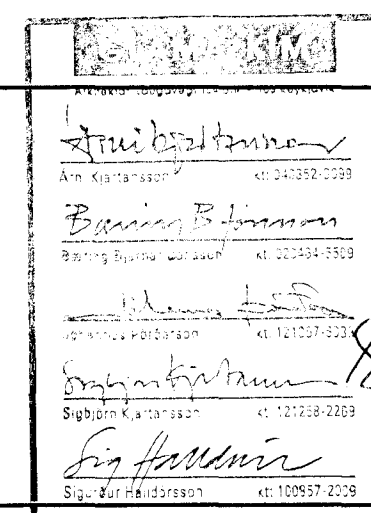

Utg. nr / Rev. no	Lýsing / Description	Dagsetning / Date	Han/Tkn / Des/Draw	Yfir / Ckd	Notk. heim / Suppl. Ref	Notk. heim / ISAL Ref
B	AS BUILT	06.03.2012	ÓM	SK		
A	INNTAKSBYGGINGAR, PL2 OG PL3	1.03.2011	BBJ	SK		

This drawing is the property of Rio Tinto Alcan Iceland Ltd. and handed out for personal use only. It may neither be copied nor made available to others without permission of Rio Tinto Alcan Iceland Ltd. The receiver is liable for any misuse.

Stærð: A1 Mkv.: 1:200 / Formati: A1 Scale: 1:1000  
Dimensions without tolerances according to ISO 2768-1 medium.

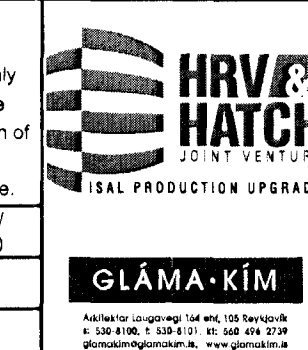

Dagsetning / Date 17.03.2011	Hannað / Designed SK	Teikn / Drawn UDM/BBJ
Vertakni / Supplier GLÁMA-KÍM	Teikn.nr. vertakna / Supplier draw.no A01.02	Samþykkt / Approved YRF / Ckd SK
Hluti af: / Part of:		

AFRIDLAEILDIR OG VIÐBÓTARAFRÍÐILL  
GRUNNMYND LAGNAKJALLARA OG ÞAKMYND

Teikn.nr. / Dwg. no. of ISAL: 250393

Reyrt./Rev: A

Flokkur nr. / Class no.	Blað nr. / Sheet no.	Næsta bl. nr. / Next sheet no.
Kostn.nr.-Ccmo. / Búrn.nr.-Eq.no	4011	n/a
AKS / UB		