
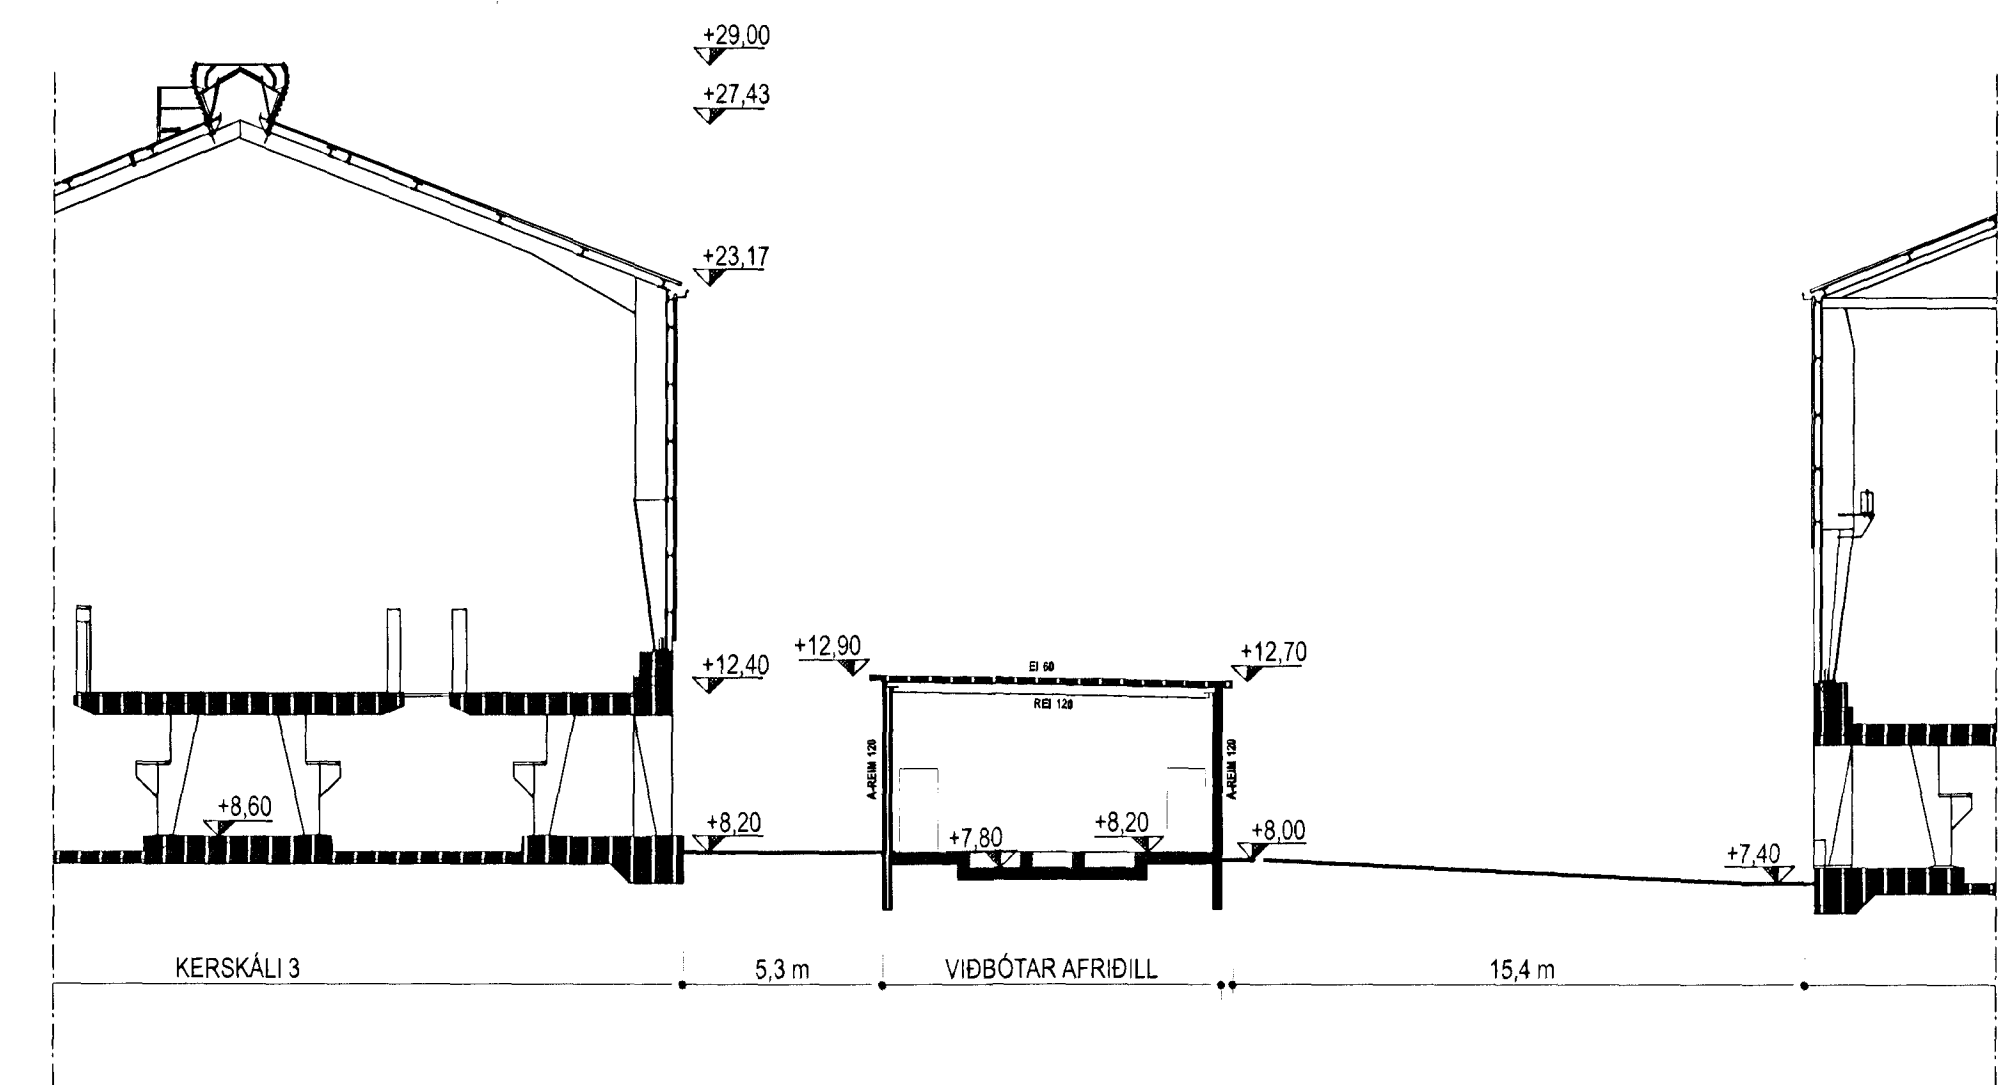
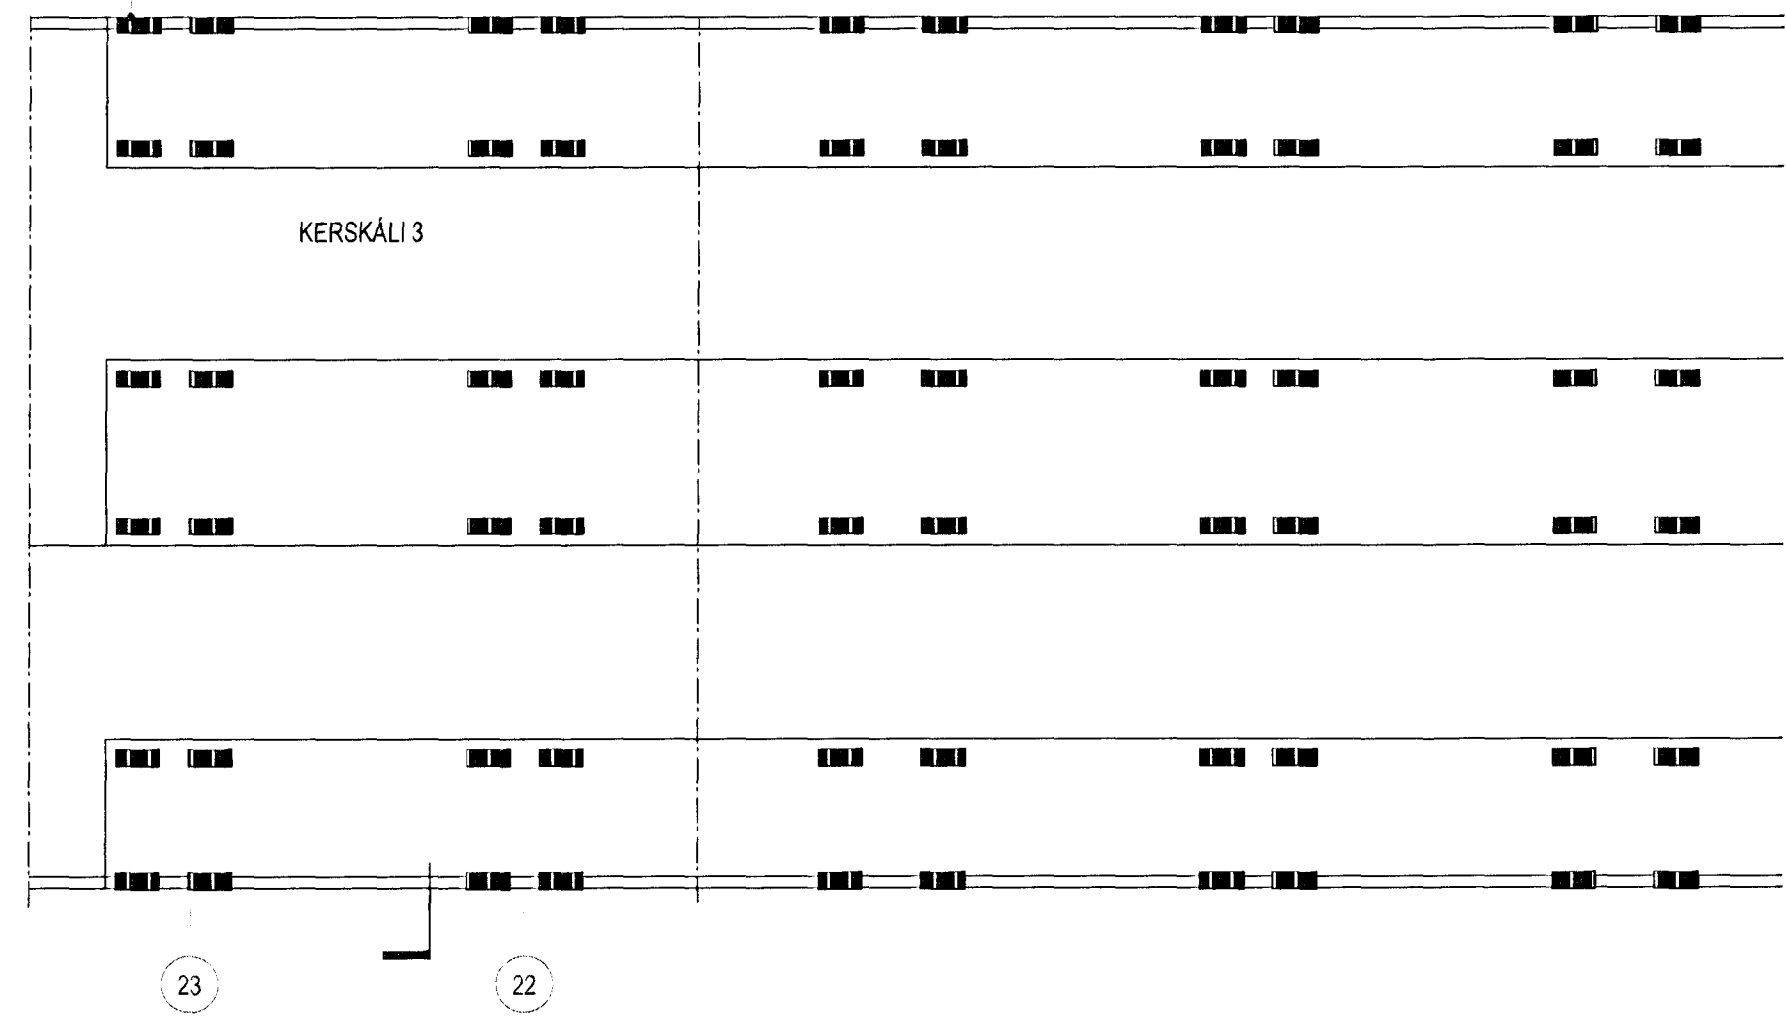


Samþykkt þann

04 APR 2012





Byggingafulltrúinn í Hafnarfirði  
E.h. Sigurður Steinar Jónsson

Bro

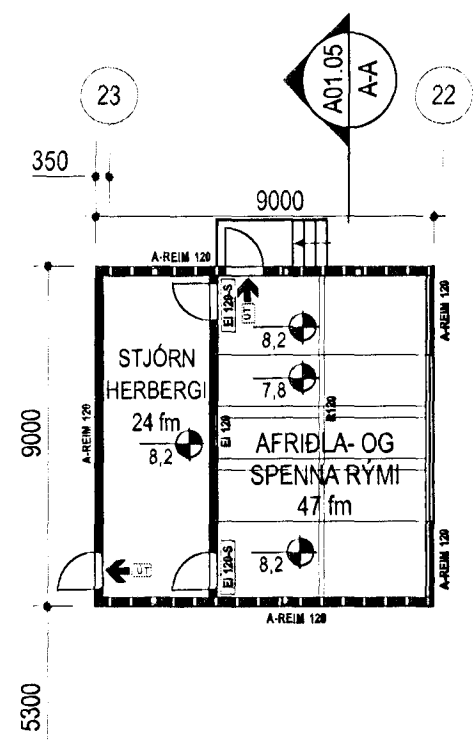

1 GRUNNMYND - VIÐBÓTAR AFRIDILL

2 SNEIDING A-A

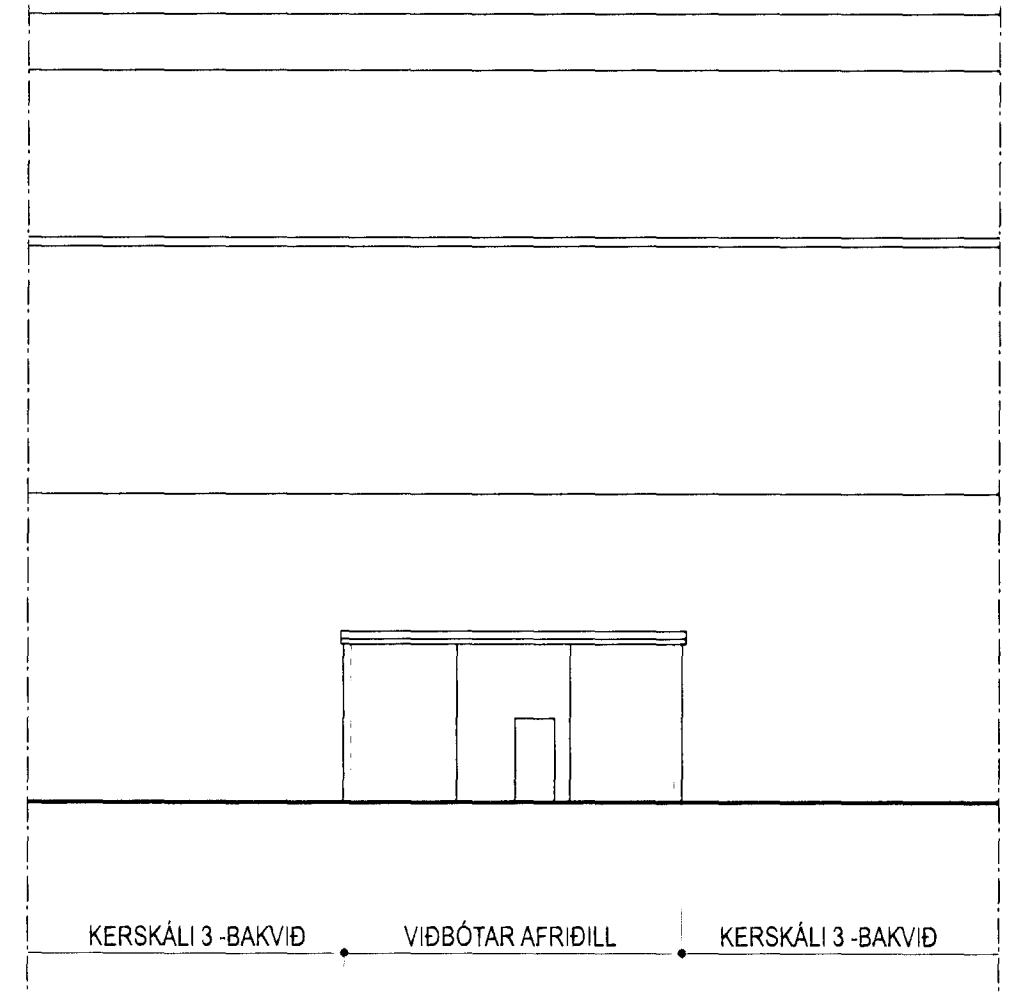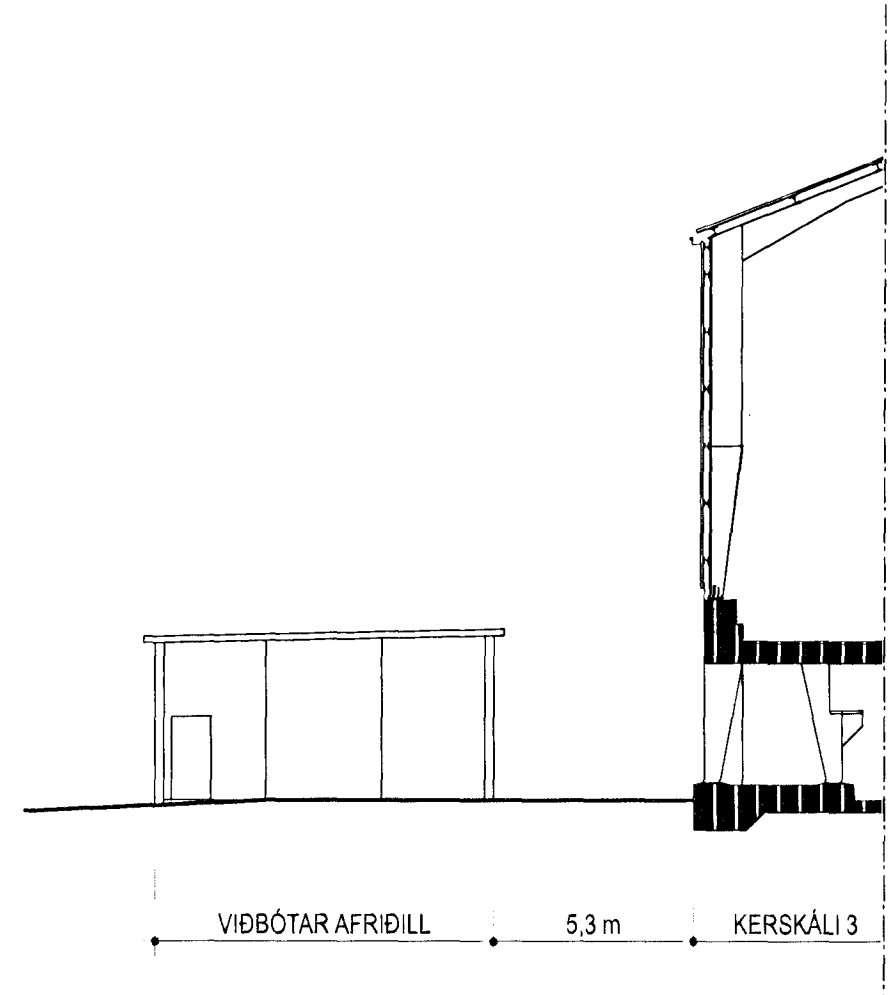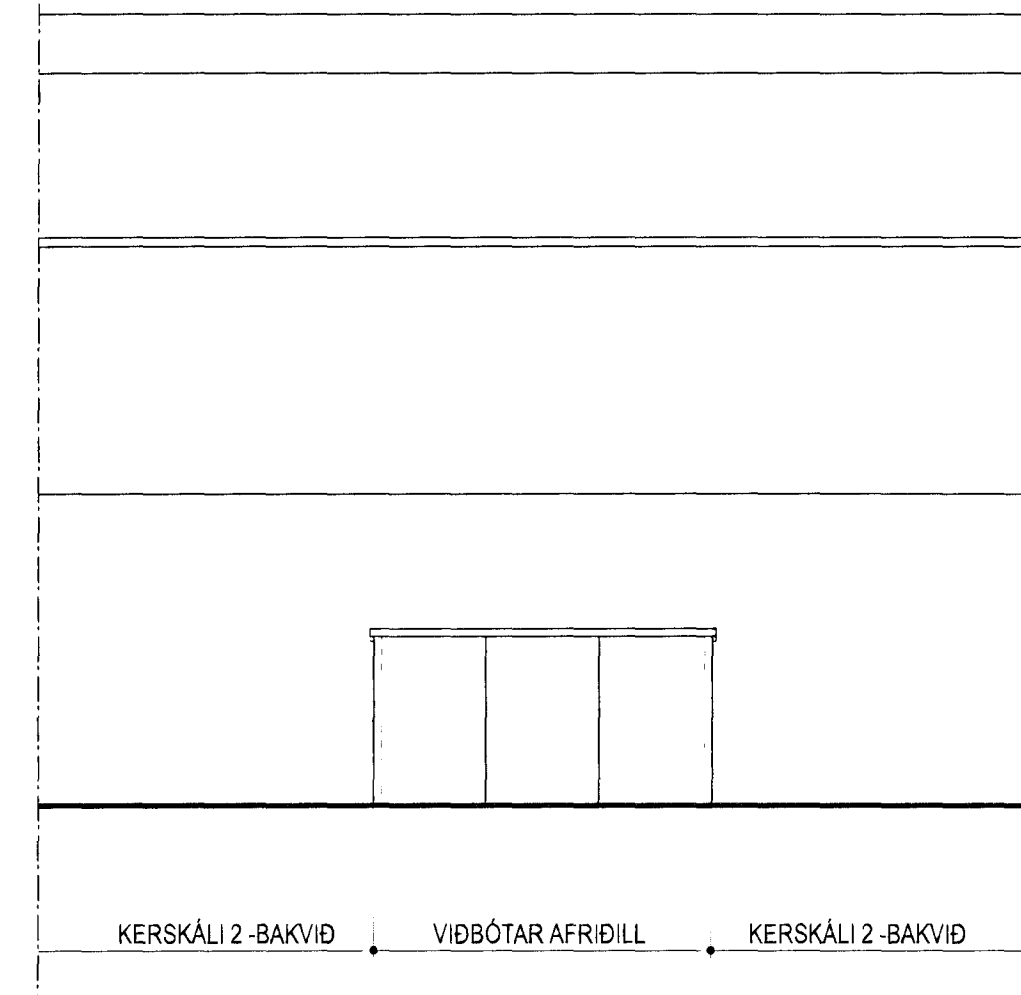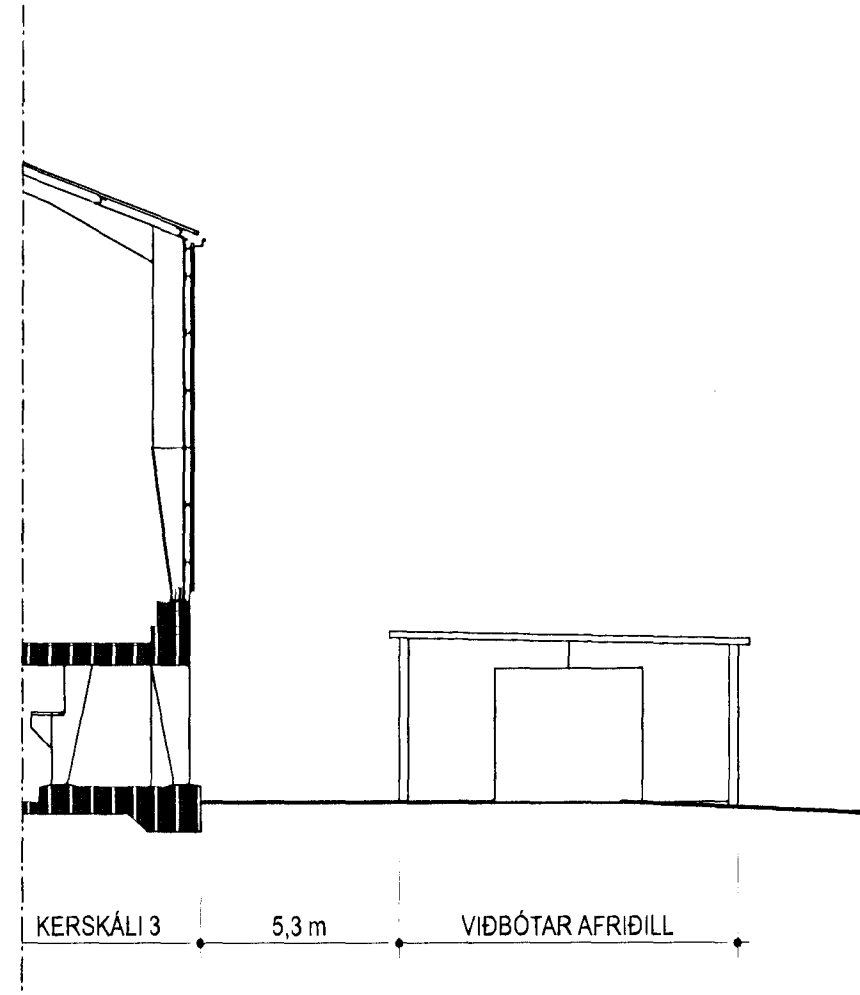


3 ÚTLIT - AUSTUR

4 ÚTLIT - SUÐUR

5 ÚTLIT - VESTUR

6 ÚTLIT - NORÐUR

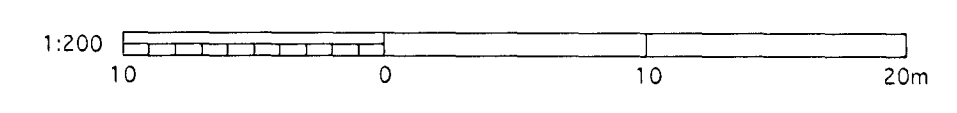


Skýringar:  
Legend:

C:\Users\lilja\Desktop\As built teikningahaus.dwg

Handwritten signatures and stamps of the architect and client.

| Utg nr / Rev no | Lýsing / Description         | Dagsetning / Date | Hann/Tín / Des/Drw | Yfir / Ckd | Notk heim / Suppl Rel | Notk heim / ISAL Rel |
|-----------------|------------------------------|-------------------|--------------------|------------|-----------------------|----------------------|
| C               | AS BUILT                     | 06.03.2012        | ÓM                 | SK         |                       |                      |
| B               | TEXTI UM BRUNAVARNIR         | 20.01.2012        | SK                 | SK         |                       |                      |
| A               | INNTAKSBYGGINGAR, PL2 OG PL3 | 01.03.2011        | BBJ                | SK         |                       |                      |

This drawing is the property of Rio Tinto Alcan Iceland Ltd. and handed out for personal use only. It may neither be copied nor made available to others without permission of Rio Tinto Alcan Iceland Ltd. The receiver is liable for any misuse.

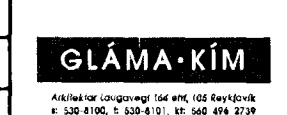

|  |                |
|--|----------------|
| Dagsetning / Date                      | 17.03.2011     |
| Hannað / Designed                      | SK             |
| Talkn nr. / Drawn                      | UDM/BBJ        |
| Verktaki / Supplier                    | GLAMA-KÍM      |
| Talkn nr. verktaka / Supplier drwn no. | A01.05         |
| Samþykkt / Approved                    | Yfir / Chkd SK |
| Hluti af / Part of:                    |                |

AFRIDLAEILDIR OG VIÐBÓTARAFRÍÐILL  
VIÐBÓTARAFRÍÐILL, MHL. 79  
GRUNNMYND, SNEIDINGAR, ÚTLIT

Teikningar / Dwg. type: AÐALUPPRÁTTUR  
Architectural: Building Application

**RioTinto Alcan**

Alcan Iceland Ltd  
Ströumsvík  
IS-222 Hafnarfjörður  
Ísland

|                                    |                    |                  |
|------------------------------------|--------------------|------------------|
| Flökkur nr. /                      | Bláð nr. /         | Núasta bl. nr. / |
|                                    |                    |                  |
| Kostn. nr. / Cchn. /               | Búh. nr. / Eq. no. |                  |
| 4011                               | n/a                |                  |
| Teikn. nr. ISAL / Dwg. no. of ISAL | Breyti / Rev       |                  |
| 250396                             | A                  |                  |

ISAL Yfirfánð og skráð, dags / ISAL Checked, date ISAL Samþykkt, dags / ISAL Approval, date