


Skráningartafla: Dreifistöð 140 - Alcan á Íslandi hf					Skrásetjari: Axel Rüdólfsson													
Landnúmer: 123154					Kennitala: 220663-3969													
Matshlutanúmer: 94					Útgáfa: 4.01b Dags: 3/13/2012													
Uppskipting og lýsing					Stærðir													
D0	D1	D2	D3	D4	D5	D5M	D6	D7	D8	D9	D10a	D10b	D11	D12	D16	Reiknitala	D17	
Lokun	Rými hæð-roð	Notkun texti	Höfuð-flokkun	Eignar-hald	Botnfötur m²	Millifötur m²	Stigar m²	Op m²	Brúttufötur m²	Brúttufötur sh < 1,8	Salarhæð min	Salarhæð max	Brúttó rúmmál m³	Nettofötur m²	Birt flatarmál m²	Reiknitala skiptarúmmála	Skiptarúmmál m³	
<b>Matshluti</b>					410,3	0,0	0,0	0,0	410,3	0,0				1.535,2	0,0	0,0		0,000
<b>Botn</b>														48,9				
<b>1. hæð</b>					244,3	0,0	0,0	0,0	244,3	0,0				768,4	0,0	0,0		
A	0101	1. hæð kapaikjallari	I	0201	166,0				166,0		2,00	2,00	332,0					
A	0102	spennir	I	0201	24,2				24,2		5,19	6,16	135,6					
A	0103	spennir	I	0201	22,9				22,9		5,19	6,16	128,7					
A	0104	spennir	I	0201	23,3				23,3		5,19	6,16	130,7					
A	0105	stöðvarspennir	I	0201	7,9				7,9		5,19	5,30	41,4					
C	0106	tröppur	I	0201	9,3				9,3									
<b>2. hæð</b>					166,0	0,0	0,0	0,0	166,0	0,0				717,9	0,0	0,0		
A	0201	dreifistöð 140	I	0201	166,0				166,0		3,99	4,50	717,9					
C	0202	tröppur/pallar	I	0201	15,9				15,9									
<b>Athugasemdir</b>																		
Dreifistöð rafmagns sem þjónar þurrheinsistöðvum 1.2 og 3. Burðarvirki og milligölf staðsteypt, veggir forsteyptir, þak úr holplötum. Oilupræur 0,8 m. á dýpt í spennarytum 0102, 0103 og 0104, mynda botn og rúmmál í rýmum.																		
<b>Samelgnir sumra</b>																		
<b>Eignarhald</b>																		
	Eignar-hald	Notkun texti	Birt flatarmál m²	Skiptarúmmál Séreign m³	Séreign og sameign m³													
	0201	dreifistöð 140	0,0	0,000	0,000													
	<b>Alls</b>		0,0	0,000	0,000													

1 SKRÁNINGARTAFLA

Skýringar:  
Legend:

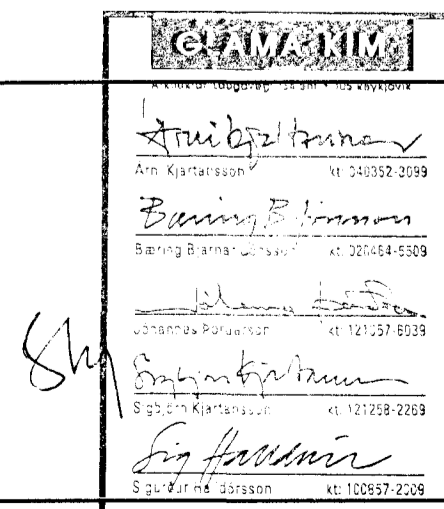

Ug nr	Rev no	Lysing Description	Dagsetning Date	Hau/Tkn Des/Drw	Yfir Ckd	Nok heim Suppl Rel	Nok heim ISAL Rel
A		As Built	09.03.2012	SK	SK		

This drawing is the property of Rio Tinto Alcan Iceland Ltd. and handed out for personal use only. It may neither be copied nor made available to others without permission of Rio Tinto Alcan Iceland Ltd. The receiver is liable for any misuse.

Scale: 1:100  
Dimensions without tolerances according to ISO 2768-1 medium.



Dagsetning / Date	01.09.2010
Hannað / Designed	SKBBJ
Teikn / Drawn	BBJ/SK
Verktaki / Supplier	GLÁMA-KÍM
Teikn.nr.verktaka / Supplier drw.no.	A0.00
Samþykkt / Approved	Yfir / Chkd AK
Hluti af / Part of:	

IDP-212 SUBSTATION 140  
DREIFISTOÐ  
SKRÁNINGARTAFLA

Teikningar / Dwg. type: **ADALUPPDRÁTTUR**  
Architectural Building Application

**RioTinto Alcan**

Flokkur nr.:	Bláð nr.:	Næsta bl. nr.:
Kostn.nr.-Cchn. / Bún.nr.-Eq.no	4011 16406	
Teikn.nr. ISAL /Dwg.no of ISAL	Breyt./Rev	
251401	A	