




1 SNEIÐING A  
mkv. 1:100

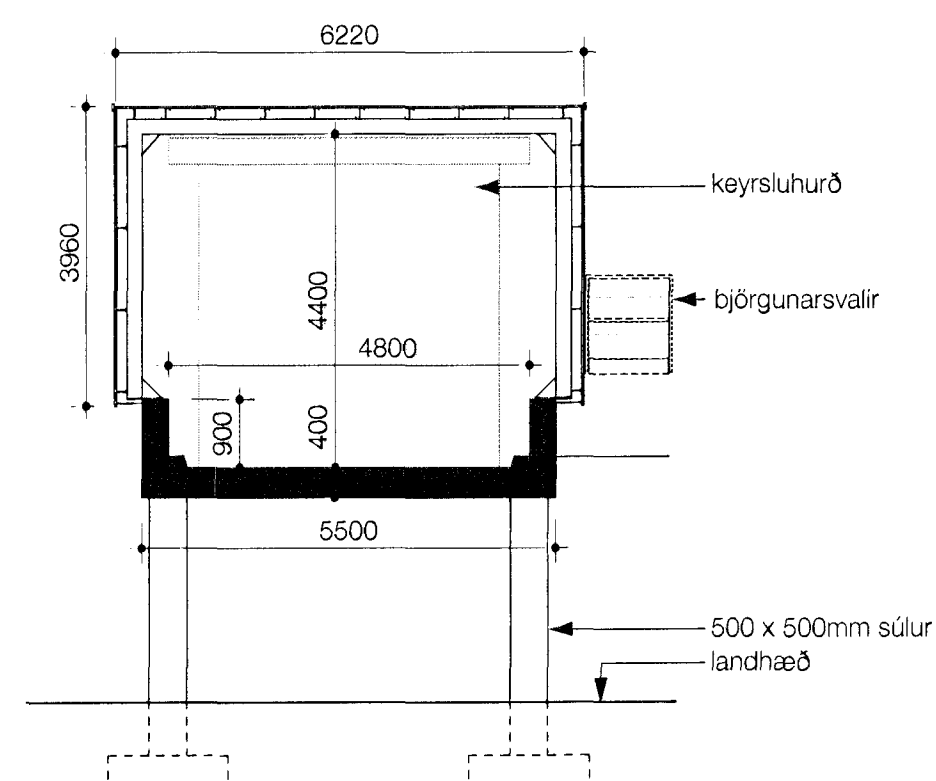


2 SNEIÐING B  
mkv. 1:100

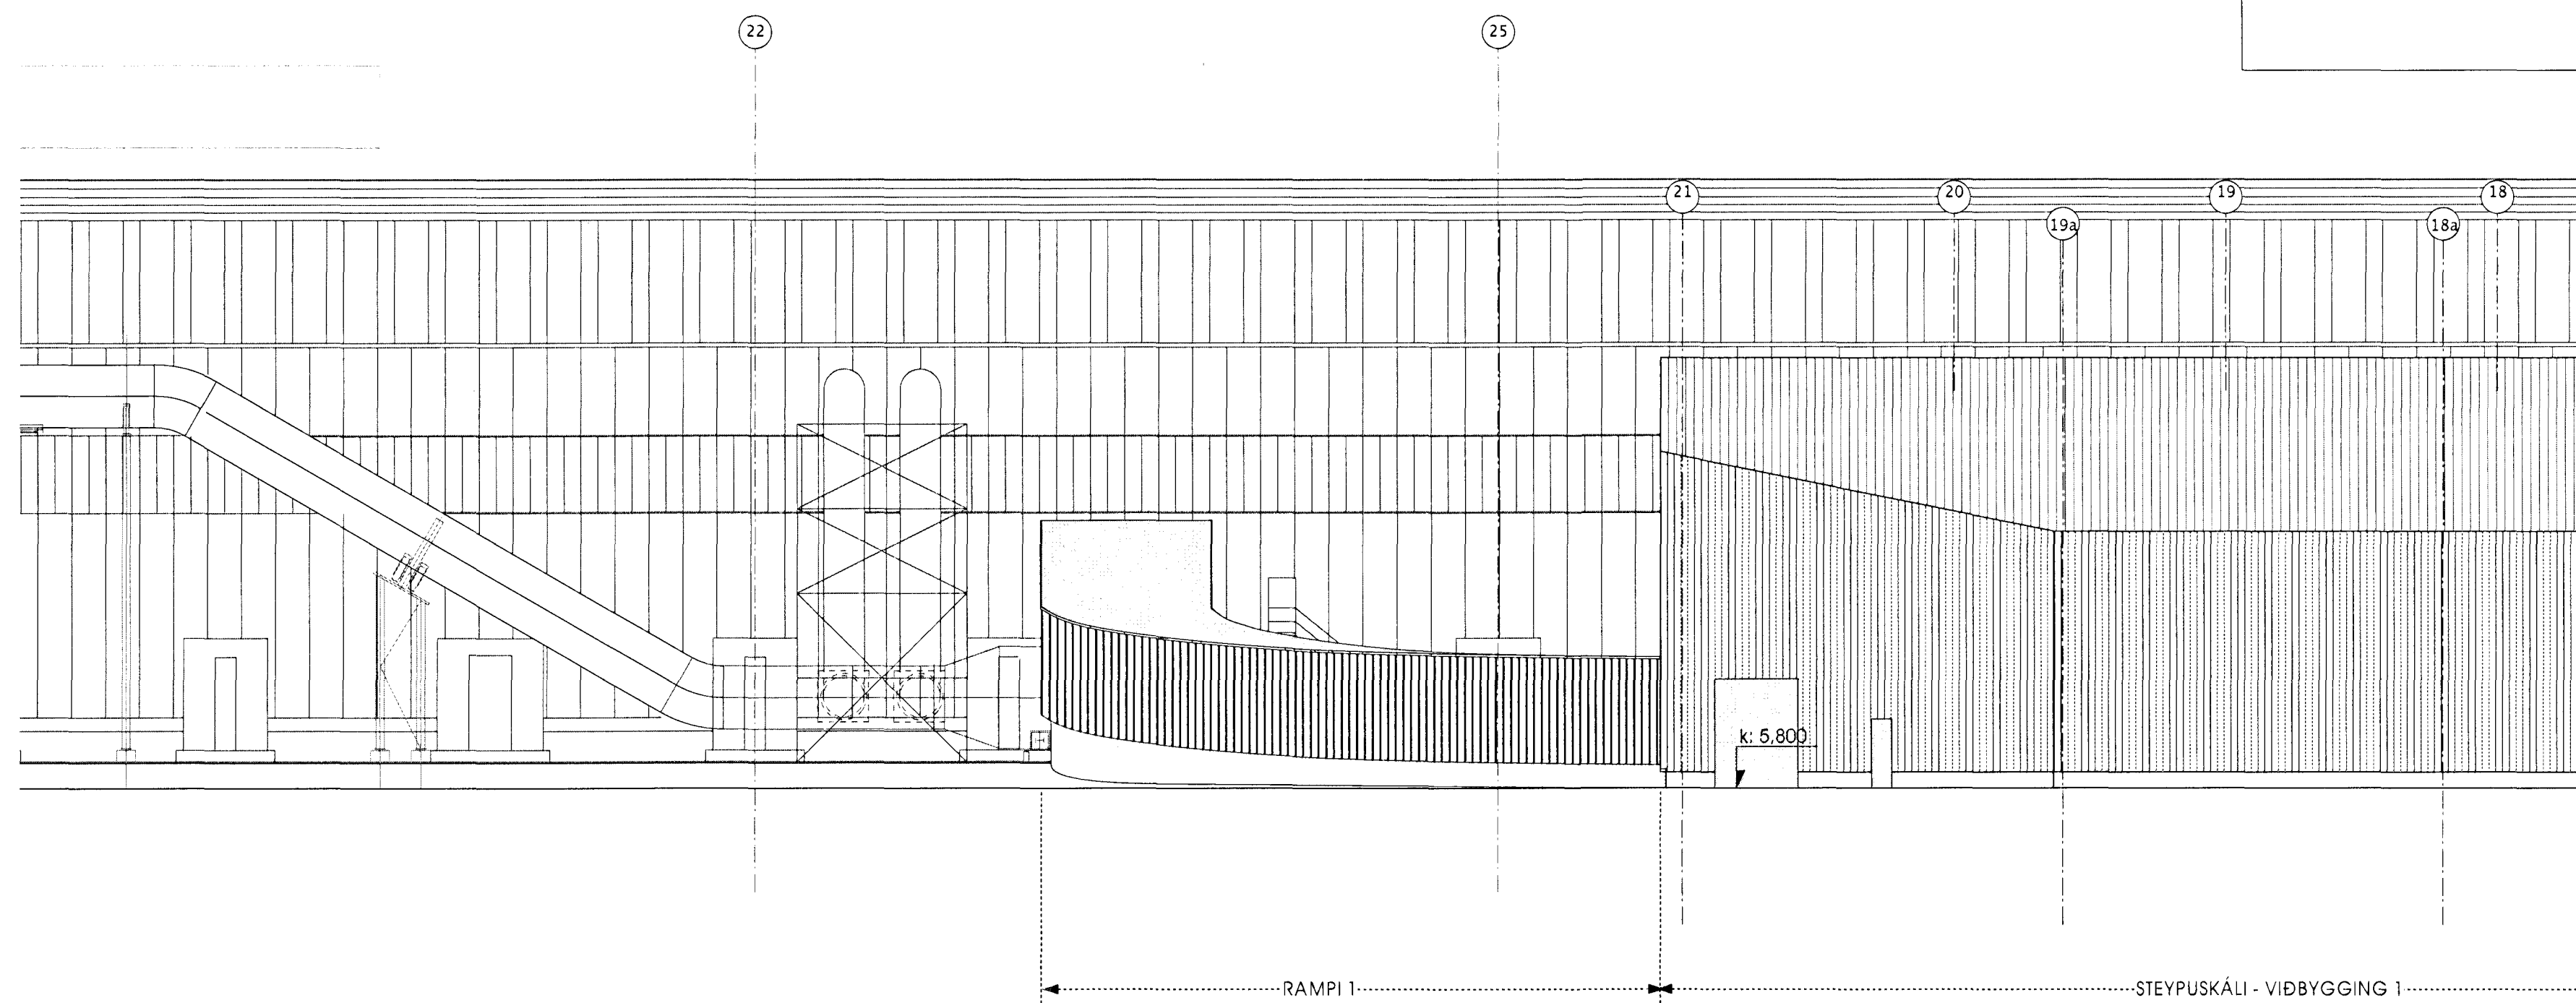

3 ÚTLIT NORÐAUSTUR  
mkv. 1:200

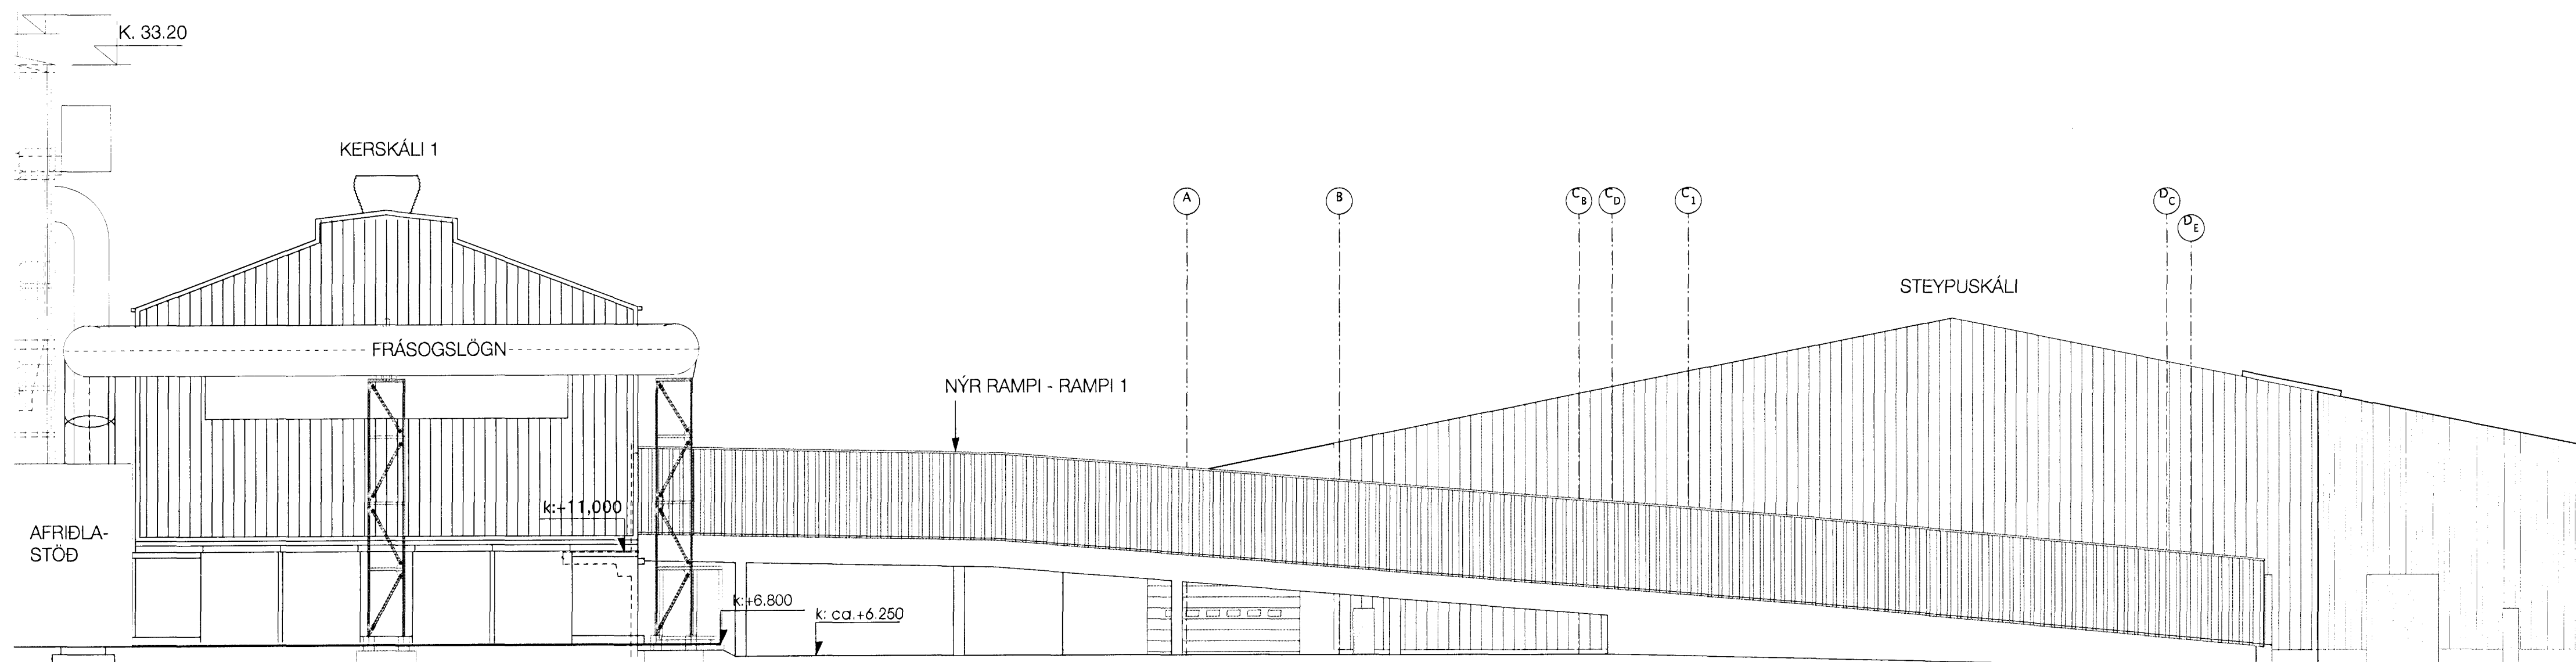


4 ÚTLIT NORÐVESTUR  
mkv. 1:200

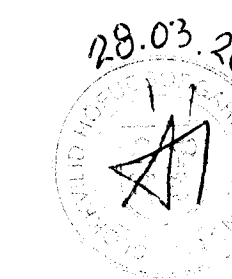

ATH:  
HK= HÆÐAKÓTAR Á HÆSTU PUNKTUM  
VIÐKOMANDI MANNVIRKIS  
Í HÆÐARKERFI HAFNARFJARÐAR



Skýringar:  
Legend:

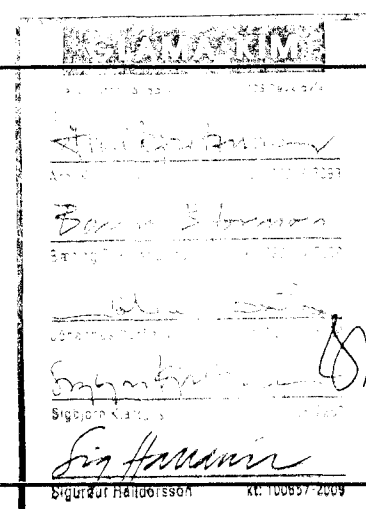

Útg nr / Rev no	Lýsing / Description	Dagsetning / Date	Han/Tkn Des./Dwn	Yfir / Ckd	Notk heim / Suppl Rel	Notk heim / ISAL Rel
A	As built	23.03.2012	SK	SK		

This drawing is the property of Rio Tinto Alcan Iceland Ltd. and handed out for personal use only. It may neither be copied nor made available to others without permission of Rio Tinto Alcan Iceland Ltd. The receiver is liable for any misuse.

Stærð: A1  
Mkv: 1:200  
Formát: Scale: 1:200  
Dimensions without tolerances according to ISO 2768-1 medium.



Dagsetning / Date 24.08.2011	Hannað / Designed SK	Teikn / Drawn UDM/SK
Verktaki / Supplier GLÁMA-KÍM	Teikn nr/verktaka / Supplier draw no. A01.04	Yfir / Chkd SK
Samþykkt / Approved	Hliut af / Part of:	

RAMPI 1 - MILLI STEYPUKÁLA OG KERSKÁLA 1  
SNEIÐINGAR OG ÚTLIT

Fig. teikningar / Dwg. type: ADALUPPDRÁTUR  
Architectural Building Application

**RioTintoAlcan**

Flokkur nr. /	Blað nr. /	Næsta bl. nr. /
Kostn. nr.-Cono. / Bún. nr.-Eq. no. 5010	16957	
AKS UF002		
Teikn. nr. ISAL / Dwg. no. of ISAL 253314	Breyt./Rev. A	