



Sampykkt þann  
18 APR 2012  
Pjetur af Vindinn í Hafnar  
k. Sigurður Steinar Jónsson

INNKEYRSLUHURD

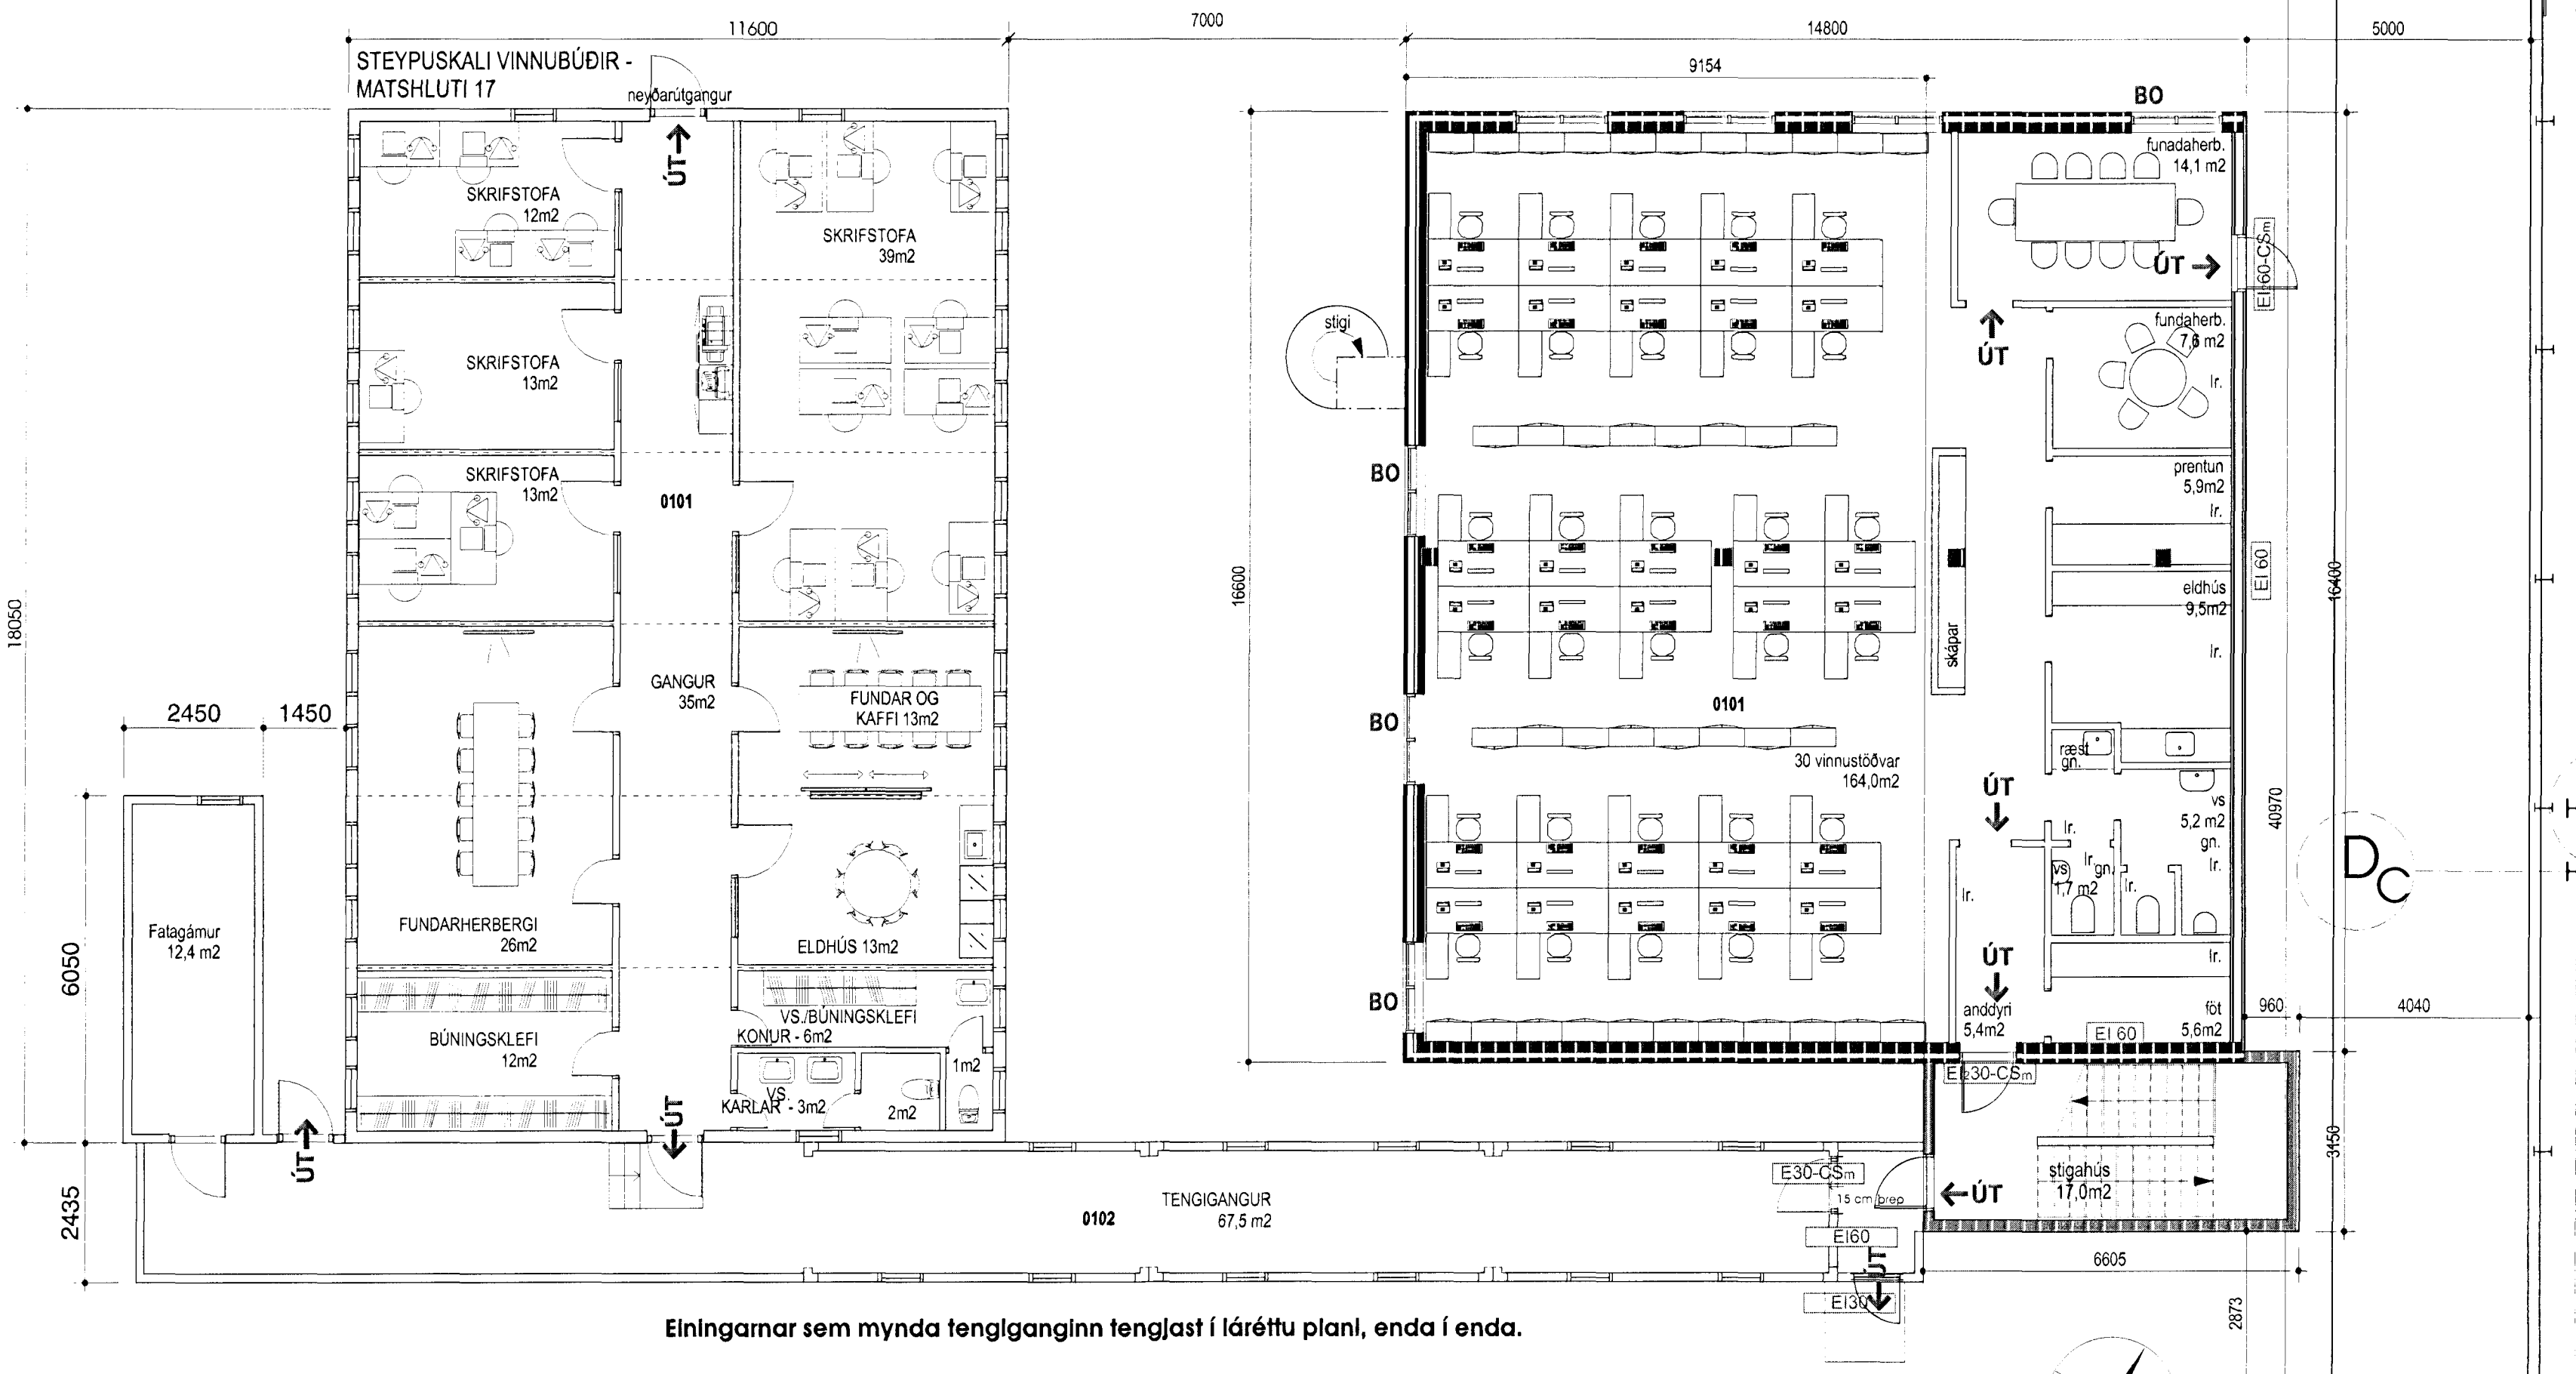


Einingarnar sem mynda tengingann tengjast í láréttu plani, enda í enda.


1 GRUNNMYND 1. HÆÐAR  
mkv. 1:100

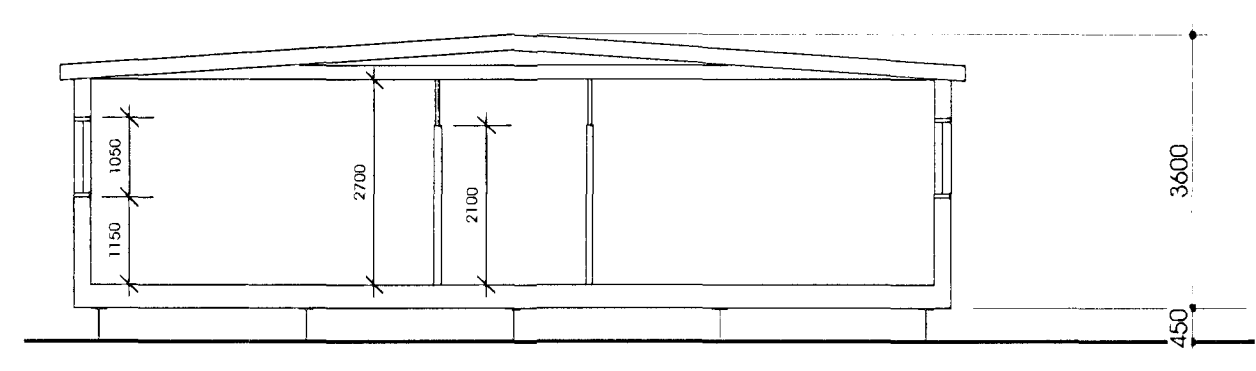


3 Þversneiðing í vinnubúðir  
mkv. 1:100

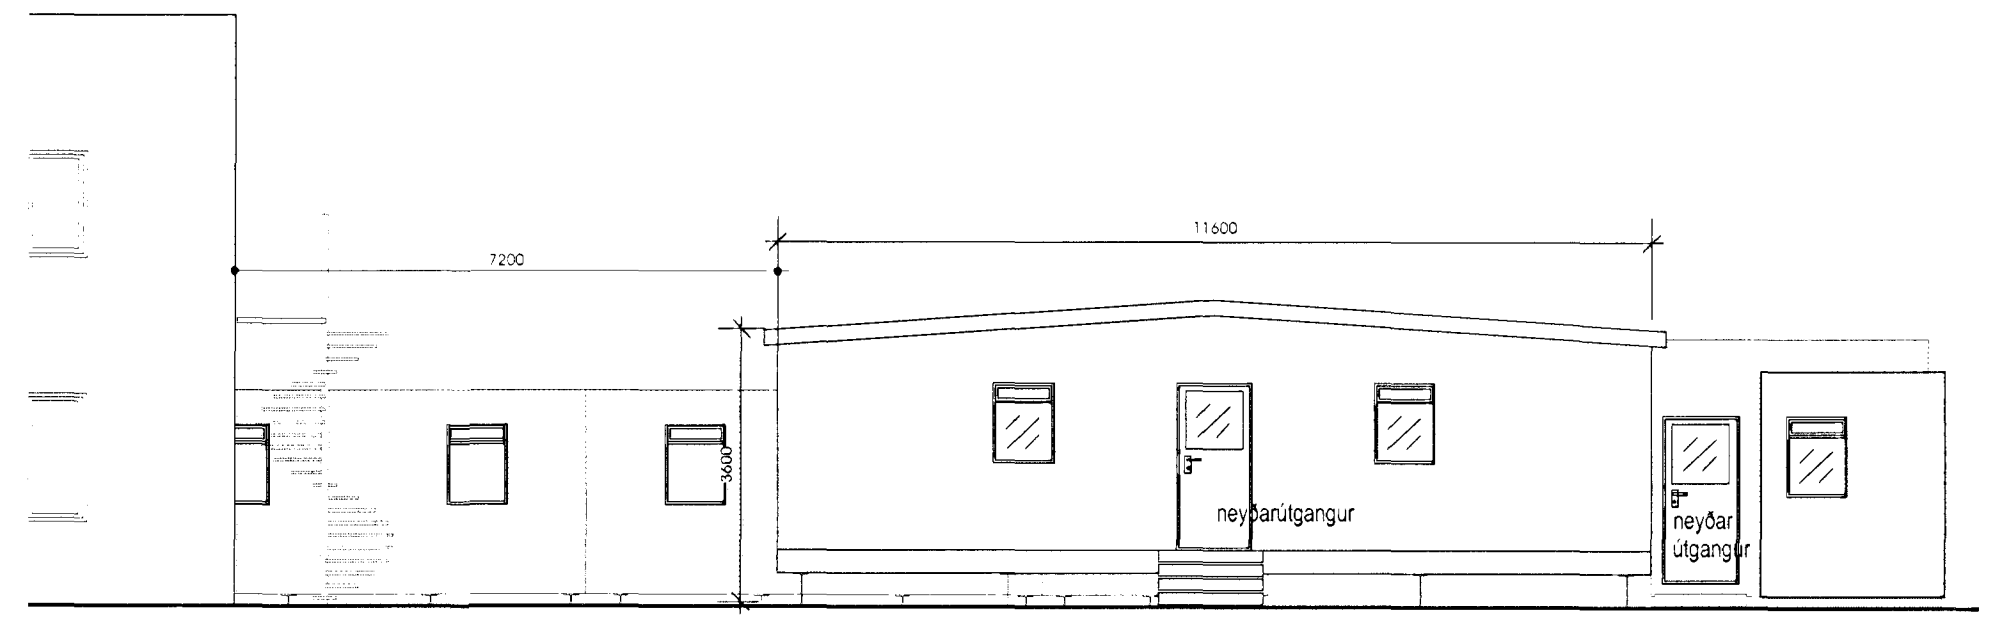

4 ÚTLIT NORÐUR  
mkv. 1:100

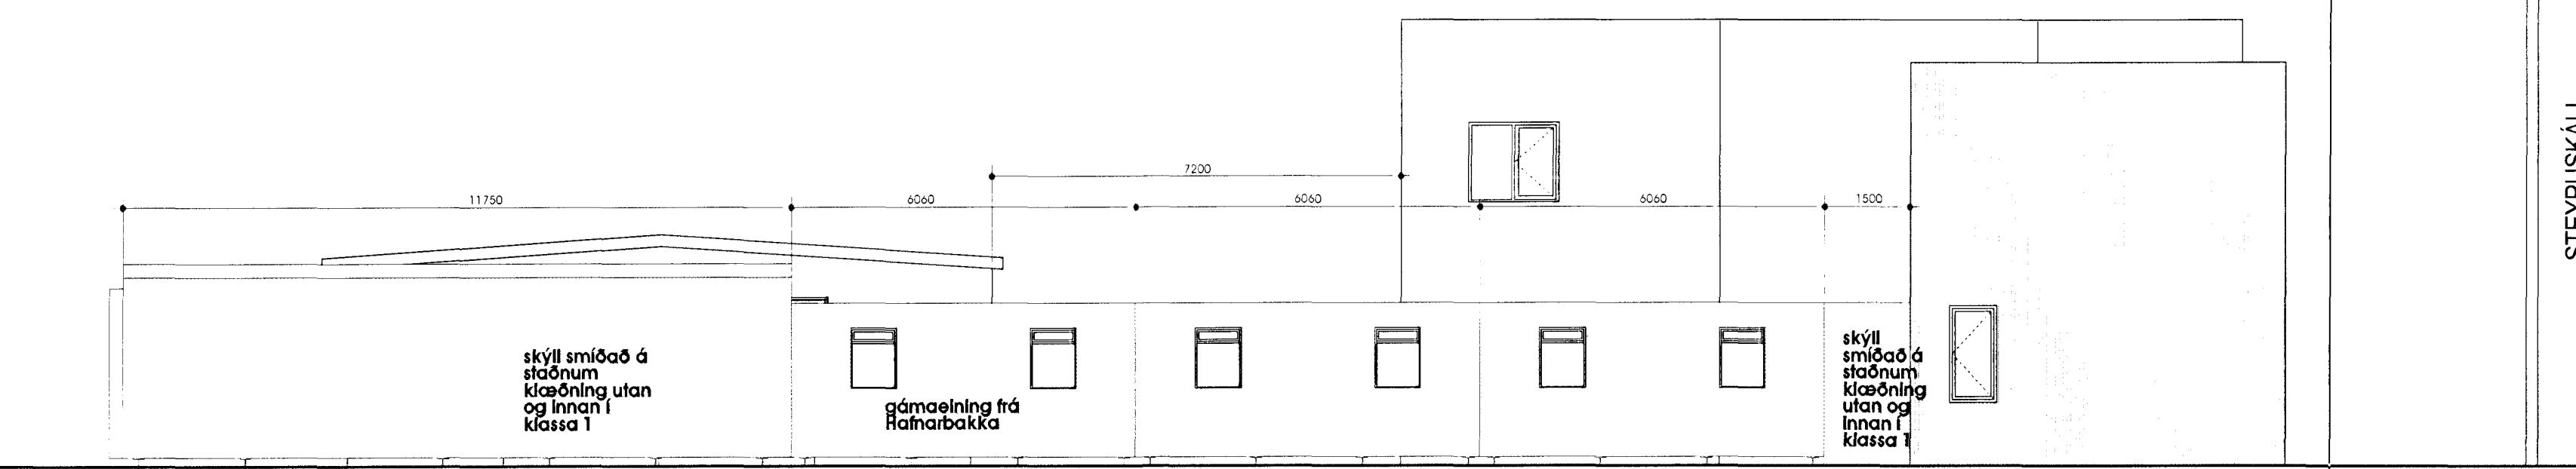

2 ÚTLIT SUÐUR  
mkv. 1:100

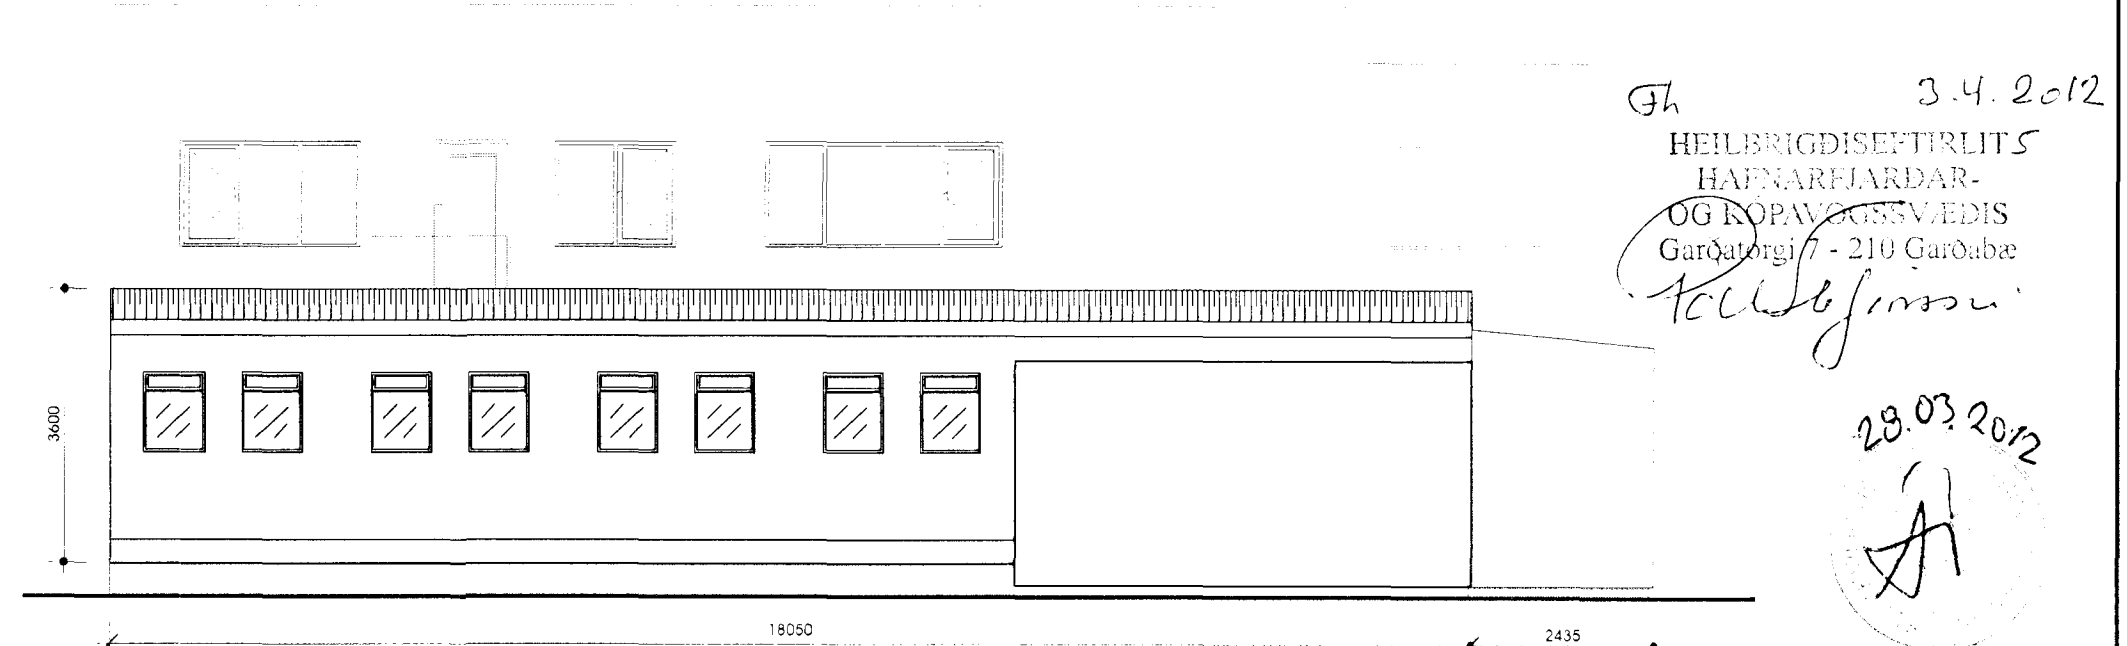

5 ÚTLIT SUÐUR  
mkv. 1:100

3.4.2012  
HEILBRIGÐISEFTIRLIT  
HAFNARLADAR-  
OG ROPAVÆÐISVÆÐIS  
Gæðingur - 219 Gæðingur  
K. Jónsson

28.03.2012  
JA

Skýringar: Legend:		<table border="1"> <tr> <td>Útg nr</td> <td>Revisi</td> <td>Lýsing</td> <td>Description</td> <td>Dagsetning</td> <td>Date</td> <td>Ár/Tkn</td> <td>Dráttur</td> <td>Yfir</td> <td>Chk</td> <td>Nokk heim</td> <td>Suppl Rel</td> <td>Nokk heim</td> <td>ISAL Ref</td> </tr> <tr> <td>A</td> <td>As Built</td> <td></td> <td></td> <td>07.02.2012</td> <td></td> <td>SK</td> <td>SK</td> <td></td> <td></td> <td></td> <td></td> <td></td> <td></td> </tr> </table>	Útg nr	Revisi	Lýsing	Description	Dagsetning	Date	Ár/Tkn	Dráttur	Yfir	Chk	Nokk heim	Suppl Rel	Nokk heim	ISAL Ref	A	As Built			07.02.2012		SK	SK							<p>This drawing is the property of Rio Tinto Alcan Iceland Ltd. and handed out for personal use only. It may neither be copied nor made available to others without permission of Rio Tinto Alcan Iceland Ltd. The receiver is liable for any misuse.</p> <p>Stærð: A1 Format: A1 Mkv.: Scale: 1:100 Dimensions without tolerances according to ISO 2768-1, medium.</p>	<p>ISAL PRODUCTION UPGRADE</p> <p>GLAMA-KIM</p>	Dagsetning / Date 25.10.2011 Hannað / Designed SK Teikn / Drawn KA Væðing / Supplier GLAMA-KIM Teikn.nr./verkataka / Supplier drw.no A01.02 Sampykkt / Approved Yfir / Chkd	STEYPUKÁLI, VINNUBÚÐIR VEGNA ORKUVIRKJA GRUNNMYND, SNEIÐING, ÚTLIT Flokkur nr.: Bláð nr.: Næsta bl.nr.: Kostn.nr.-Ccnr. / Bún.nr.-Eq.no AKS	Tag teikningar / Dwg type: AÐALUPPDRÁTTUR Architectural Building Application ISAL Teikn.nr. ISAL / Dwg.no of ISAL Breyt./Rev A Rio Tinto Alcan Alcan Iceland Ltd Strásmásk IS-222 Hálfaþýpur Iceland
			Útg nr	Revisi	Lýsing	Description	Dagsetning	Date	Ár/Tkn	Dráttur	Yfir	Chk	Nokk heim	Suppl Rel	Nokk heim	ISAL Ref																			
A	As Built			07.02.2012		SK	SK																												
Hluti af / Part of: ISAL Yfirfarð og skráð. dags / ISAL Checked, date ISAL Sampykkt, dags / ISAL Approval, date																																			