


15.04.2011
 Hannasó / Designed
 SK/BBJ
 KABBJ

1 GRUNNMYND 1. HÆÐAR
 m.kv. 1:100

Skýringar:
Legend:

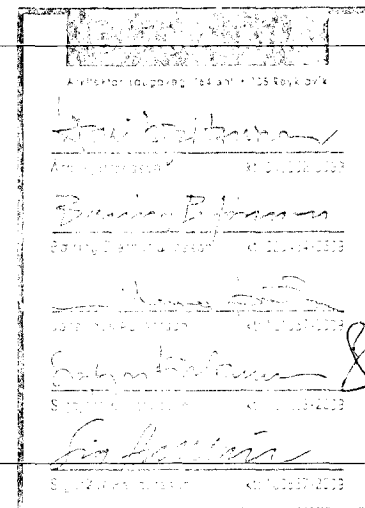

Utg nr / Rev no	Lýsing / Description	Dagsetning / Date	Han/Tkn / Des/Drw	Yfir / Ckd	Neik heim / Suppl Rel	Neik heim / ISAL Rel
A	As Built	07.03.2012	SK	SK		

This drawing is the property of Rio Tinto Alcan Iceland Ltd. and handed out for personal use only. It may neither be copied nor made available to others without permission of Rio Tinto Alcan Iceland Ltd. The receiver is liable for any misuse.



Dagsetning / Date: 15.04.2011
 Hannasó / Designed: SK/BBJ
 KABBJ
 Verktaki / Supplier: GLÁMA-KÍM
 Teikn nr / Drawn: 21.01
 Samþykkt / Approved: Yfir / Ckd SK
 Hlið af / Part of:

STEYPUKÁLI, ÞJÓNUSTUBYGGING
 GRUNNMYND
 Flokkur nr.: Blað nr.: Næsta bl nr.:
 Kostn nr.-Cno. / Bún nr.-Eq.no: 6010 16963
 AKS
 UL6
 BYGGINGARUPPDRÁTTUR
 Architectural Construction Drawing
 ISAL Teikn nr. ISAL/Drw.no. of ISAL Breyt/Rev.
Rio Tinto Alcan
 Straumsvík
 IS-222 Hafnarfordur
 Ísland
 256856 | A
 ISAL Yfirfarið og skráð, dags / ISAL Checked, date ISAL Samþykkt, dags / ISAL Approval, date