



Samþykkt þann
26 OCT 2012
Byggingafræðingur / Architect
Fh. Sigurður Steinmar Kjartansson


Nick Indriáson
Kt. 181144-3949
NS

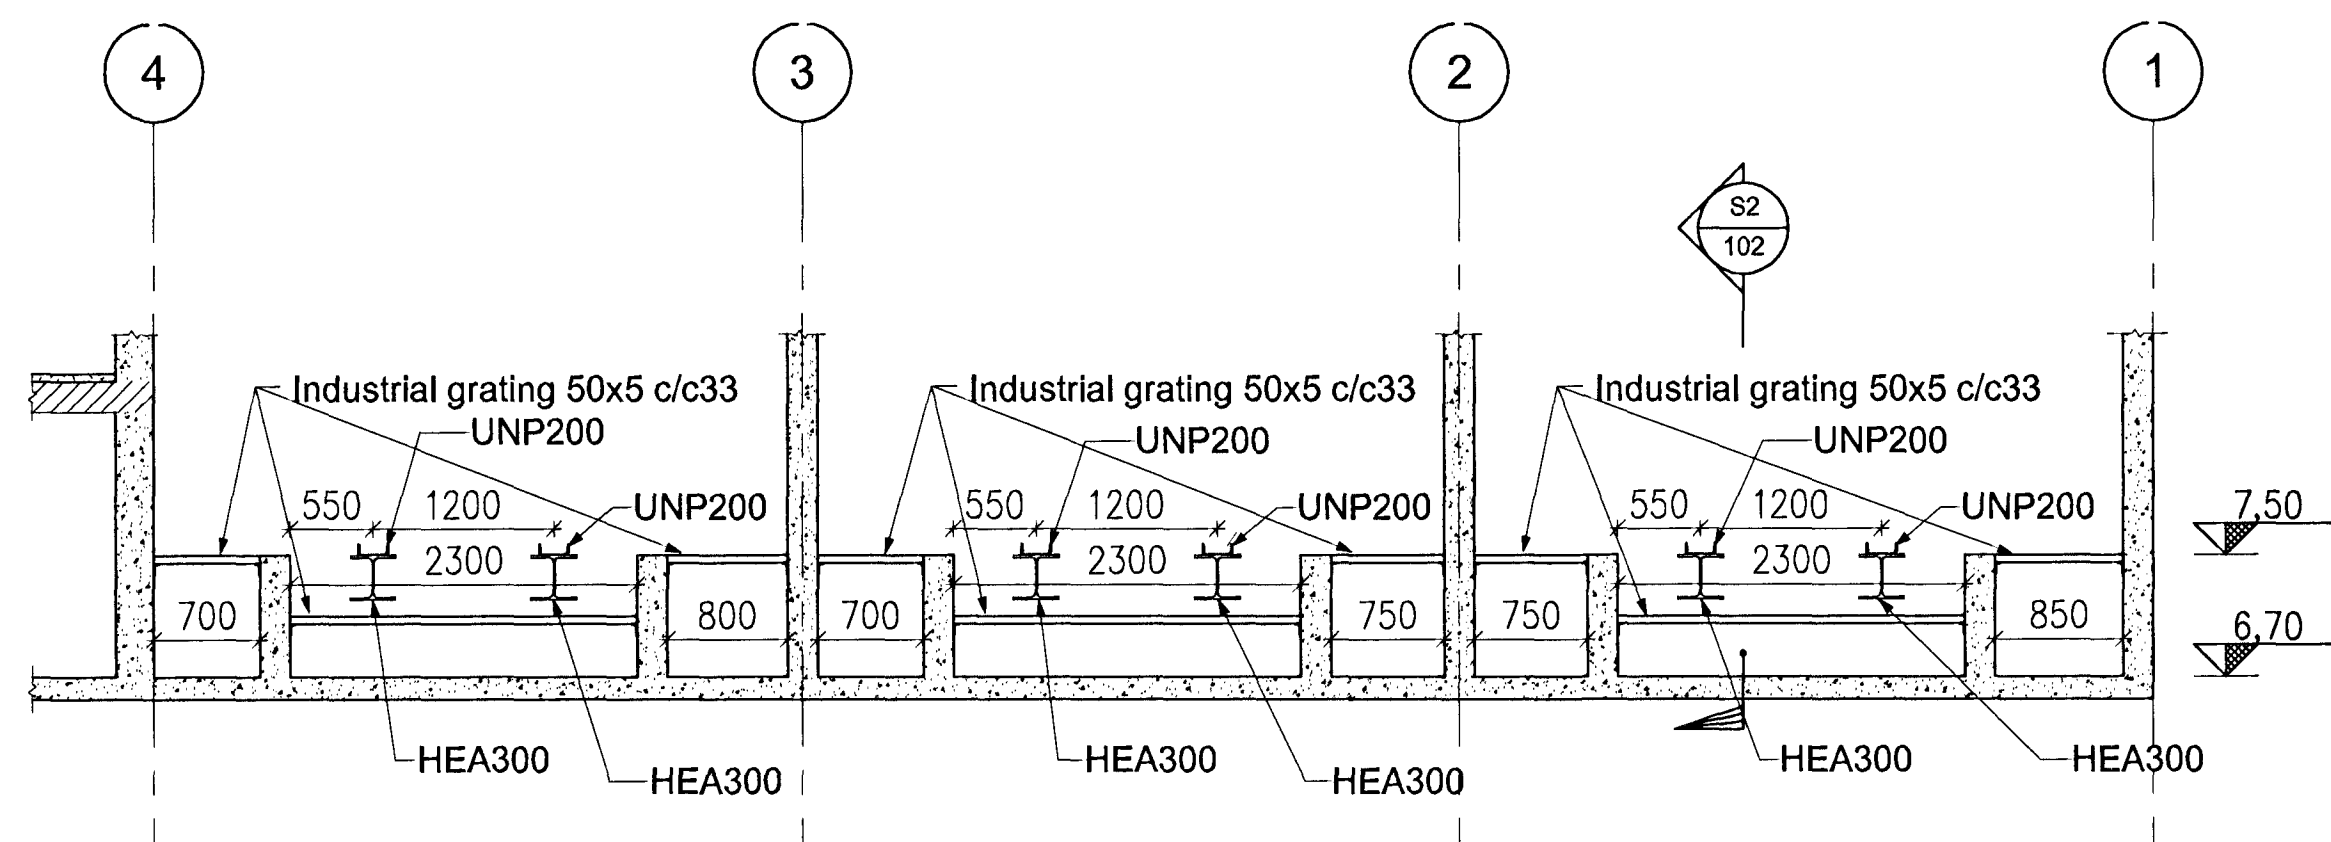


S5 SECTION
101 1:50

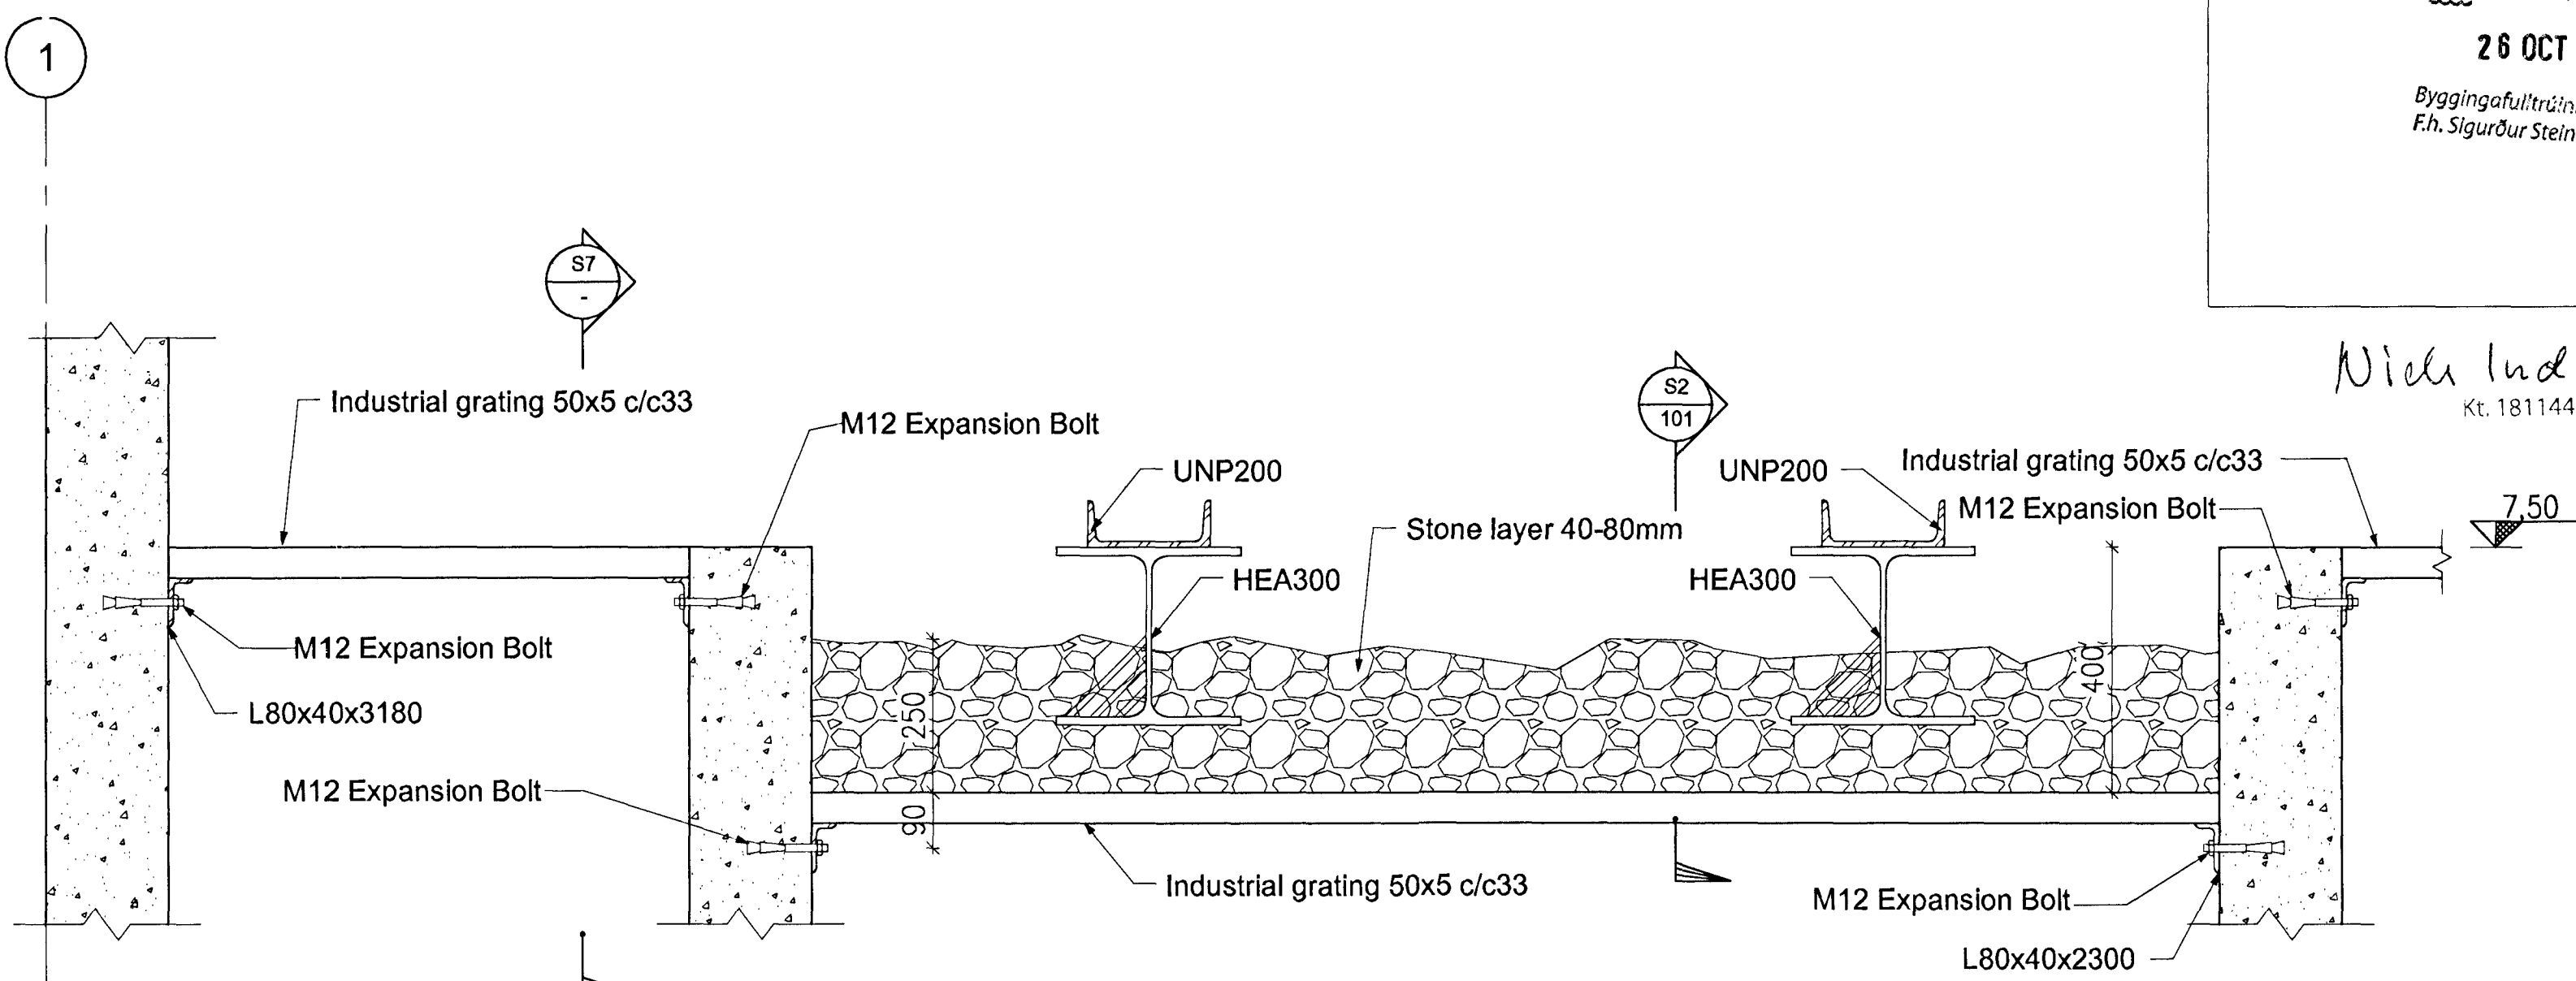

S6 SECTION
101 1:10

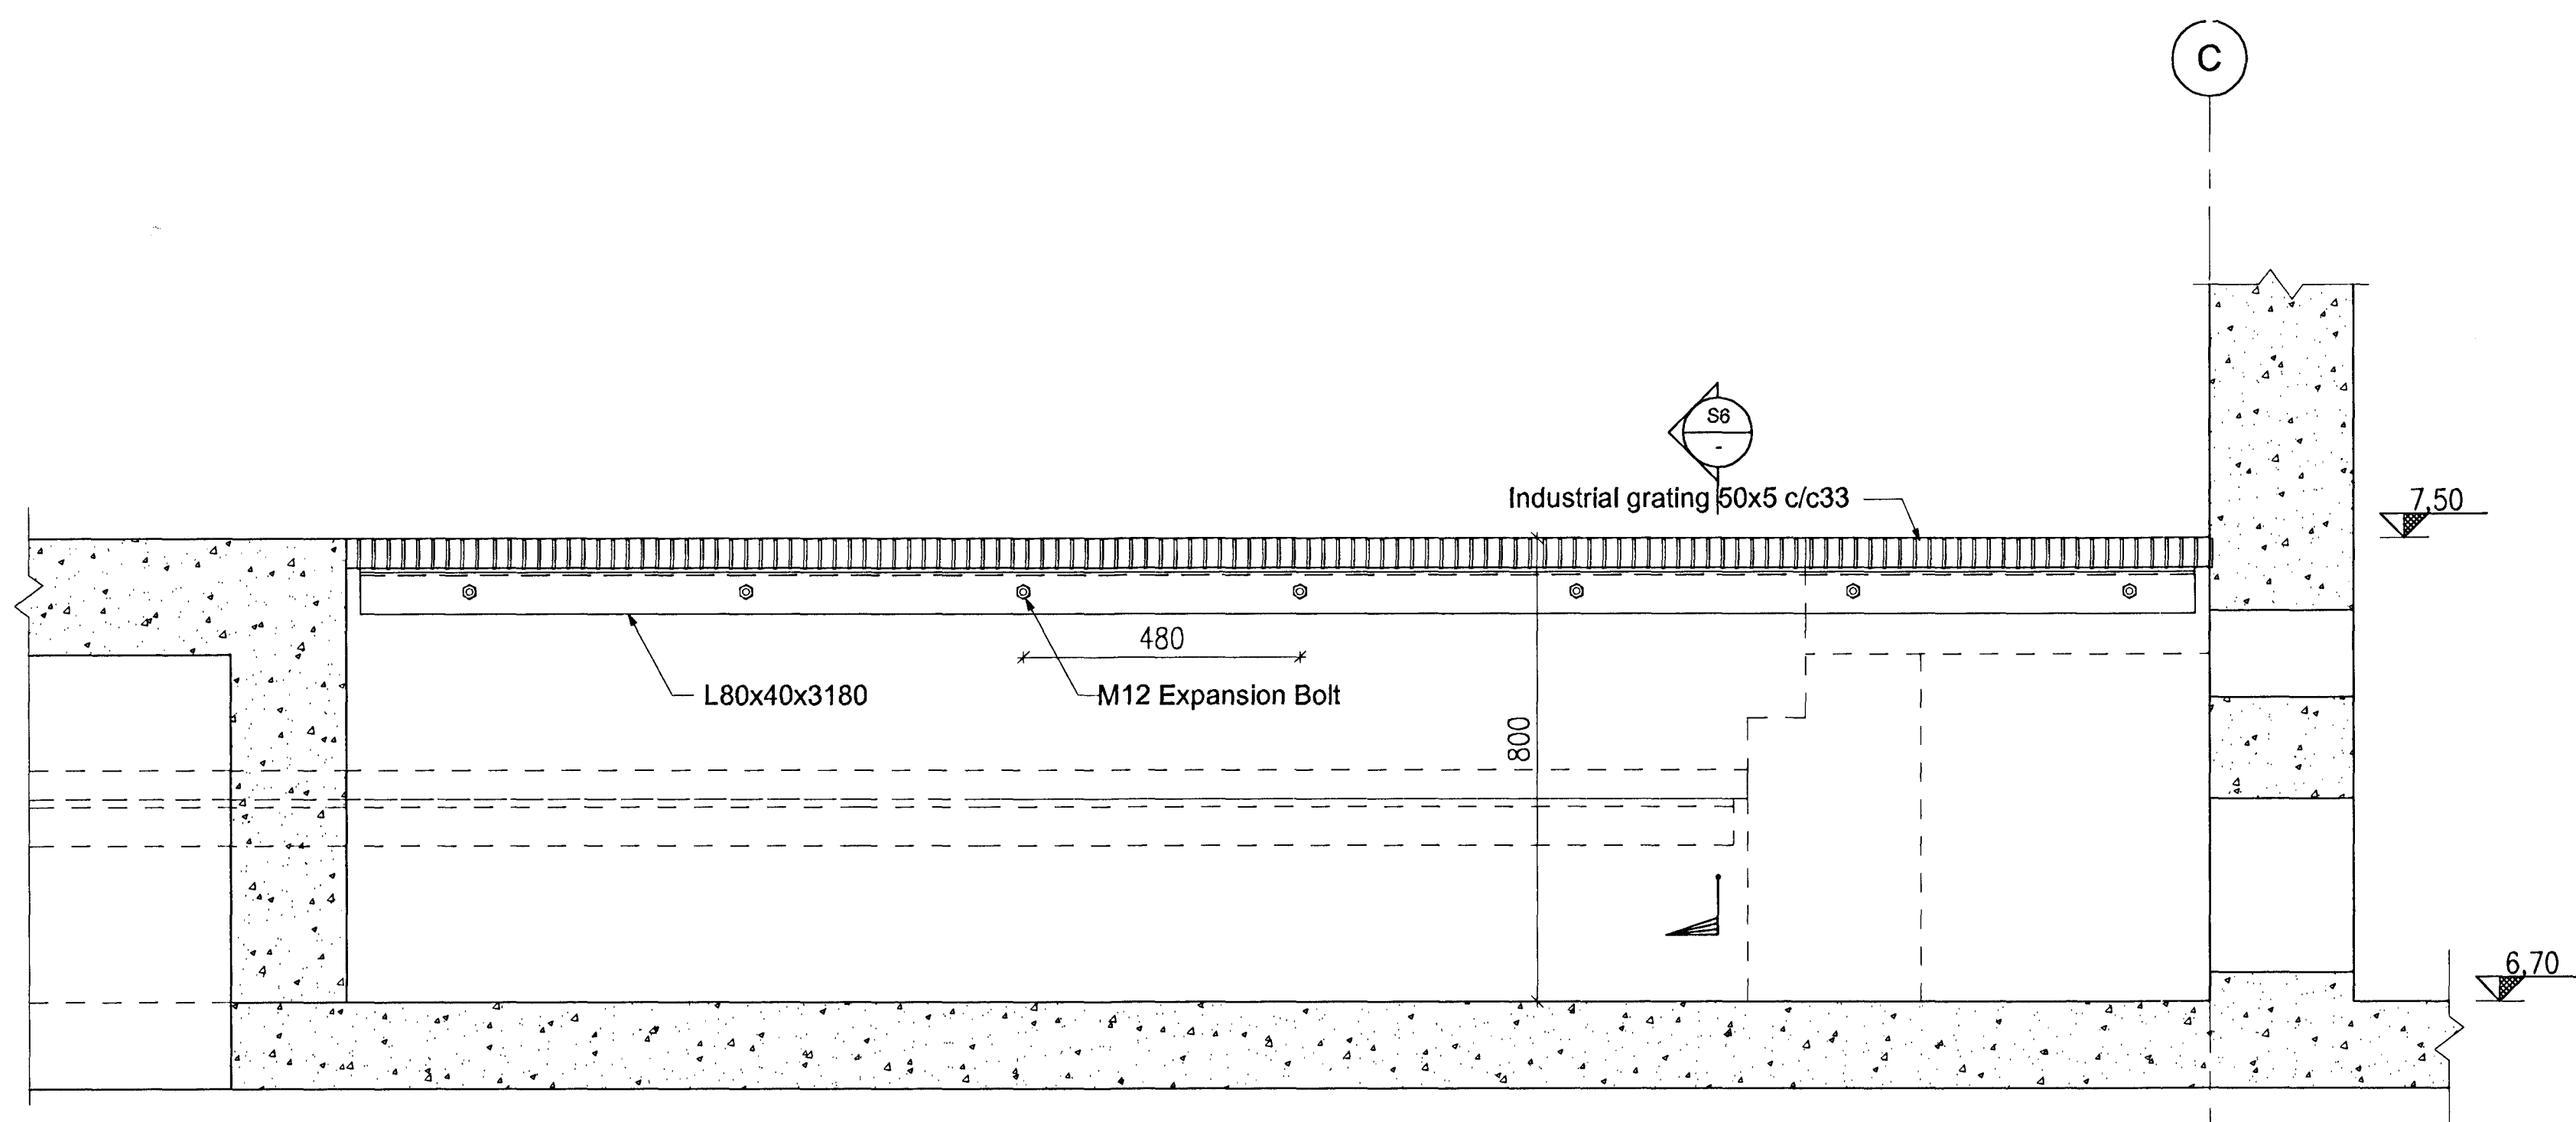

S7 SECTION
101 1:10

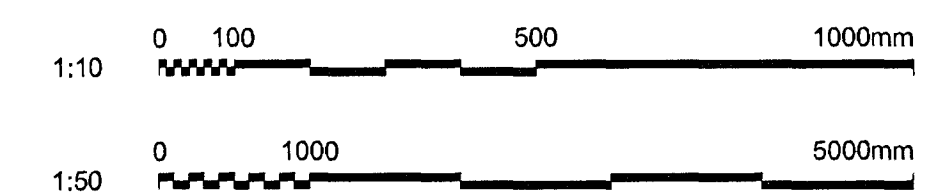

Skýringar:
Legend:

Ólg nr / Rev no	Lýsing / Description	Dagsetning / Date	Har/Re / Des/Drw	Yfir / Old	Notk heim / Suppl Ref	Notk heim / ISAL Ref
5	Record drawing	2012.09.20	CMG	NI	PG	reth

This drawing is the property of Rio Tinto Alcan Iceland Ltd. and handed out for personal use only. It may neither be copied nor made available to others without permission of Rio Tinto Alcan Iceland Ltd. The receiver is liable for any misuse.

Stærð / Scale: 1:10, 1:50
Format: A1
Dimensions without tolerances according to ISO 2768-1 medium.



Dagsetning / Date	2011.02.14
Hiannað / Designed	HFB
Telkn / Drawn	HFB/AFV
Verktaki / Supplier	HRV
Telkn nr. verktaka / Supplier drw.no.	IDP-212-ZA-062-102
Samþykkt / Approved	NI
Yfir / Chkd	HJH
Hluti af / Part of:	

IPU 212 - SUBSTATION 140		Flokkur nr.:	Blað nr.:	Nesta bl. nr.:
CIVIL WORK		Kostn. nr. - Cno. /	Búrn. nr. - Eq. no	
GRATING, SECTIONS		4011	16406	
STRUCTURAL STEEL		AKS	UB140	
RioTintoAlcan		ISAL / Tekn. nr. ISAL / Drw. no. of ISAL	251426	Breyt./Rev. A
		ISAL / Yfirforð og skráð, dags / ISAL Checked, date		ISAL / Samþykkt, dags / ISAL Approval, date