




S1 SECTION  
011 1:50

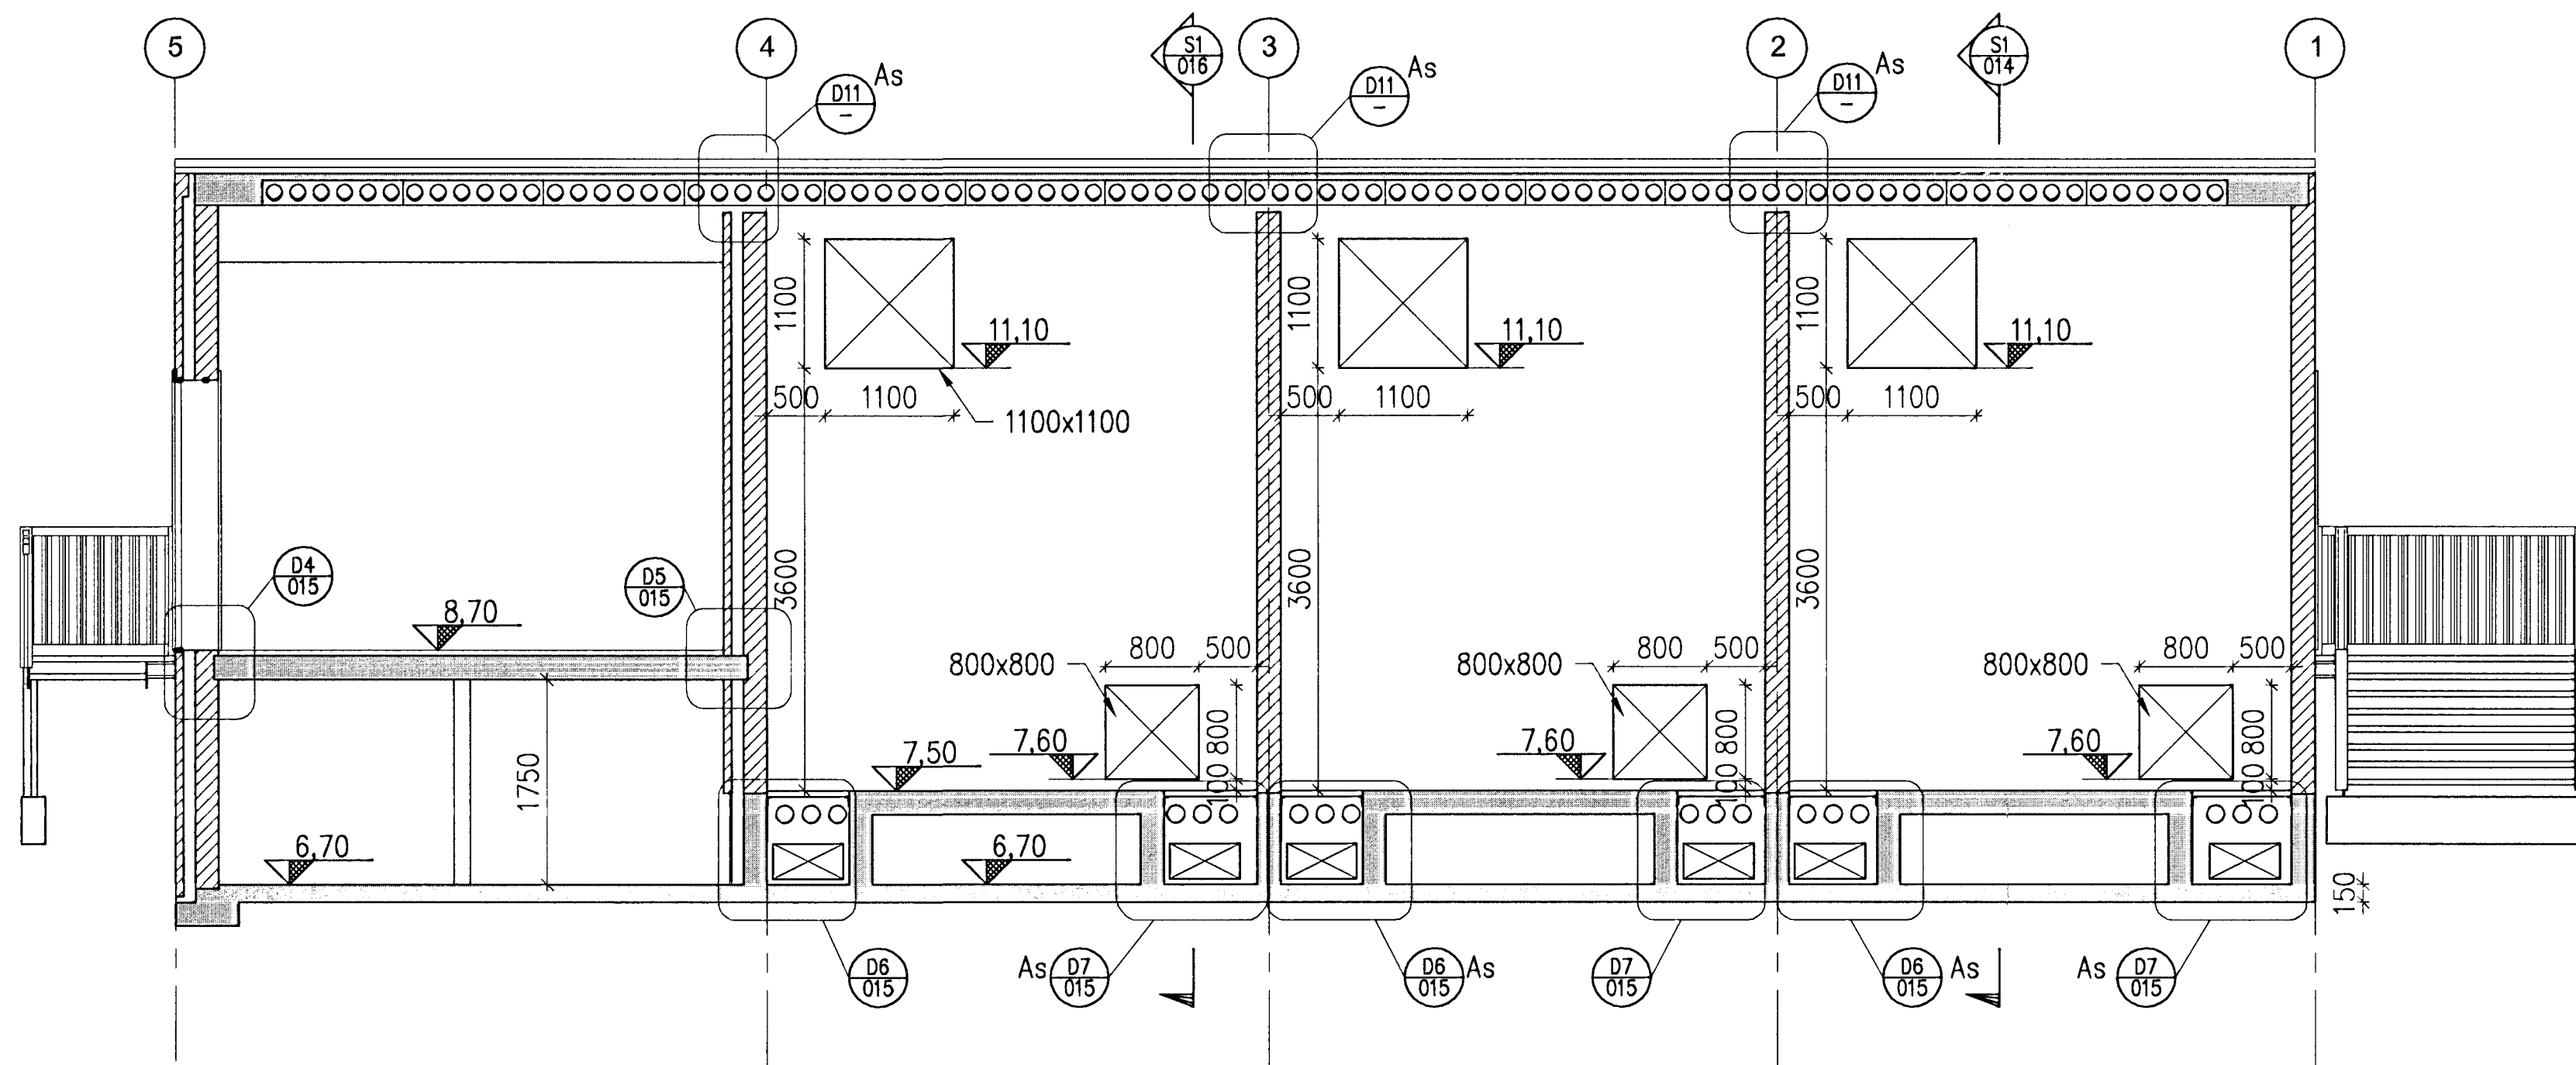


S2 SECTION  
011 1:50

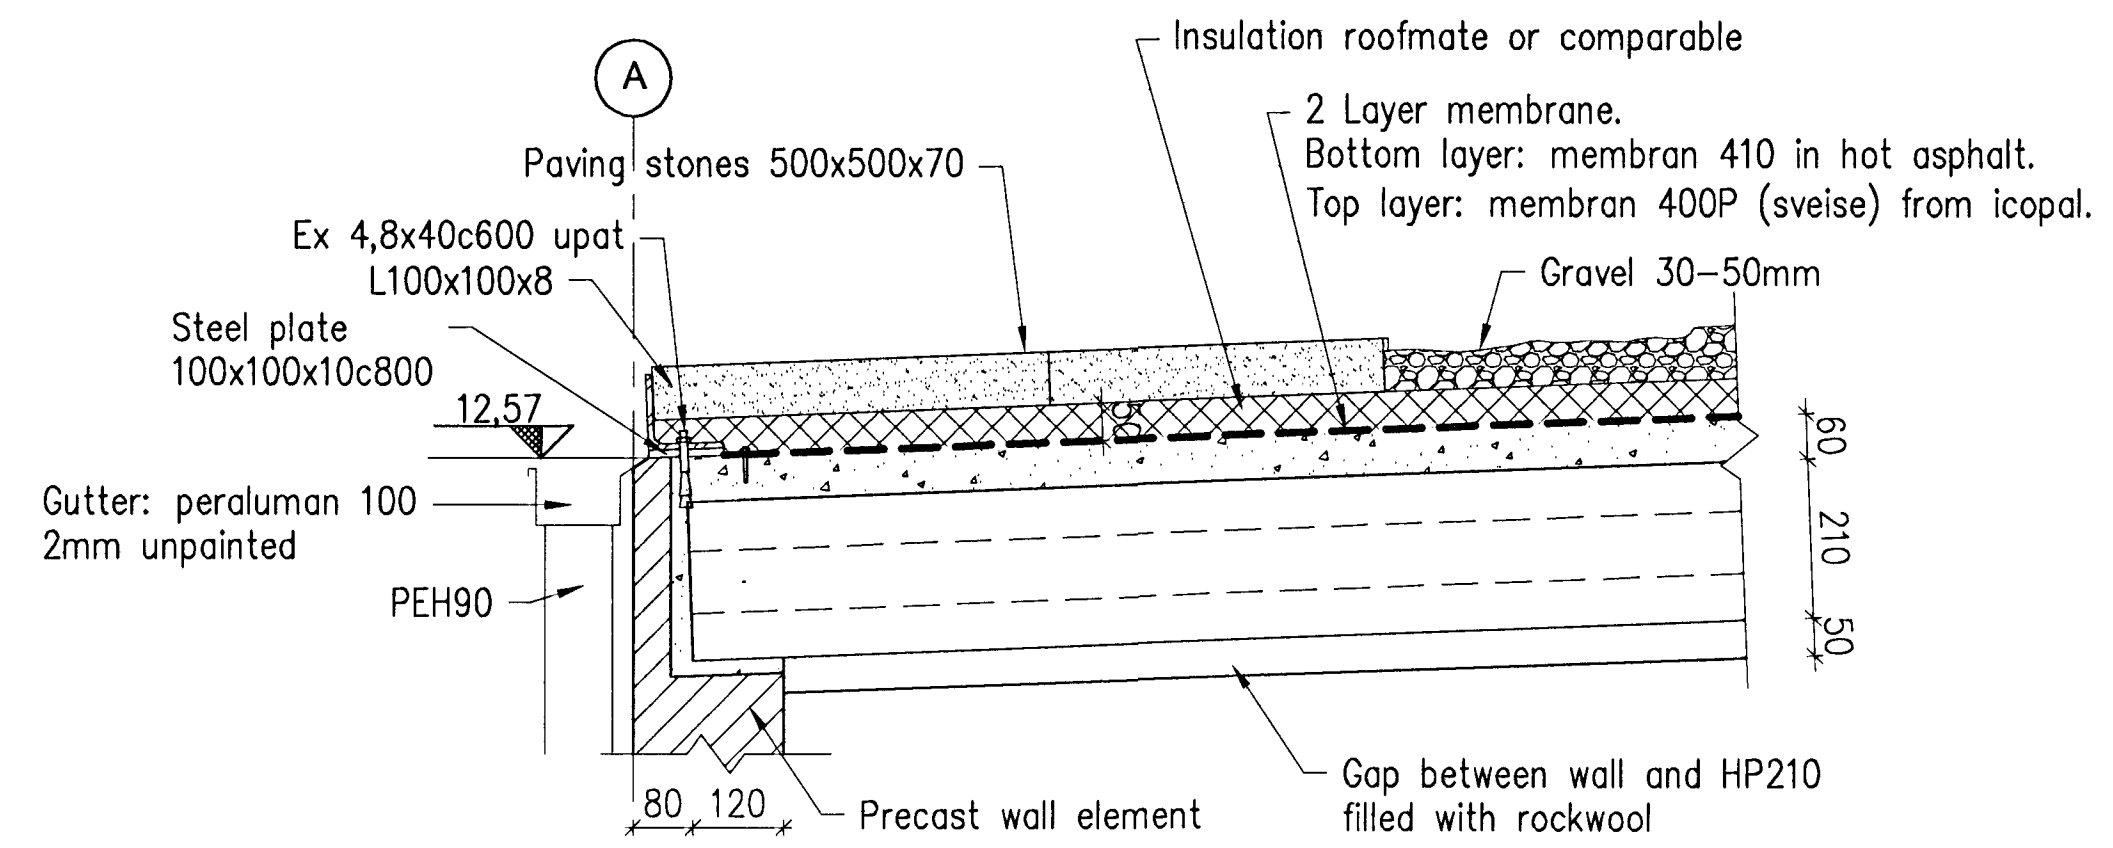


D8 DETAIL  
1:10

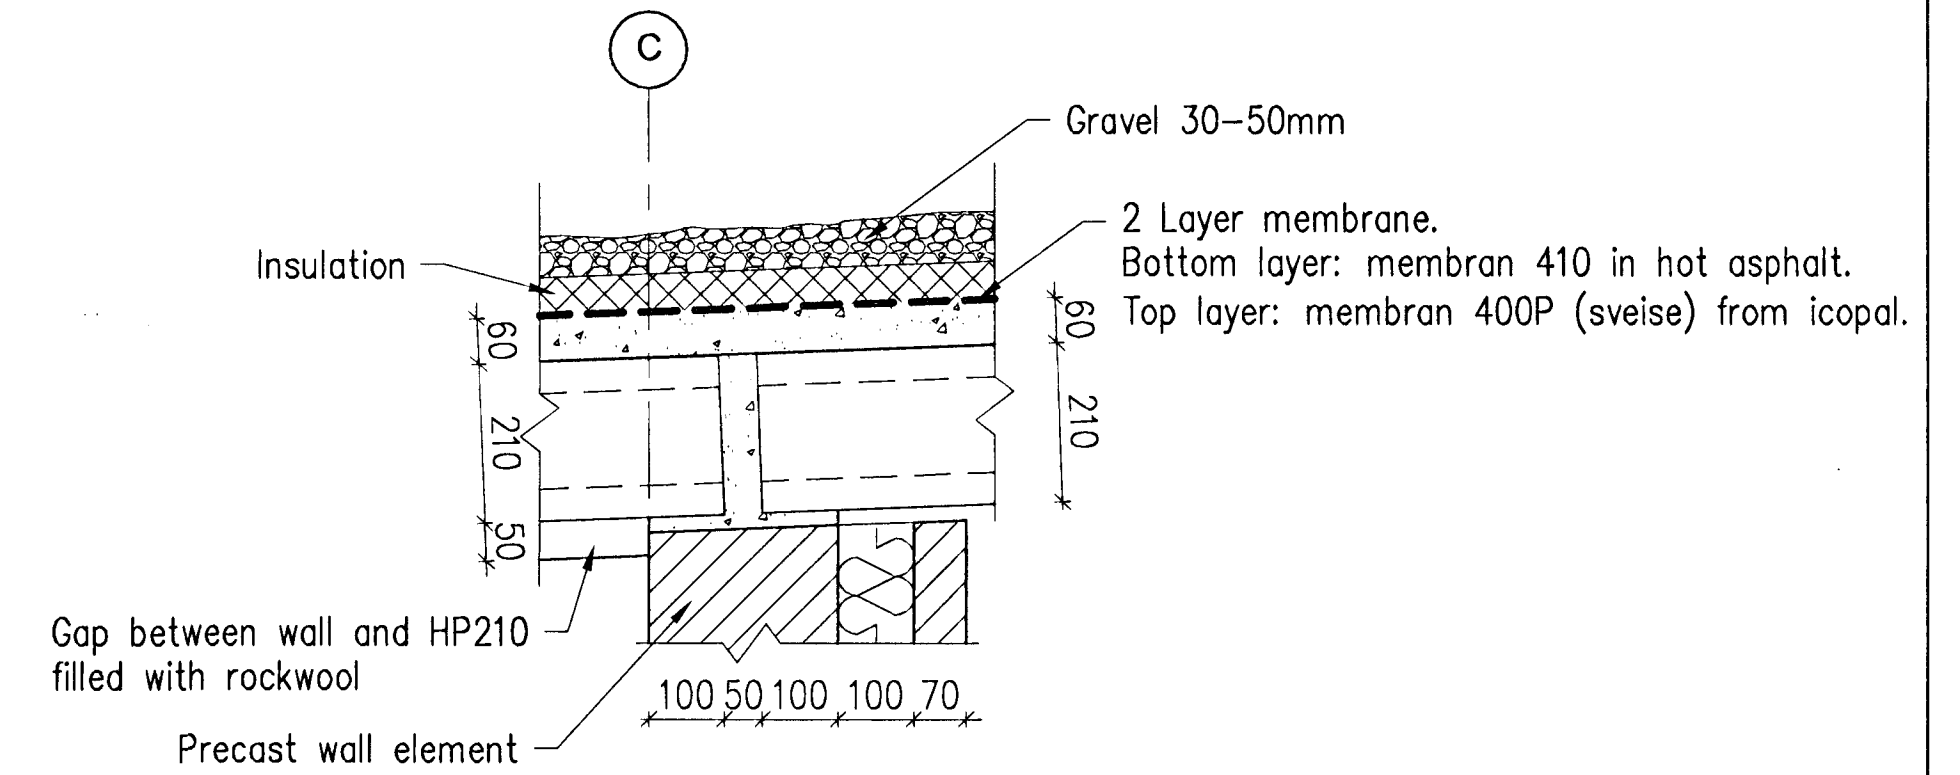


D9 DETAIL  
1:10

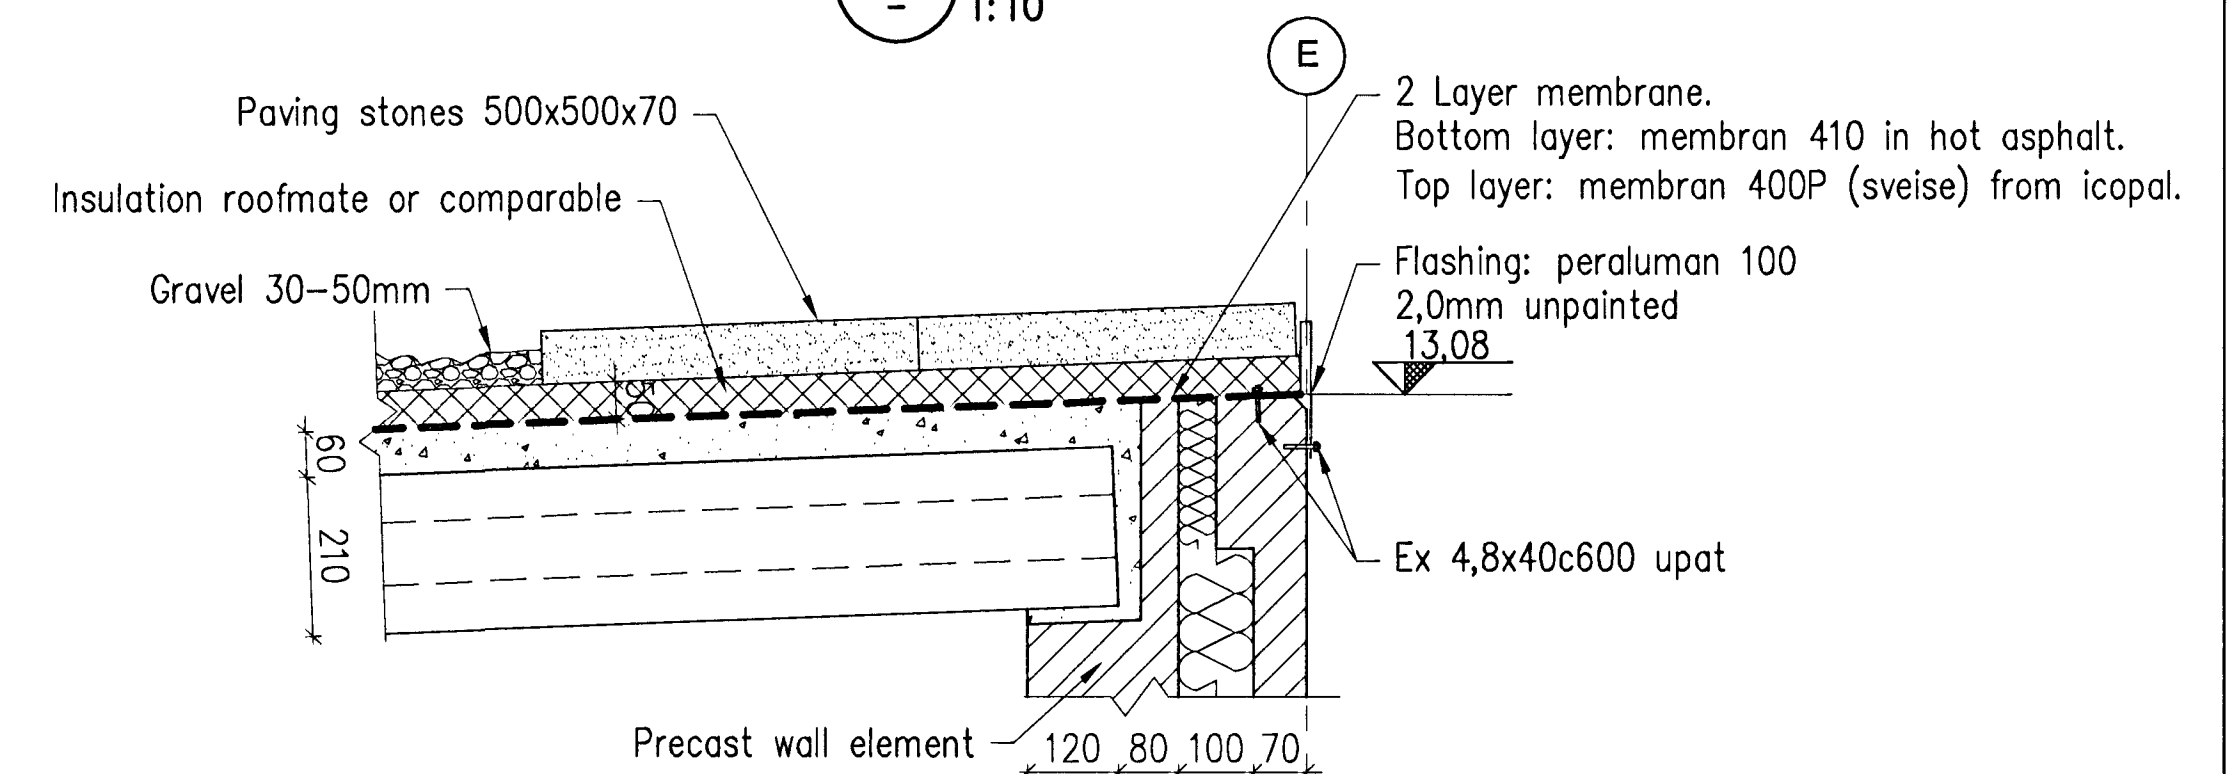

D10 DETAIL  
1:10

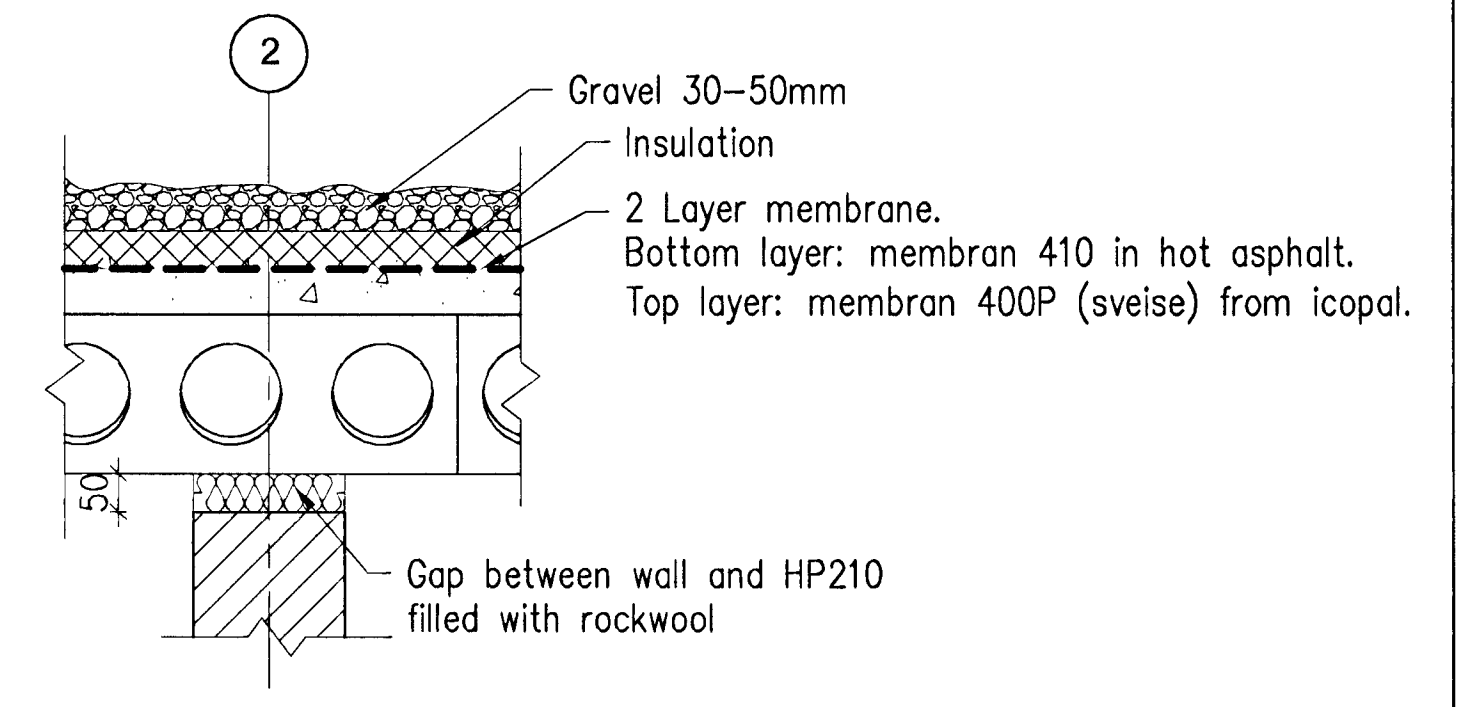

D11 DETAIL  
1:10

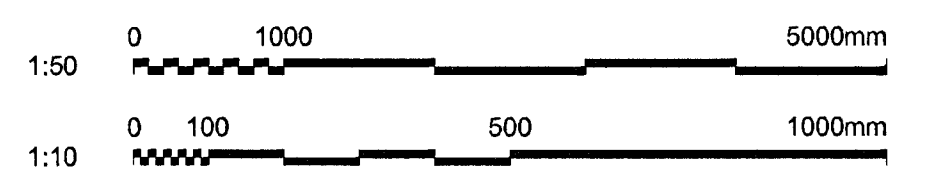


Samþykkt þann  
26 OCT 2012  
Byggingafulltrúinn í Hafnarfirði  
F.h. Sigurður Steinar Jónsson

Níel Indriðason  
Kt. 131144-3949  
NI

Skýringar:  
Legend:  
Prefabricated elements are shown on contractors drawings

6	Record drawing	2012.09.20	CMG	NI	PG	re: >
Ólg nr	Ísling	Dagsetning	Har/Dr	Yfir	Notk heim	Notk heim
Rev no	Description	Date	Des/Drw	Ckd	Suppl Rel	ISAL Rel

This drawing is the property of Rio Tinto Alcan Iceland Ltd. and handed out for personal use only. It may neither be copied nor made available to others without permission of Rio Tinto Alcan Iceland Ltd. The receiver is liable for any misuse.  
Star: A1 Mkv.: 1:50, 1:10  
Formatt: Scales: 1:50, 1:10  
Dimensions without tolerances according to ISO 2768-1 medium.

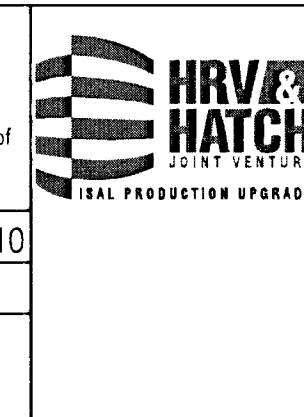

Dagsetning / Date: 2011.02.14  
Hannað / Designed: HFB  
Tækn / Drawn: HFB/AFV  
Varklafi / Supplier: HRV  
Tækn.nr.verktaka / Supplier drw.no: IDP-212-DA-062-014  
Sambúið / Approved: Yfir / Chkd: HJH  
Húti of / Part of:

IPU 212 - SUBSTATION 140		Flokkur nr.:	Blöð nr.:	Nasta bln. nr.:
GENERAL LAYOUT		Kostn.nr.-Cano / Bn.nr.-Eg.no:	4011 16406	
SECTIONS AND DETAILS		AKS		
FORMWORK		UB140		
RioTintoAlcan		ISAL Tækn.nr. ISAL / Drw.no. of ISAL	Breyt./Rev:	A
ISAL Sambúið, dags / ISAL Approved, date		251413		