


Níels Indriðason  
 Kt. 181144-3949  
 NI

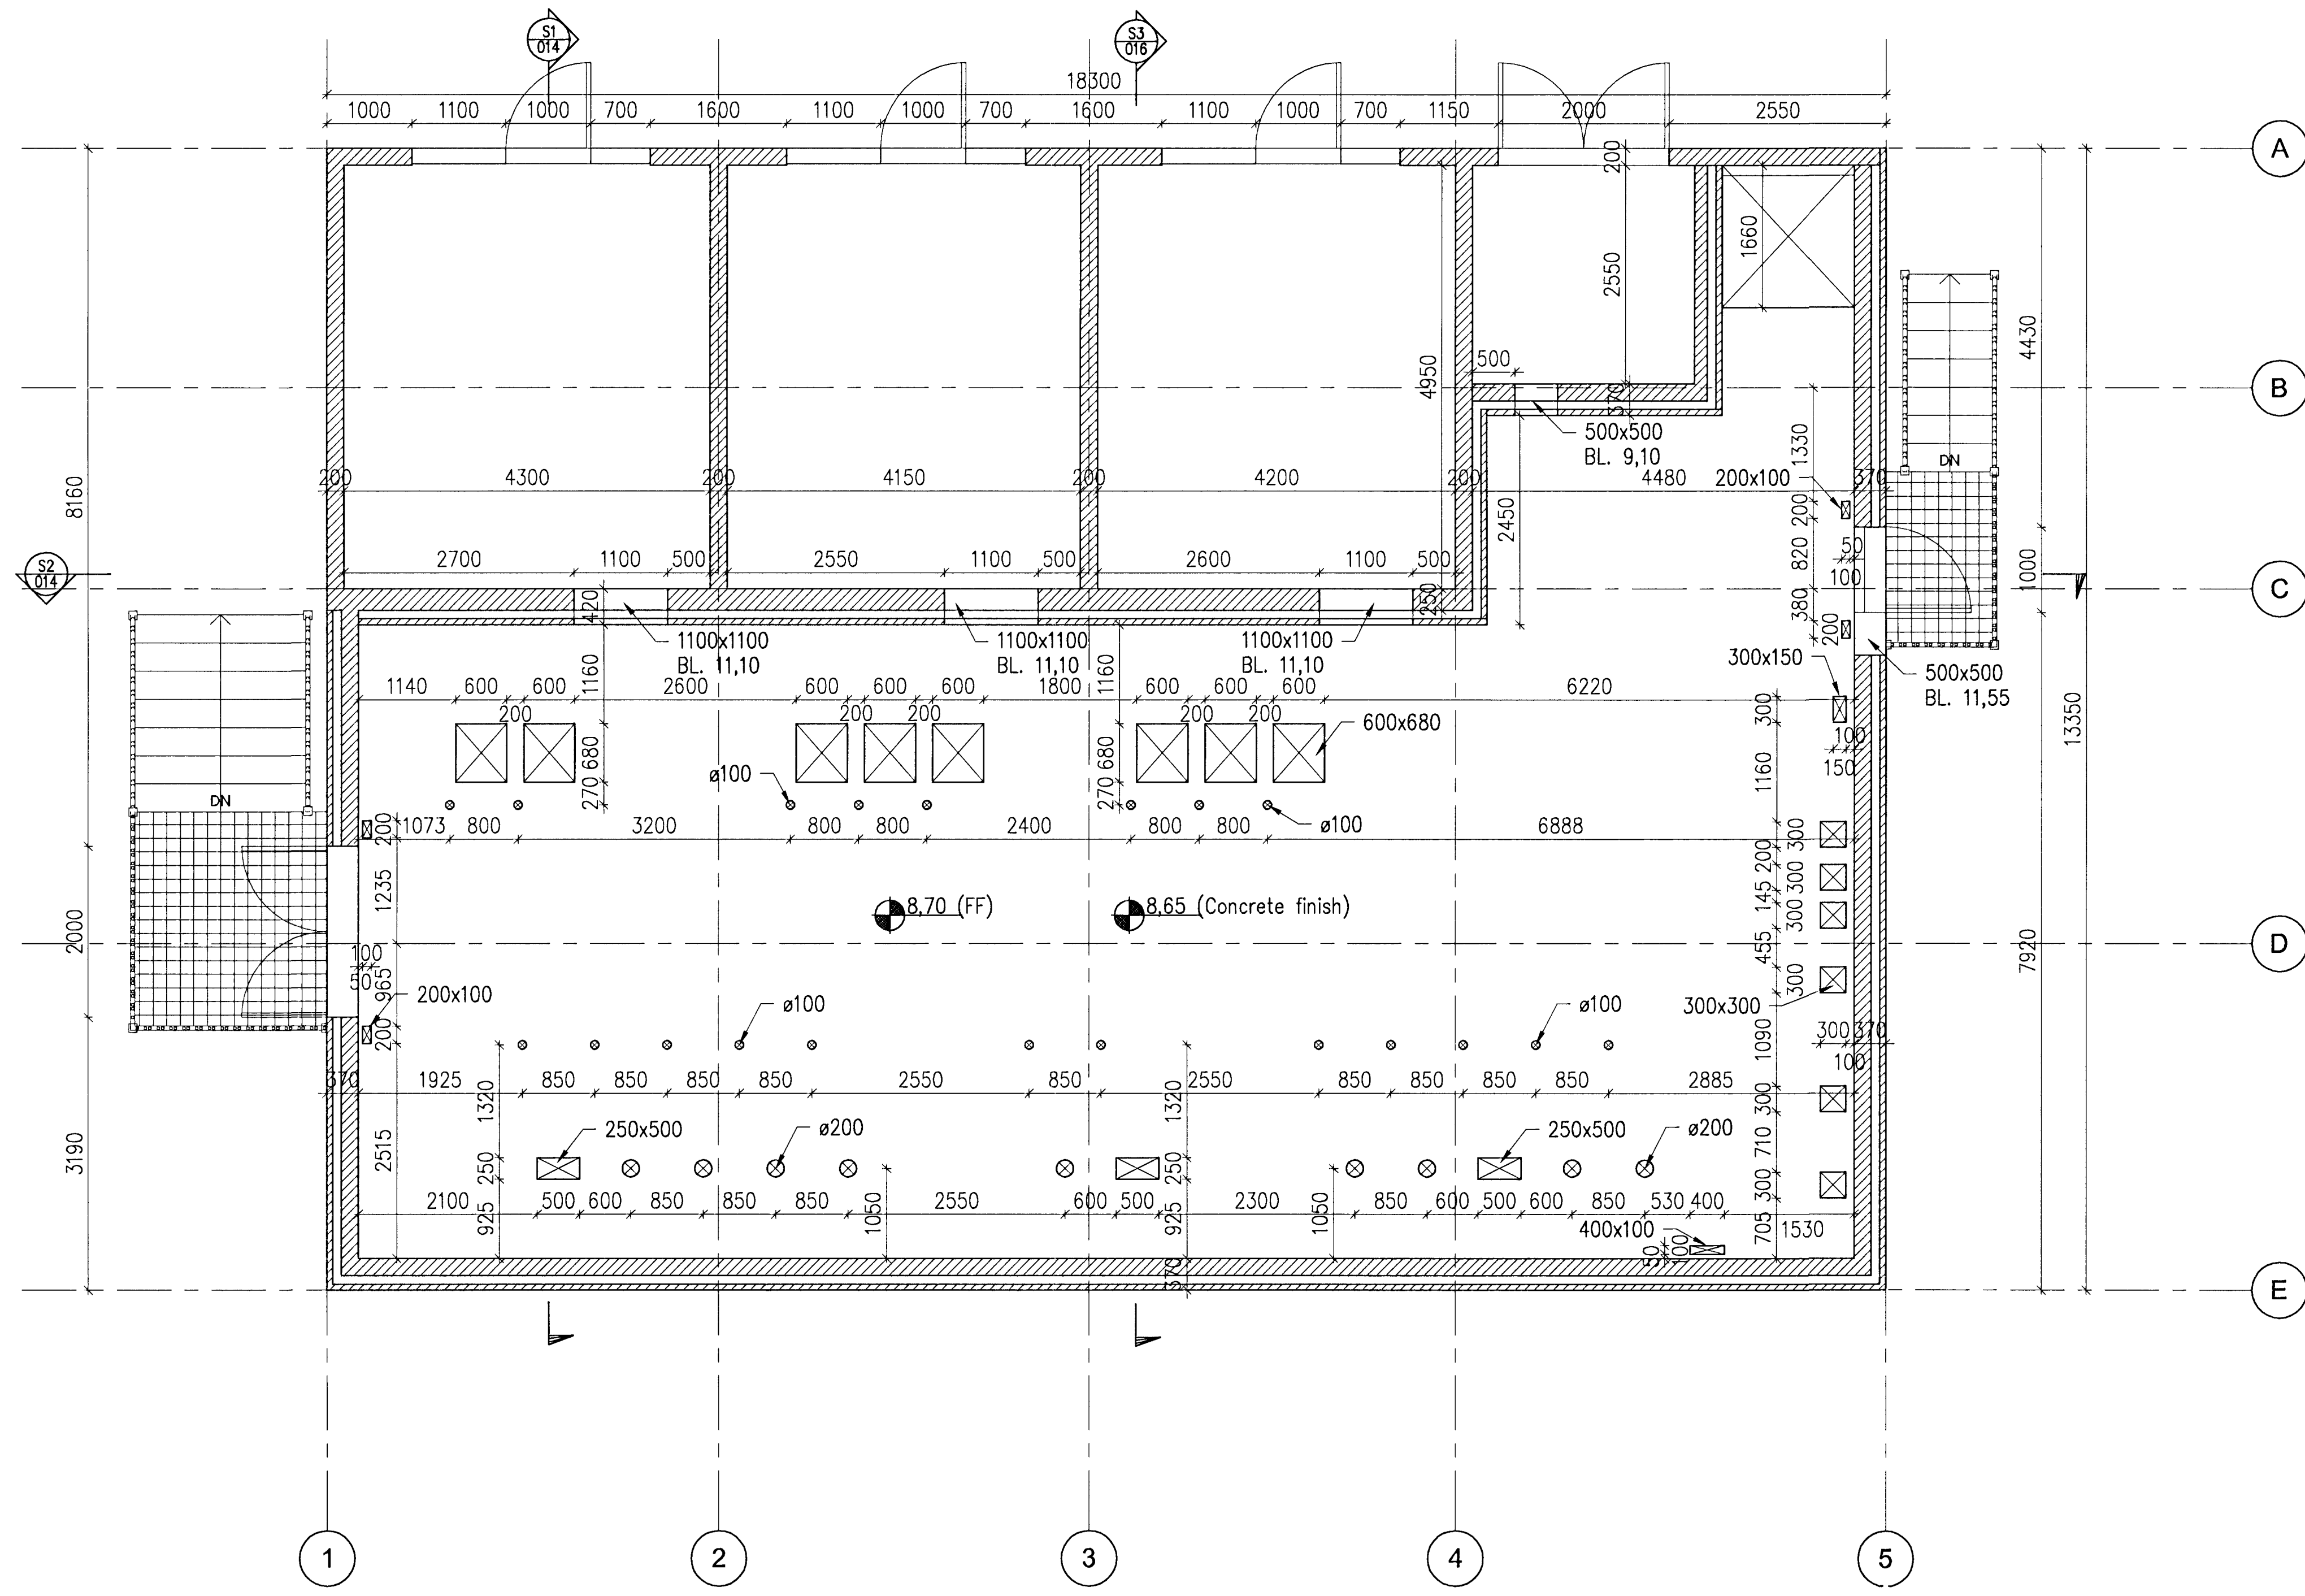

PLAN, LEVEL 8.70, 1:50



Skýringar:  
 Legend:  
 Prefabricated elements are shown on contractors drawings

6	Record drawing	2012.09.20	GMG	NI	FE	reA
Útg nr	Lýsing	Dagsetning	Höfundur	Yfirlit	Notk heim	Notk heim
Rev no	Description	Date	Des./Dw	Old	Suppl	ISAL Ref

This drawing is the property of Rio Tinto Alcan Iceland Ltd. and handed out for personal use only. It may neither be copied nor made available to others without permission of Rio Tinto Alcan Iceland Ltd. The receiver is liable for any misuse.

Stærð: A1 Mkv: 1:50  
 Formát: Scale: 1:50  
 Dimensions without tolerances according to ISO 2768-1 medium.

Dagsetning / Date: 2011.02.14	
Hannað / Designed: HFB	Tekni / Drawn: HFB/AFV
Verktaki / Supplier: HRV	
Tæknirerfjakona / Supplier drw.no: IDP-212-DA-062-013	
Sambúið / Approved: NI	Yfirl / Chkd: HJH
Húti of / Part of:	

IPU 212 - SUBSTATION 140 GENERAL LAYOUT CONTROL ROOM, PLAN			Flokkur nr.:	Blað nr.:	Nesta bl.nr.:
			Kostn.nr.-Cóno. / Bón.nr.-Eq.no	4011 16406	
Teg. teikningar / Dwg. type: FORMWORK			AKS	UB140	
<b>Rio Tinto Alcan</b>			ISAL	Tekn.nr. ISAL / Drw.no. of ISAL	Breyt./Rev.
			251412	A	
			ISAL Yfirráð og ákrið, dags / ISAL Checked, date		
			ISAL Samþykkt, dags / ISAL Approved, date		