

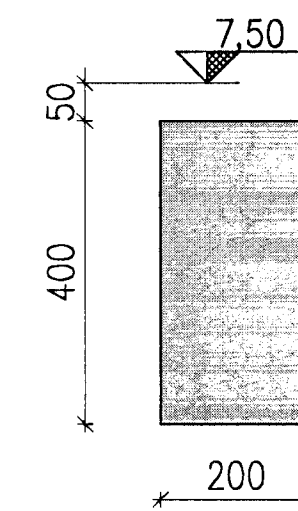


Níki Indriðsson  
Kt. 181144-3949  
NI

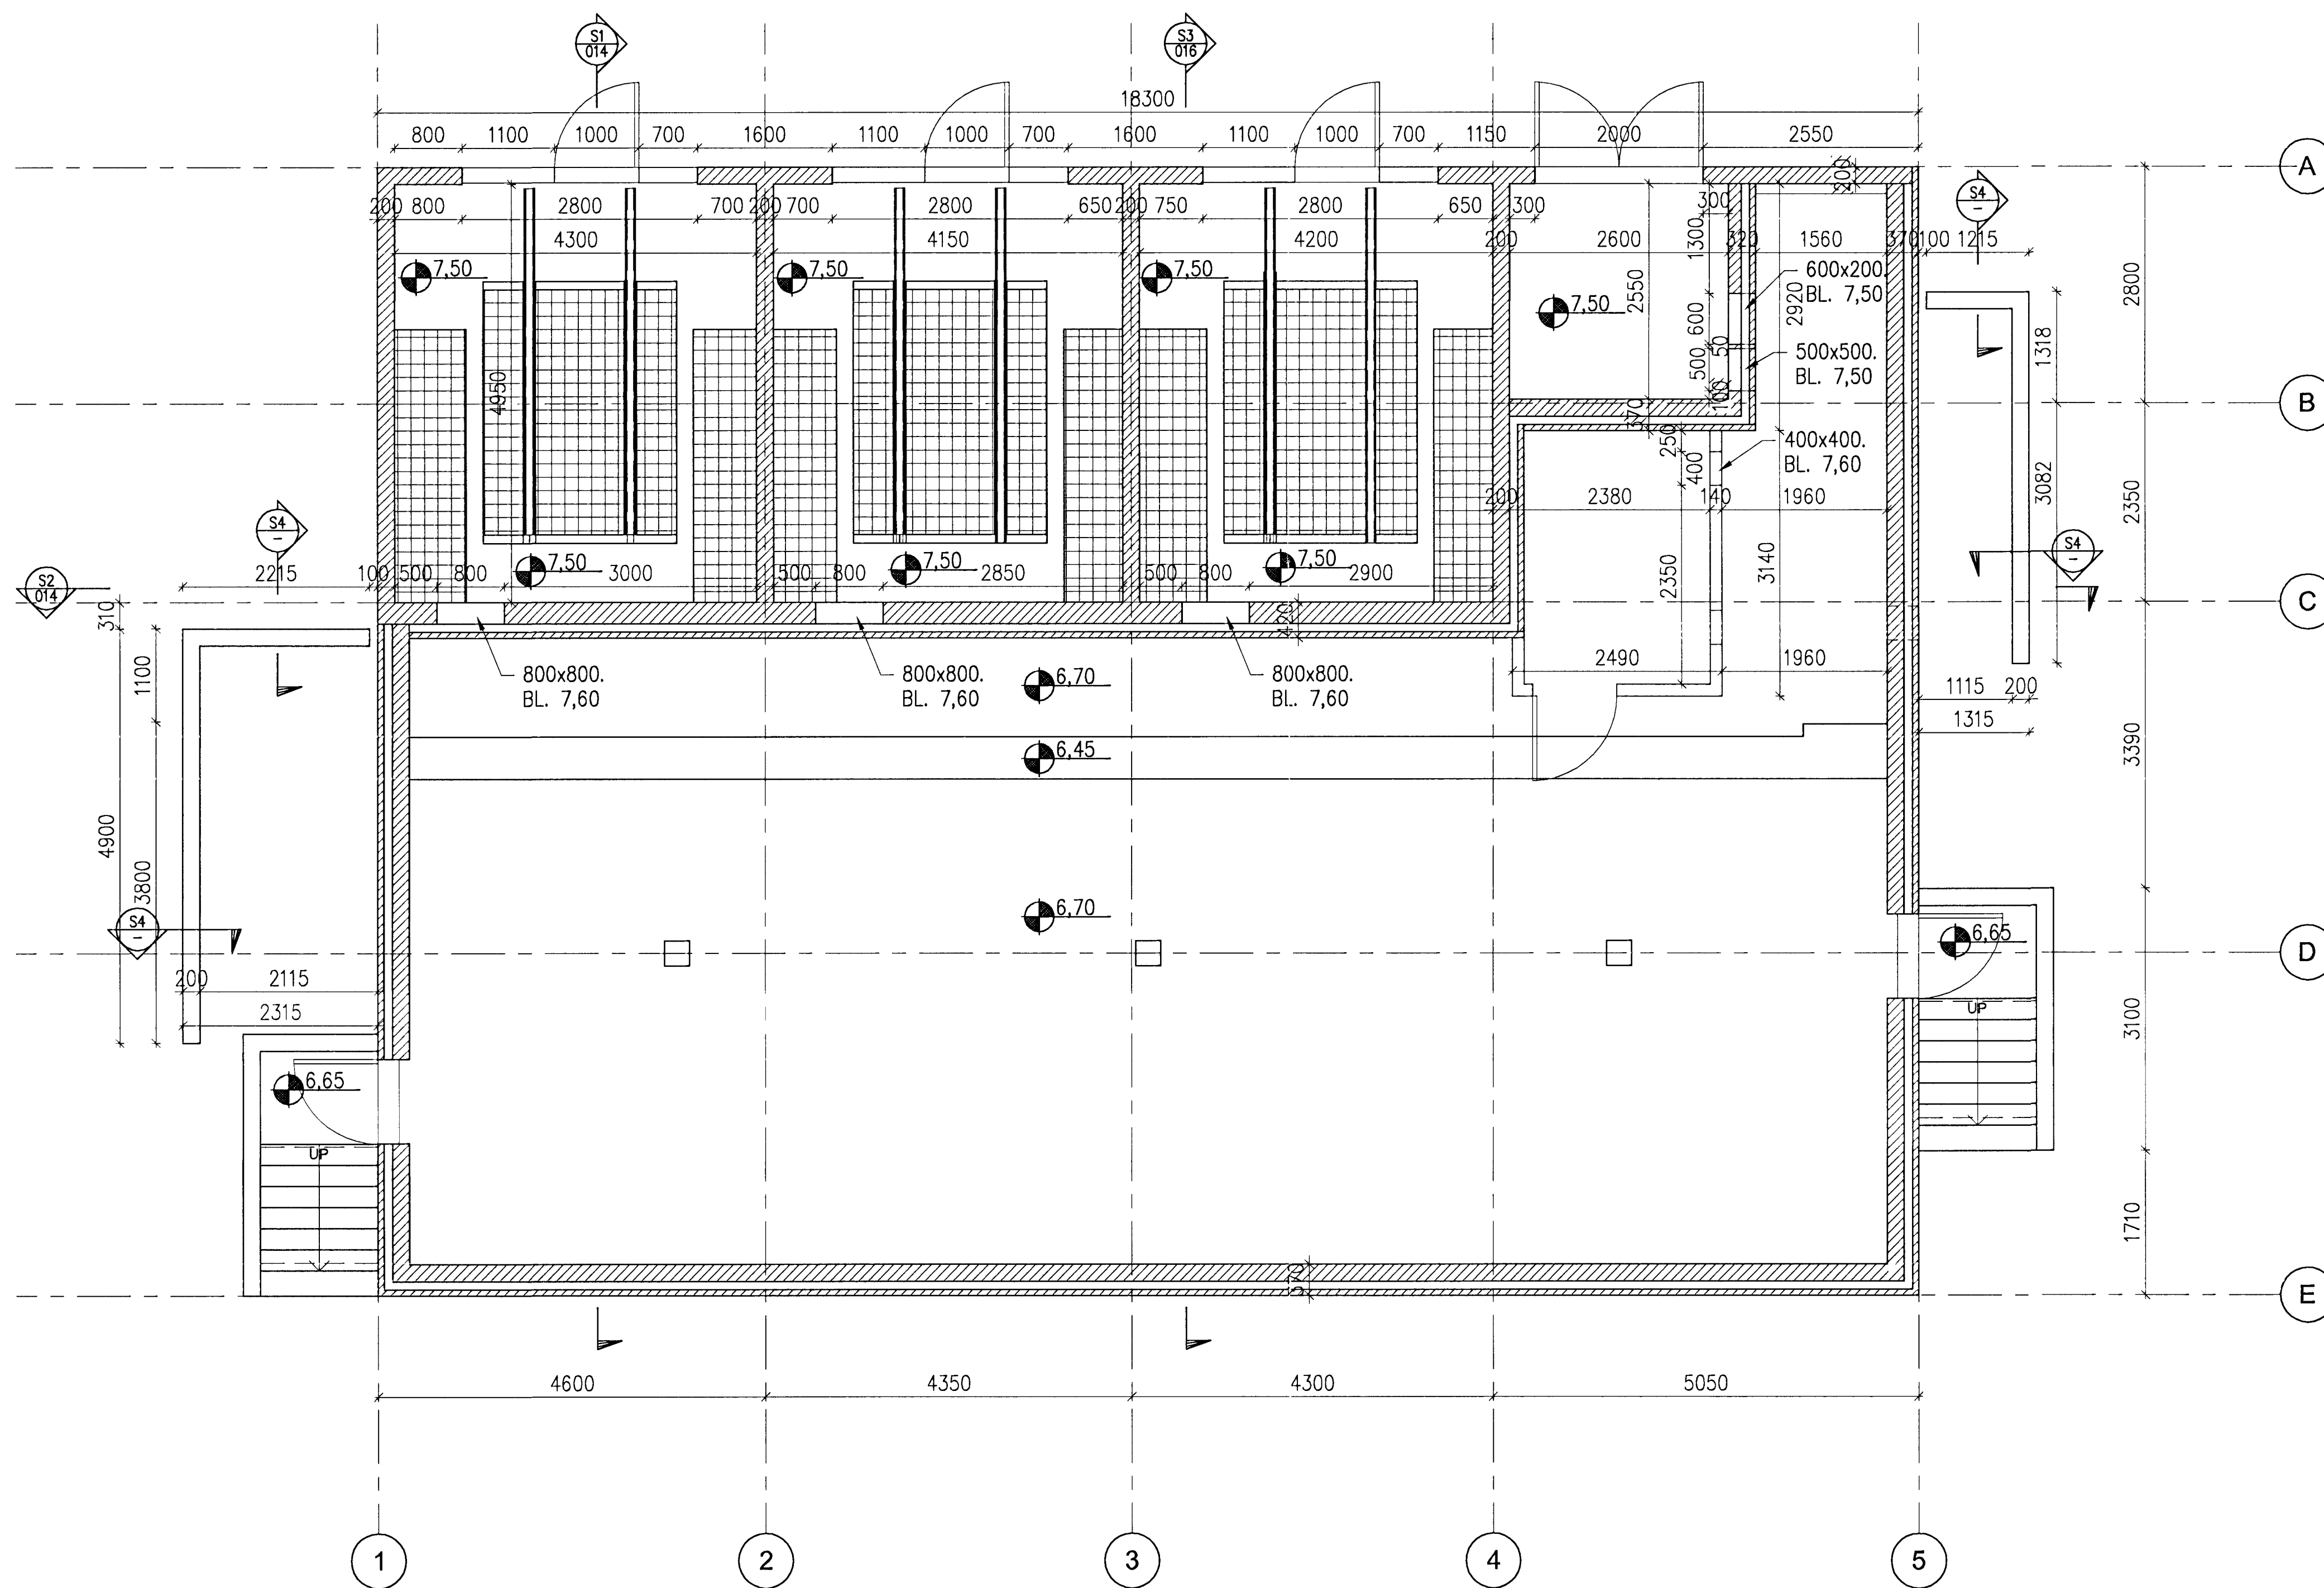

S4 SECTION  
- 1:10

PLAN, LEVEL 7.50, 1:50

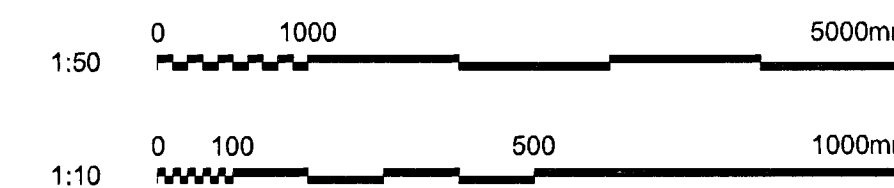

Skýringar:  
Legend:  
Prefabricated elements are shown on contractors drawings

C:\IDP\01 IDP\200 - Utilities\210 Electrical energy supply\Drawings\Architectural\IDP-212-DA-062-012.dwg

6	Record drawing	2012.09.20	GMG	NI	PE	PEB	→
Ótg nr	Lýsing	Dagsetning	Hor/Tín	Yfir	Notk heim	Notk heim	
Rev no	Description	Date	Des/Drw	Ckd	Suppl Rel	ISAL Rel	

This drawing is the property of Rio Tinto Alcan Iceland Ltd. and handed out for personal use only. It may neither be copied nor made available to others without permission of Rio Tinto Alcan Iceland Ltd. The receiver is liable for any misuse.	
Stærð:	A1
Formmál:	Mkv: 1:50, 1:10
Scale: 1:50, 1:10	
Dimensions without tolerances according to ISO 2768-1 medium.	



Dagsetning / Date	2011.02.14
Hönnuð / Designed	HFB
Tekn / Drawn	HFB/AFV
Verktaki / Supplier	HRV
Tekn.nr.verktaka / Supplier drw.no.	IDP-212-DA-062-012
Svambætt / Approved	NI
Yfir / Chkd	HJH
Hluti af: / Part of:	

IPU 212 - SUBSTATION 140		Flokkur nr.:	Blöð nr.:	Nasta bl.nr.:
GENERAL LAYOUT		Kostn.nr.-Cóno. / Bón.nr.-Eq.no	4011	16406
TRANSFORMER ROOMS, PLAN		AKS	UB140	
FORMWORK		Tekn.nr. ISAL / Drw.no. of ISAL	251411	Breyt./Rev. A
Rio Tinto Alcan		ISAL		
Alcan Iceland Ltd		ISAL		
Stráumvirk		ISAL		
Ís-222 Hafnarþorður		ISAL		
Ísland		ISAL		
ISAL Yfirbúð og skráð, dags / ISAL Checked, date		ISAL Samþ.Mt, dags / ISAL Approval, date		