


Níels Indriðason
 Kt. 181144-3949
 Ni

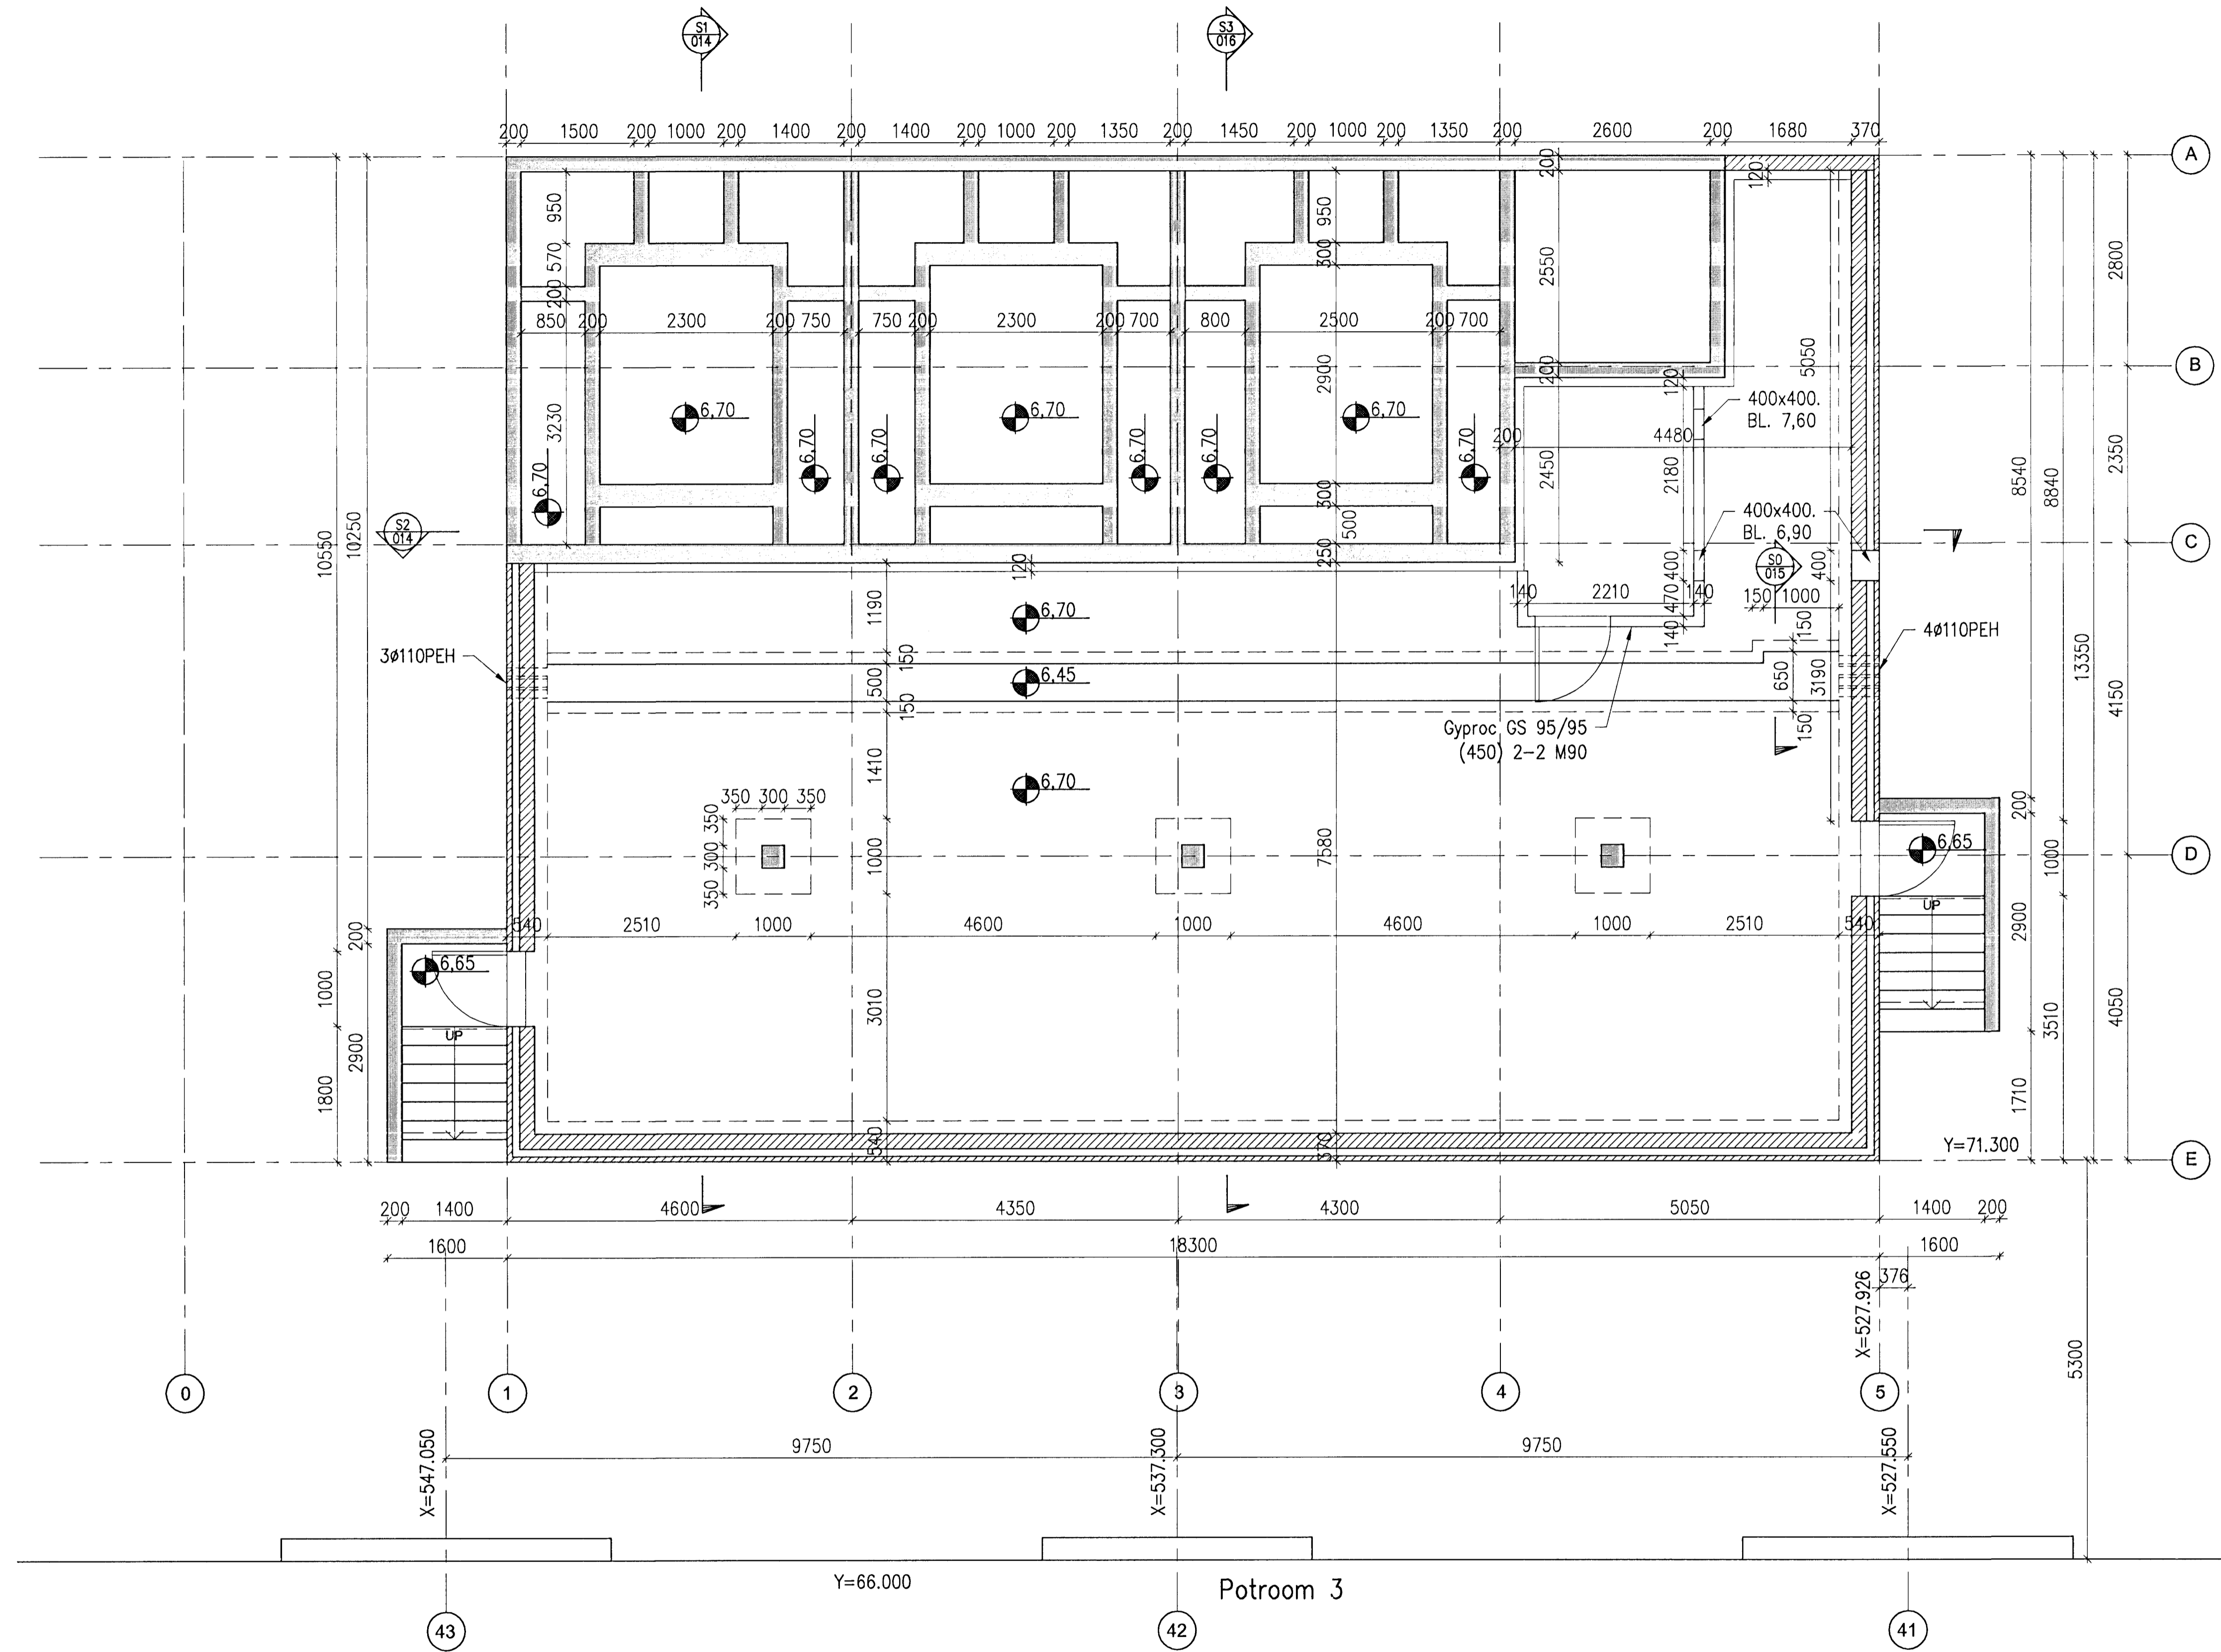

PLAN, LEVEL 6.70, 1:50



Skýringar: Coordinates X,Y are in a local coordinate system 0,0.
 Legend: The Contractor Surveyor shall consult with Engineers Surveyor, prior to survey work, coordinate transformation to ISN93 Coordinate system.
 See electrical drawings for embedded pipes.
 Prefabricated elements are shown on contractors drawings

6	Record drawing	2012.09.20	GMG	NI	PG	REB	
Útg nr	Lýsing	Dagsetning	Hor/Þes	Yfir	Notk heim	Notk heim	
Rev no	Description	Date	Des/Draw	Old	Suppl	Revised	ISAL Ref

This drawing is the property of Rio Tinto Alcan Iceland Ltd. and handed out for personal use only. It may neither be copied nor made available to others without permission of Rio Tinto Alcan Iceland Ltd. The receiver is liable for any misuse.

Scale: 1:50
 Dimensions without tolerances according to ISO 2768-1 medium.

Dagsetning / Date	2011.02.14
Hannað / Designed	HFB
Tekn / Drawn	HFB/AFV
Verktaki / Supplier	HRV
Tekn.nr.verktaka / Supplier draw.no.	IDP-212-DA-062-011
Snúðátt / Approved	NI
Yfir / Chkd	HJH
Hluti af: / Part of:	

IPU 212 - SUBSTATION 140		Flokkur nr.:	Blöð nr.:	Nesta blinn.:
GENERAL LAYOUT		Kostn.nr.-Ceno. /	Búrn.nr.-Eq.no	
CABLE BASEMENT PLAN		4011	16406	
Tag.tekningar / Dwg. type:		FORMWORK	AKS	
Tekn.nr. / Dwg.no. of ISAL		251410	Breyt./Rev.	A
ISAL Yfirfarð og skráð, dags / ISAL Checked, date		ISAL Samþykkt, dags / ISAL Approved, date		