


Samþykkt þann
26 OCT 2012
 Byggingafrádráttur / Harðarinnar
 F.h. Sigurður Steinar Jónsson

Nick Indriðason
 Kt. 181144-3949
 NI

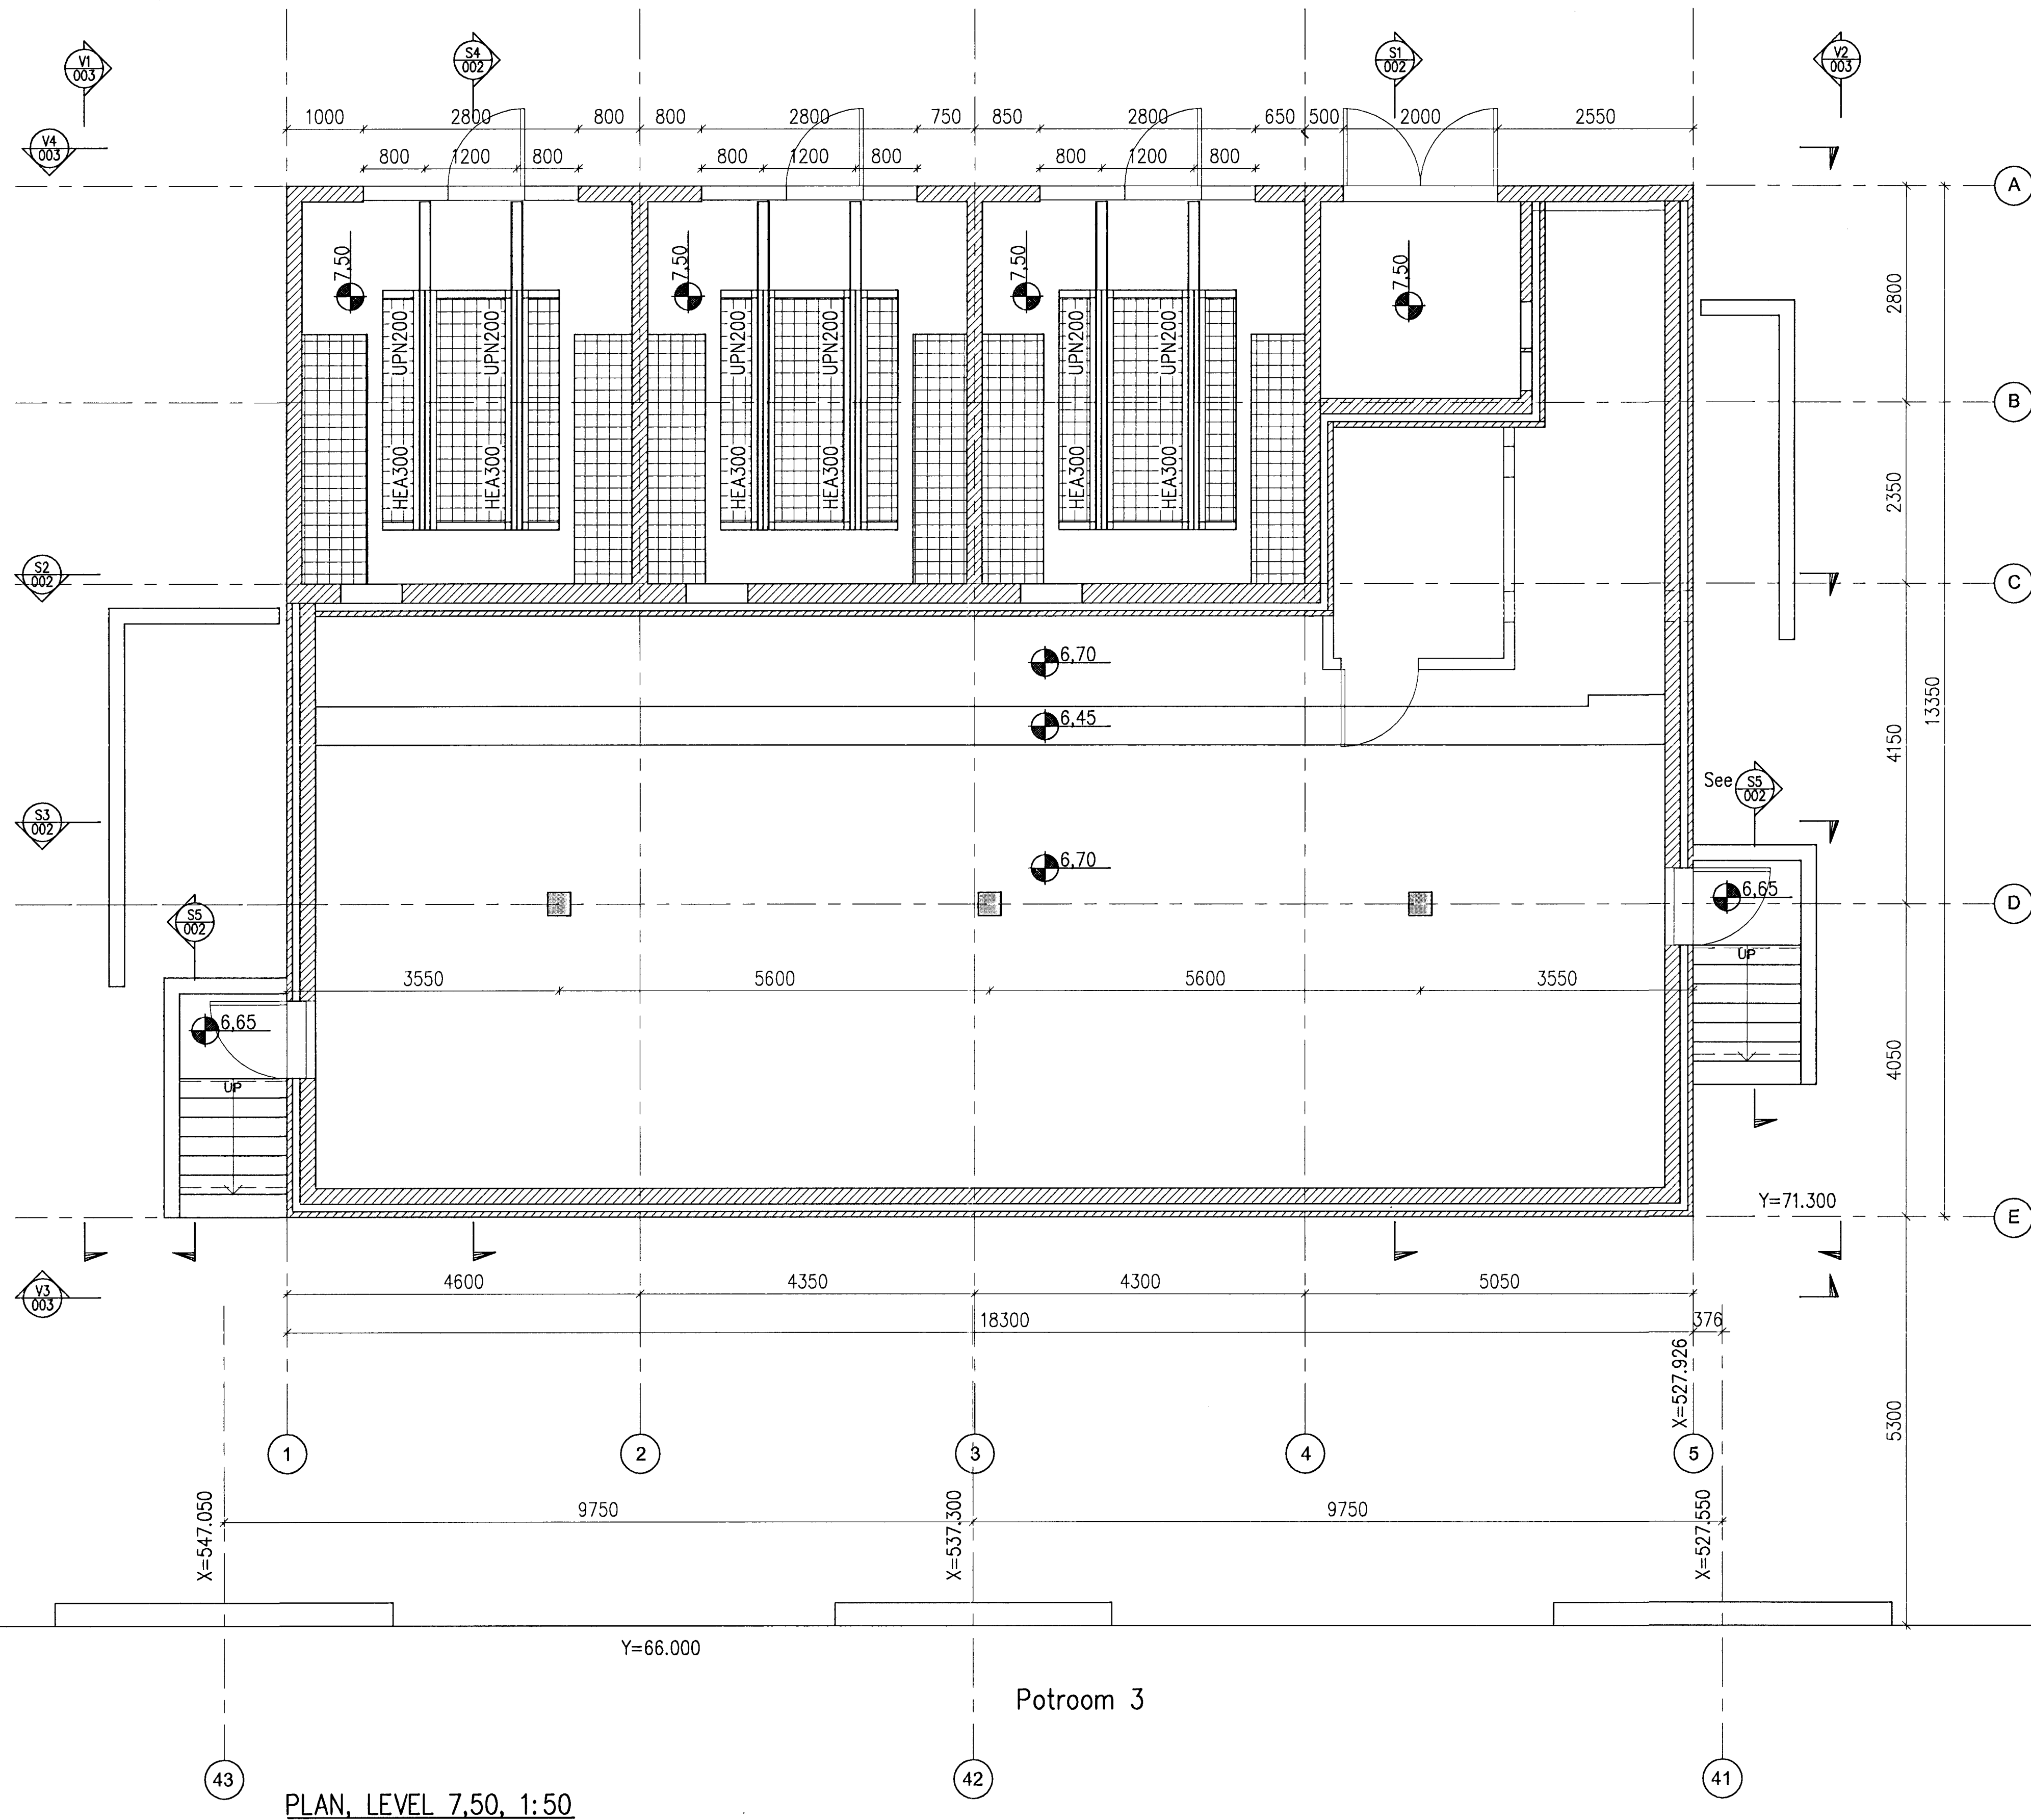

PLAN, LEVEL 7,50, 1:50



Skýringar: Coordinates X,Y are in a local coordinate system 0,0.
 Legend: The Contractor Surveyor shall consult with Engineers Surveyor, prior to survey work, coordinate transformation to ISN93 Coordinate system.

Prefabricated elements are shown on contractors drawings

| | | | | | | |
|--------|----------------|------------|---------|------|-----------|-----------|
| 6 | Record drawing | 2012.09.20 | GMG | NI | PG | HEA-300 |
| Ölg nr | Lýsing | Dagsetning | Höf./Bú | Yfir | Notk heim | Notk heim |
| Rev no | Description | Date | Des/Drw | Old | Suppl Rel | ISAL Rel |

| | | | |
|--|----------------|--|---------|
| This drawing is the property of Rio Tinto Alcan Iceland Ltd. and handed out for personal use only. It may neither be copied nor made available to others without permission of Rio Tinto Alcan Iceland Ltd. The receiver is liable for any misuse. | | | |
| Stærð: A1 | Mkv.: 1:50 | Formati: A1 Scale: 1:50 Dimensions without tolerances according to ISO 2768-1 medium. | |
| 6 | Record drawing | 2012.09.20 | GMG |
| Ölg nr | Lýsing | Dagsetning | Höf./Bú |
| Rev no | Description | Date | Des/Drw |

| | | | | | | |
|--|--|--|--|---|--------------------|------------------------|
| Dogsetning / Date 2011.02.14 | | IPU 212 - SUBSTATION 140 GENERAL LAYOUT PLAN +6,70/+7,50 | | Flokkur nr.: 4011 | Blað nr.: 16406 | Nasta bl.nr.: 16406 |
| Hannað / Designed HFB | | Teikn / Drawn HFB/AFV | | Kostn.nr.-Ceno. / Bón.nr.-Eq.no 4011 16406 | | |
| Verktaki / Supplier HRV | | Teg.teikningar / Dwg. type OVERVIEW | | AKS UB140 | | |
| Stærð: A1 Formati: A1 | | Mkv.: 1:50 Scale: 1:50 | | ISAL Alcan Iceland Ltd Straumur & IS-222 Hálfarjörður Ísland | | |
| Hið af / Part of: | | Yfir / Chkd HJH | | ISAL 251407 A | | |
| ISAL Yfirráð og skráð, dags / ISAL Checked, date | | | | ISAL Samþykkt, dags / ISAL Approval, date | | |