


Níels Indriðason
Kt. 181144-3949 W1

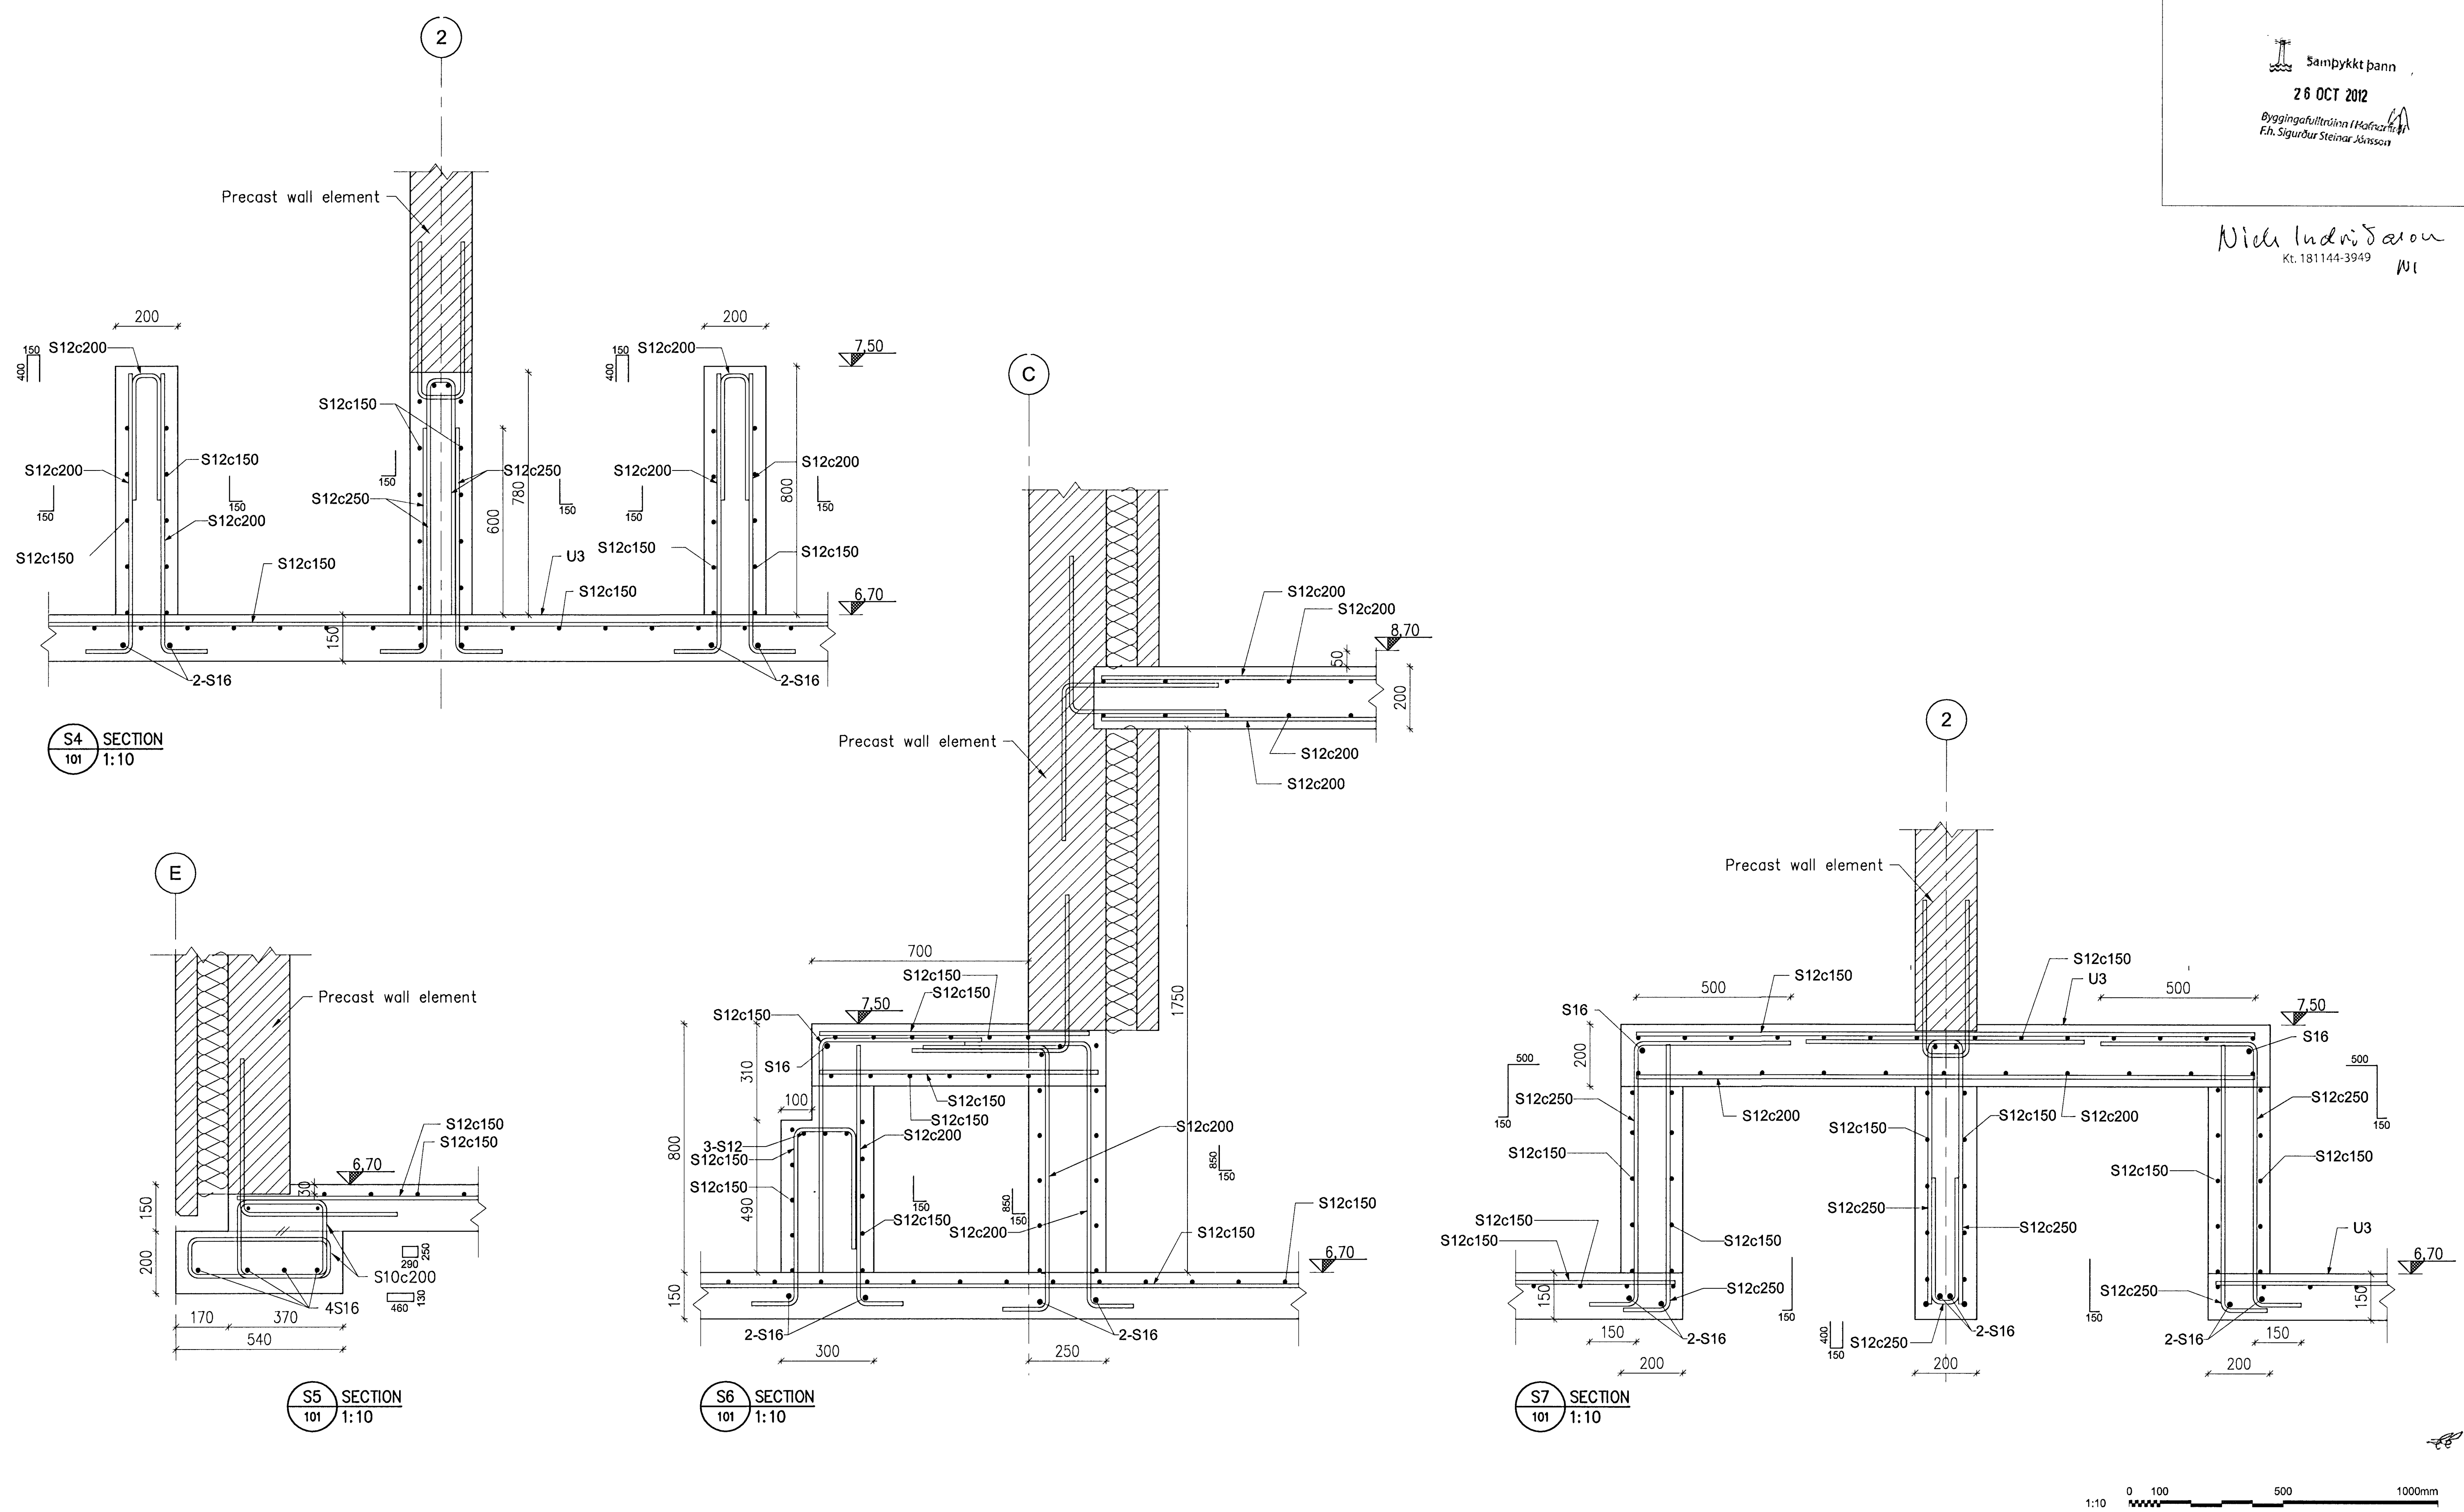

Skýringar:
Legend:
Prefabricated elements are shown on contractors drawings

6	Record drawing	2012.09.20	GMG	NI	PG	re3
Útg nr	Liðing	Dagsetning	Höf/Des	Yfir	Notk heim	Notk heim
Rev no	Description	Date	Des/Drw	Ord	Suppl Ref	ISAL Ref

This drawing is the property of Rio Tinto Alcan Iceland Ltd. and handed out for personal use only. It may neither be copied nor made available to others without permission of Rio Tinto Alcan Iceland Ltd. The receiver is liable for any misuse.

Format: A1 Mkv: 1:10
Scale: 1:10
Dimensions without tolerances according to ISO 2768-1 medium.

HRV HATCH
ISAL PRODUCTION UPGRADE

Dagsetning / Date: 2011.02.14
Hannað / Designed: HFB
Tekin / Drawn: HFB/AFV
Verktaki / Supplier: HRV
Tekn.nr.verktaka / Supplier drw.no: IDP-212-CA-062-103
Sambúikt / Approved: NI
Hluti af: / Part of:

IPU 212 - SUBSTATION 140
CIVIL WORK
FOUNDATIONS AND SECTIONS
REINFORCEMENT

Flokkur nr.: Blað nr.: Nasta blinn.:
4011 16406

Kostn.nr.-Öcno. / Bún.nr.-Eq.no:
AKS UB140

ISAL
Alcan Iceland Ltd
Straumavík
IS-222 Hafnarfordur
Ísland

Tekn.nr. ISAL / Drw.no. of ISAL Breyt./Rev.:
251420 A

ISAL Yfirbúið og skrðið, dags / ISAL Checked, date
ISAL Sambúikt, dags / ISAL Approved, date