



SECTION A-A

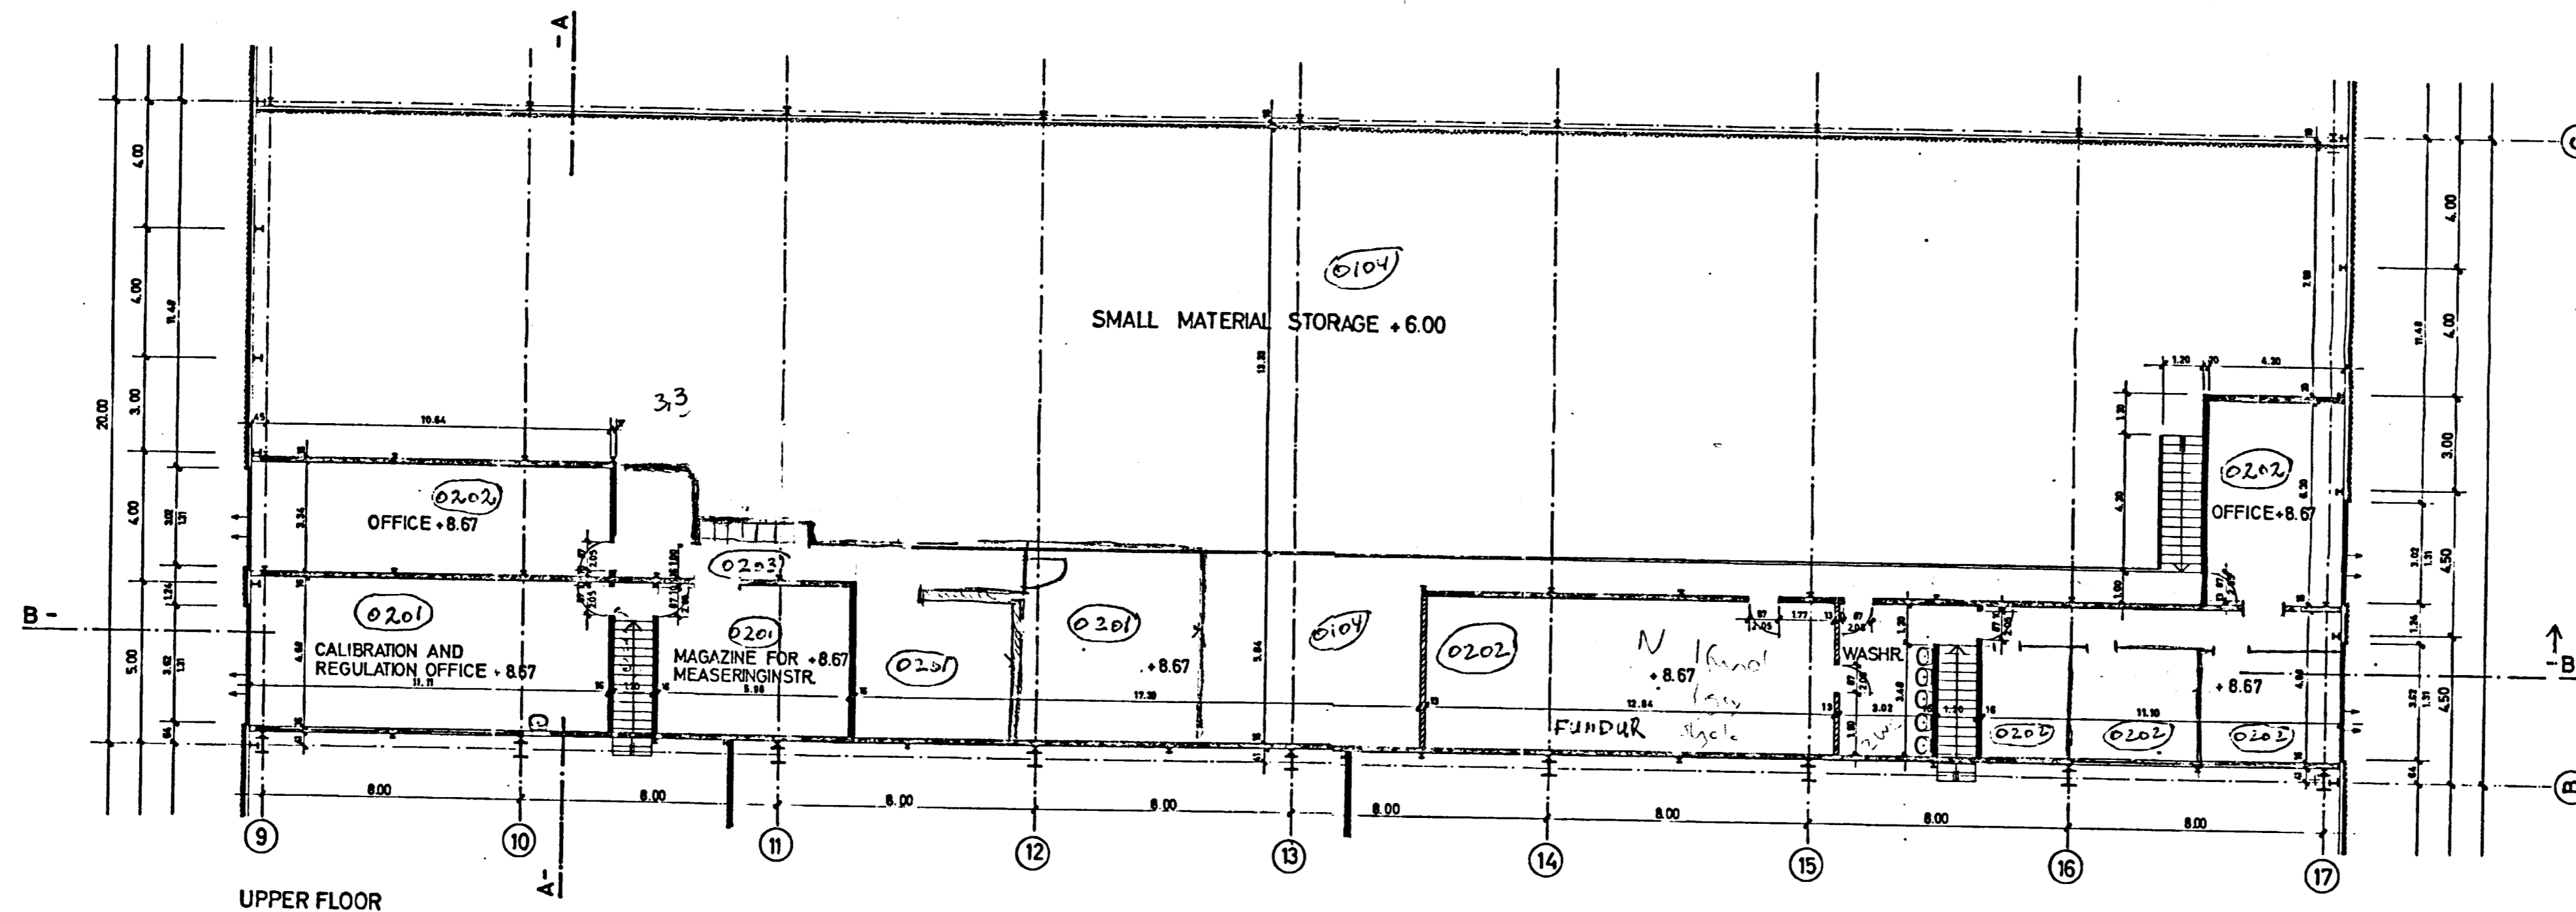

UPPER FLOOR

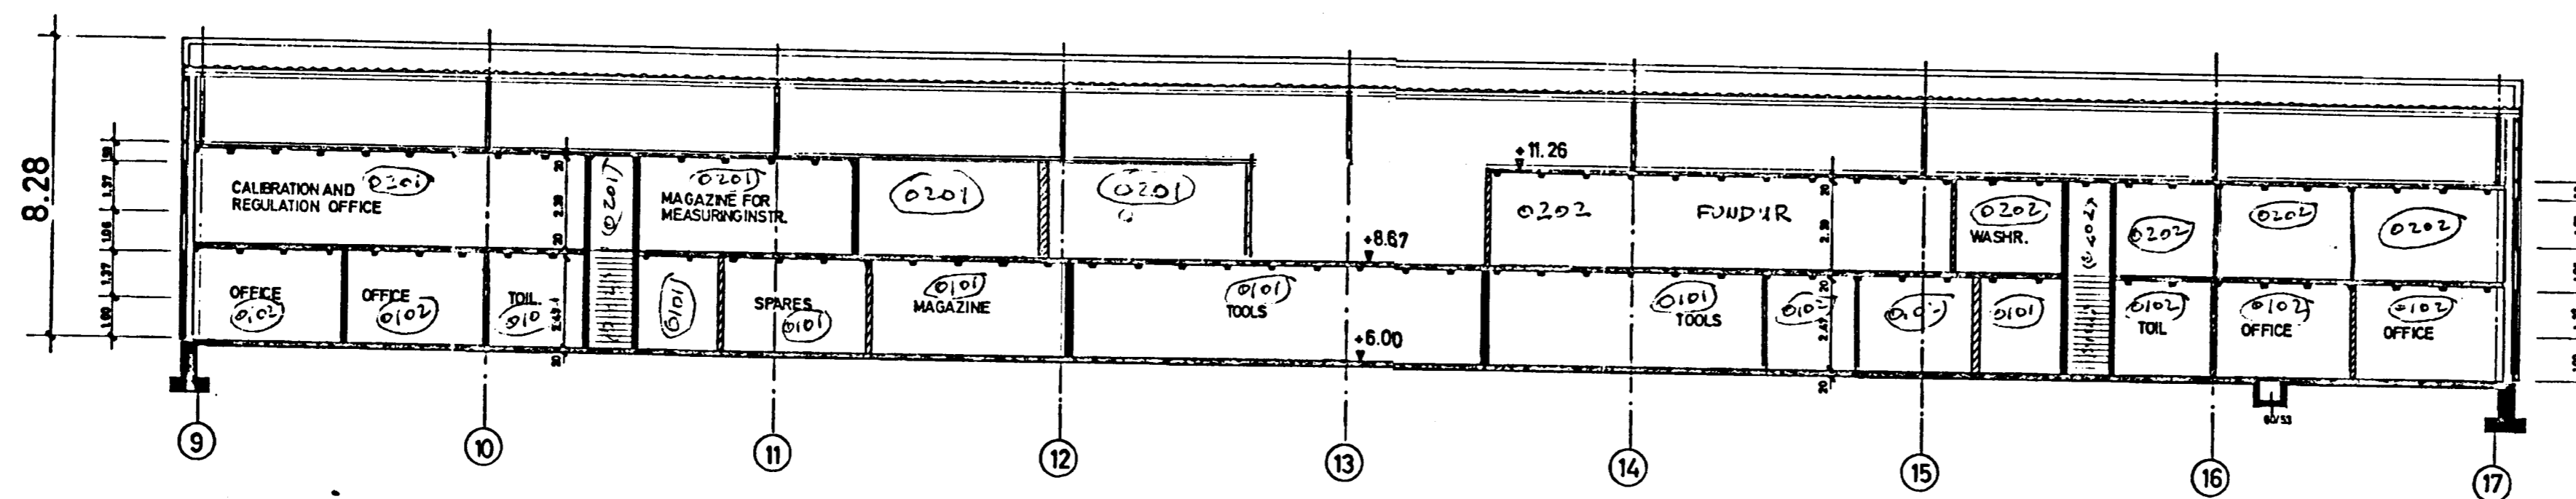

SECTION B-B

Alcan á Íslandi hf.			
Skráning matshluta bygginga í Straumsvík			
ADALVERKSTÆÐI, LAGER	123154	19	
<small>Heiti byggingar</small>	<small>Fastaúmer</small>	<small>Landnúmer</small>	<small>Matshlutanúmer</small>
VST Verkfræðistofa Sigurðar Thoroddsen hf. kt. 611276-0289			
Niels Indriásson kt. 181144-3949		2003-09-16	
<small>Niels Indriásson kt. 181144-3949</small>		<small>Dagsetning</small>	

△					
REV. N.	DATUM	REVISION	GEZ.	GEPR.	GEN.
ICELANDIC ALUMINIUM COMPANY LTD.					
CONSTRUCTION DRAWING			Sheet	Entered	
WORKSHOP			Number	24689	to
UPPER FLOOR AND SECTIONS			Scale	1:100	25.8.03
AS BUILT DRAWING			Drawn		
Profildrángur			Checked		
Schweizerische Aluminium AG ZÜRICH			No.	150 206 IS 52	