



ELEVATION, NORTH EAST

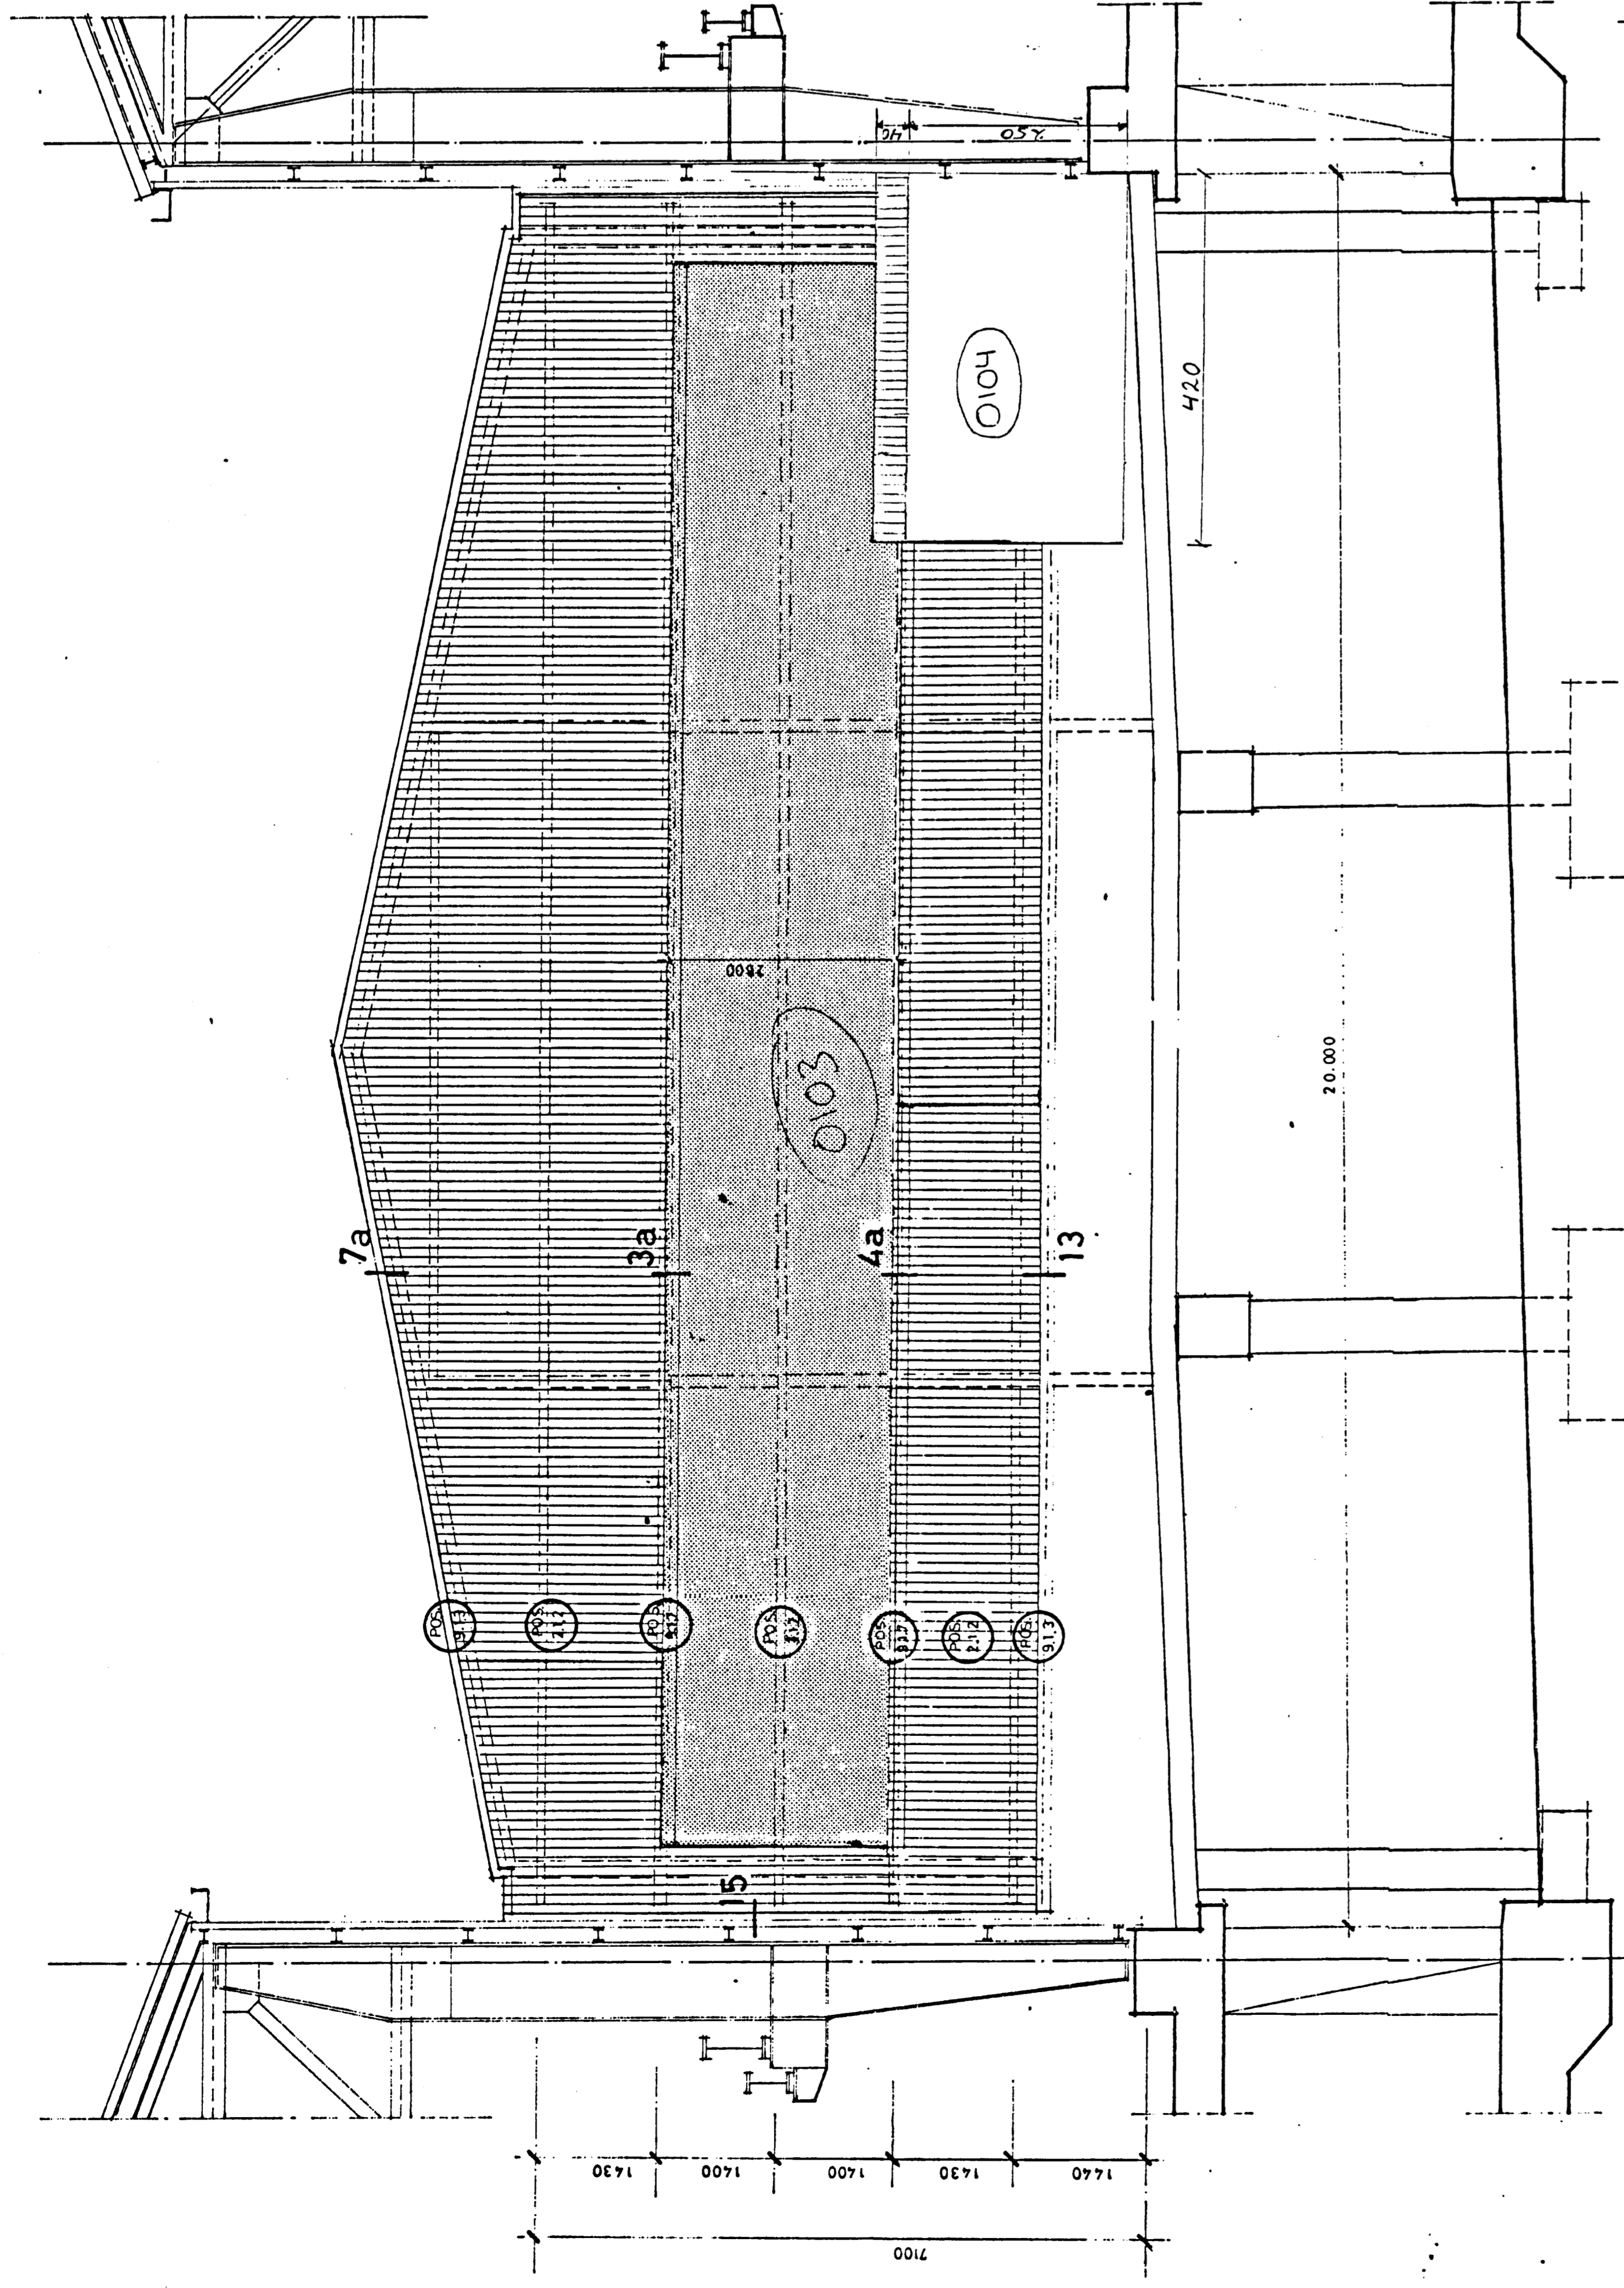

ELEVATION, SOUTH WEST

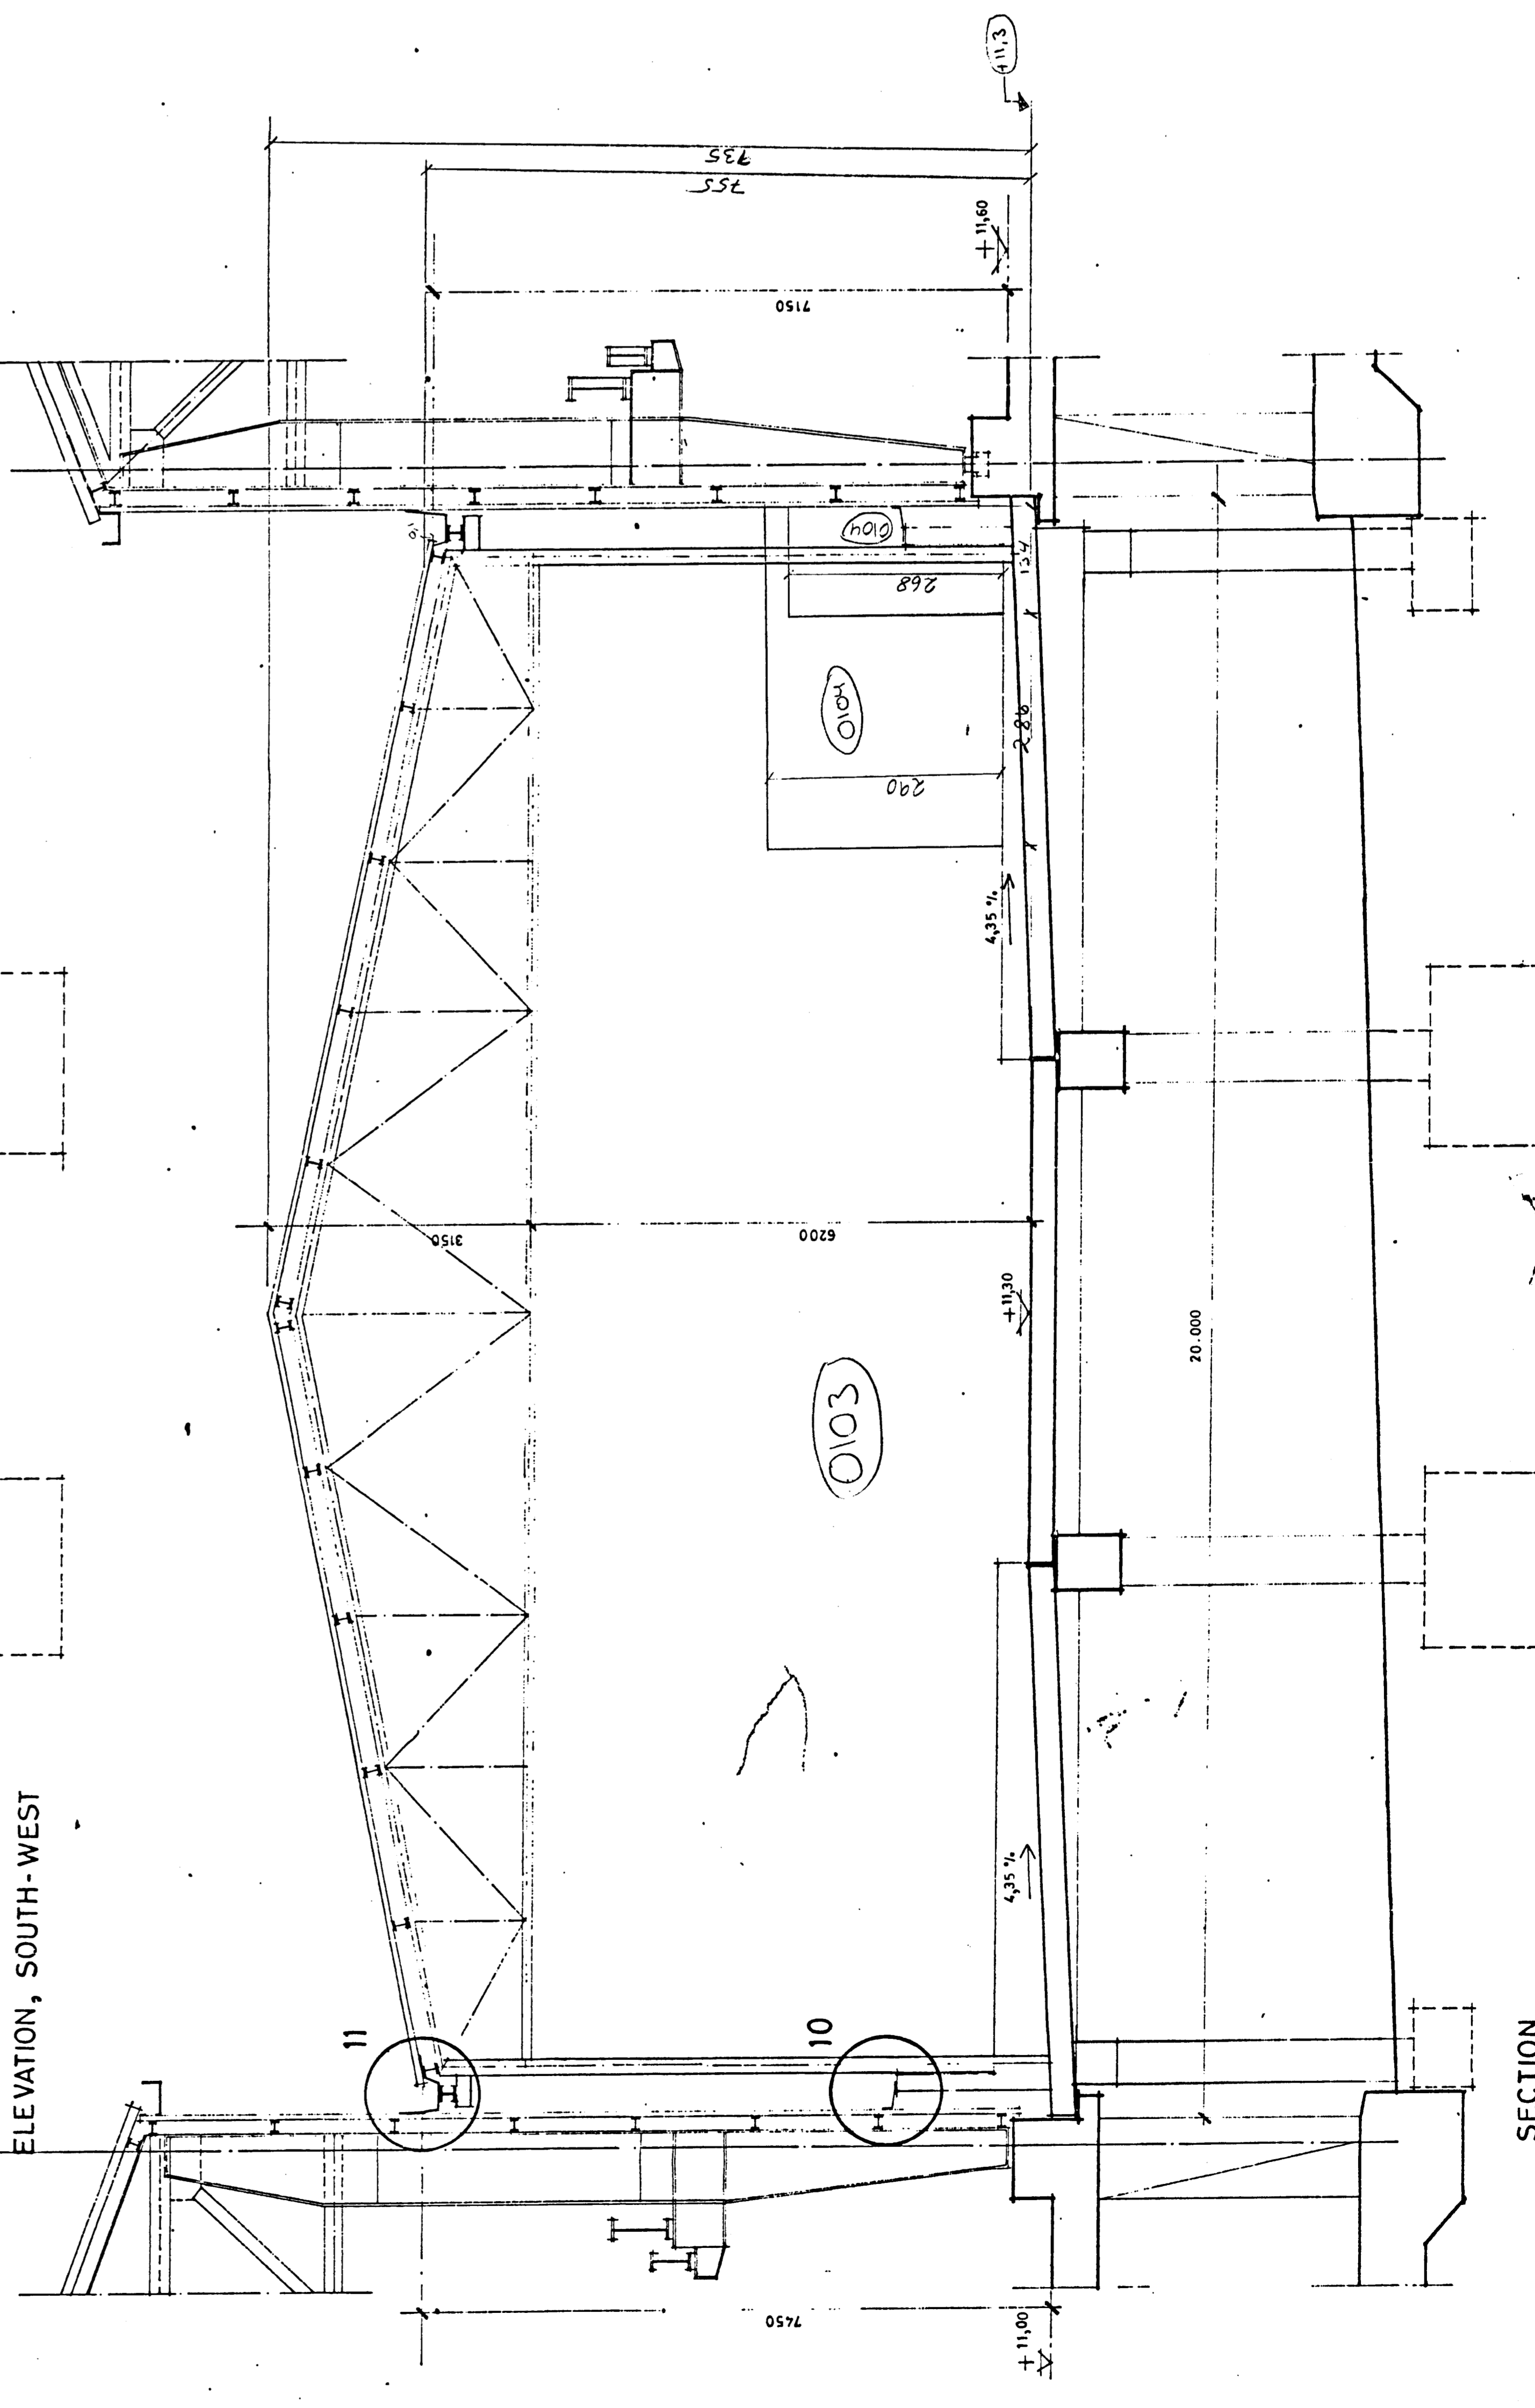

SECTION

Alcan á Íslandi hf.		Skráning matshluta Bygginga í Straumsvík	
DEIGLINGSSTÆÐI	123184	76	
Alcan	Verkefni	Lausnir	Maðalíftími
VST	Verkefnistala	Sigundur Thoroddsen hf. n. 611276-0289	2003-10-02
Mál númer: 101/144-2003		Gagnahugi	
REV. N.	DATE	REVISED	BY
ICELANDIC ALUMINIUM COMPANY LTD.			
ARCHITECTURAL DRAWING		Scale: 1:50	
CRUCIBLE CLEANING SHOP		Drawing No: 163073 IS-313	
ELEVATIONS AND SECTION		Project No: 163073 IS-313	
Drawing: AS BUILT DRAWING		Schweizerische Aluminium AG ZÜRICH	