



Sambýkkt þann
02 OCT 2012
Byggingafráunir / Meðhöndlun
F.h. Sigurður Steinar Jóhannsson

Níels Indriðason
Kt. 181144-3949
U1


V1
281
FRONT VIEW

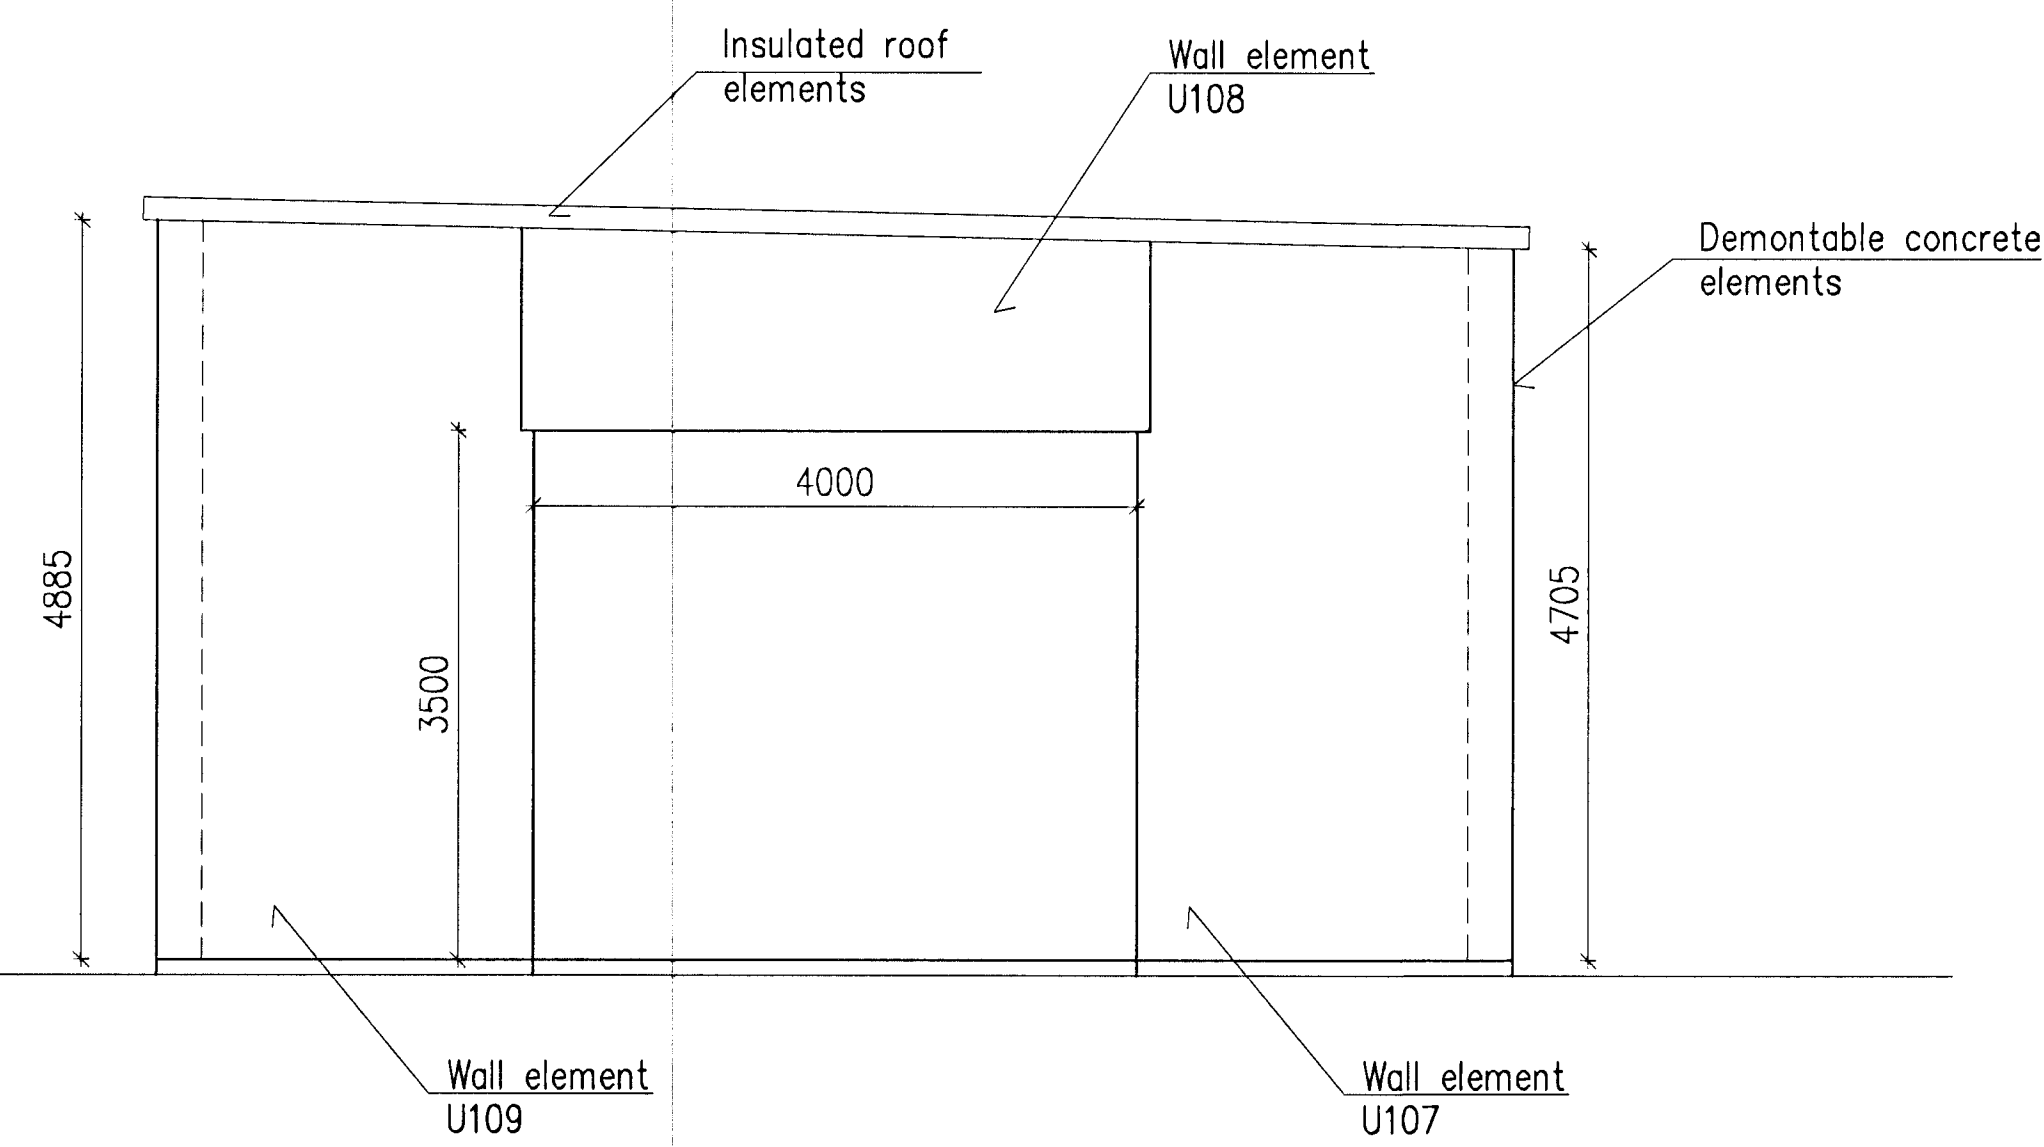



V2
281
BACK VIEW

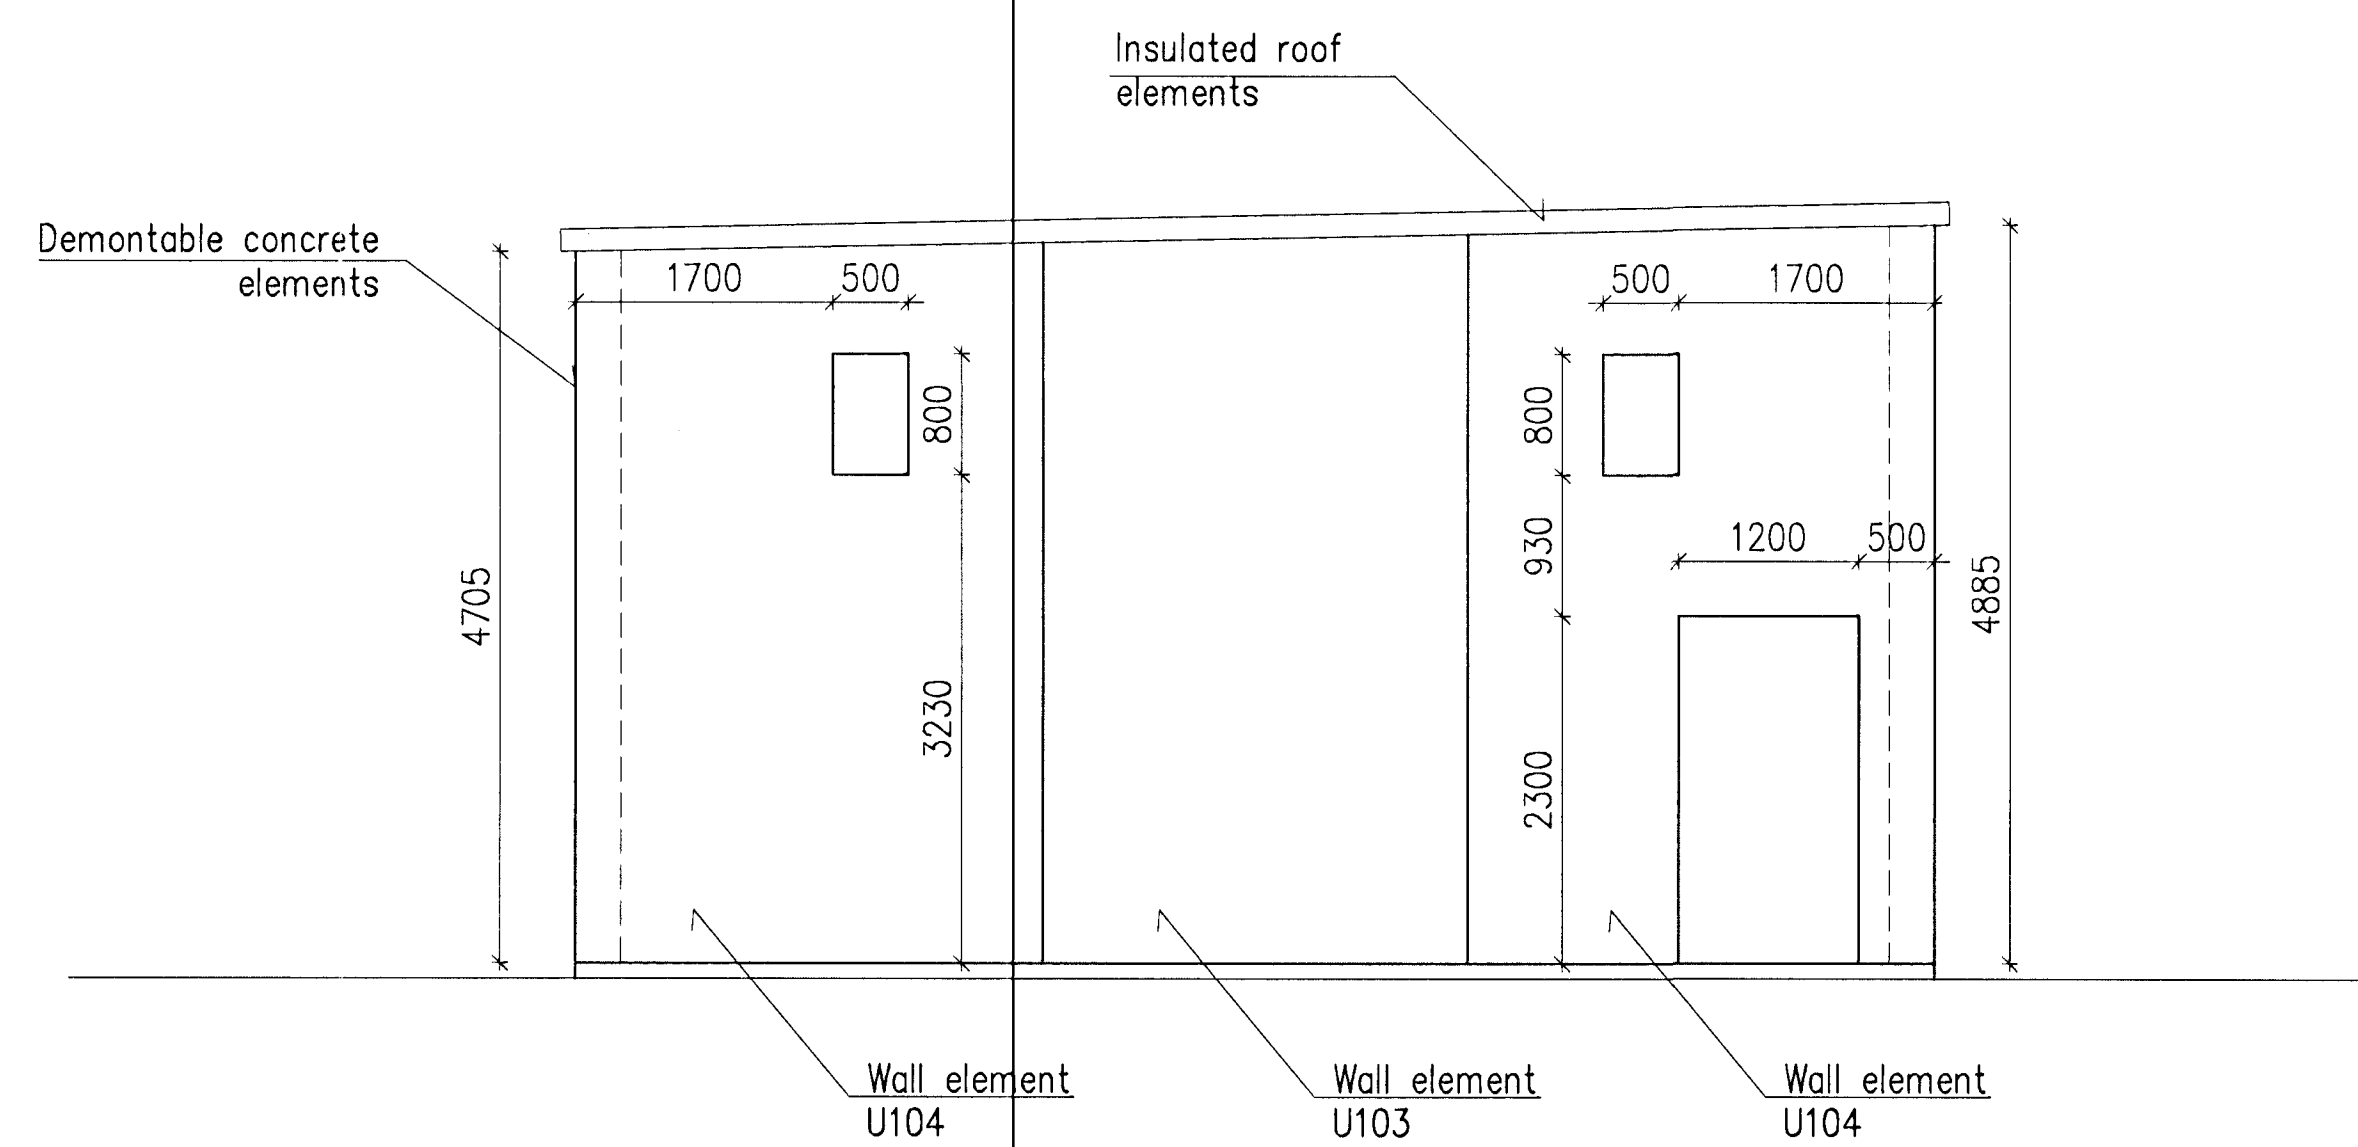

V3
281
SIDE VIEW

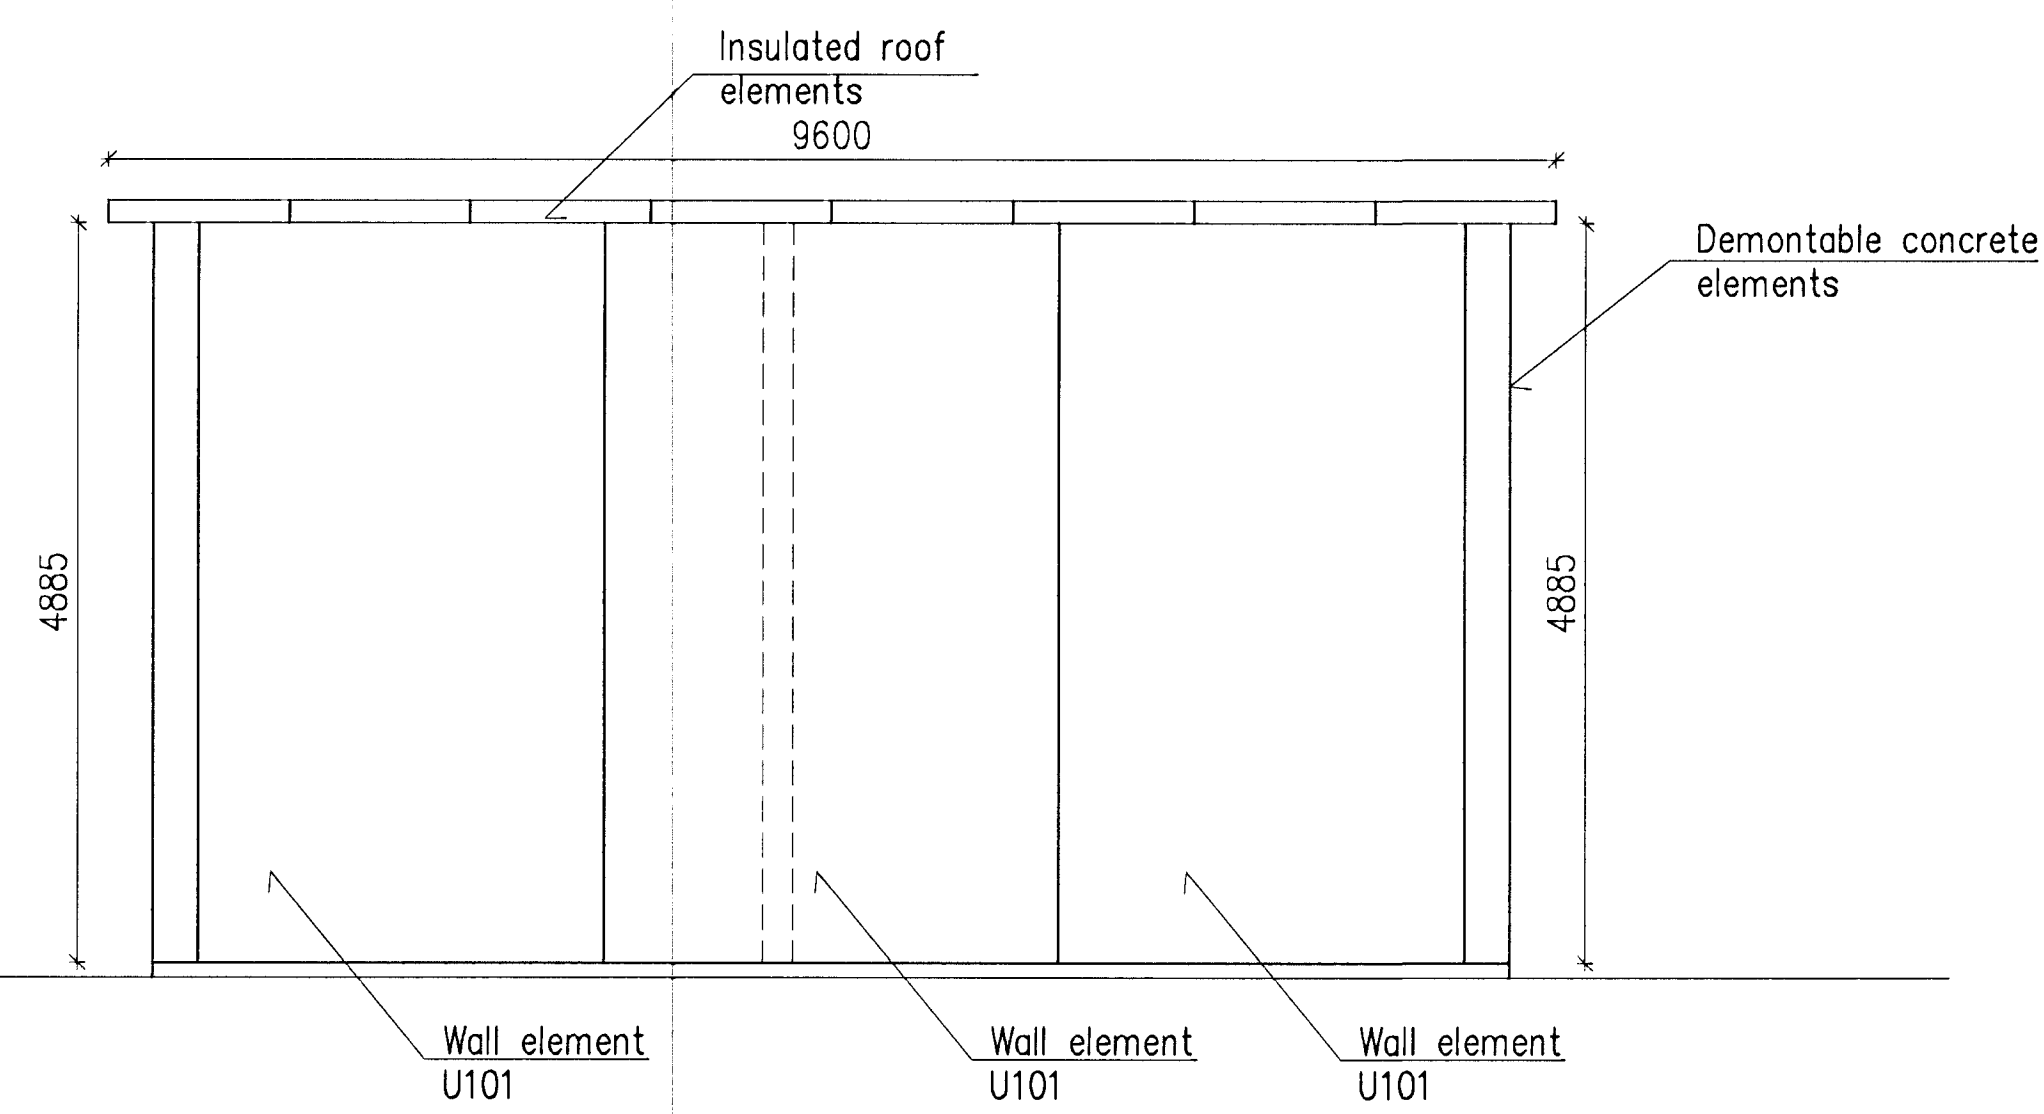

V4
281
SIDE VIEW

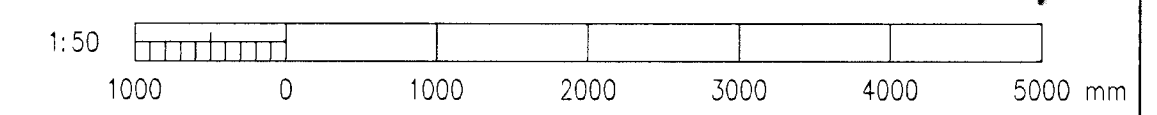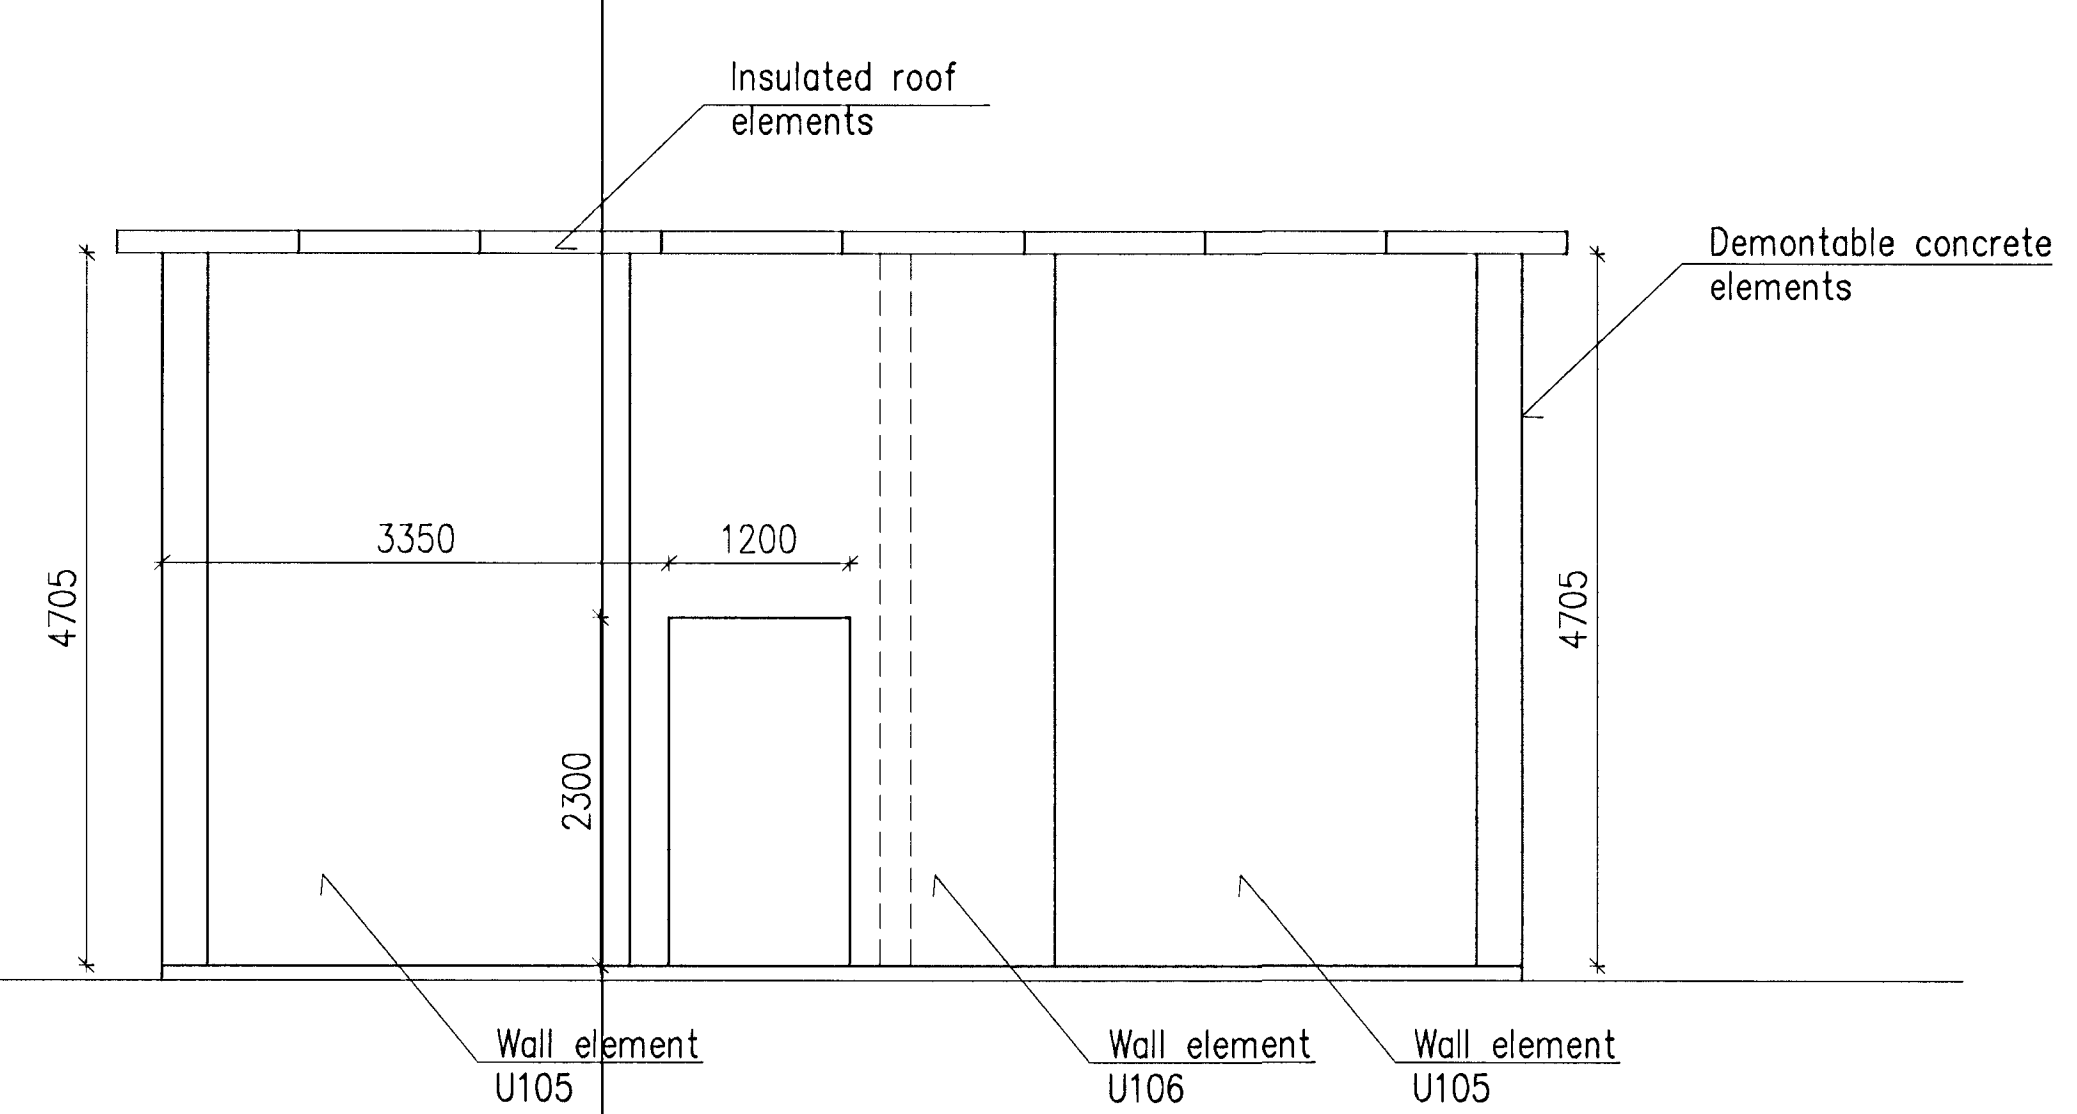

Skýringar: All detailing for walls and roofelements not shown on the drawing shall be according to manufacturers instructions and approved by the engineer.

13	As Built	2012.02.27	CMG	NI	AK	MA
Ög nr	Rev no	Dagsetning	Hor./Tva	Yfir	Notk heim	Notk heim
		Date	Des/Draw	Old	Suppl Ref	ISAL Ref

This drawing is the property of RioTinto Alcan Iceland Ltd. It may neither be copied nor made available to others without permission of RioTinto Alcan Iceland Ltd. The receiver is liable for any misuse.

Scale: 1:50
Dimensions without tolerances according to ISO 2768-1 medium.

HRV HATCH
REAL PRODUCTION OPERATORS

2009.01.08
Hannað / Designed: HFB
Tekin / Drawn: AFV
Verktaki / Supplier: HRV

Tekn.nr.verktaka / Supplier drw.no: IDP-410-C0-073-282
Sambúikt / Approved: NI
Húti of: / Part of: NI

IPU 410 - SUBSTATION
PL3 - BOOSTER BUILDING
SIDE VIEWS

Flakkur nr.: 4011
Blæð nr.: 16784
Næsta bl.nr.:
Kostn.nr.-Cono. / Blönn.-Eq.no

WALLS & ROOF ELEMENTS
AKS
UB136

RioTinto Alcan
Alcan Iceland Ltd
Straumark
IS-222 Hafnarfjarður
Iceland

Tekn.nr. ISAL / Drw.no. of ISAL: 251309
Breyt./Rev: A

ISAL Yfirfarið og skráð, dags / ISAL Checked, date
ISAL Sambúikt, dags / ISAL Approval, date