



Níels Indriðason
 Kt. 181144-3949 NI


DOOR OPENING 1:20

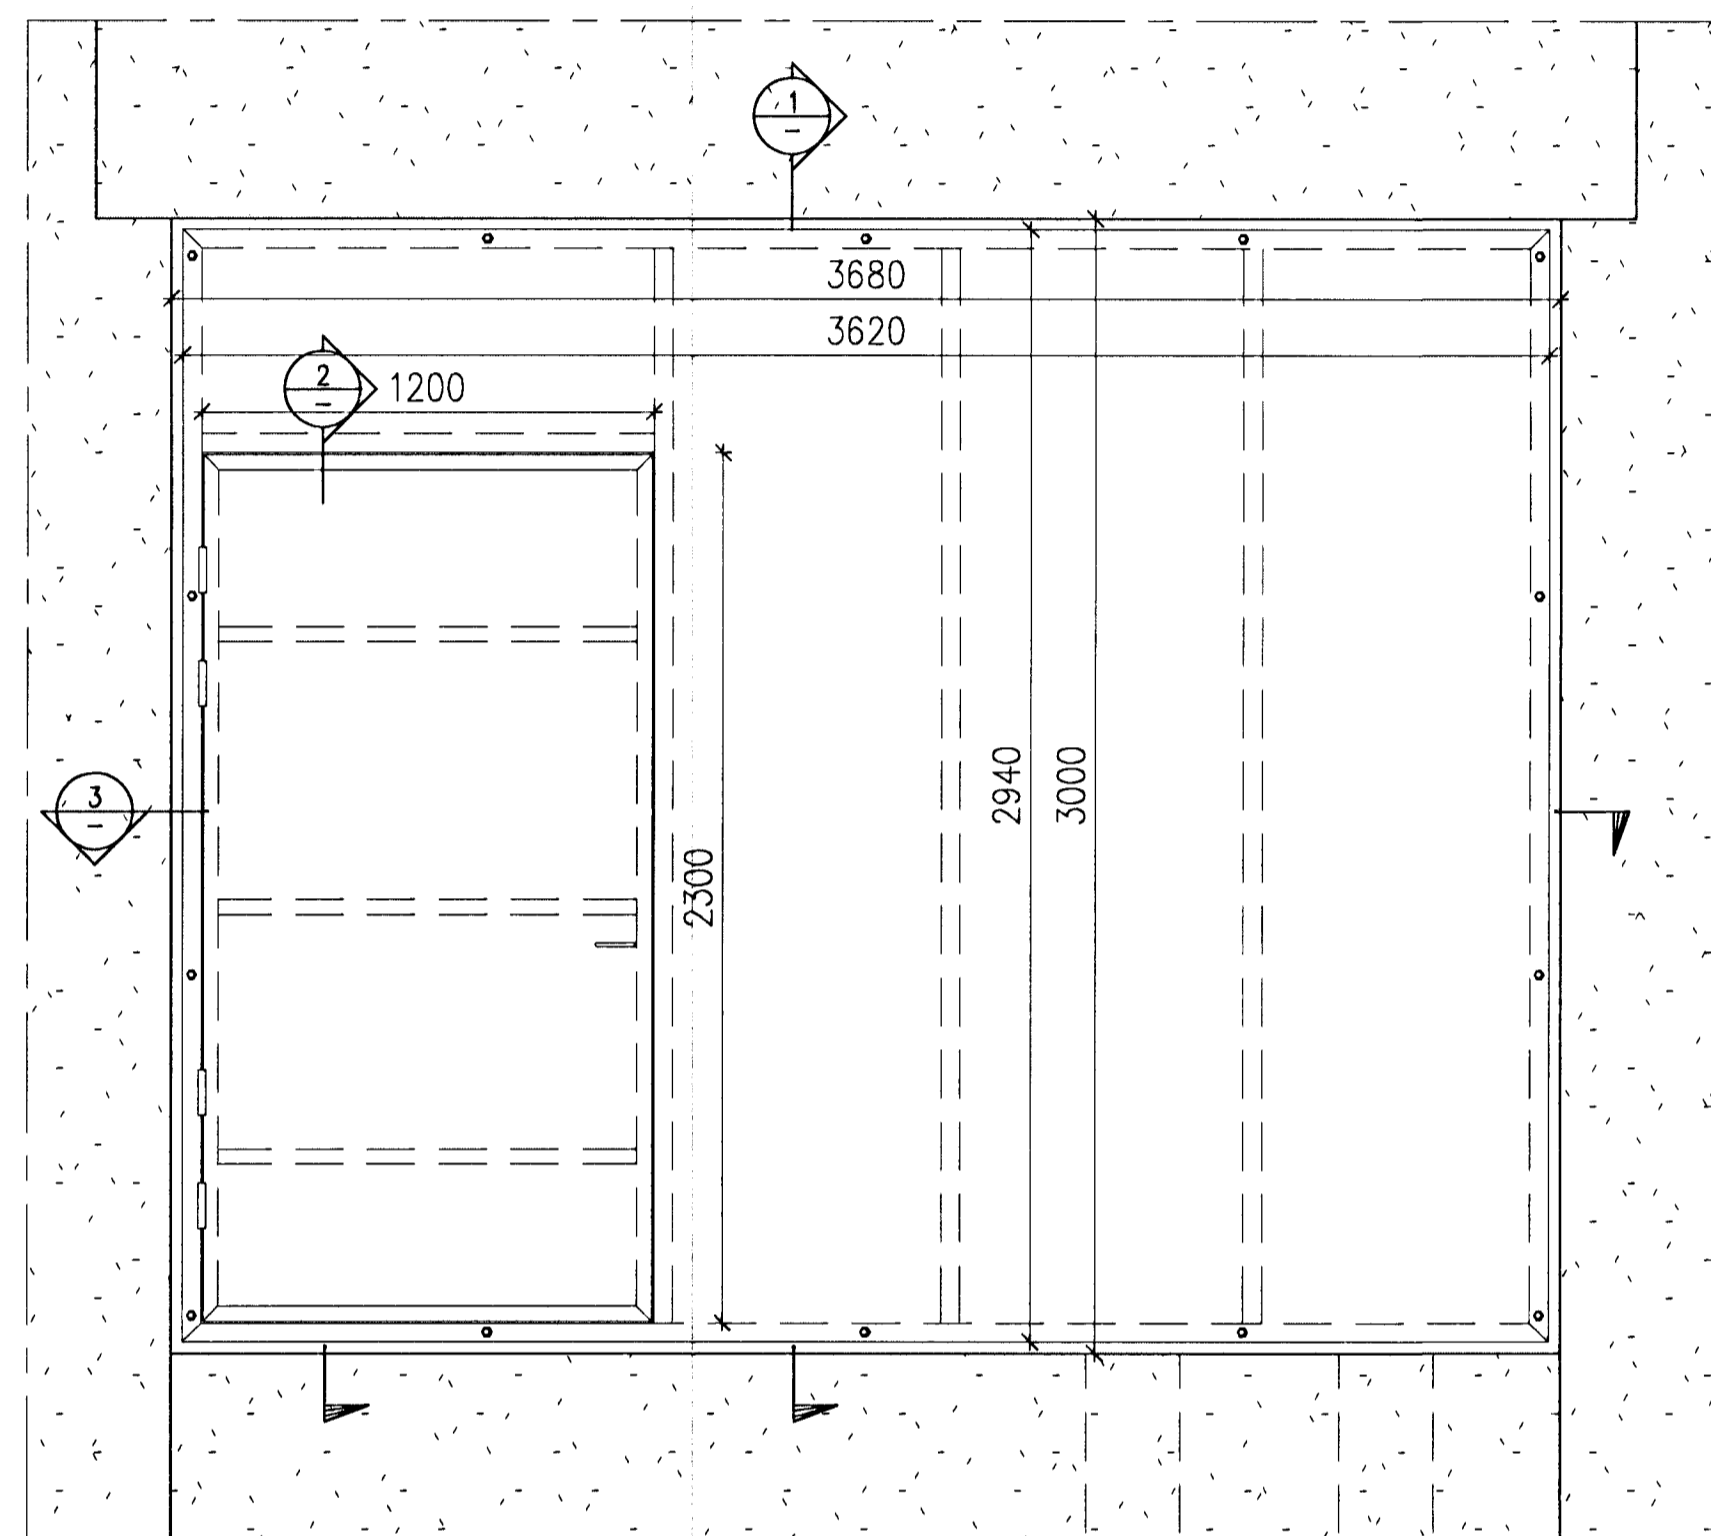



1 SECTION
 1:10

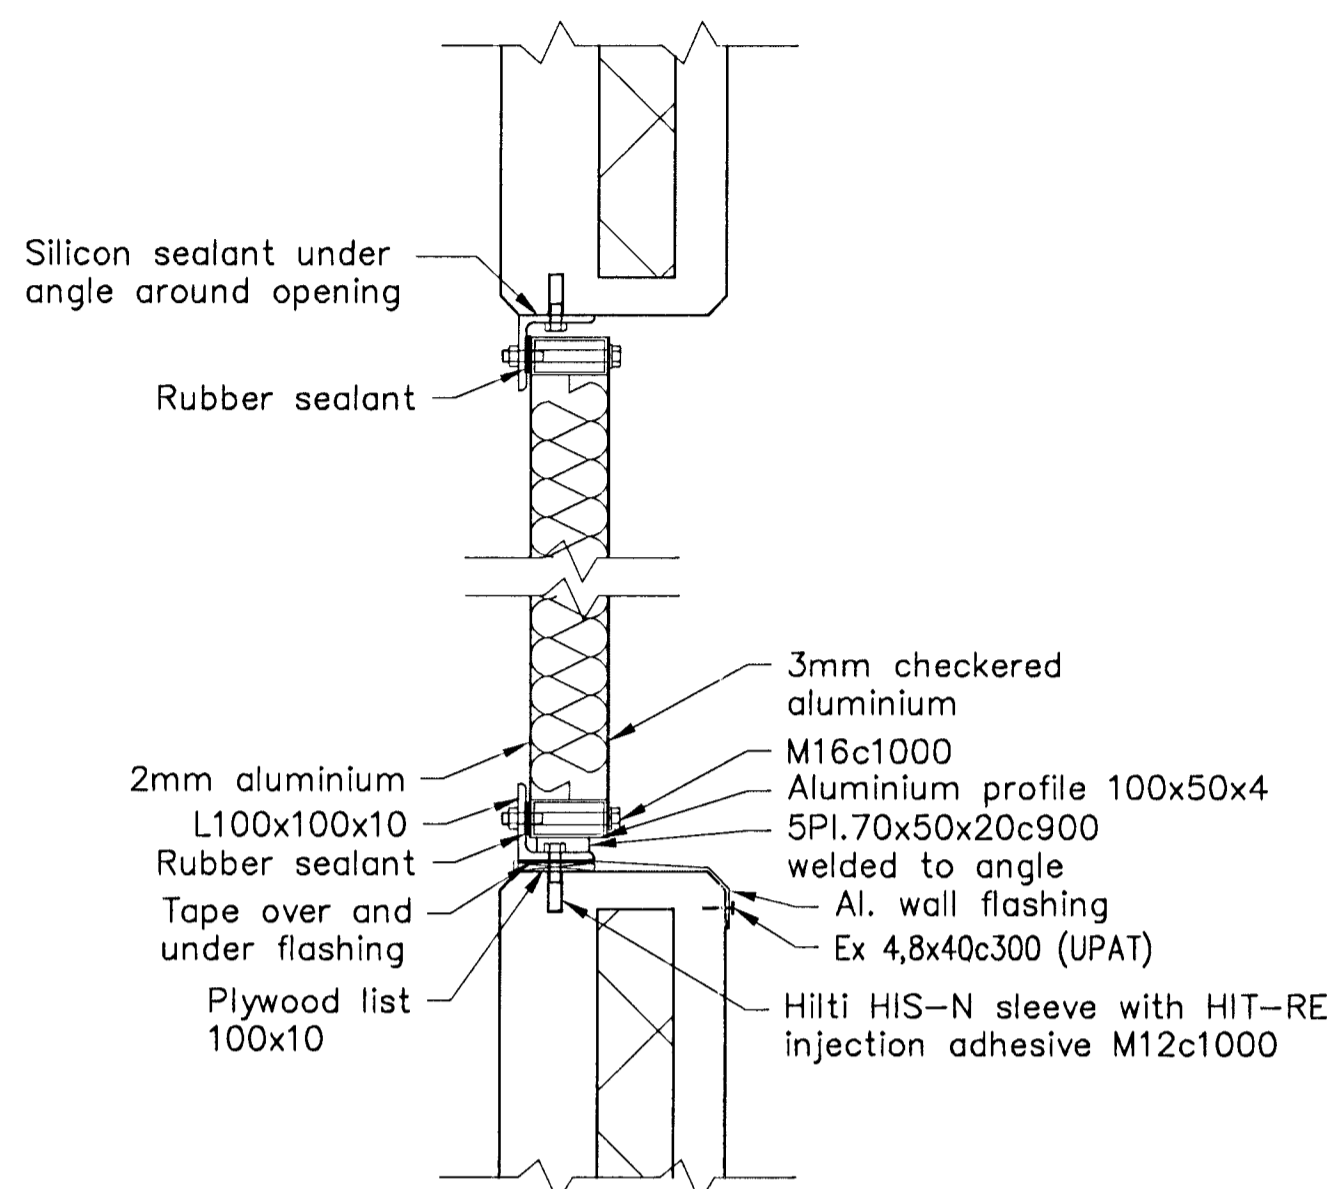

2 SECTION
 1:10

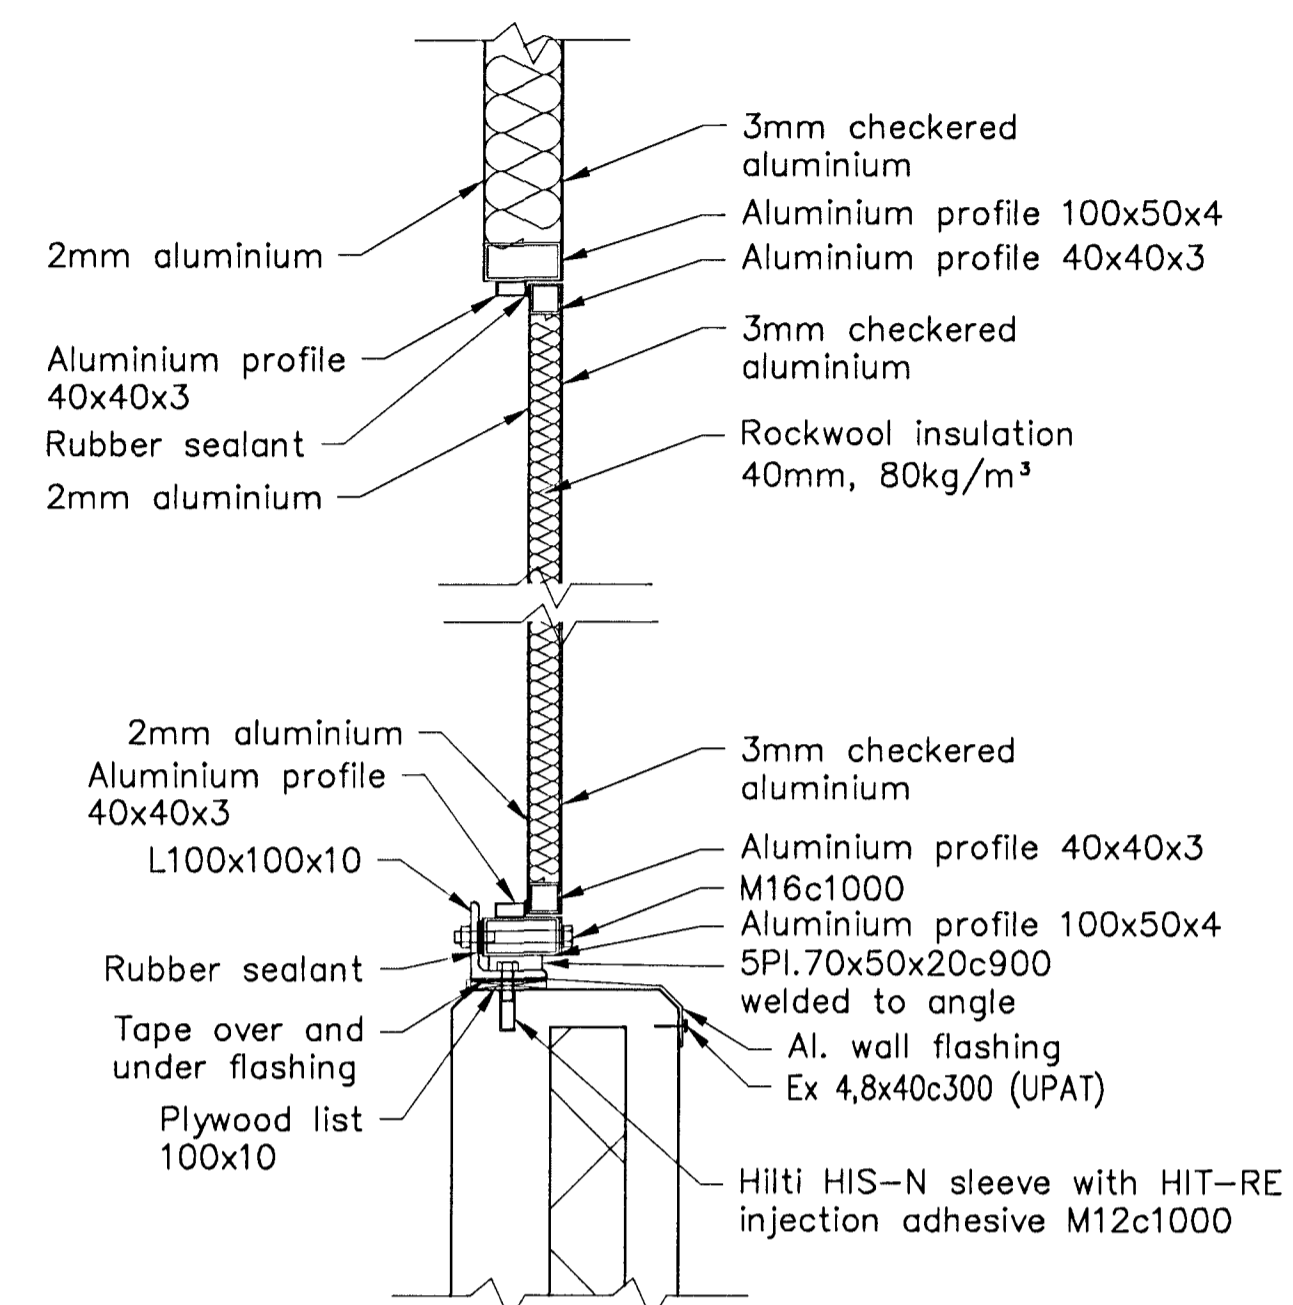

3 SECTION
 1:10

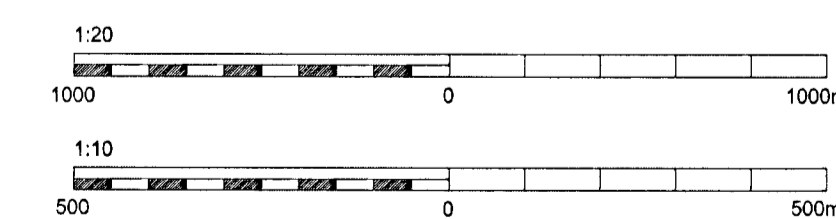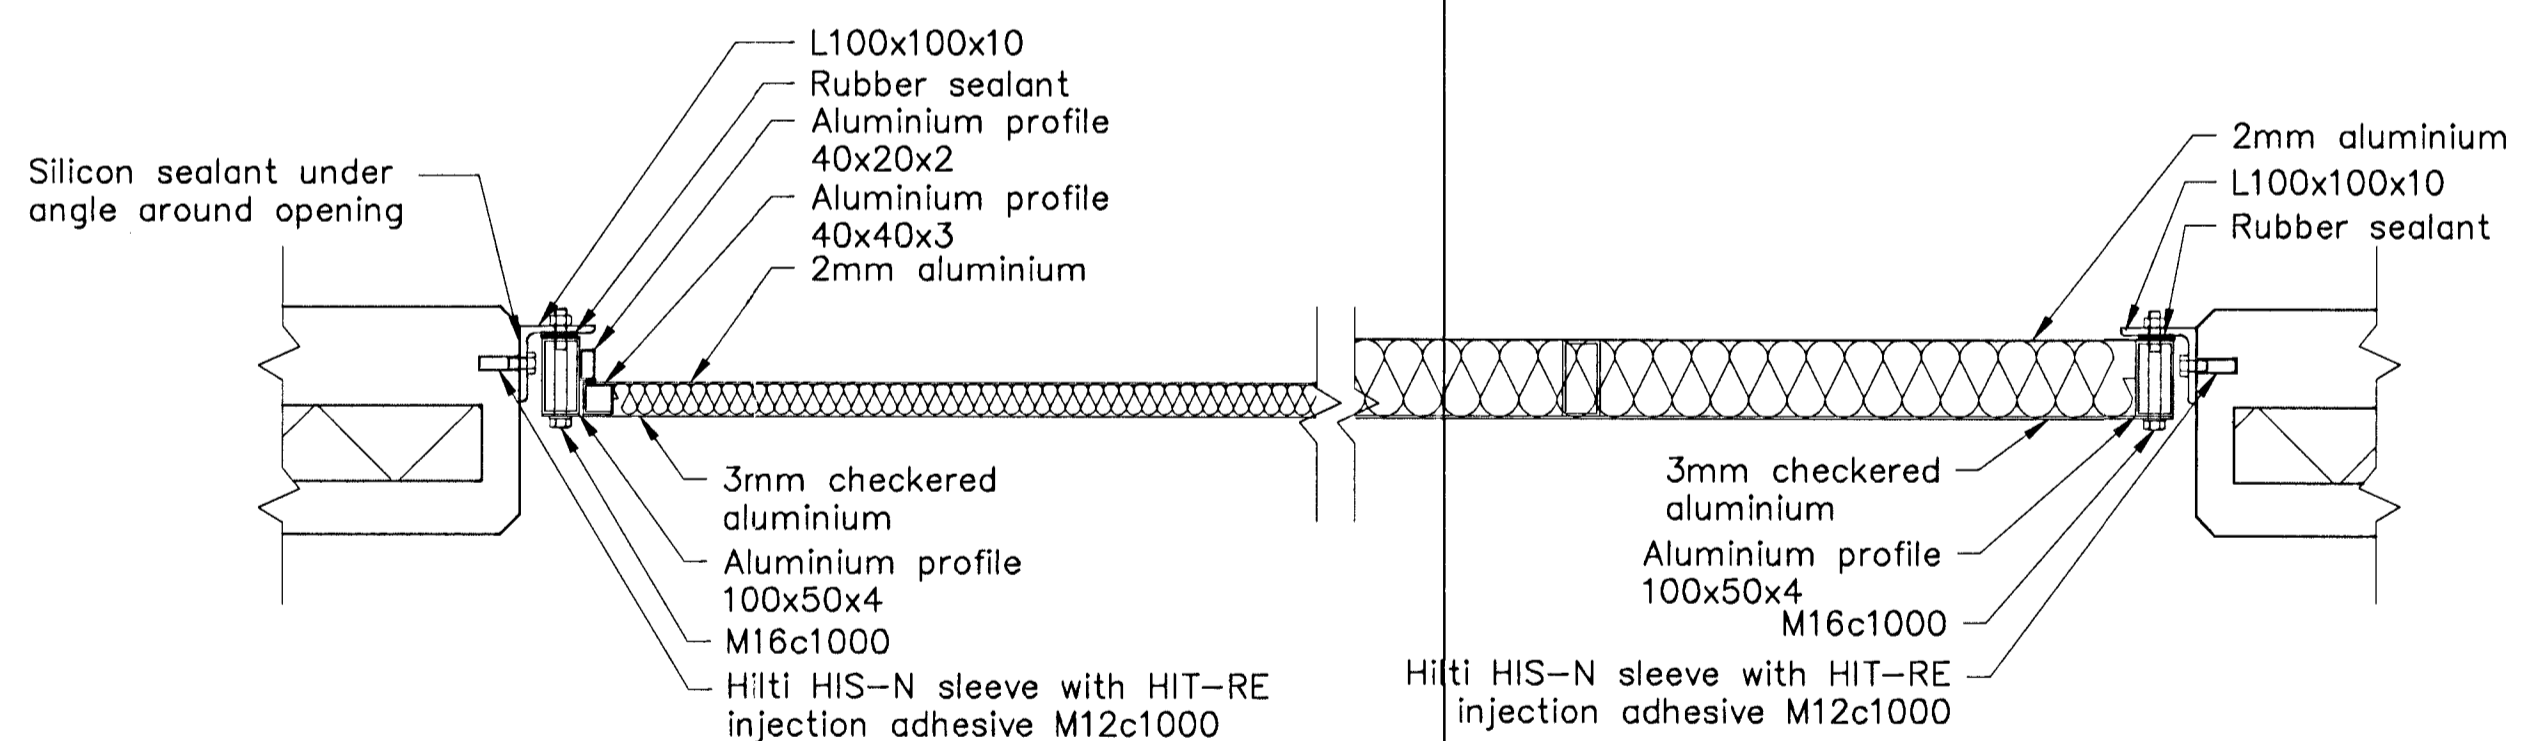

Skýringar: Legend:	This drawing is the property of Rio Tinto Alcan Iceland Ltd. and handed out for personal use only. It may neither be copied nor made available to others without permission of Rio Tinto Alcan Iceland Ltd. The receiver is liable for any misuse.					 HRV ISAL PRODUCTION UPGRADER	Dagsetning / Date: 2011.04.06 Hönnuð / Designed: HJH/GMG Tækn / Draw: GMG Verktaki / Supplier: HRV Tæknirætttaka / Supplier drw.no: ICC-212-ZA-517-201 Samþykkt / Approved: NI Hilti af / Part of: NI		IPU 212 SUBSTATION 61 DOOR OPENING, SIDE VIEW AND SECTIONS STEEL STRUCTURE		Flakur nr.: 4011	Blað nr.: 16940	Næsta bl. nr.: UB61
	2 As Built Útg. nr. / Rev. no. 2012.02.16 Date GMG Des./Dw. NI FH JSH	Hilti af / Part of:	ISAL Yfirráð og skráð, dags / ISAL Checked, date ISAL Samþykkt, dags / ISAL Approved, date	ISAL Flakur nr. / ISAL No. of Flakur 260560	ISAL Blað nr. / ISAL No. of Sheet A		ISAL Næsta bl. nr. / ISAL Next Sheet No. UB61						