




Níels Indriðsson
 Kt. 181144-3949

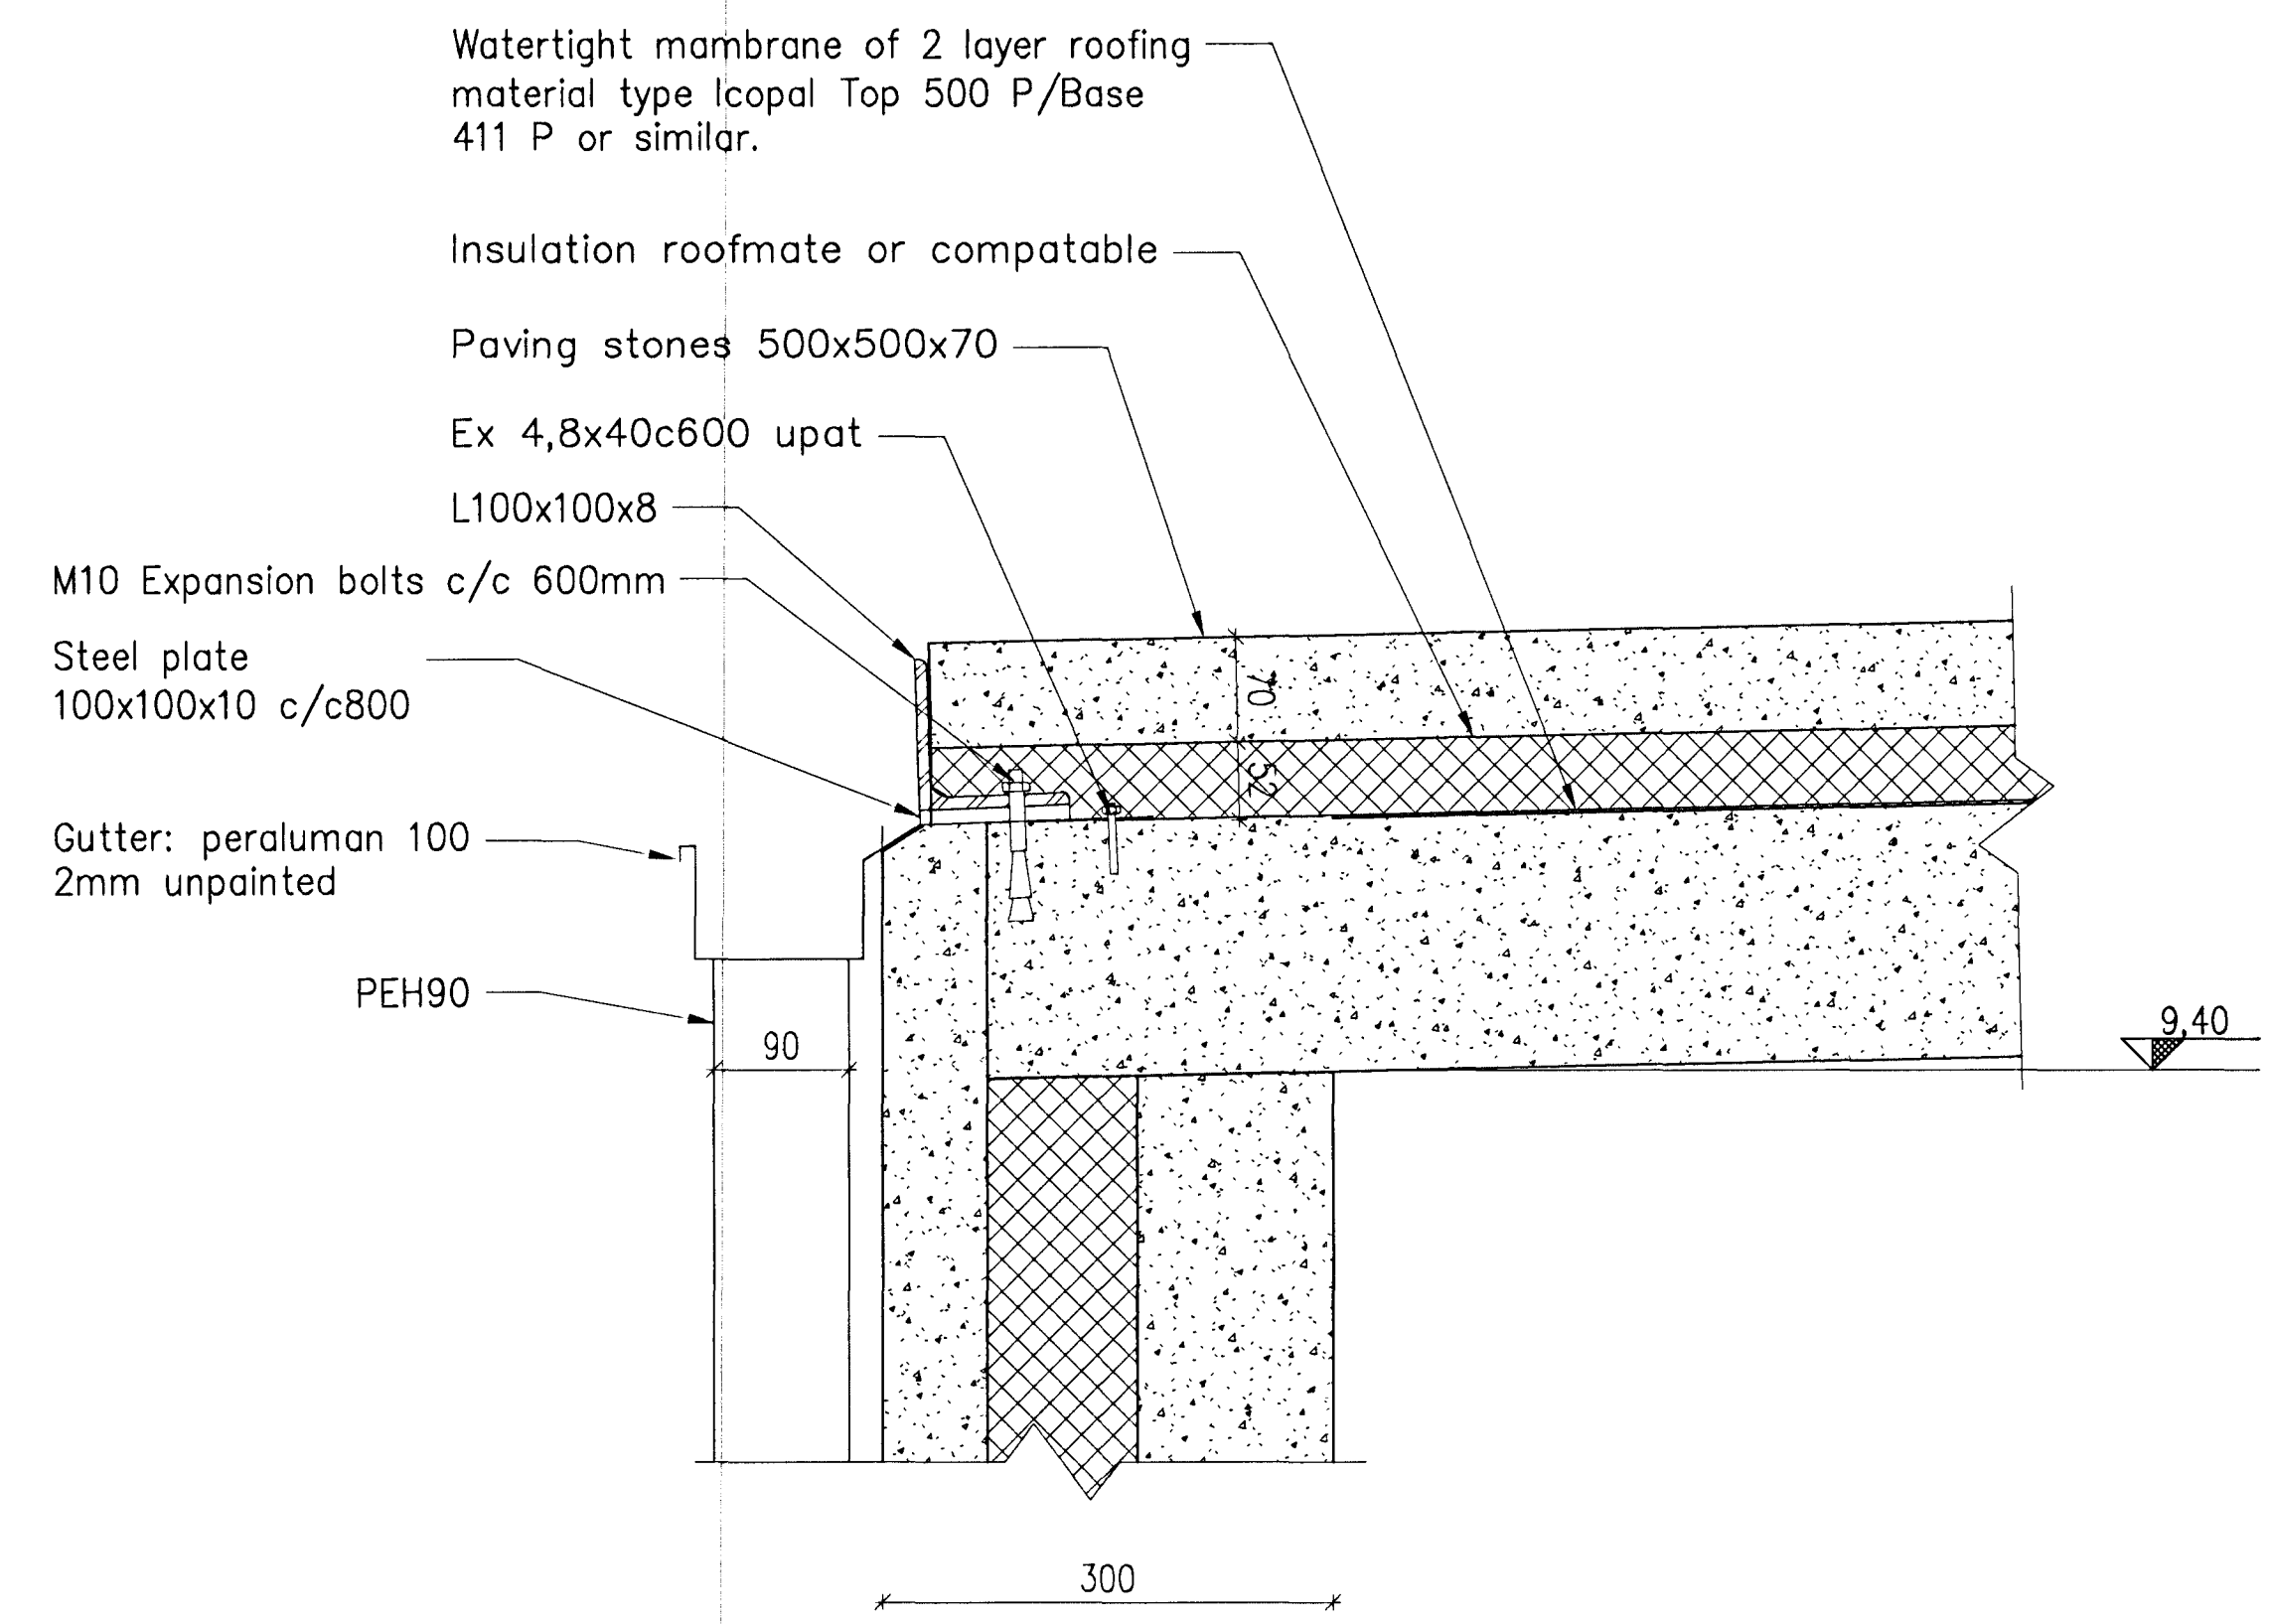

D1 DETAIL
 001 1:5

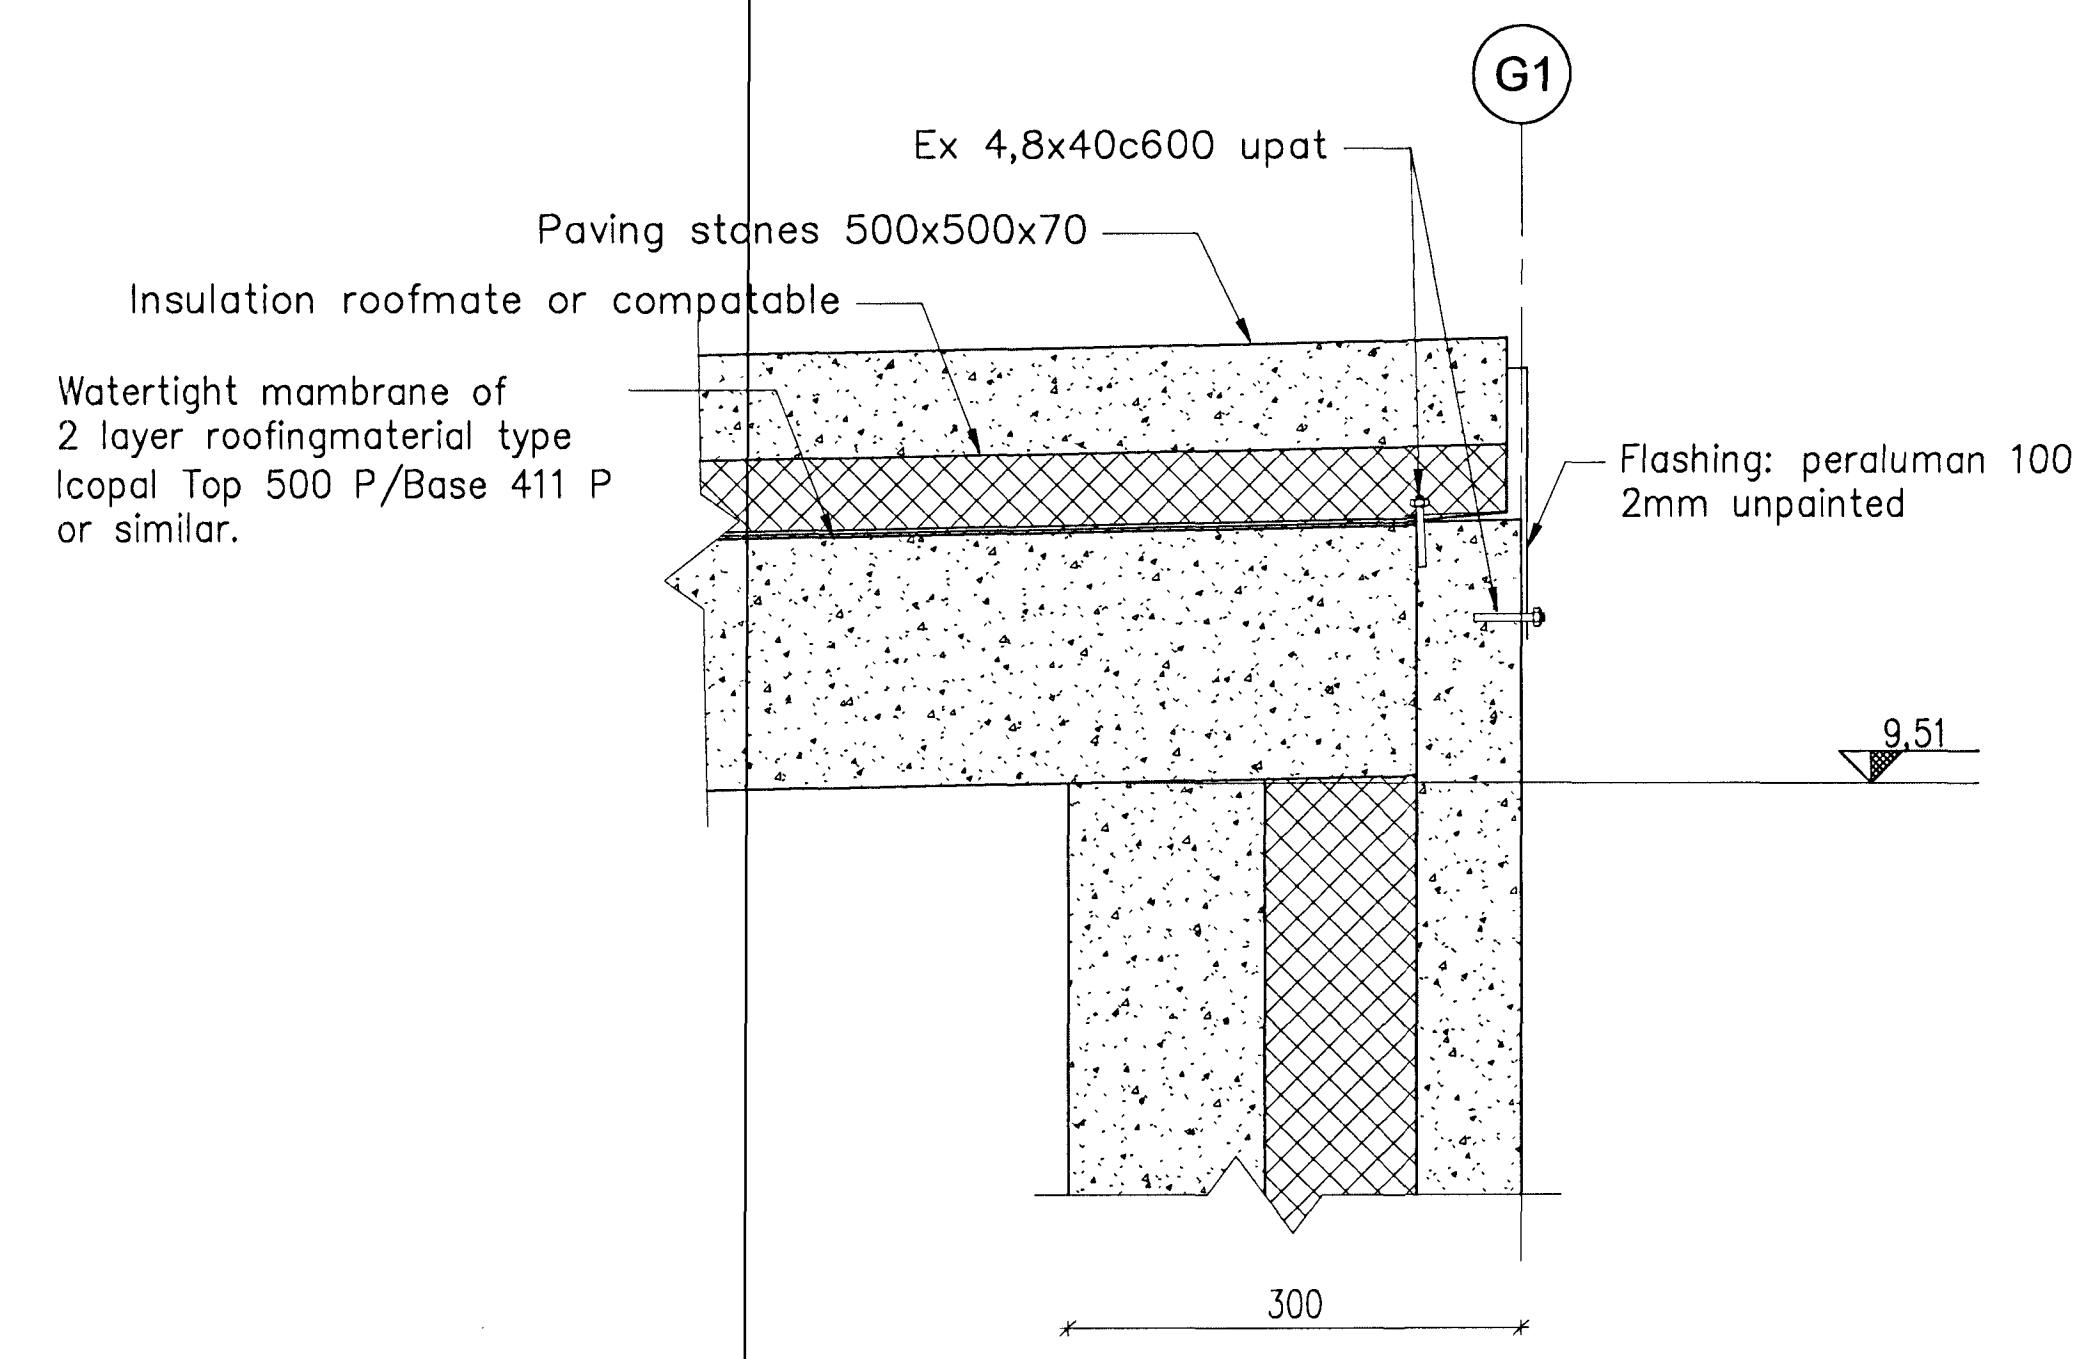

D2 DETAIL
 001 1:5

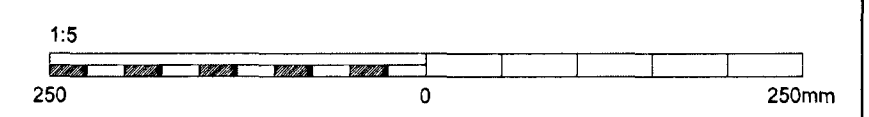

Skýringar: Legend	This drawing is the property of Rio Tinto Alcan Iceland Ltd and handed out for personal use only. It may neither be copied nor made available to others without permission of Rio Tinto Alcan Iceland Ltd. The receiver is liable for any misuse.											Dagsetning / Date 2010.05.28		IPU 212 - SUBSTATION 61		Flokkur nr.:	Blöð nr.:	Nesta bl. nr.:			
	Standard: A1 Format: A1 Scale: 1:5 Dimensions without tolerances according to ISO 2768-1 medium.											Formaður / Designed: HFB Tækn / Drawn: ÁFV		BUILDING LAYOUT		Kosta.nr.-Göno. / BSN.nr.-Eq.no	4011	16940			
										Verktaki / Supplier: HRV		Tæknir.verktaki / Supplier drw.no: ICC-212-CA-517-002 Samþykkt / Approved: YHJ / Öhd HJH		Tæknir. ISAL / Drw.no. of ISAL: 260552 Breyt./Rev: A		AKS UB61					
3 As Built Útg. nr / Rev. no: 3 Lýsing / Description: As Built										2012.02.16 Dagaþing / Date: 2012.02.16 Hönn./Tækn. Des./Drw: GMG		YHJ YHJ YHJ		Nafn heim. / Supplier: NI FH		Nafn heim. / Supplier: NI FH		ISAL ISAL		ISAL Yfirfarð og skráð. dags / ISAL Checked, date ISAL Samþykkt, dags / ISAL Approved, date	