
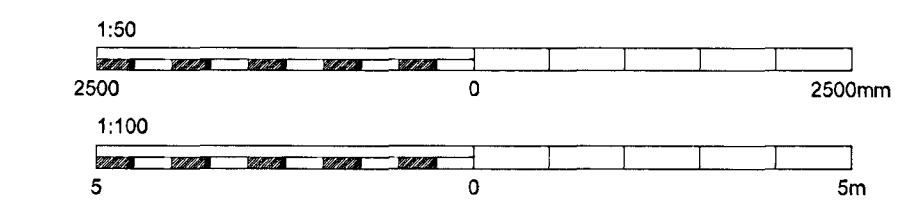


Níels Indriðason  
 Kt. 181144-3949

ROOF VIEW, 1:100

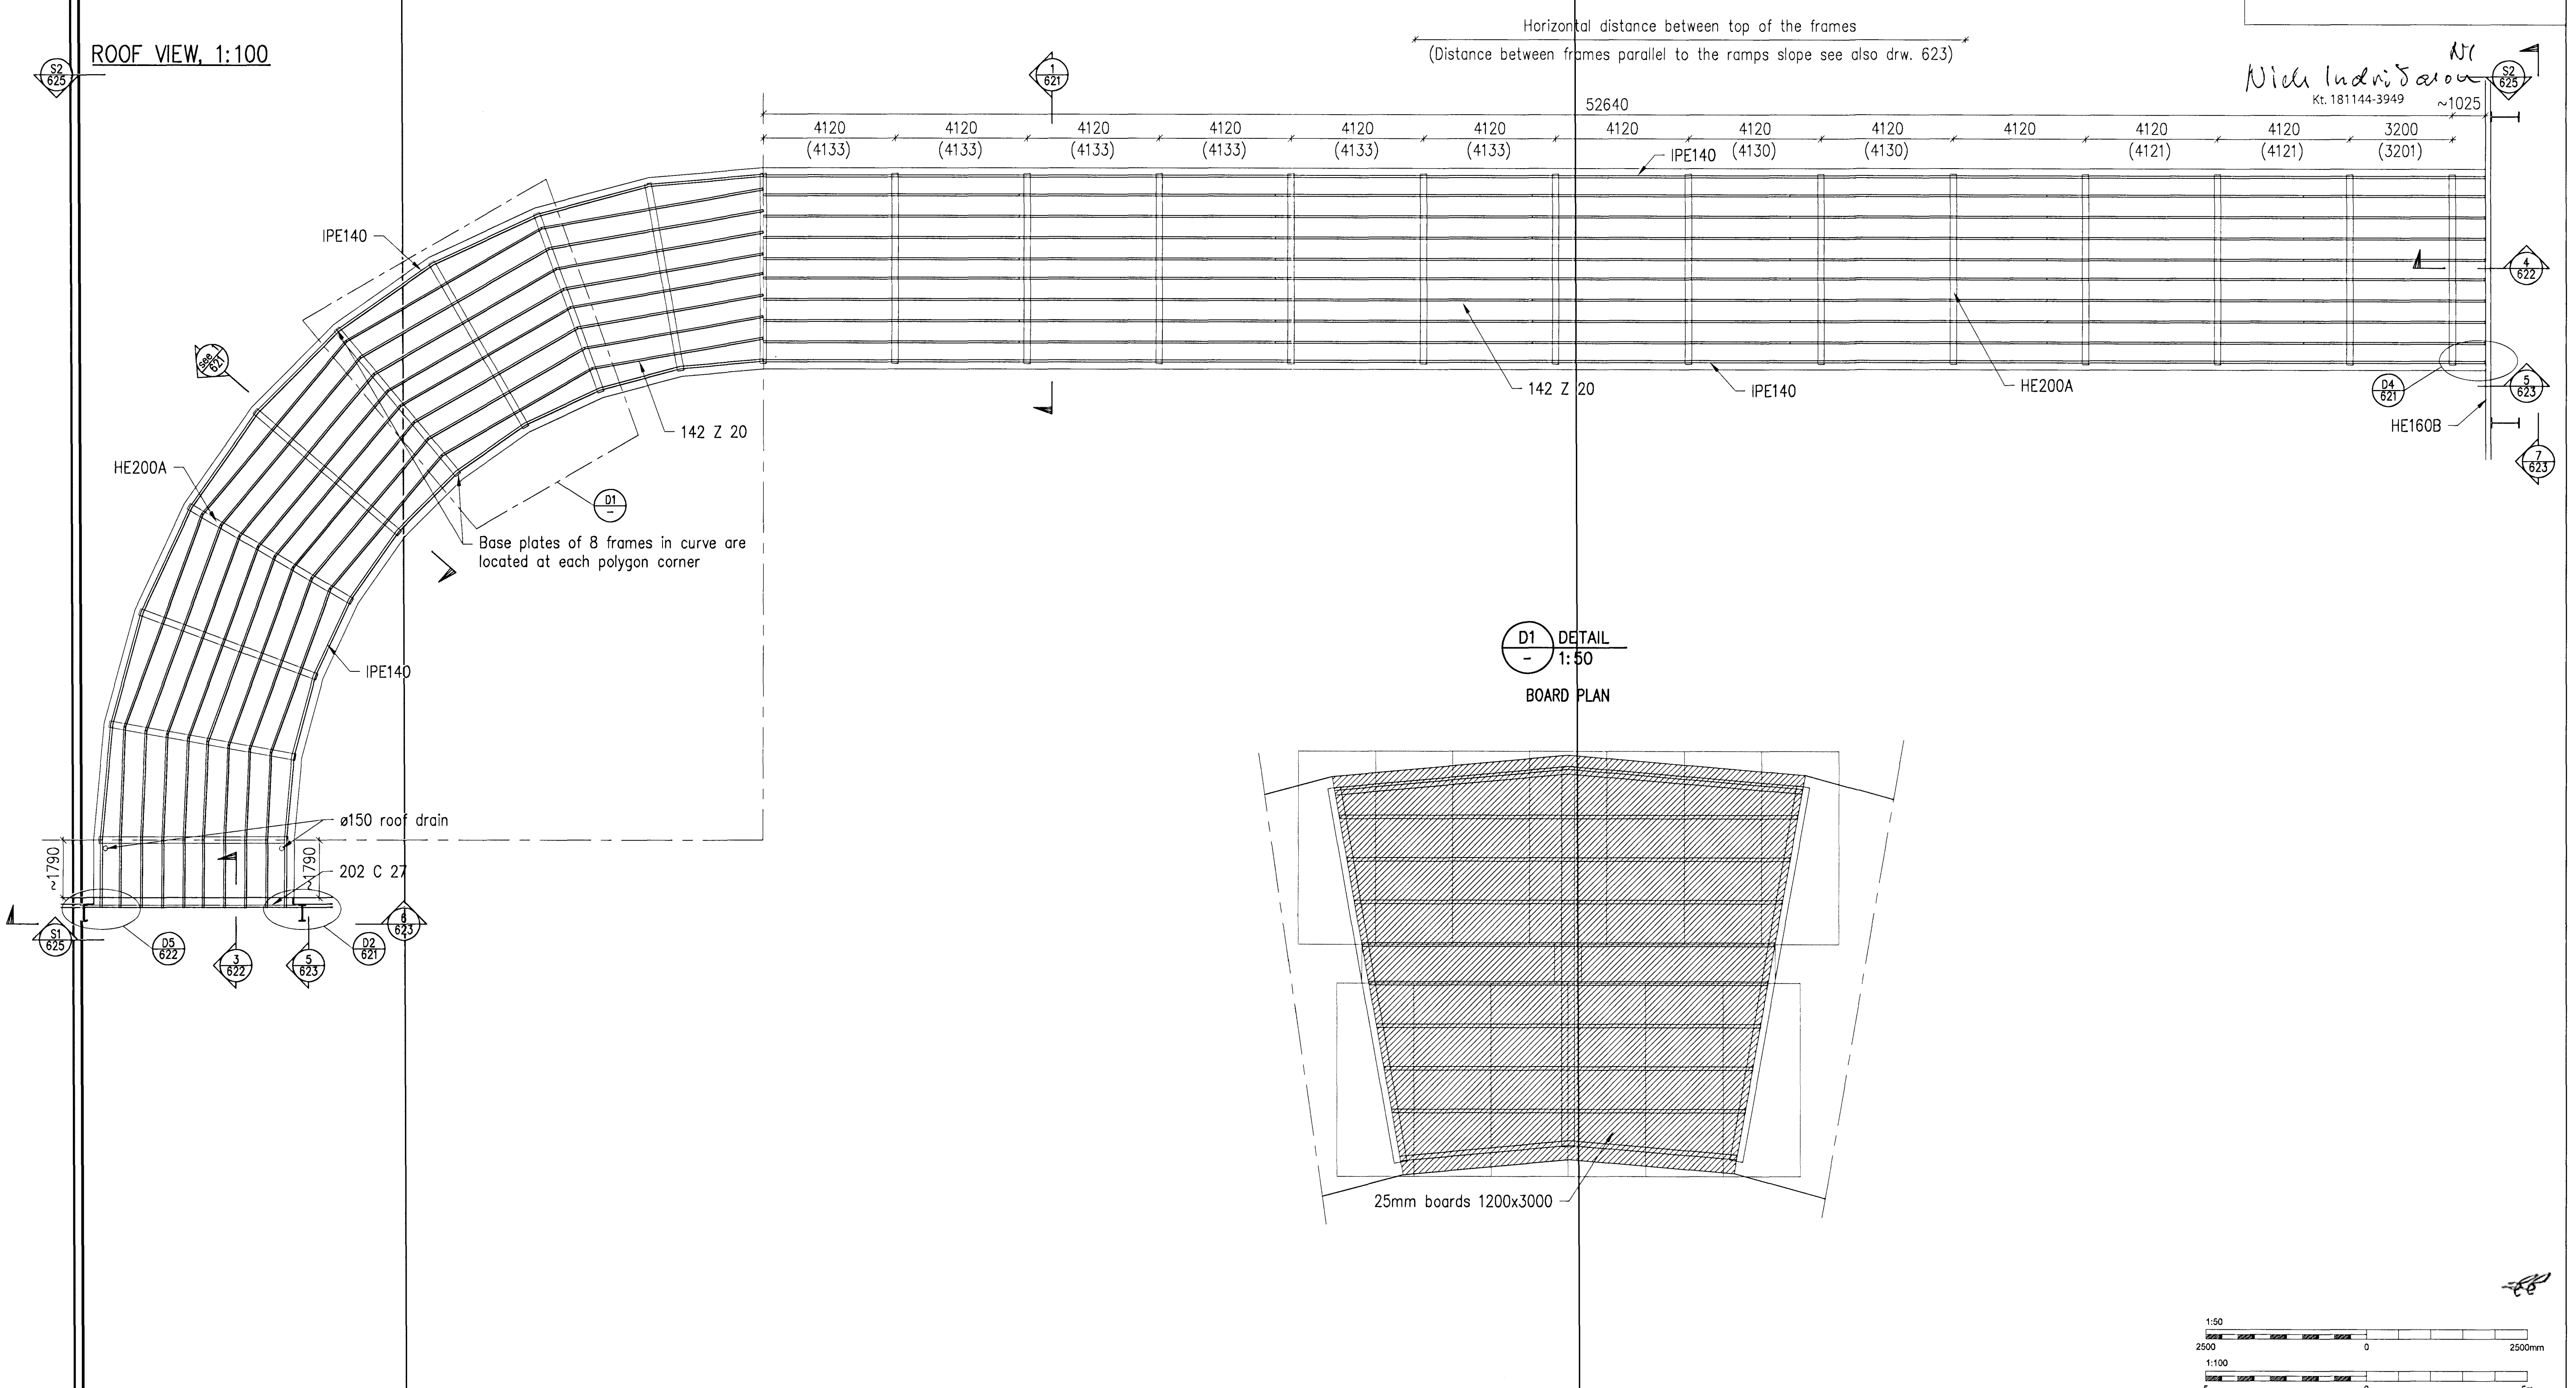

Skýringar: Legend:	GENERAL NOTES see drawing ICC-611-CA-541-600	This drawing is the property of Rio Tinto Alcan Iceland Ltd. and may not be copied or used in any way without the written permission of Rio Tinto Alcan Iceland Ltd. The receiver is liable for any misuse.				Dagsetning / Date 2011.04.07		IPU-CASTHOUSE EXTENSION BUILDINGS, RAMPS RAMP 1 ROOF VIEW		Flokkur nr.: 5010	Blað nr.: 16957	Næsta blinn.:
			Formati: A1 Scale: 1:50/100 Dimensions without tolerances according to ISO 2768-1 medium.		Tekn. / Drawn HS LDB	Verktaki / Supplier HRV	Tekn.nr.verktaka / Supplier drw.no. ICC-611-ZA-541-620	Teg.teikningar / Dwg. type: STEEL STRUCTURE	ISAL Tekn.nr. ISAL / Drw.no. of ISAL 253546	AKS UF002	Breyt./Rev. A	
7 Ótg nr Rev no	Record Drawing	2012.07.23 Dagsetning Date	HS Höf./Tkn Des./Drw	NI Yfir Old	PG Notk heim Suppl Rel	HRV	Húti af: / Part of:	<b>RioTinto Alcan</b>		ISAL Sambýkt, dags / ISAL Checked, date ISAL Sambýkt, dags / ISAL Approved, date		