
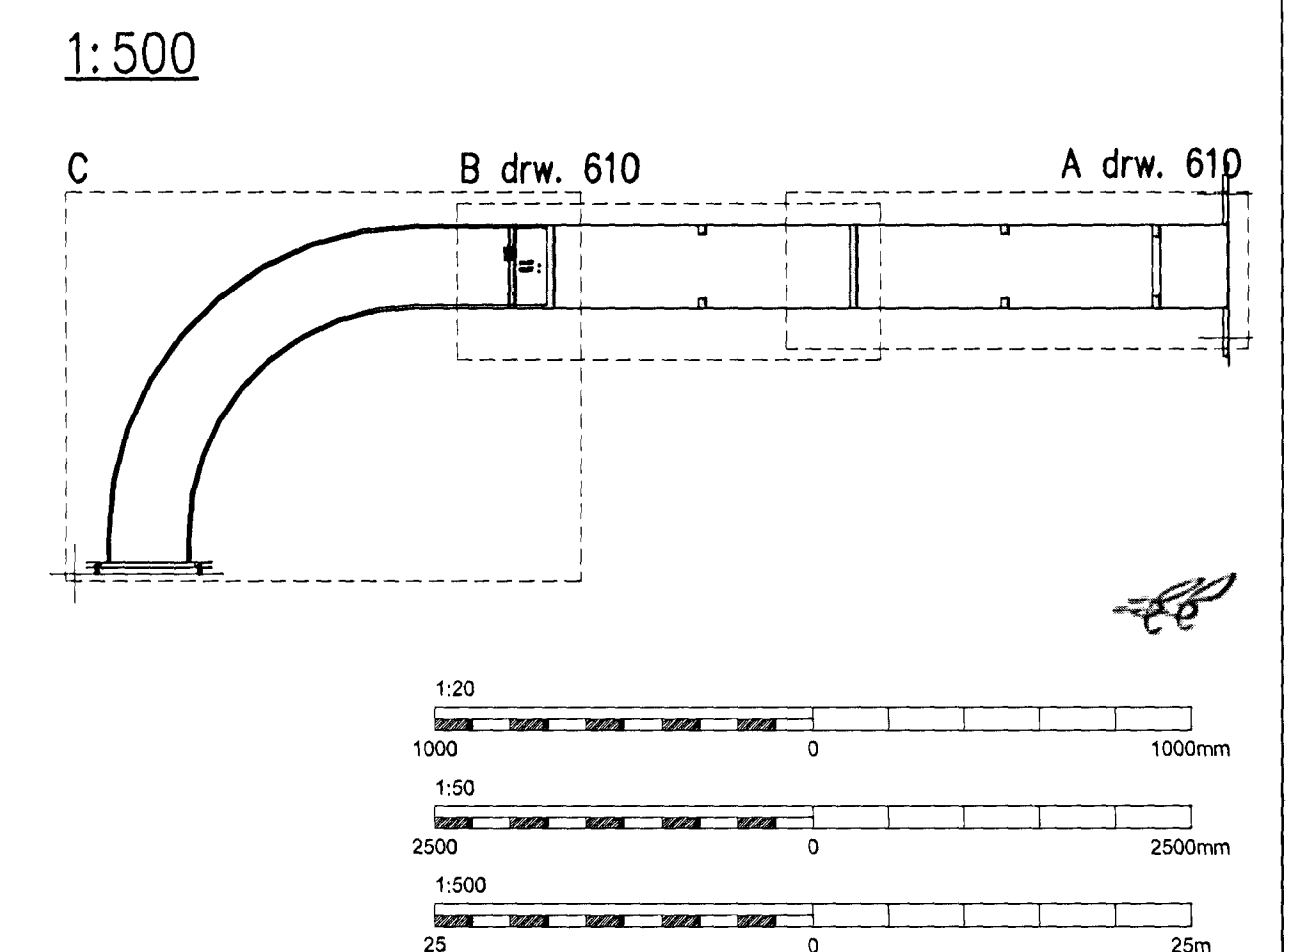


SLAB PLAN - C, 1:50

Samþykkt þann  
 02 OCT 2012  
 Byggingafulltrúginn / Hafnarfjörður  
 F.h. Sigurður Steinar Jónsson

Níels Indriðason  
 Kt. 181144-3949  
 NI

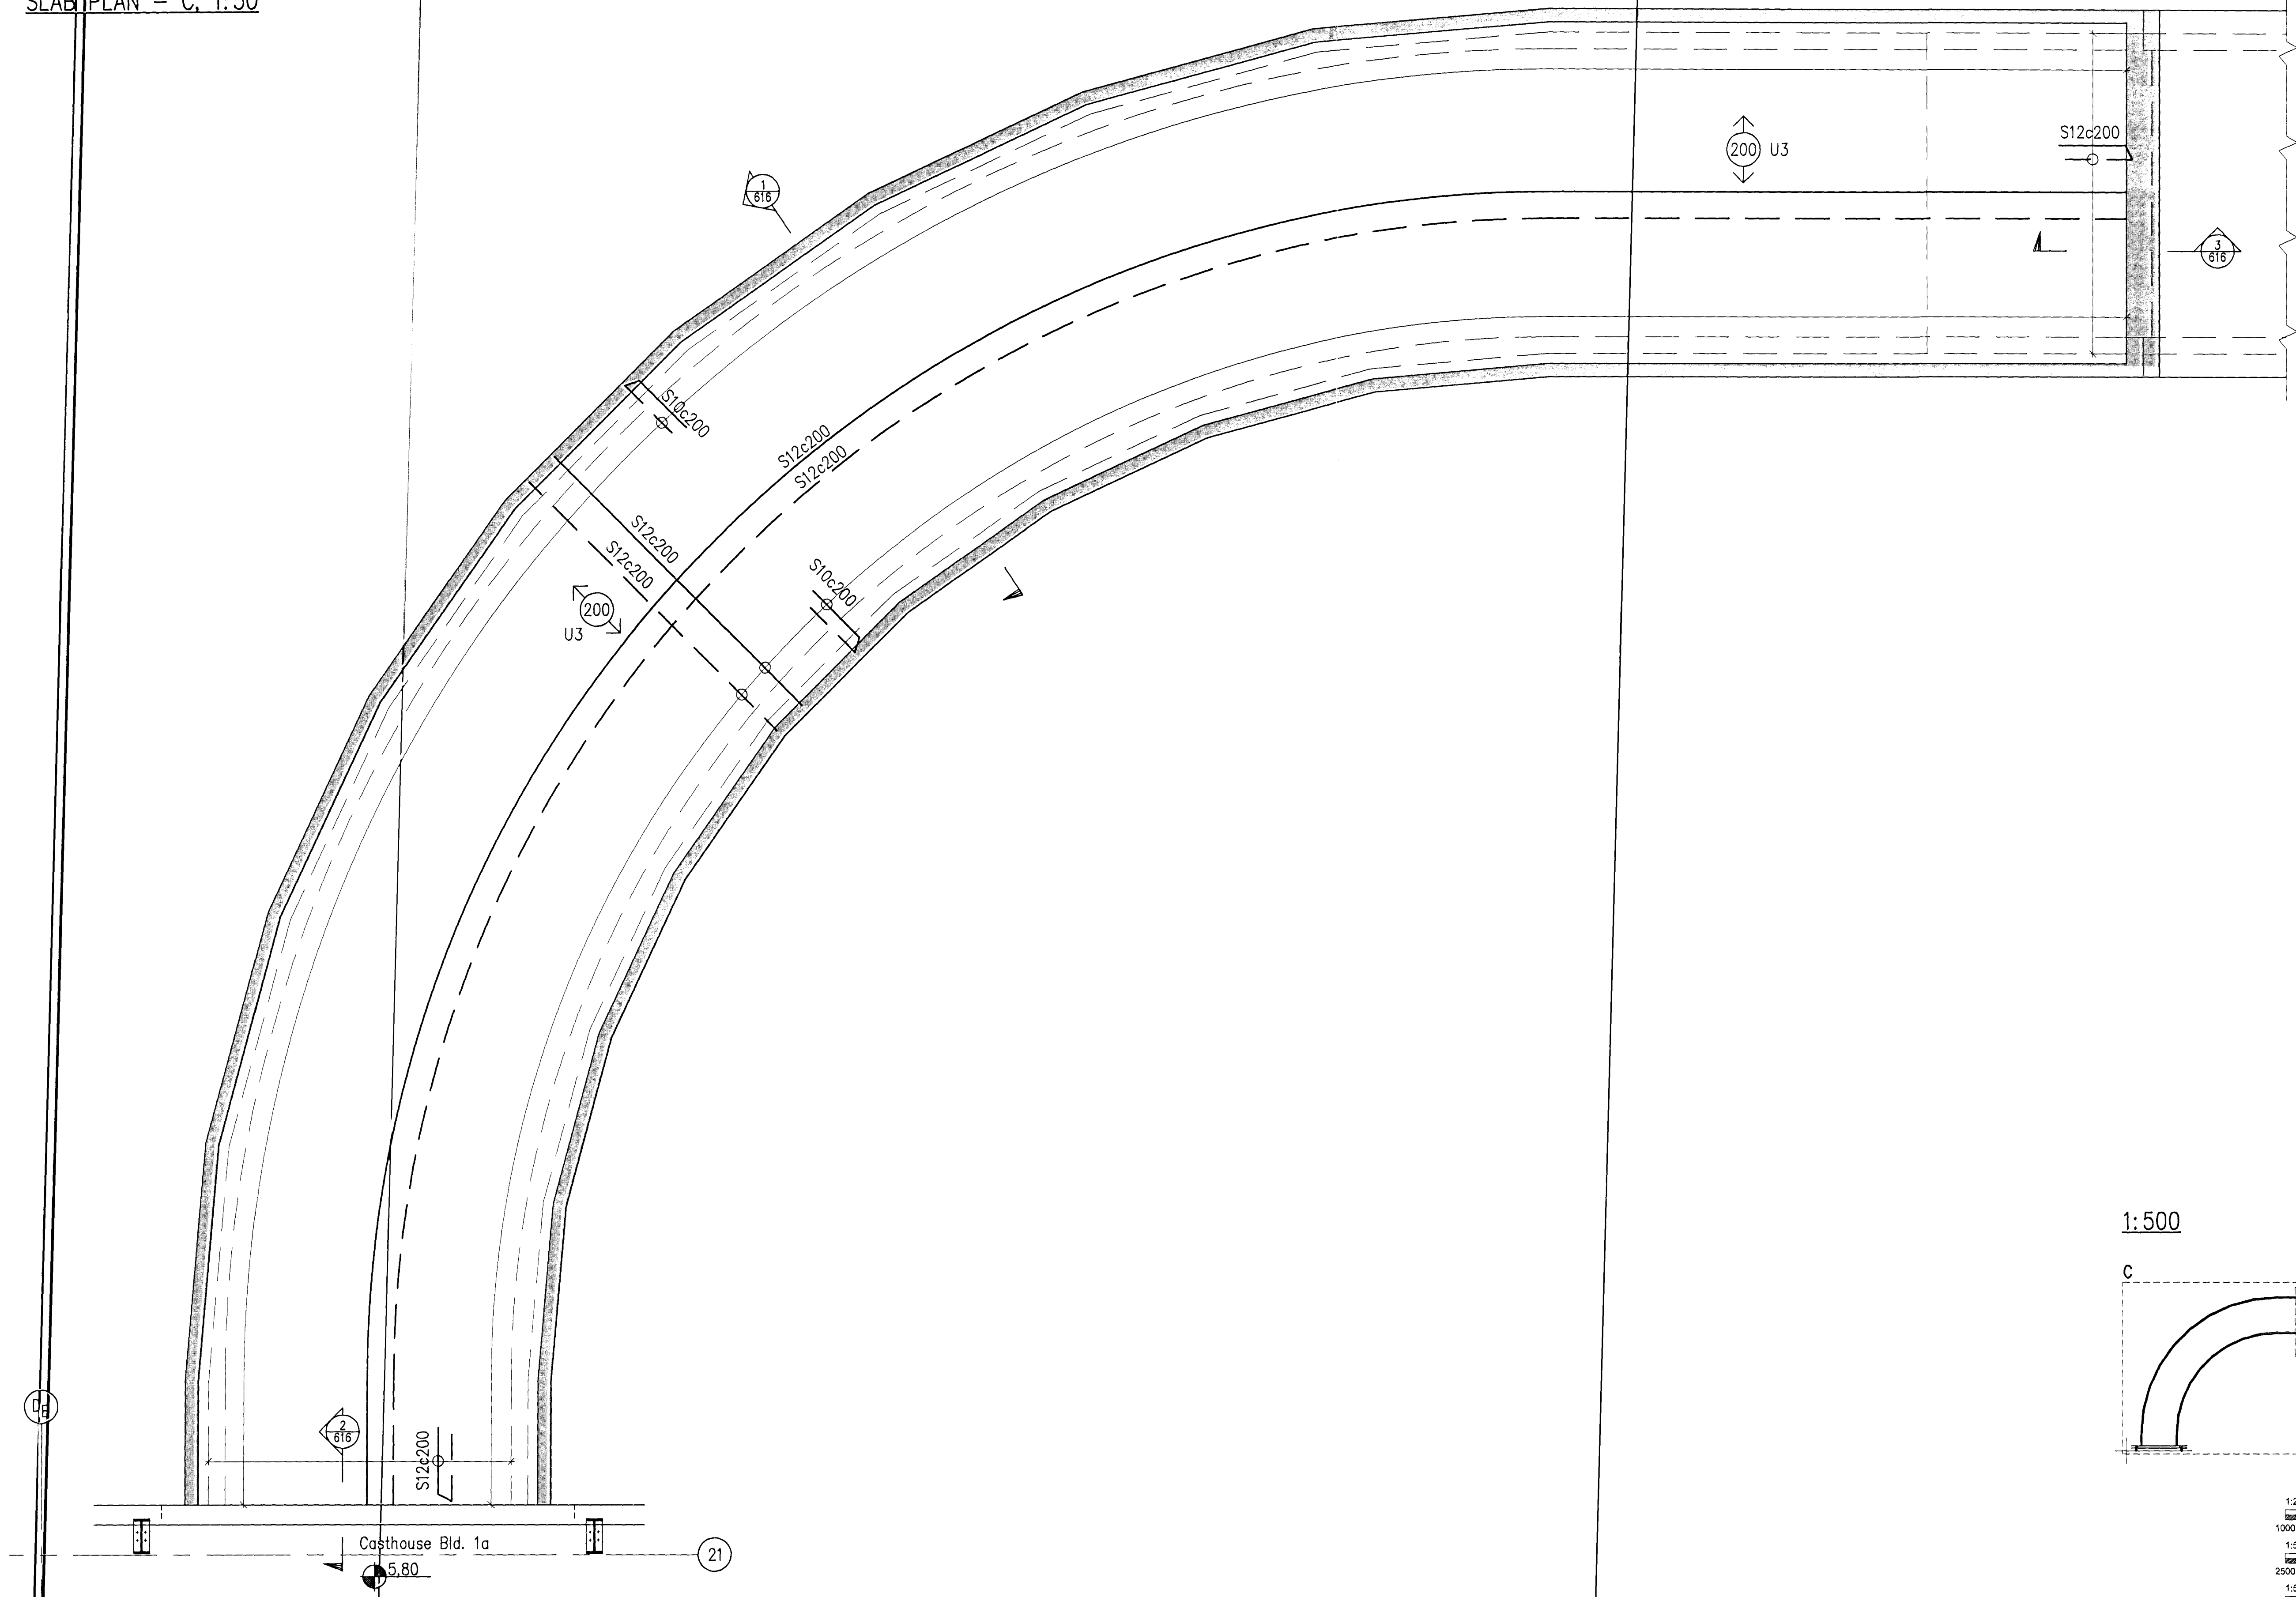

Skýringar: GENERAL NOTES see drawing ICC-611-CA-541-600  
 Legend: CONCRETE: C30/37:XF3-38  
 Concrete cover for reinforcement (tolerances acc. to F5ENV1992)  
 Top of slab with traffic 60 mm  
 except slab on filling 40 mm  
 Precast elements are shown on contractors drawings

|        |                |            |          |      |           |           |
|--------|----------------|------------|----------|------|-----------|-----------|
| 5      | Record Drawing | 2012.07.23 | GMG      | NI   | PG        | HRV       |
| Étg nr | Lýsing         | Dagsetning | Hon./Tón | Yfir | Notk heim | Notk heim |
| Rev no | Description    | Date       | Des/Drw  | Old  | Suppl     | ISAL Ref  |

This drawing is the property of Rio Tinto Alcan Iceland Ltd. and handed out for personal use only. It may neither be copied nor made available to others without permission of Rio Tinto Alcan Iceland Ltd. The receiver is liable for any misuse.

**HRV & HATCH**  
 JOINT VENTURE  
 REAL PRODUCTION UPGRADE

Dagsetning / Date: 2011.04.07  
 Hönnað / Designed: HS/GMG  
 Tækn / Drawn: LDB  
 Verktaki / Supplier: HRV  
 Tækn.nr.verktaka / Supplier drw.no.: ICC-611-CA-541-611  
 Samþykkt / Approved: NI  
 Hluti of / Part of:

IPU-CASTHOUSE EXTENSION BUILDINGS, RAMPS  
 RAMP 1  
 PLAN VIEW 2/2  
 REINFORCEMENT

Flokkur nr.: 5010  
 Blað nr.: 16957  
 Nasta blinn.:  
 Kostn.nr.-Cano. / Blm.nr.-Eq.no.:  
 AKS  
 UF002  
**Rio Tinto Alcan**  
 Alcan Iceland Ltd  
 Straumsvík  
 IS-222 Hafnarfjörður  
 Ísland

Tækn.nr. ISAL / Drw.no. of ISAL: 253522  
 Breyt./Rev.: A

ISAL Yfirráð og skráð, dags / ISAL Checked, date  
 ISAL Samþykkt, dags / ISAL Approval, date

C:\NDR\04\IPU\099 As-built EPCM\600\ICC-611-CA-541-611-5.dwg