




Samþykkt þann /
02 OCT 2012
 Byggingafultrúnaður / Hafnarátt
 Fh. Sigurður Steinar Jónsson

Níels Indriðason
 Kt. 181144-3949 NI



FOUNDATION F4
 1:20

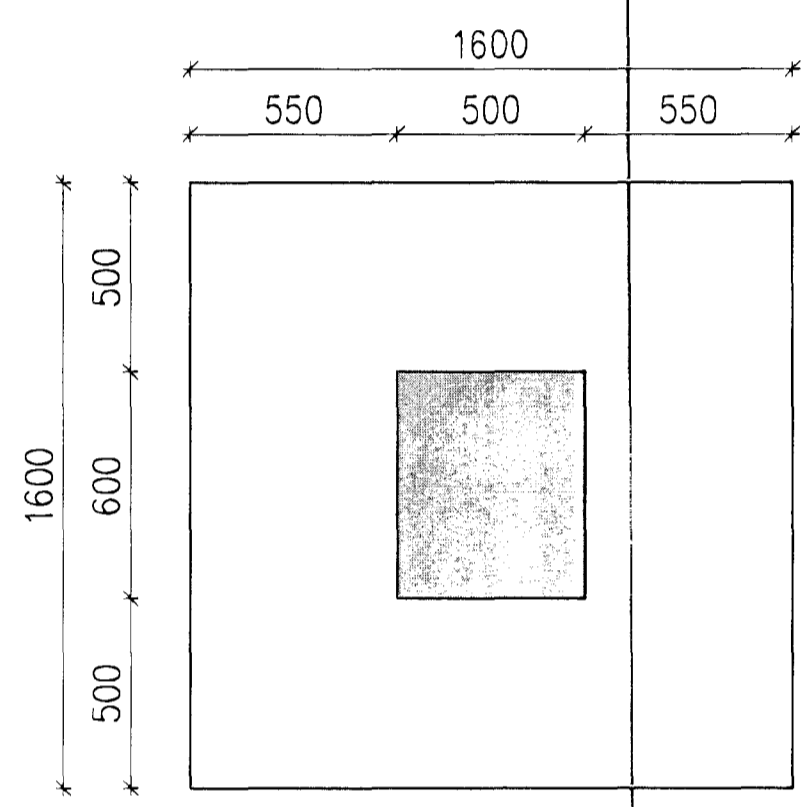

FOUNDATION F5
 1:20

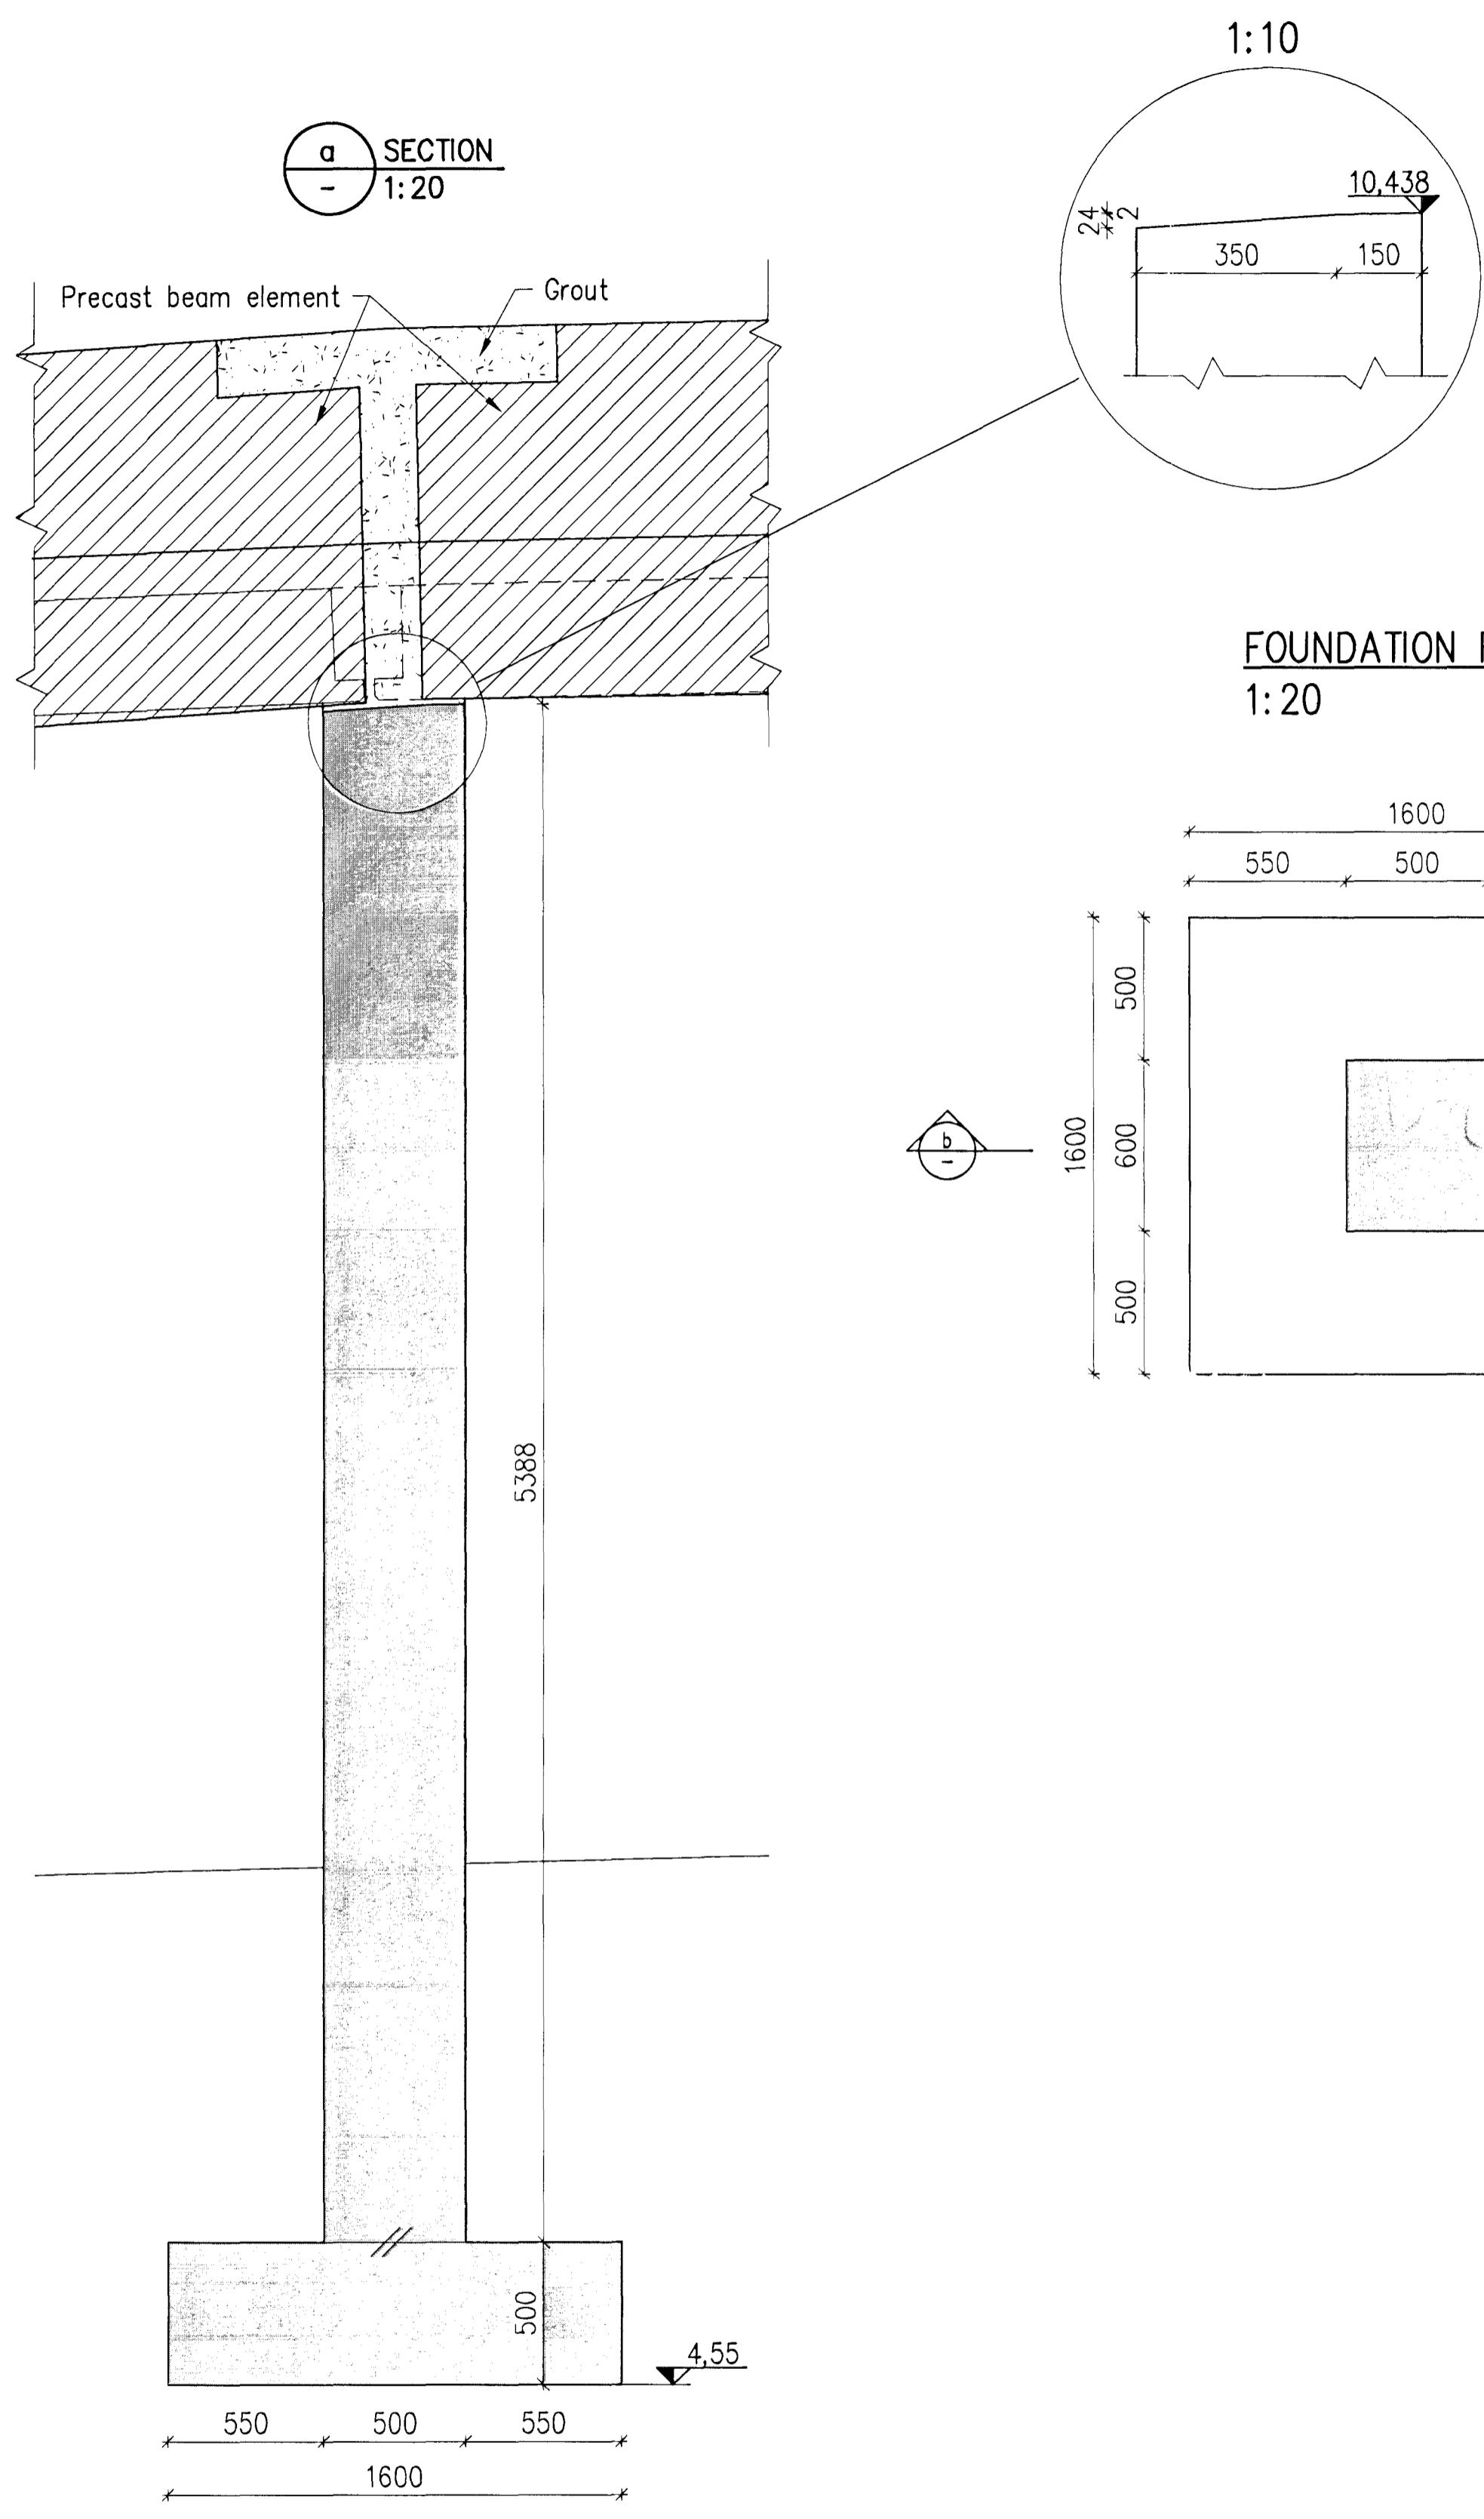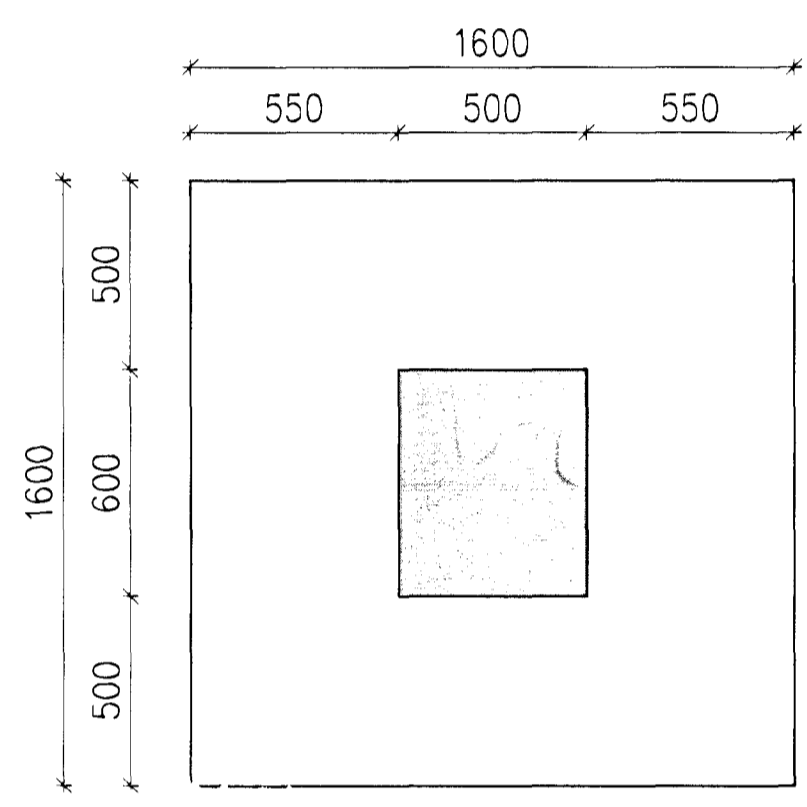

b SECTION
 1:20

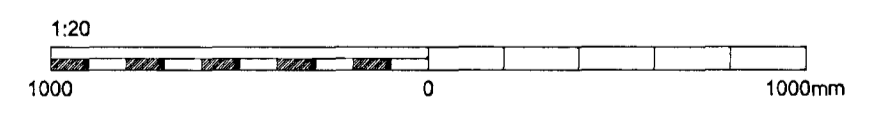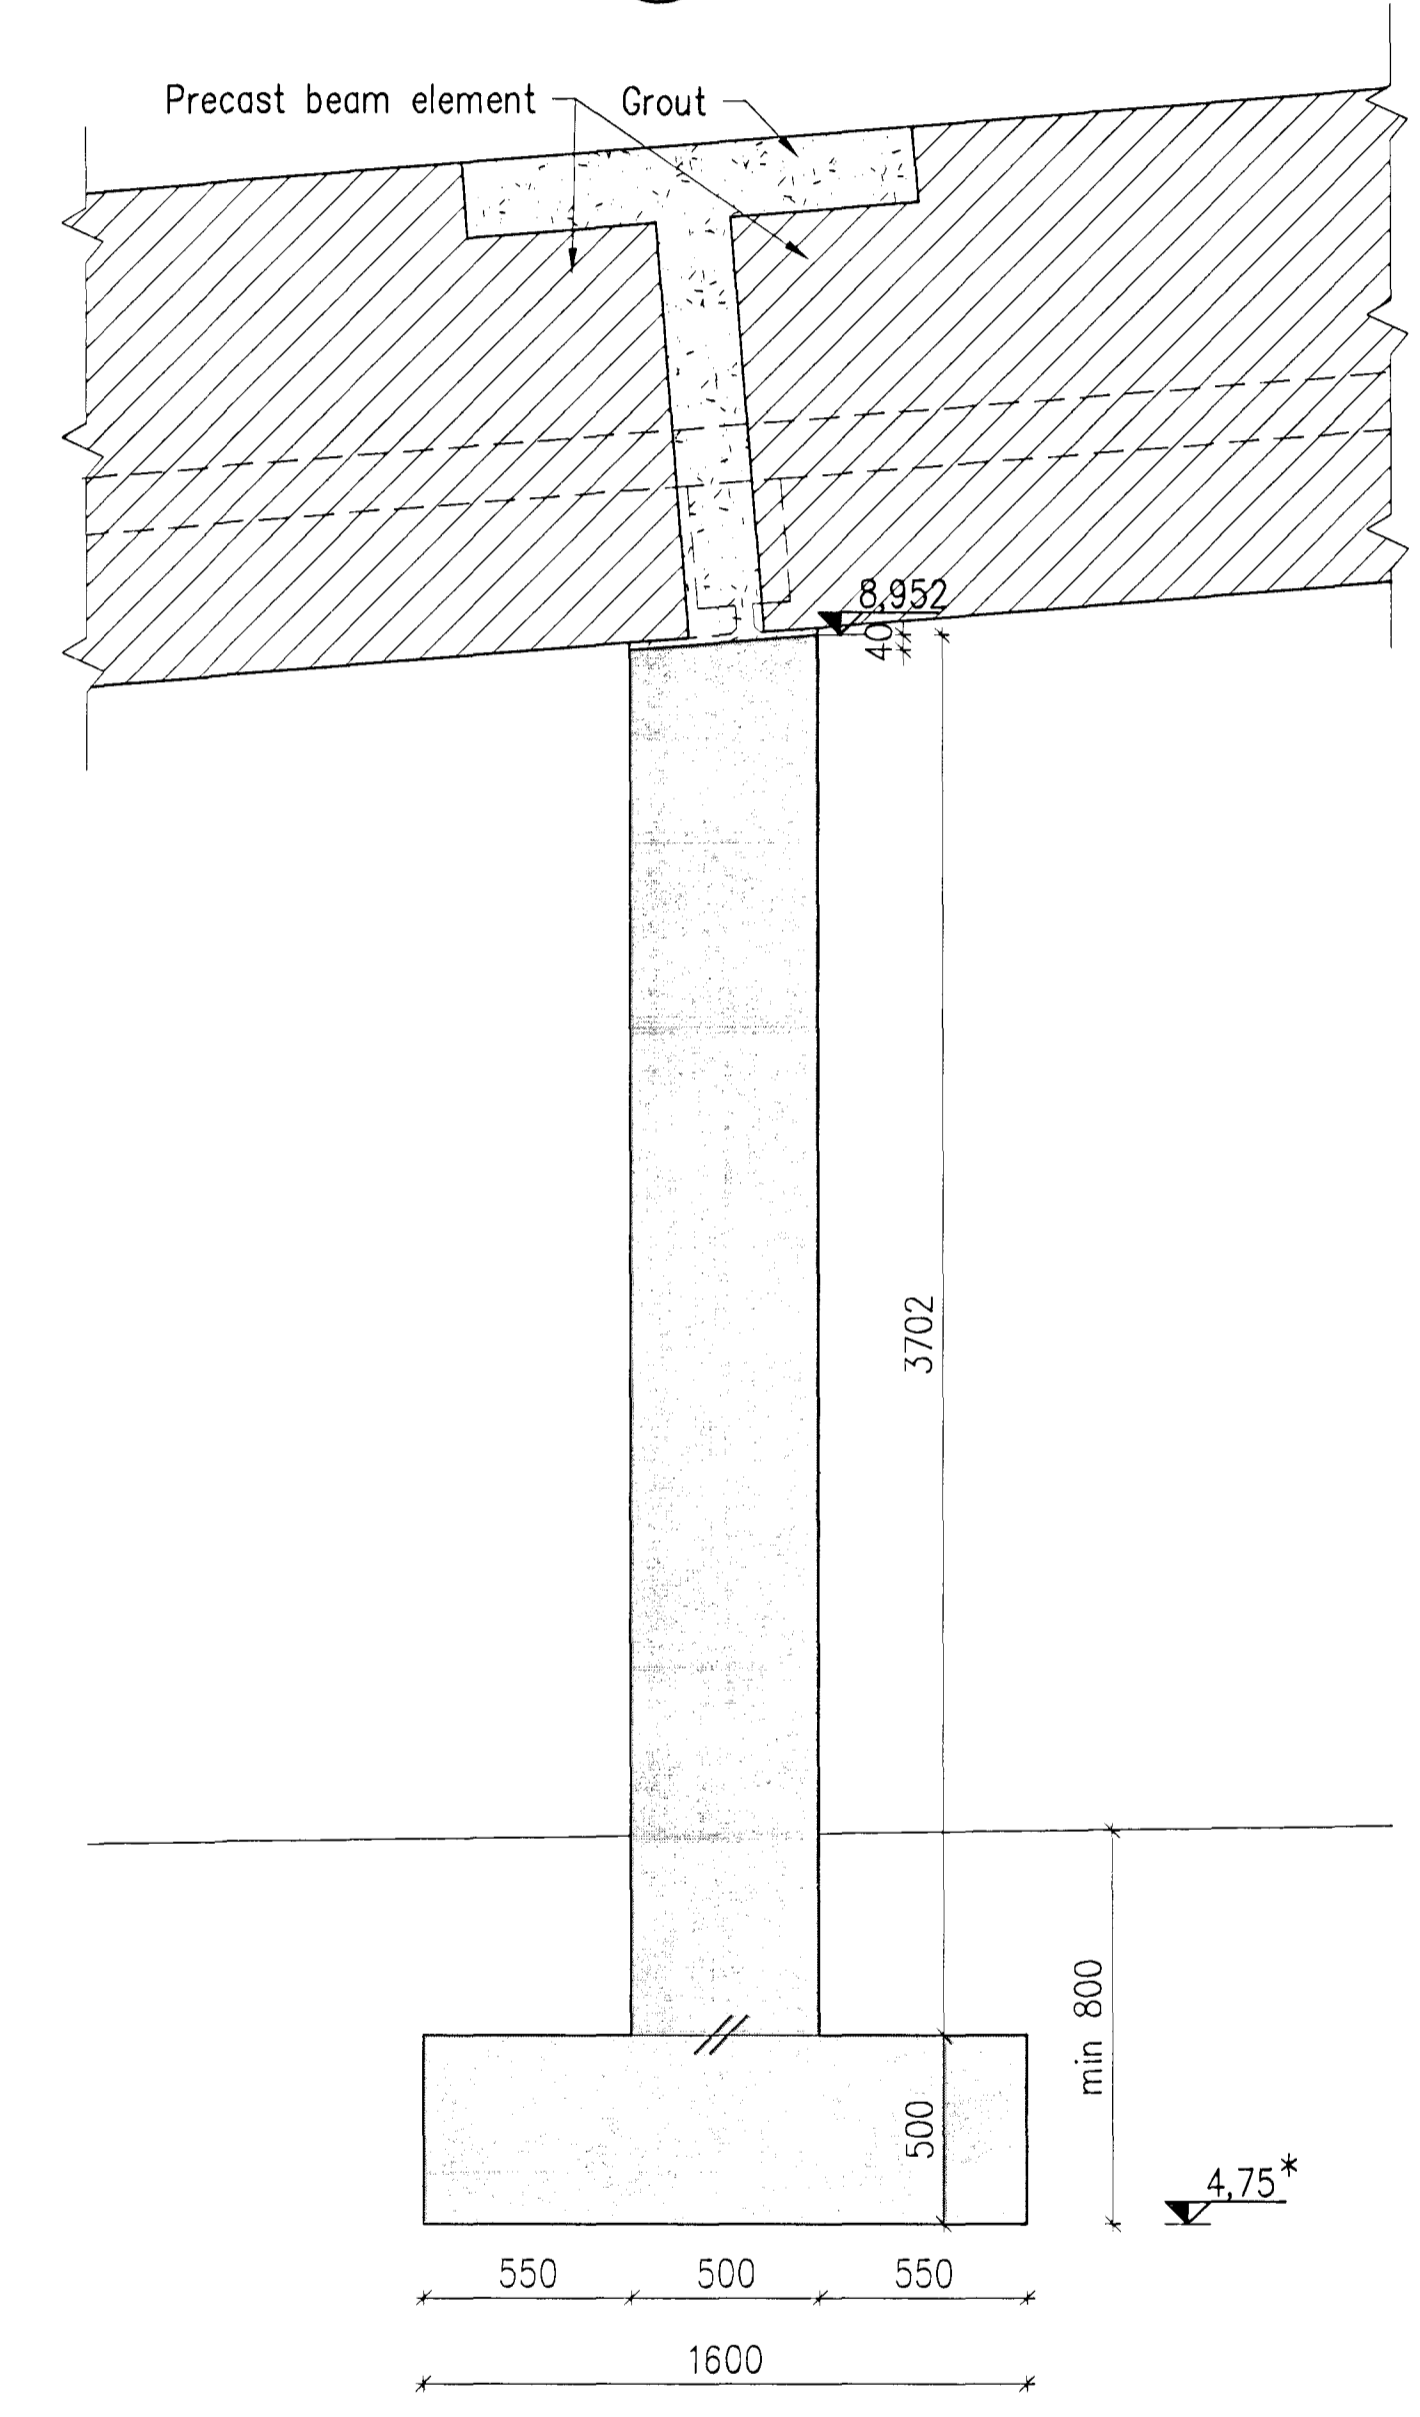

Skýringar: Legend:
 GENERAL NOTES see drawing ICC-611-CA-541-600
 CONCRETE: C30/37:XF3-38
 * Elevation of foundations on rock may differ (min. 800 from finished surface)
 Precast elements are shown on contractors drawings

C:\DP\04\IPU\039 As-built EPCM\600\ICC-611-CA-541-606-6.dwg

6	Record Drawing	2012.07.23	GMG	NI	FG	MS
Qig nr	Lýsing	Dagsetning	Höfu/Run	Yfir	Notk heim	Notk heim
Rev no	Description	Date	Des/Drw	Chk	Suppl Rel	ISAL Rel

This drawing is the property of Rio Tinto Alcan Iceland Ltd. It may neither be copied nor made available to others without permission of Rio Tinto Alcan Iceland Ltd. The receiver is liable for any misuse.
 Start: A1 Mkv: 1:20
 Format: Scale: 1:20
 Dimensions without tolerances according to ISO 2768-1 medium.

Dagsetning / Date: 2011.04.07		Tækn / Drawn: HS/GMG	
Hannað / Designed: HS/GMG		Tækn / Drawn: GMG	
Verktaki / Supplier: HRV		Teg. teikningar / Dwg. type: FORM WORK	
Tækn.nr.verktaki / Supplier drw.no: ICC-611-CA-541-606		Teg. teikningar / Dwg. type: FORM WORK	
Samþykkt / Approved: NI		Yfir / Chkd: NI	
Húti of: / Part of:			

IPU-CASTHOUSE EXTENSION BUILDINGS, RAMPS		Flokkur nr.:	Blað nr.:	Nasta bl. nr.:
RAMP 1		5010	16957	
FOUNDATIONS F4 AND F5		Kostn.nr.-Cora. / Blun.nr.-Eqno		
		5010		
Teg. teikningar / Dwg. type: FORM WORK		AKS		
		UF002		
RioTinto Alcan		Tækn.nr. ISAL / Drw.no. of ISAL	Breyt./Rev.	
		253519	A	
		ISAL Yfirland og skráð. dags / ISAL Checked, date		
		ISAL Samþykkt, dags / ISAL Approval, date		