




Níli Indriðason
 Kt. 181144-3949
 NI

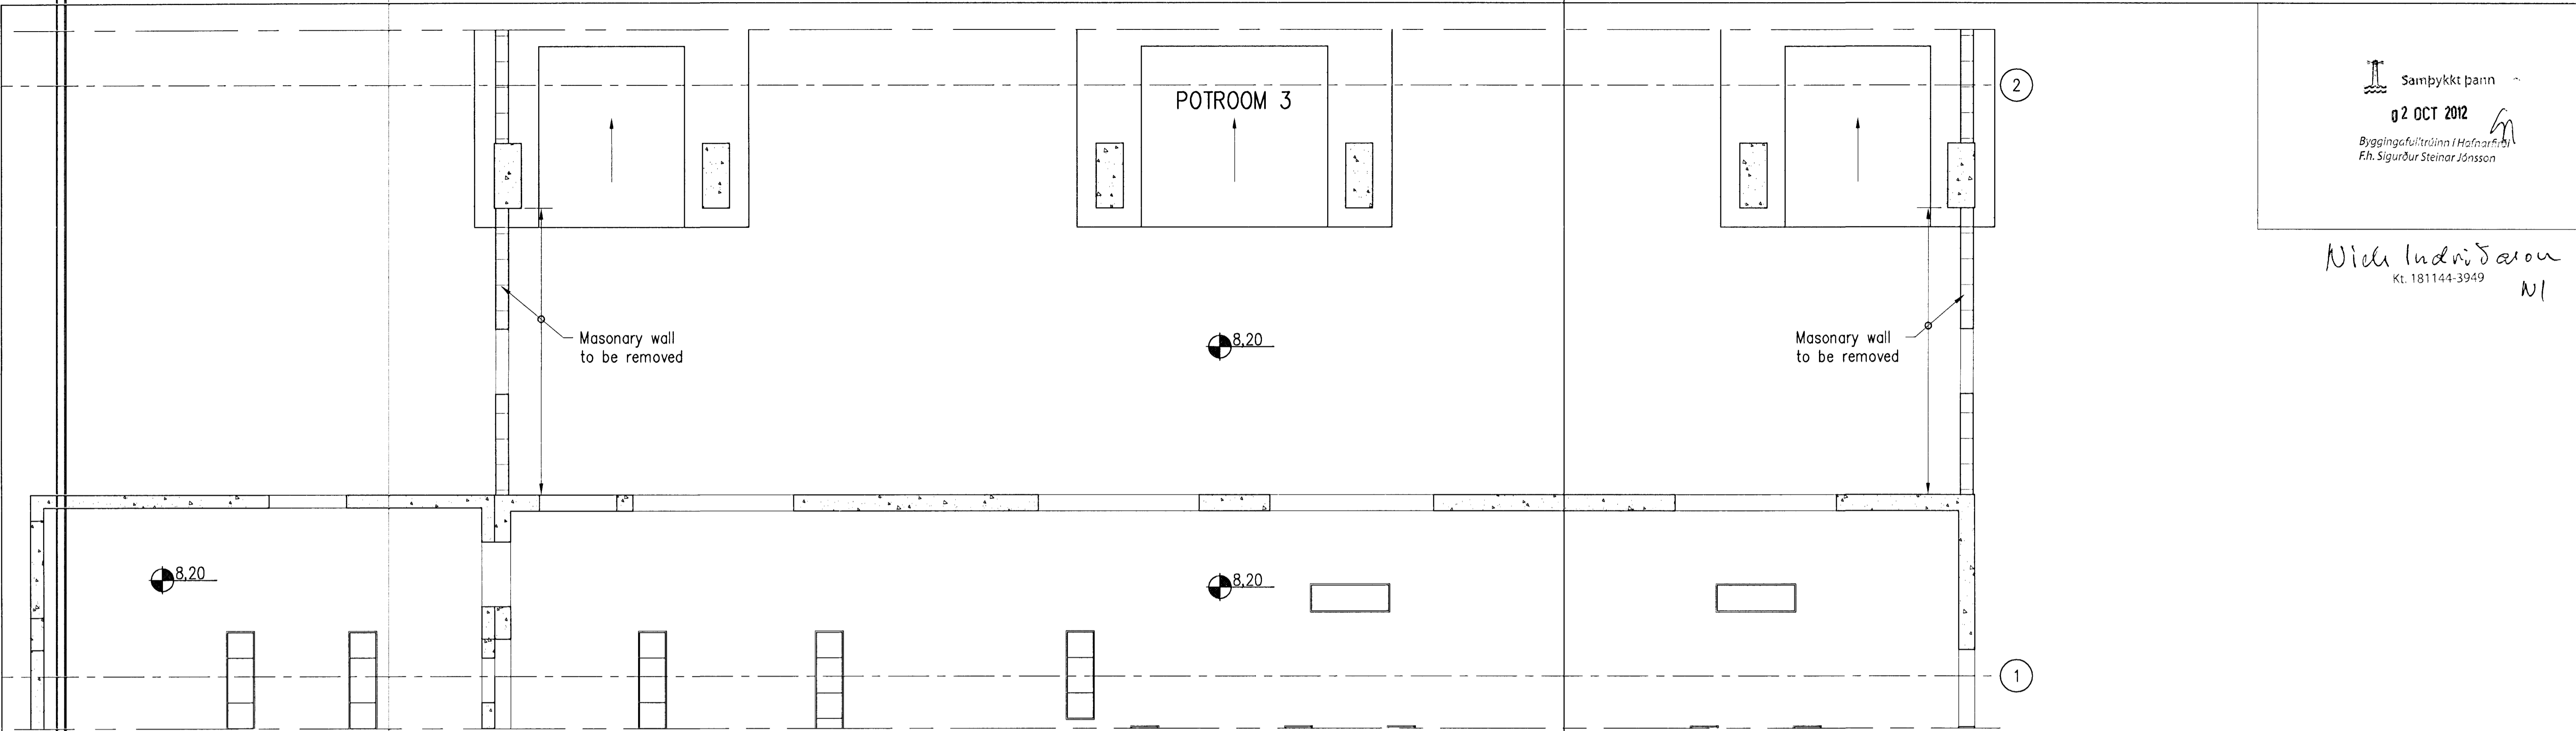

EXISTING PLAN VIEW 1:50

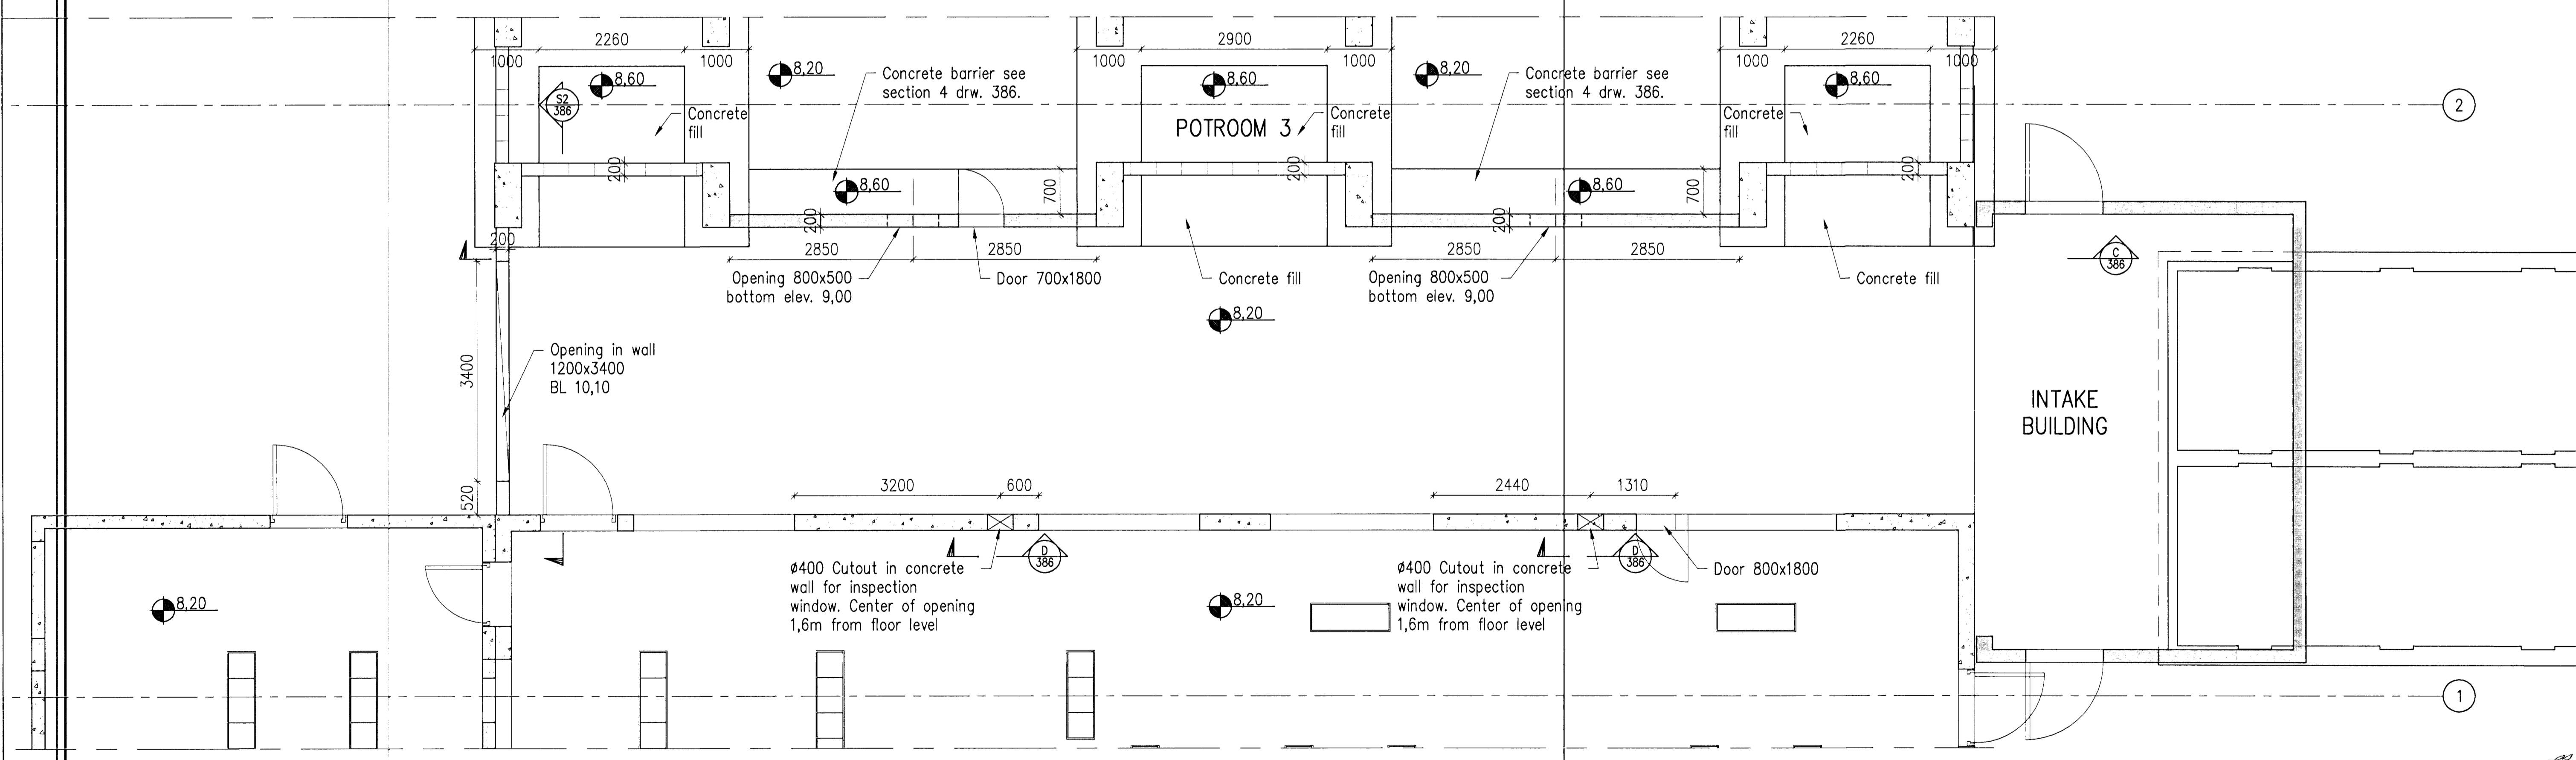

NEW PLAN VIEW 1:50

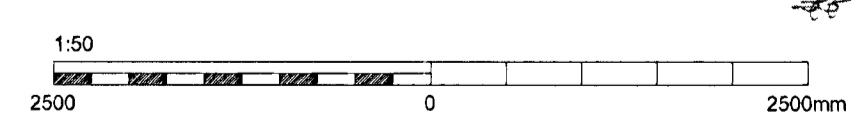

Skýringar / Legend
 Concrete cover 30 mm.
 Concrete: C30/37.
 Reinforcement: B500C.
 NB: No equipment shown on this drawing.

6	Record drawing	2012.09.13	GMG	NI	SKJ	VER	
Útg nr	Lýsing	Dagsetning	Höf/Út	Yfir	Nálg heim	Nálg heim	ISAL Ref
Rev no	Description	Date	Des/Drw	Old	Suppl	Rel	ISAL Ref

This drawing is the property of Rio Tinto Alcan Iceland Ltd. and handed out for personal use only. It may neither be copied nor made available to others without permission of Rio Tinto Alcan Iceland Ltd. The receiver is liable for any misuse.

Format: A1
 Scale: 1:50
 Dimensions without tolerances according to ISO 2768-1 medium.

HRV HATCH
 JOINT VENTURE
 IDEAL PRODUCTION UPGRADE

Dagsetning / Date: 2011.07.14
 Höfnað / Designed: SE
 Tækn / Drawn: LDB
 Verktaki / Supplier: HRV
 Tækn nr verktaka / Supplier drw no: IDP-410-CA-109-385
 Samþykkt / Approved: NI
 Hluti af / Part of: NI

IPU 410-RECTIFIER BUILDINGS-POTROOM 3
 COLLECTOR BUSBAR ROOMS & INTAKE BUILDING
 LAYOUT

Flokkur nr.:
 Blað nr.:
 Nasta blinnr.:
 Kostn.nr.-Ceno. / Blá nr.-Eq.no:
 4011 13983
 Teg. teikningar / Dwg. type:
 FORM WORK
 AKS
 UB13

RioTintoAlcan
 Alcan Iceland Ltd
 Straumavík
 IS-222 Hafnarfjörður
 Ísland

Tækn.nr. ISAL / Drw.no. of ISAL: 251324
 Breyt./Rev.: A

ISAL Vörð og skráð, dags / ISAL Checked, date
 ISAL Samþykkt, dags / ISAL Approval, date