



Níels Indriðason  
 Kr. 181144-3949 NI

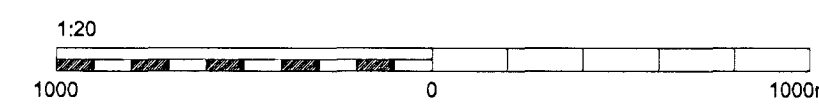

Skýringar:  
 Legend: Concrete: C30/37:XF3-32  
 Precast elements are shown on  
 drw. IDP-410-CA-015-388

Ólg. nr. Rev. no.	Lýsing Description	Dagsetning Date	Hönn./Tín. Des./Drw.	Yfir Ckd.	Notk. heim. Suppl. Rel.	Notk. heim. ISAL Ref.
12	Record drawing	2012.09.12	GMG	NI	NA	revis

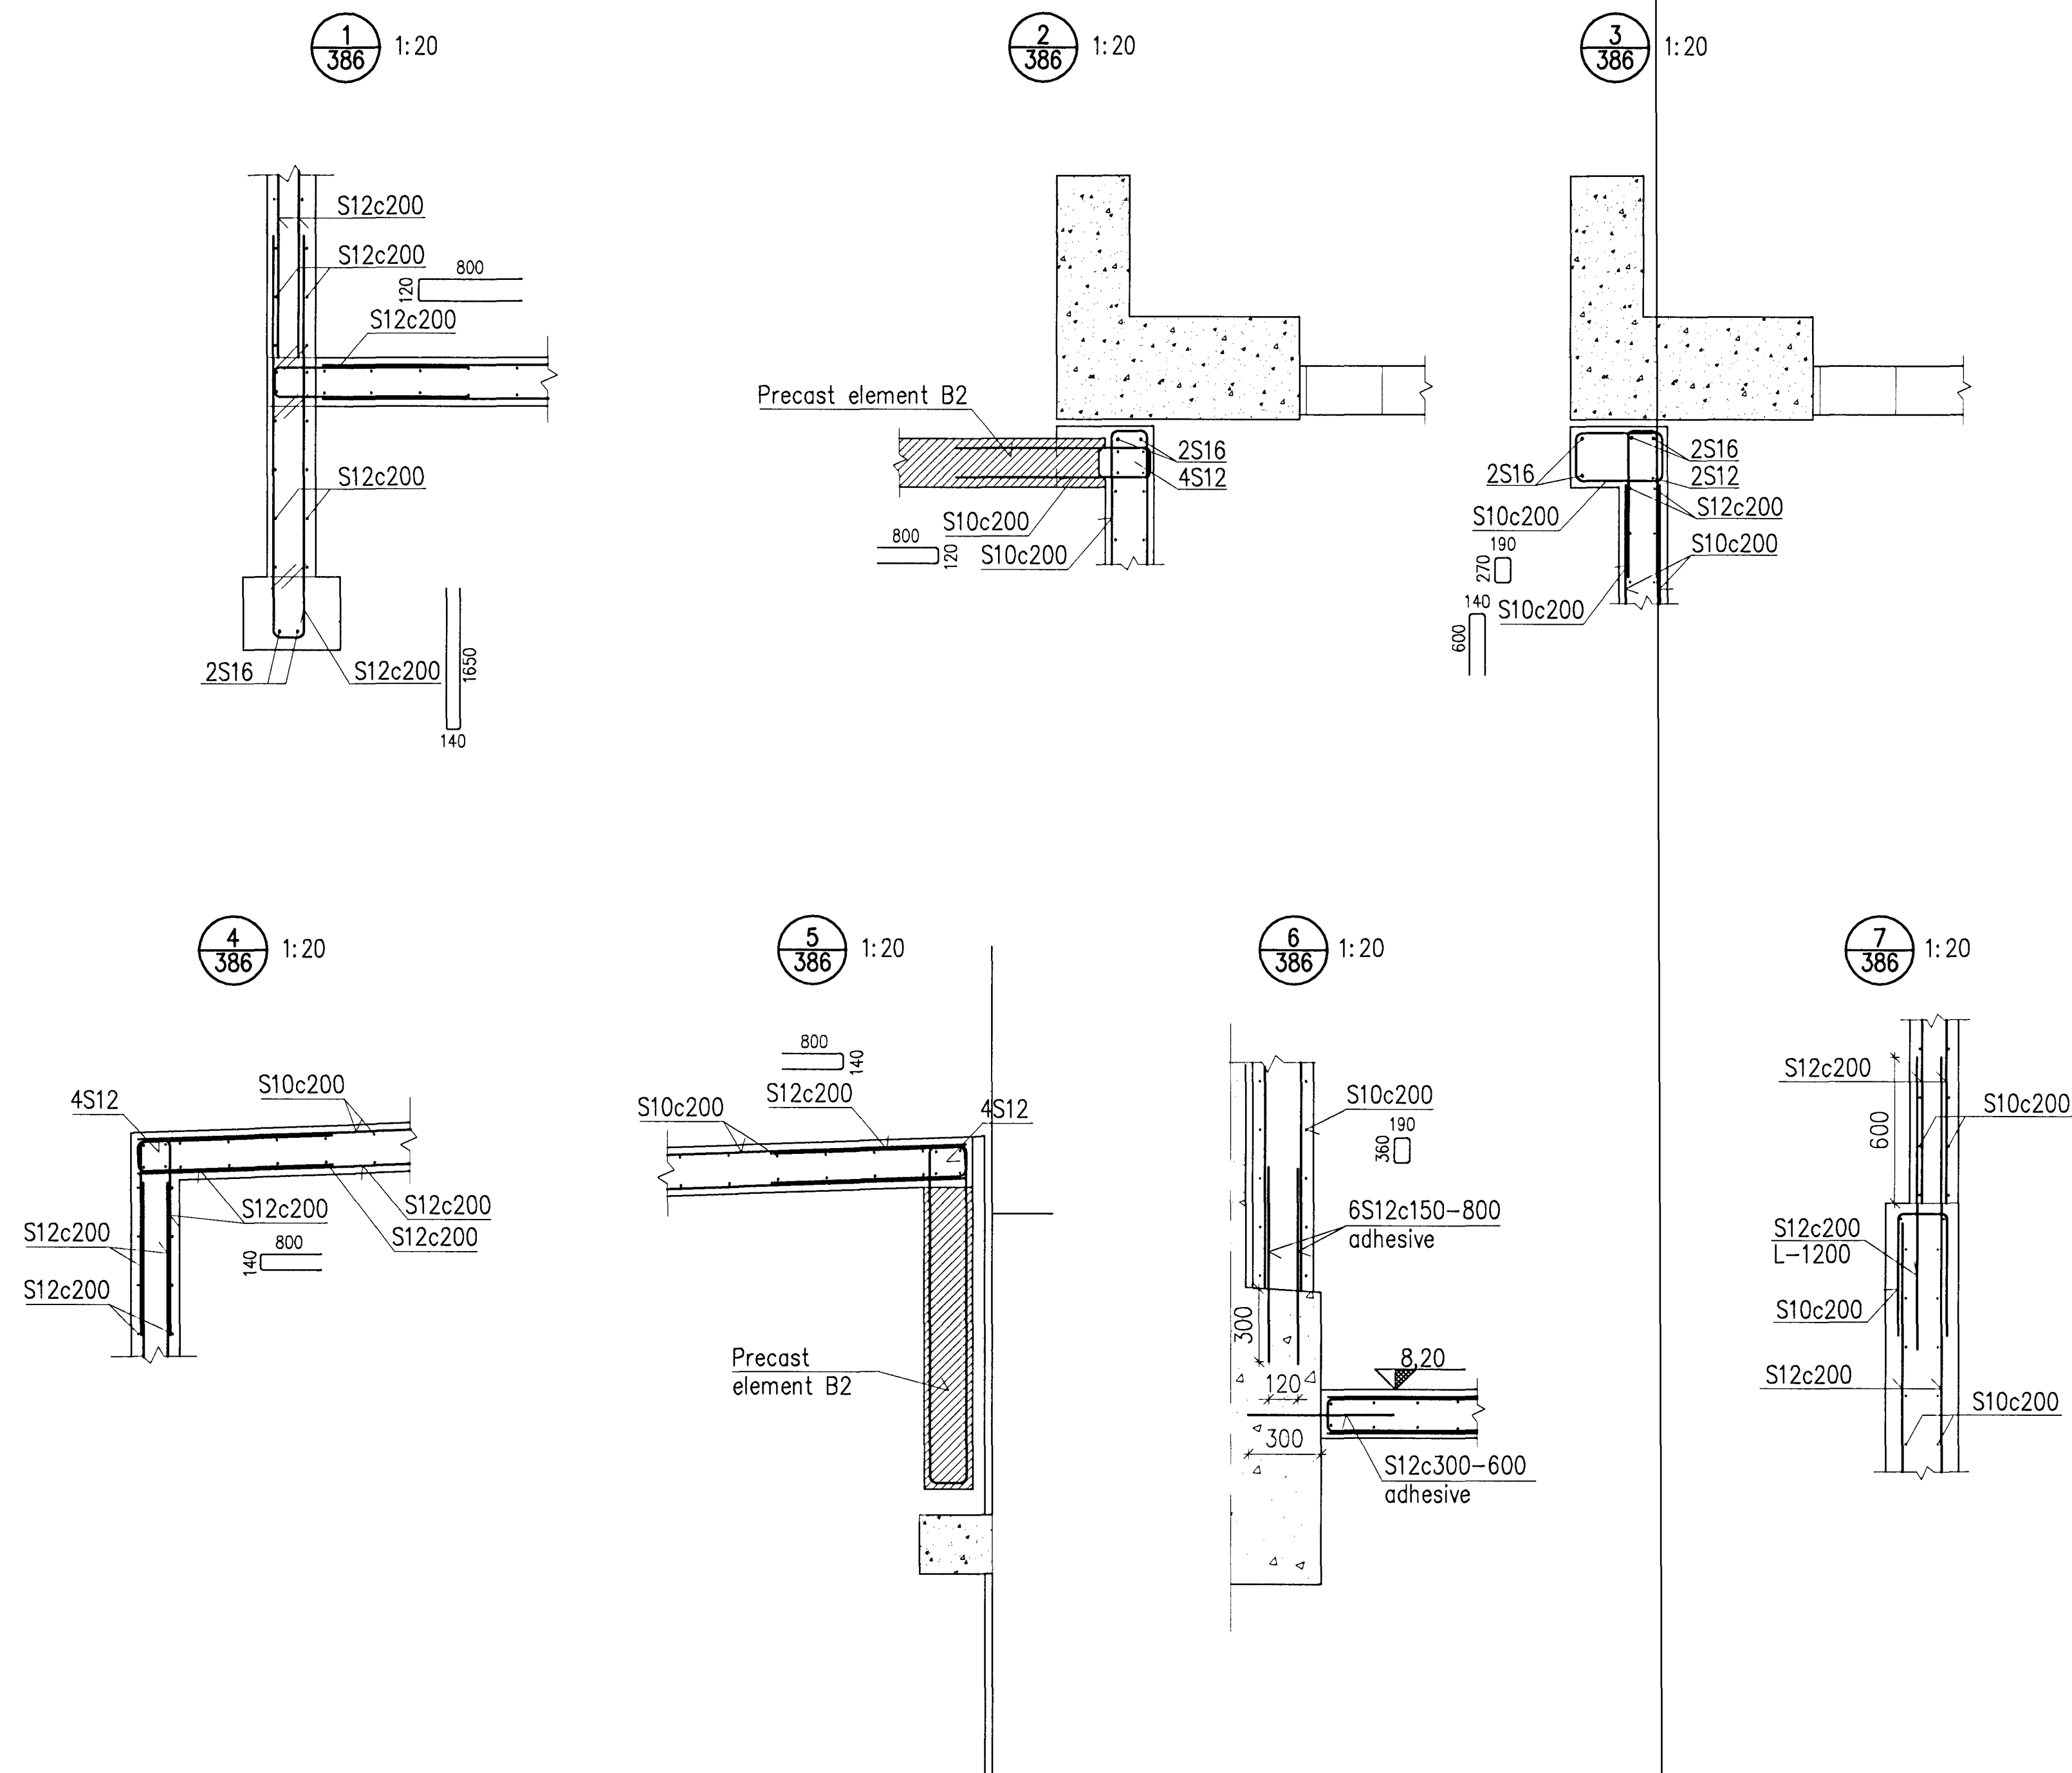

This drawing is the property of Rio Tinto Alcan Iceland Ltd. and handed out for personal use only. It may neither be copied nor made available to others without permission of Rio Tinto Alcan Iceland Ltd. The receiver is liable for any misuse.

Scale: 1:20  
 Dimensions without tolerances according to ISO 2768-1 medium

Dagsetning / Date	2011.02.21
Hönnað / Designed	GMG
Teikn / Drawn	GMG
Verktaki / Supplier	HRV
Teikn.nr. verktaka / Supplier drw.no.	IDP-410-CA-015-387
Samþykkt / Approved	NI
Yfir / Chkd	NI
Hluti af / Part of:	

IPU 410 - RECTIFIER BUILDINGS INTAKE BUILDING PL 3 SECTIONS		Flokkur nr.:	Blöð nr.:	Næsta bl. nr.:
		Kostn. nr. - Cono. / Blm. nr. - Eq. no.	4011	13983
Tag teikningar / Dwg. type:		REINFORCEMENT		
ISAL		Tekn. nr. ISAL / Drw. no. of ISAL	Breyt. / Rev.	
RioTintoAlcan		251305	A	
ISAL Yfirfarð og skrúð, dags / ISAL Checked, date		ISAL Samþykkt, dags / ISAL Approved, date		