




Nick Indriðason
Kt. 181144-3949
NI

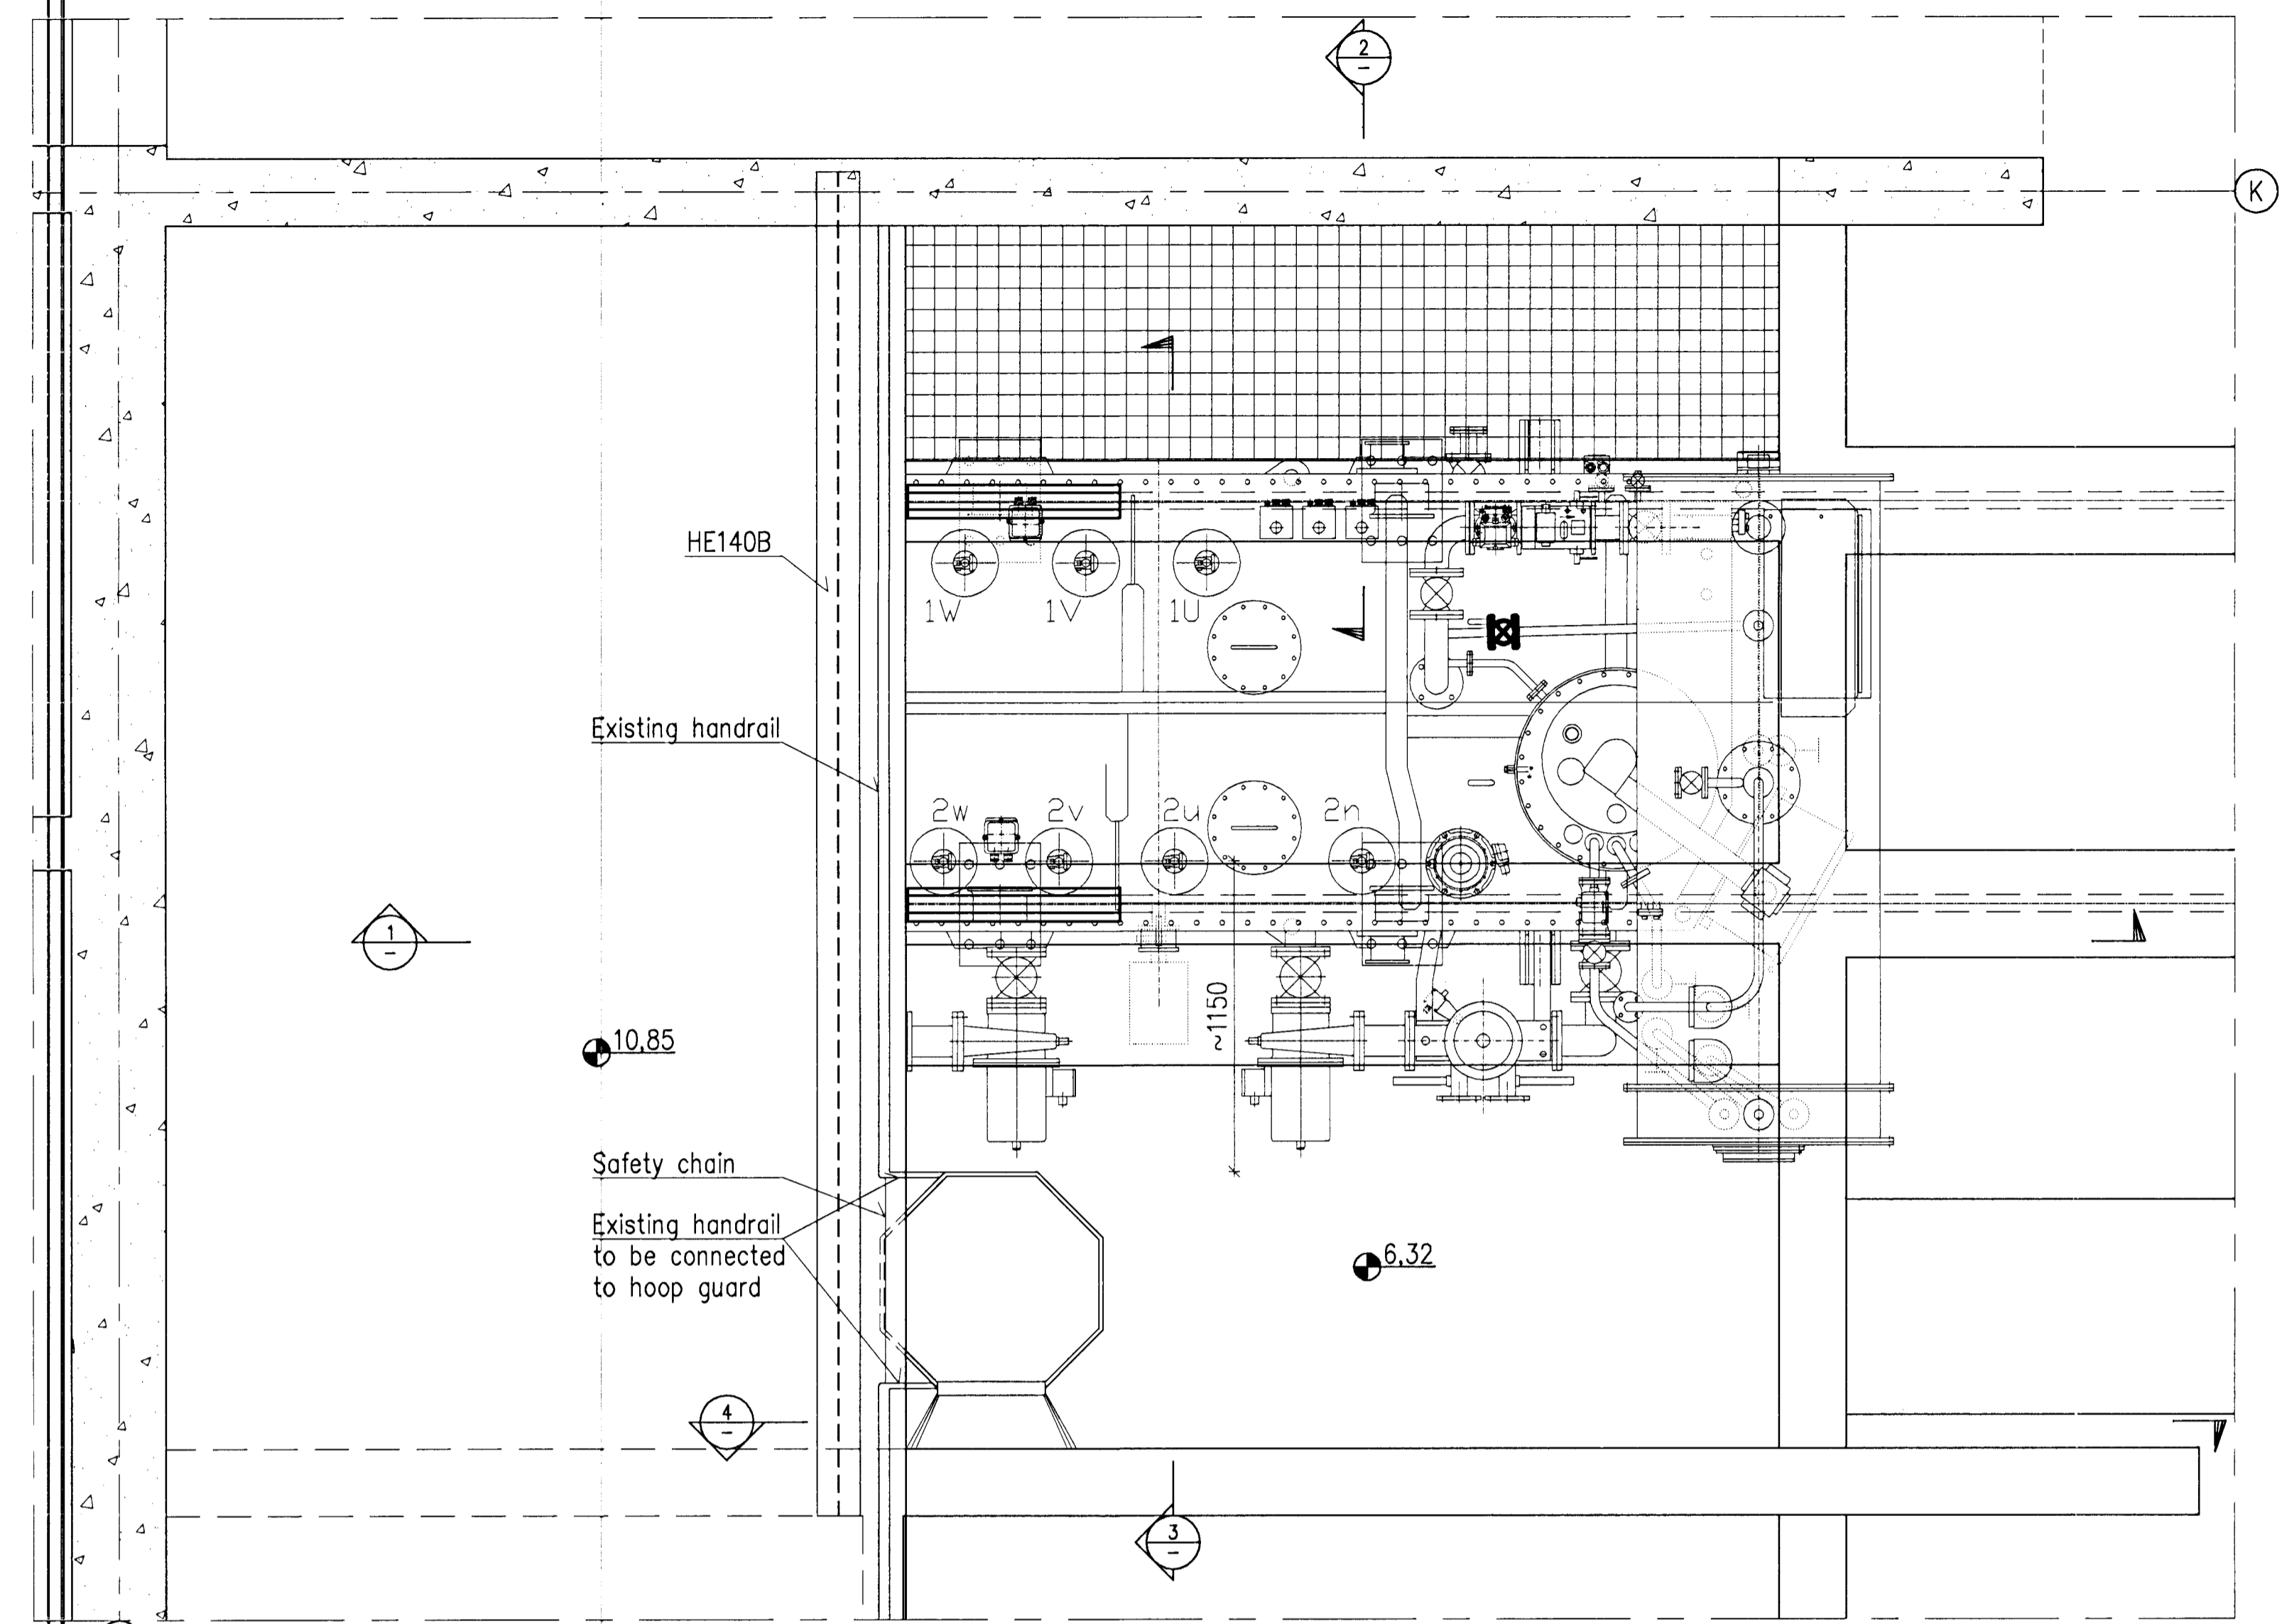


BAY AREA, PLAN VIEW, 1:20
with 30 MVA ABB transformer

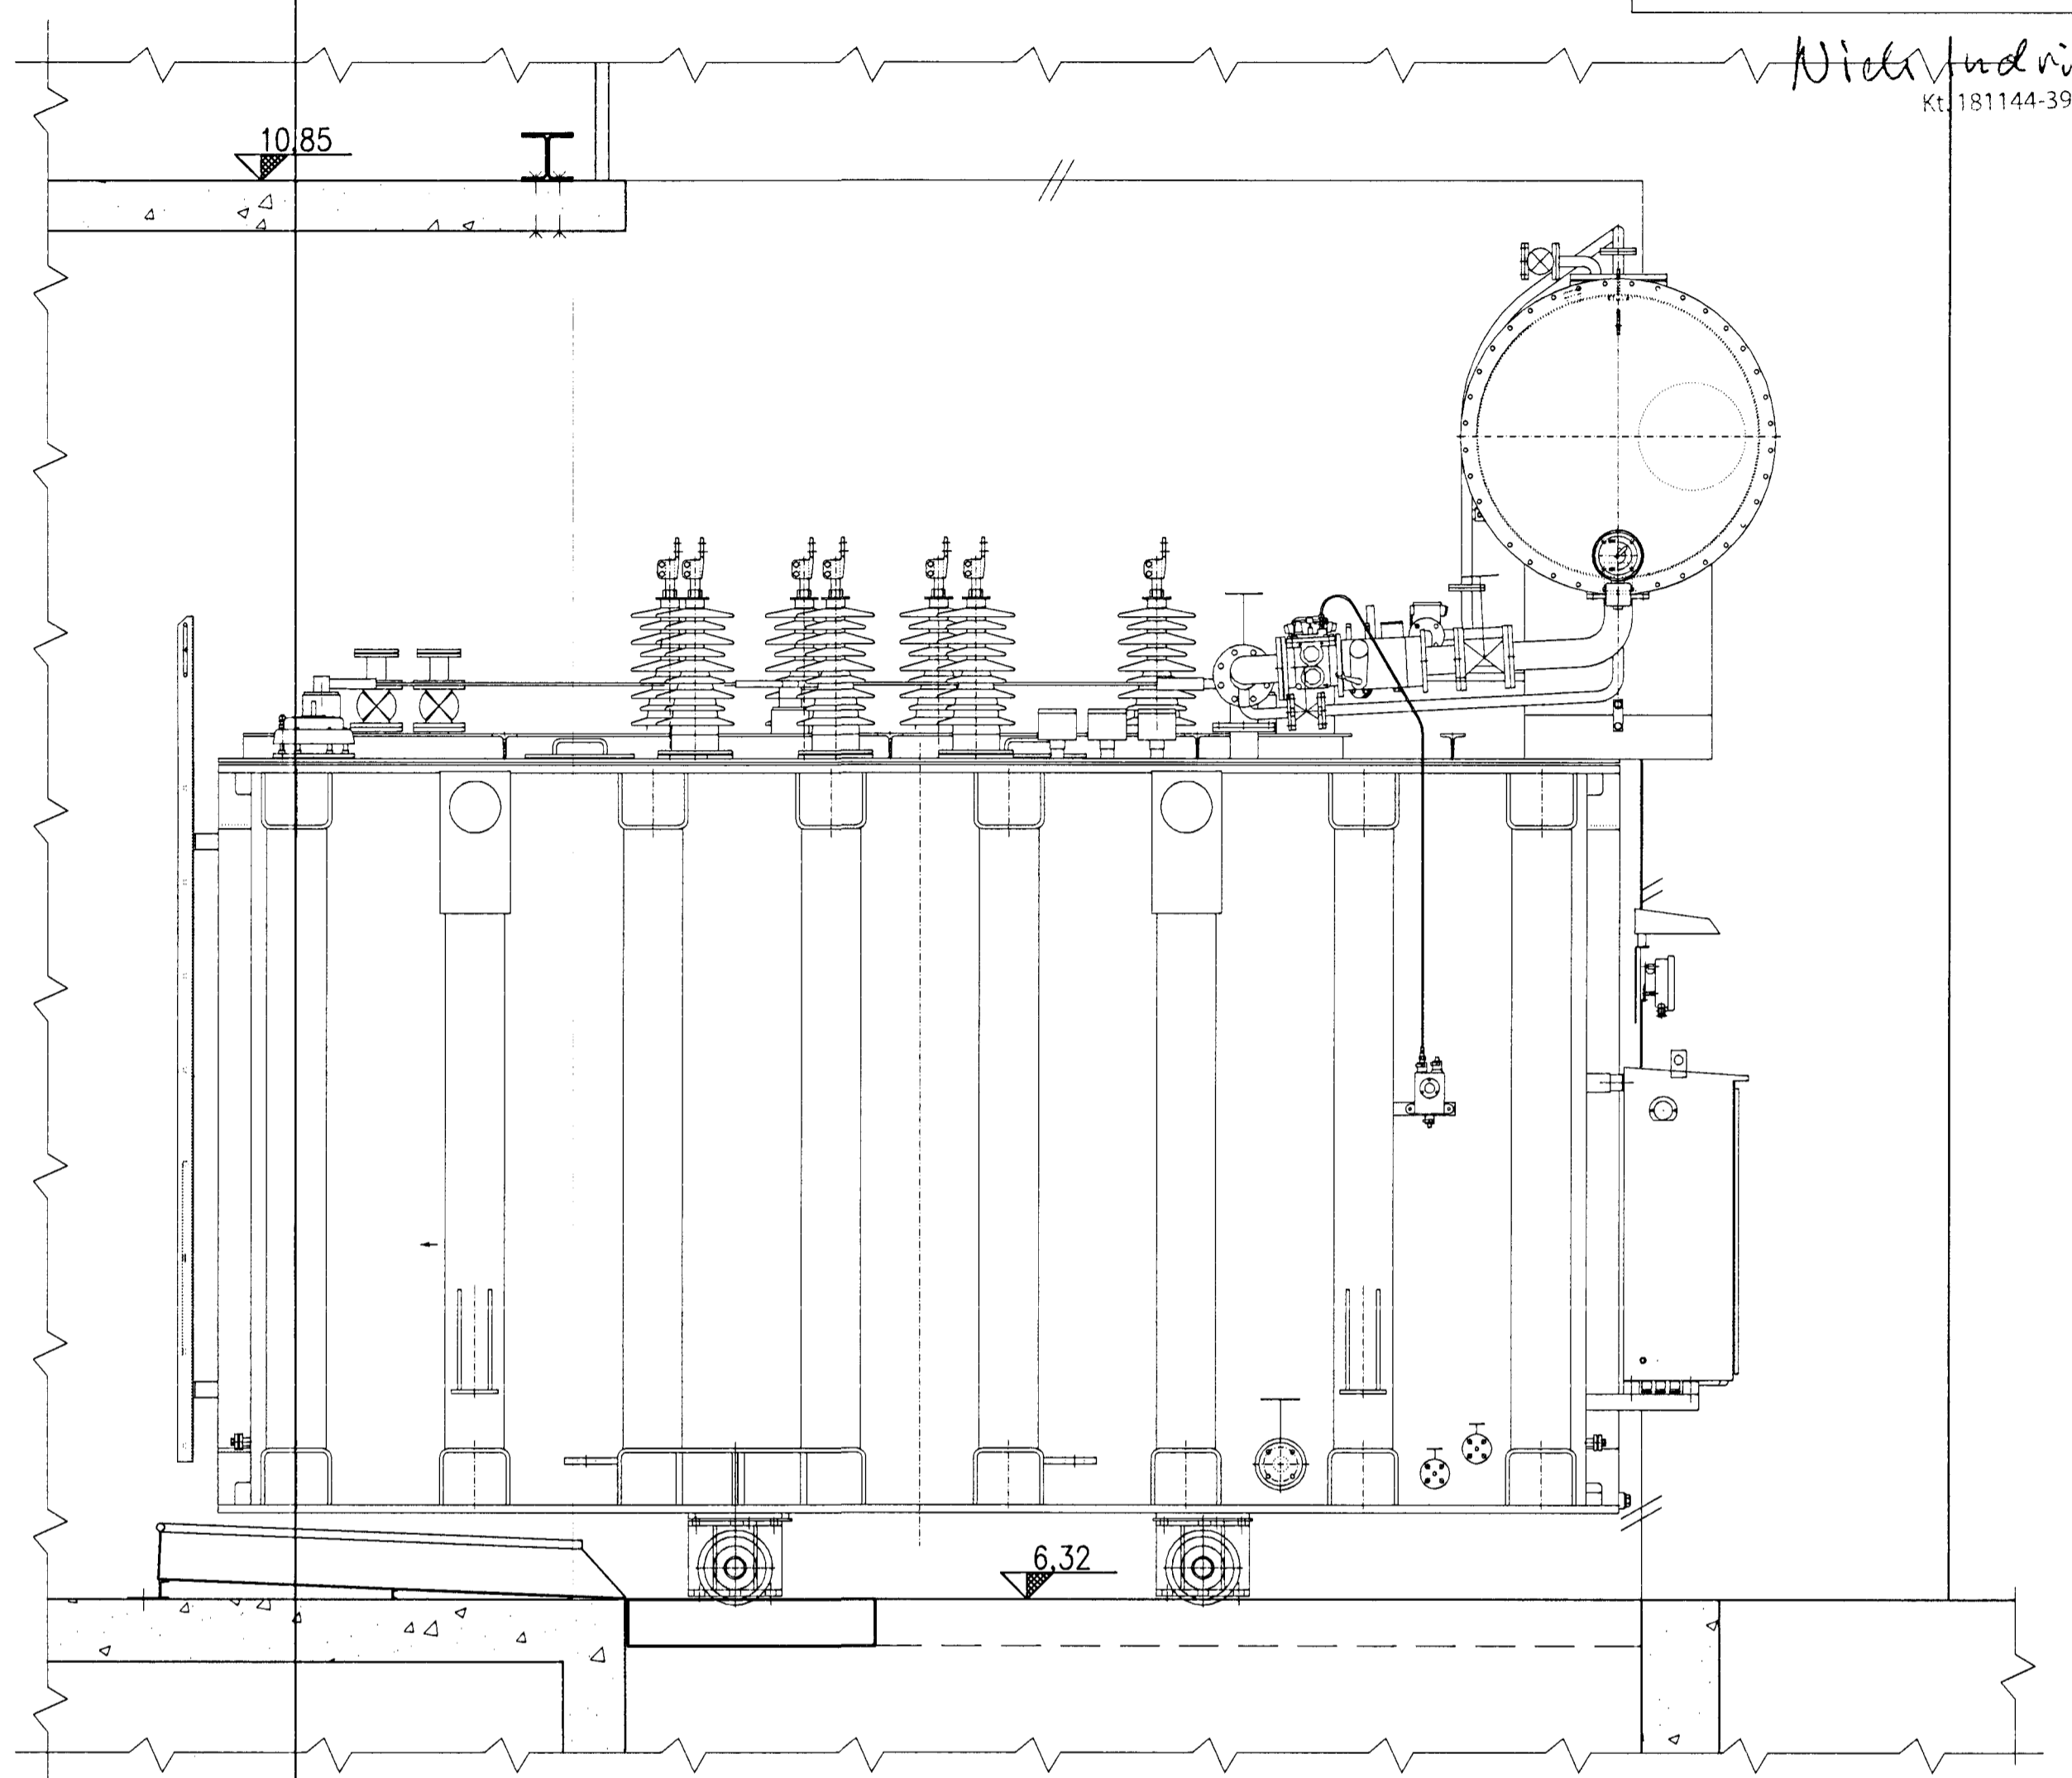

1 SECTION, 1:20

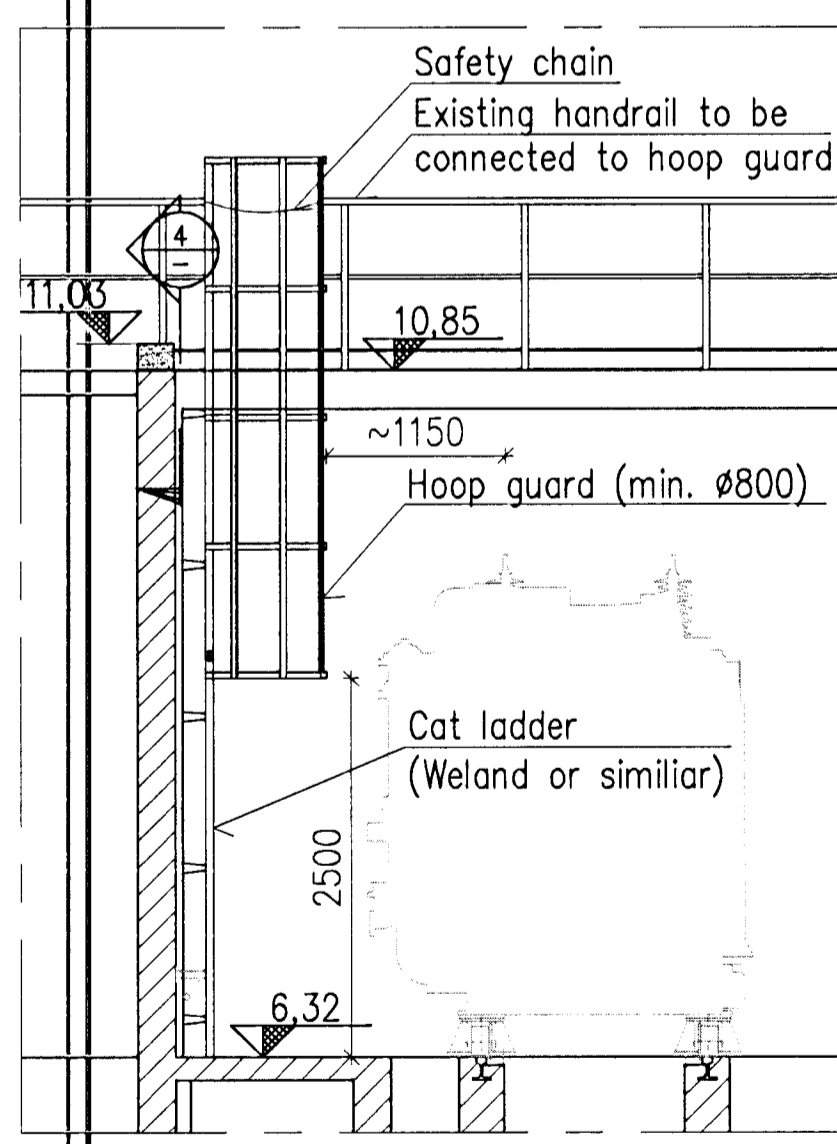


3 SECTION, 1:50

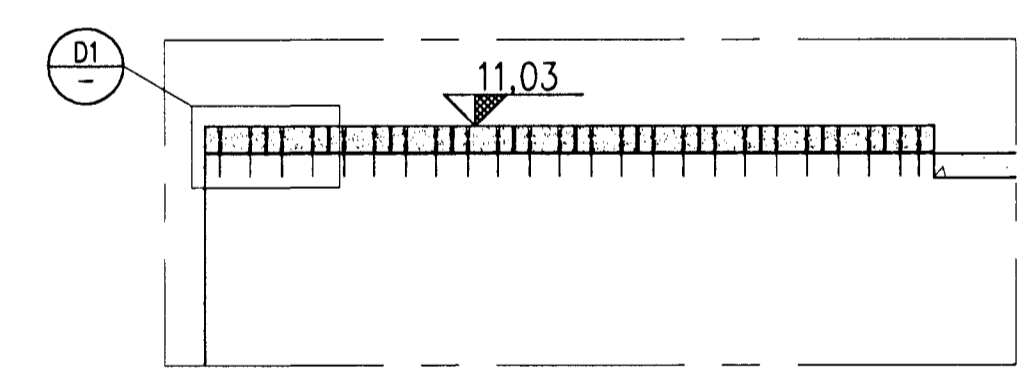


4 SECTION, 1:50

Prefab. stone (BM Valló)
400x240x170 embedded in
mortar with 2S12 anchors.


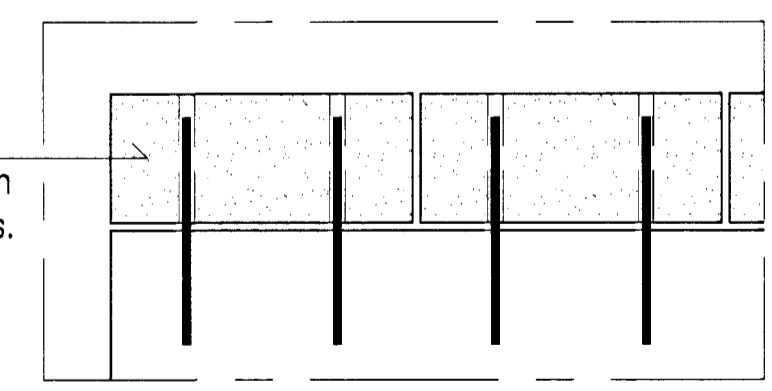


D1 DETAIL, 1:10

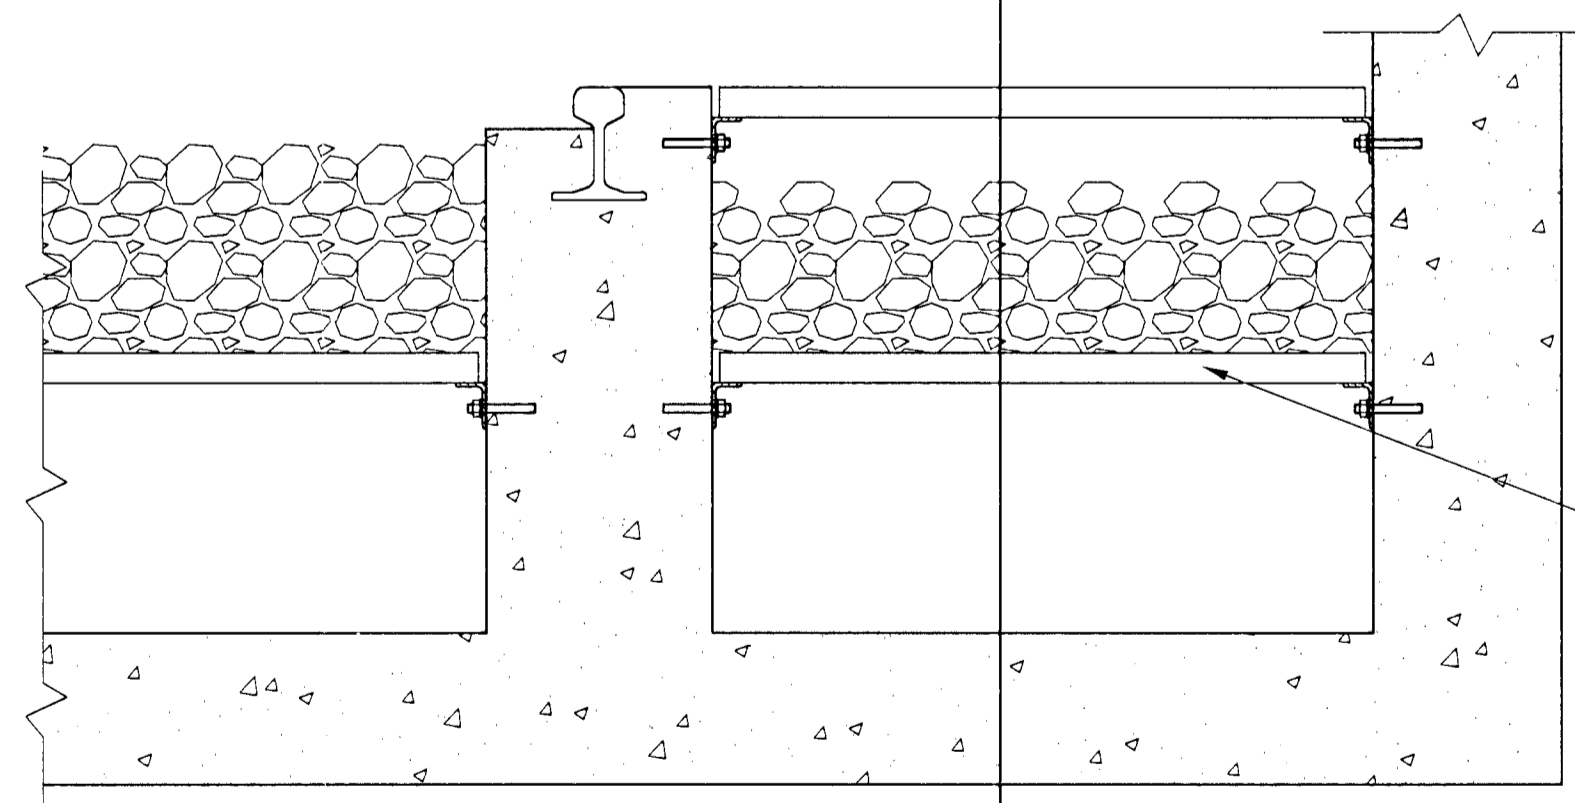

2 SECTION, 1:10

Grating and stone material to be dismantled before demolition and concrete work, and re-instalment after changes have been performed

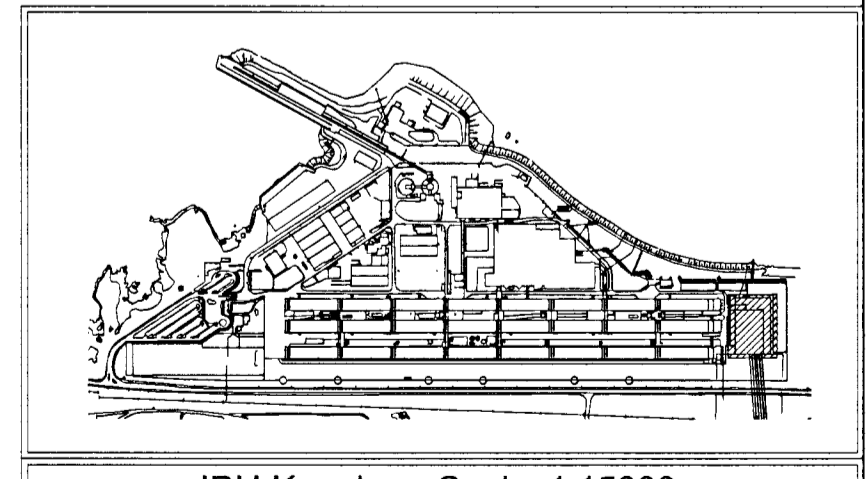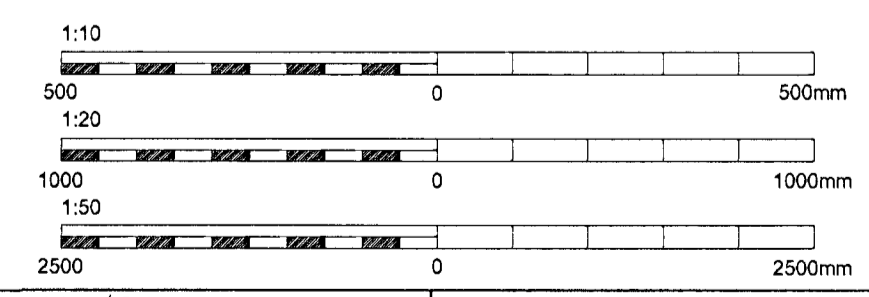

IPU Keyplan - Scale: 1:15000

Skýringar
Legend:
Cat ladder dimensions shall be checked on site

Fig. nr. Rev. no.	Lýsing Description	Dagsetning Date	Höf./Rit. Des./Drw.	Yfir/ Ckd.	Notk. heim. Suppl. Rel.	Notk. heim. ISAL Rel.
5	Record drawing - Separation wall extended to +11.03	2012.09.12	GMG	NI	ÓSig.	MCBW
4	As Built	2012.03.13	SE	NI	ÓSig.	MCBW

This drawing is the property of Rio Tinto Alcan Iceland Ltd. and handed out for personal use only. It may neither be copied nor made available to others without permission of Rio Tinto Alcan Iceland Ltd. The receiver is liable for any misuse.

Scale: 1:10, 20, 50
Dimensions without tolerances according to ISO 2768-1 medium.



Dagsetning / Date	2011.08.08
Samþykkt / Approved	YIP / Chkd NI
HRV	HRV
TEKNIKUR / Supplier	LDB
TEKNIKURVERKJÓFA / Supplier drw.no.	IDP-412-CA-015-003
Hluti af / Part of:	

IPU - 410 MAIN SUBSTATION
BAY FOR 30 MVA TRANSFORMER, 07D12
PLAN VIEW AND SECTION
GENERAL ARRANGEMENT

RioTintoAlcan

Flakur nr. /	Blöð nr. /	Nasta blinn. /
4011	01188	
Kostn.nr.-Gögn. / Bgn.nr.-Egno.	AKS	
UB01		
Tekn.nr. ISAL / Drw.no. of ISAL	Breyt./Rev.	
251330	A	
ISAL Yfirráð og skráð, dags. / ISAL Checked, date	ISAL Samþykkt, dags. / ISAL Approved, date	