


Samþykkt þann
 01 OCT 2012
 Byggingafulltrúinn í Hafnarfirði
 F.h. Sigurður Steinar Jónsson

Níki Indriðason
 Kt. 181144-3949

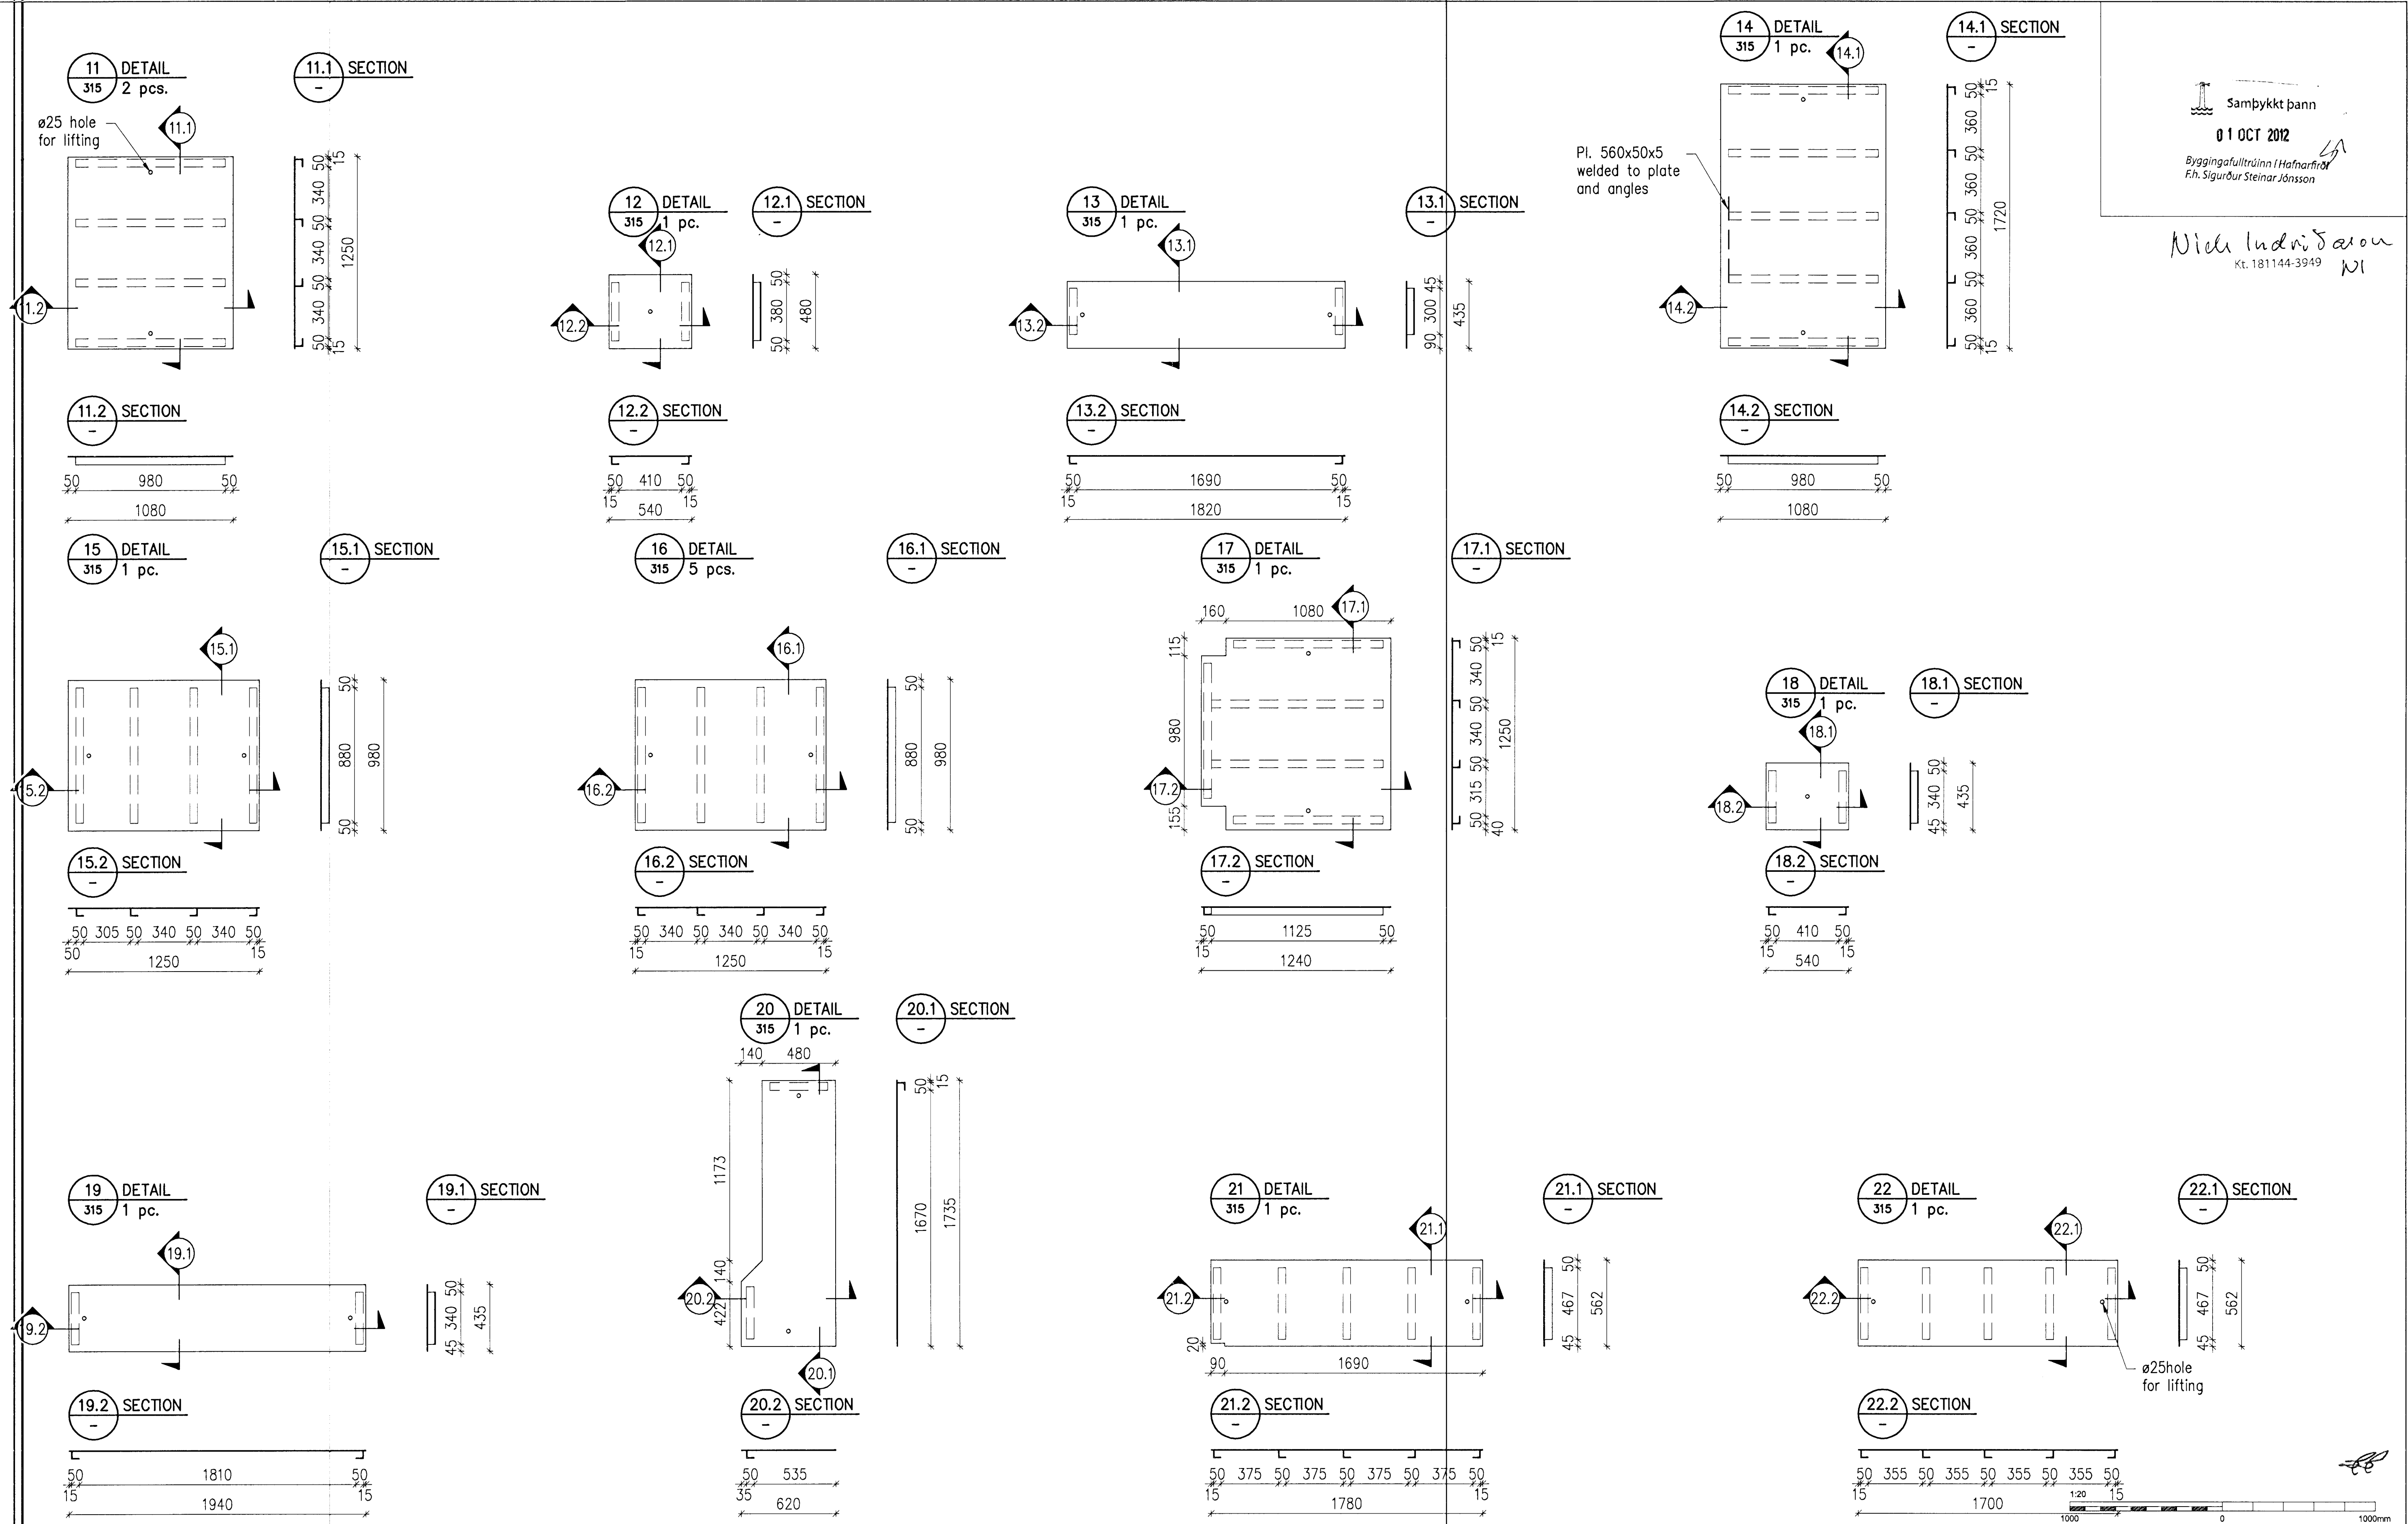

Skýringar
 Legend:
 Plates are aluminium chequered plates 5/7.
 Angles are aluminium 50x50x5 welded to plates.
 All dimensions shall be checked on site.

| Sl. nr. Rev no | Lýsing Description | Dagsetning Date | HS Hafn/Des/Drw | Yfir Okt | Notk heim Suppl Rel | Notk heim ISAL Rel |
|-------------------|-----------------------|--------------------|--------------------|-------------|------------------------|-----------------------|
| 2 | Record drawing | 2012.09.12 | HS | NI | EG | MS |

This drawing is the property of Rio Tinto Alcan Iceland Ltd. and may neither be copied nor made available to others without permission of Rio Tinto Alcan Iceland Ltd. The receiver is liable for any misuse.

Scale: 1:20
 Dimensions without tolerances according to ISO 2768-1 medium.

HRV & HATCH
 REAL PRODUCTION UPGRADE

Dagsetning / Date: 2011.09.14
 Hannað / Designed: HS
 Tækn / Drawn: LDB
 Verktöð / Supplier: HRV
 Töskn-ervertkava / Supplier draw no.: IDP-410-ZA-015-318
 Sömbætt / Approved: NI
 Hluti af / Part of: NI

IPU410-RECTIFIER BUILDINGS
 B5/S2
 GRATING AND COVER PLATES, DETAILS AND SECTIONS
 STRUCTURAL STEEL

Flokkur nr.: 4011
 Blað nr.: 13982
 Kostn.nr.-Gögn. / BGNr.-Eg.no: AKS
 Töskn.nr. ISAL / Draw no. of ISAL: UB12
 Breyt./Rev: A

RioTintoAlcan
 Alcan Iceland Ltd
 Straumsvík
 IS-222 Hafnarfjörður
 Ísland

ISAL Yfirráð og skráð. dags / ISAL Checked, date
 ISAL Samþykkt, dags / ISAL Approval, date