
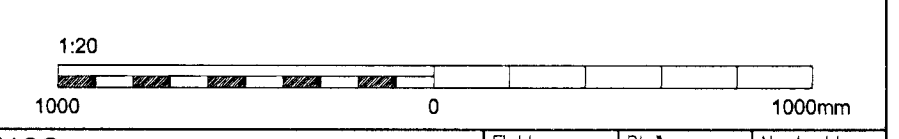


Samþykkt þann
 01 OCT 2012
 Byggingafulltrúinn / Hafnarfirði
 F.h. Sigurður Steinar Jónsson
 37.1 SECTION

Níels Indriðason
 Kt. 181144-3949
 NI

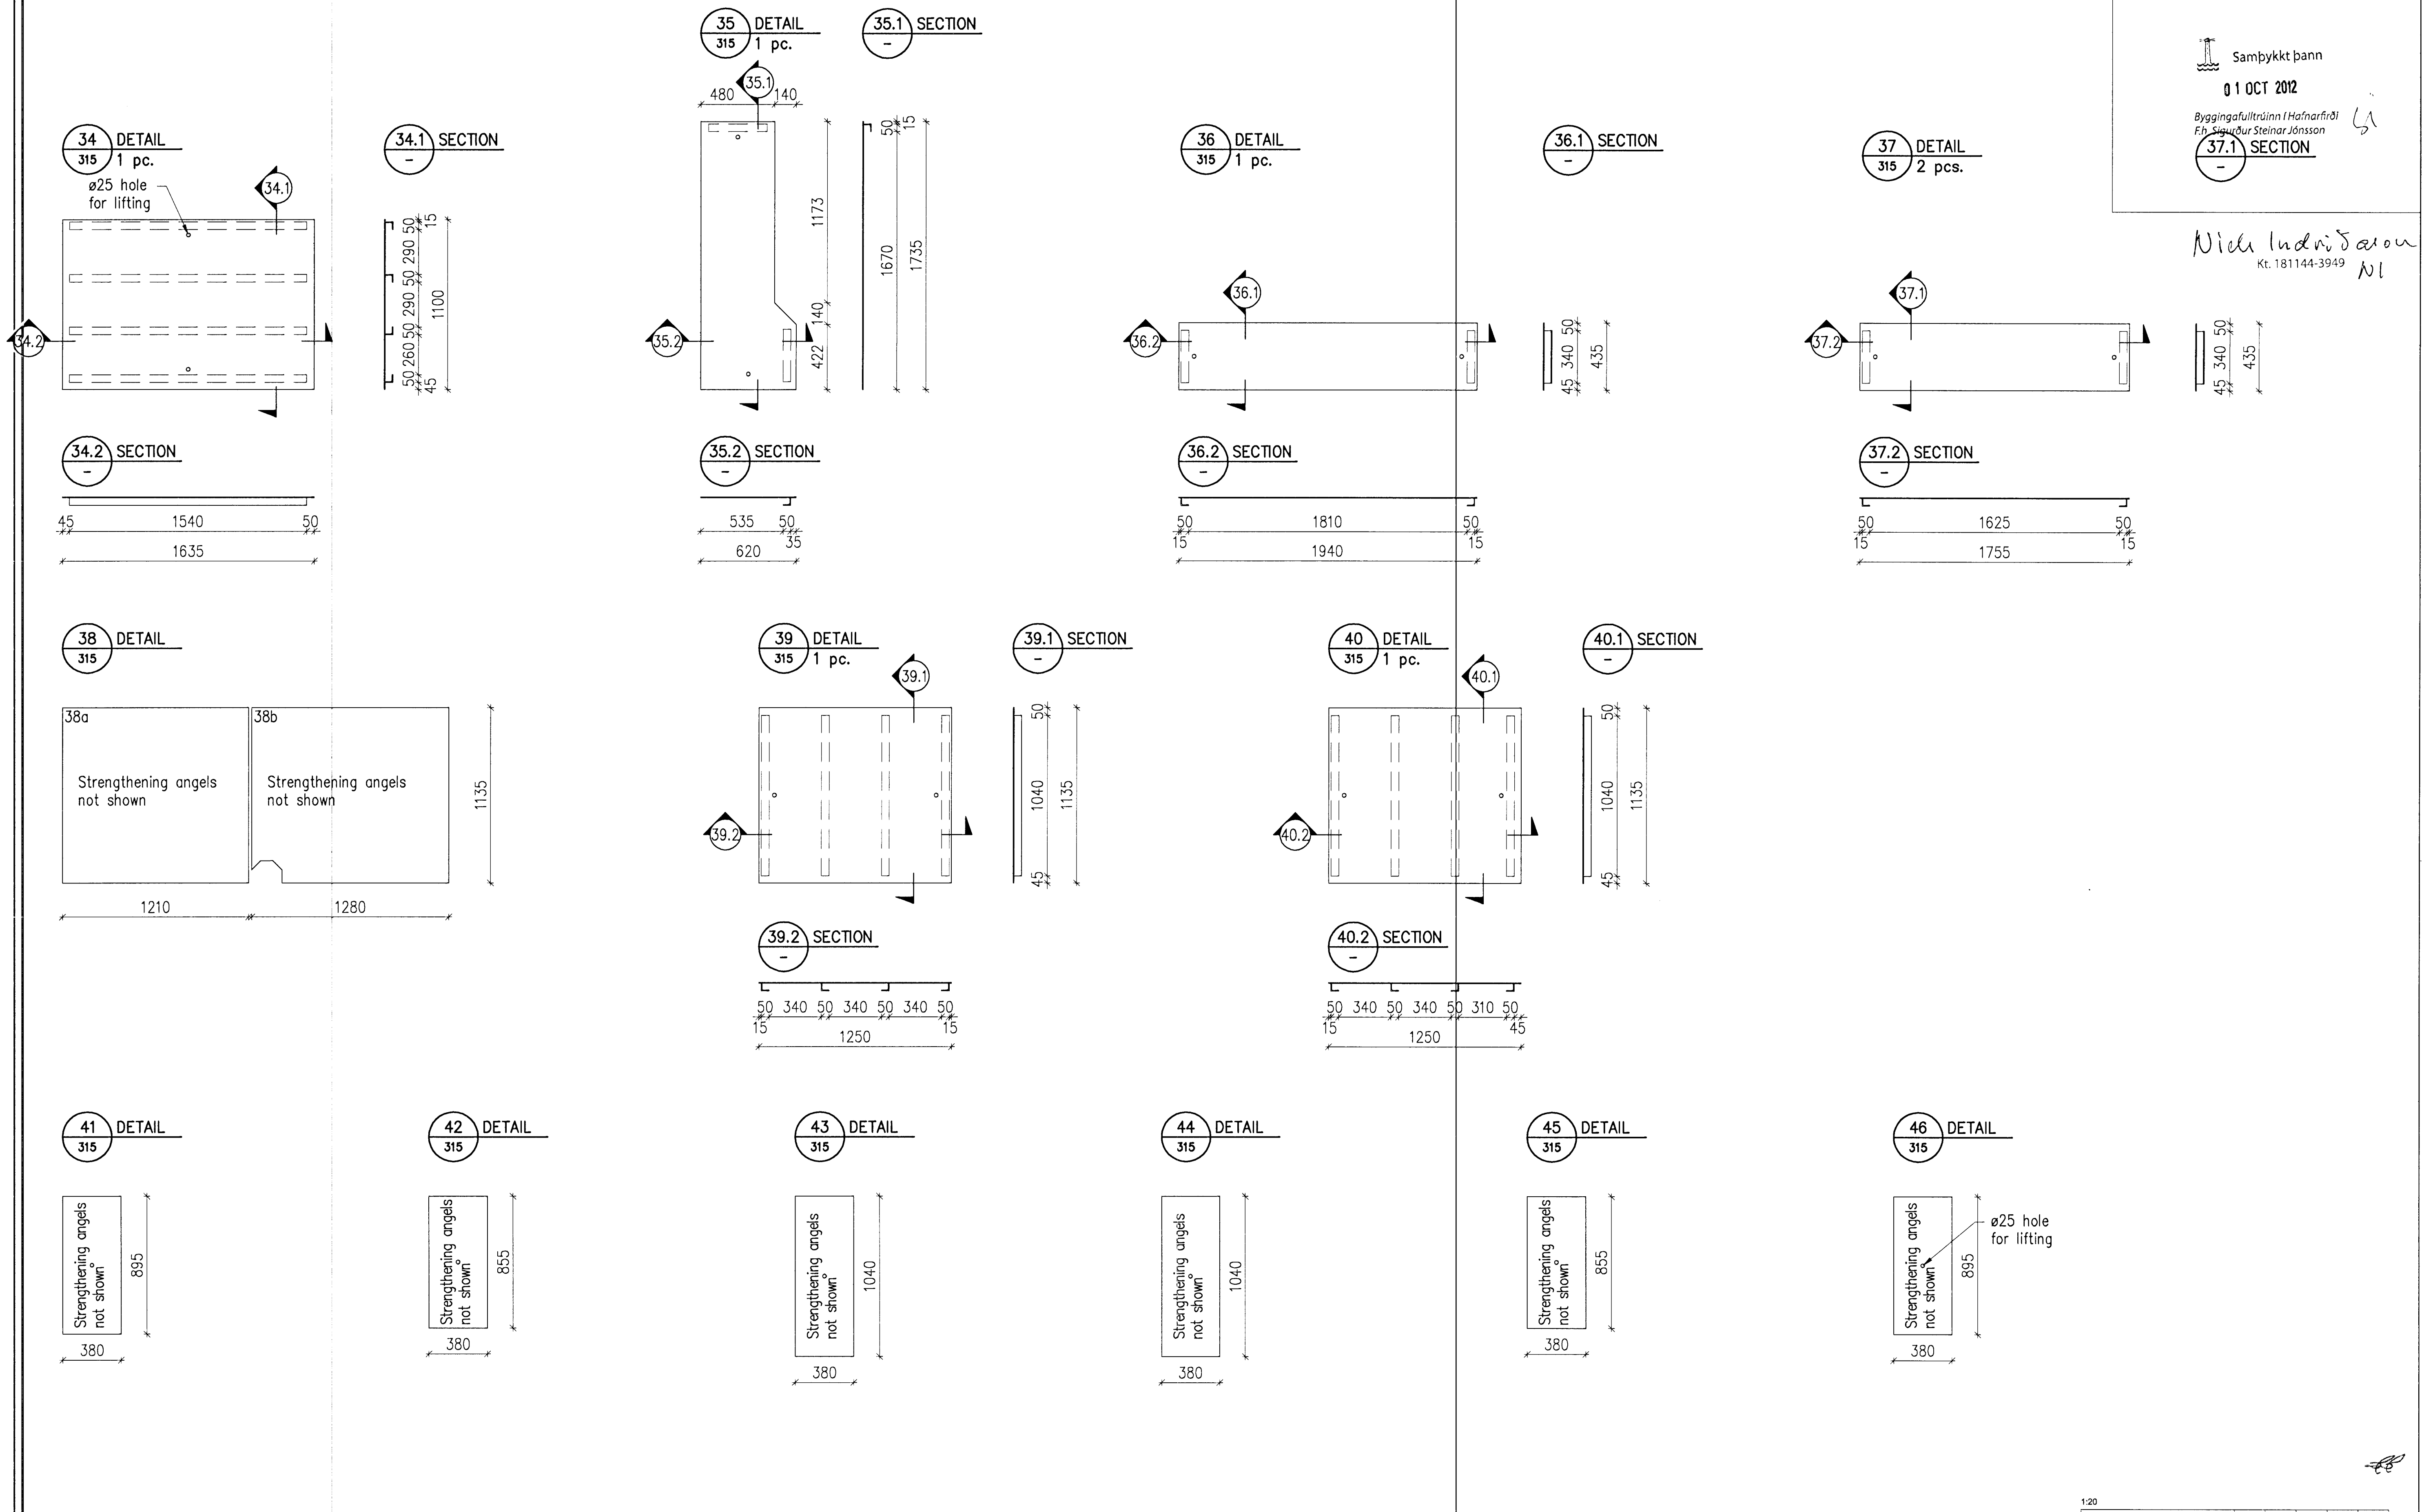

Skýringar: Legend:	Plates are aluminium chequered plates 5/7. Angels are aluminium 50x50x5 welded to plates. All dimenions shall be checked on site.	<table border="1"> <tr> <th>Útg nr</th> <th>Rev no</th> <th>Lýsing</th> <th>Description</th> <th>Dagsetning</th> <th>Date</th> <th>Har/Þun</th> <th>Des/Drw</th> <th>Yfirf</th> <th>Old</th> <th>Notk heim</th> <th>Suppl Rel</th> <th>Notk heim</th> <th>ISAL Rel</th> </tr> <tr> <td>2</td> <td></td> <td>Record drawing</td> <td></td> <td>2012.09.12</td> <td></td> <td>HS</td> <td></td> <td>NI</td> <td></td> <td></td> <td></td> <td></td> <td></td> </tr> </table>	Útg nr	Rev no	Lýsing	Description	Dagsetning	Date	Har/Þun	Des/Drw	Yfirf	Old	Notk heim	Suppl Rel	Notk heim	ISAL Rel	2		Record drawing		2012.09.12		HS		NI						This drawing is the property of Rio Tinto Alcan Iceland Ltd and handed out for personal use only. It may neither be copied nor made available to others without permission of Rio Tinto Alcan Iceland Ltd. The receiver is liable for any misuse. Site: A1 Mkv: 1:20 Farrest: Scale: 1:20 Dimensions without tolerances according to ISO 2768-1 medium.		Dagsetning / Date: 2011.09.14 Hönnuð / Designed: HS Tekn / Drawn: LDB Verktaki / Supplier: HRV Tekn.nr.verktaka / Supplier drw.no: IDP-410-ZA-015-320 Samþykkt / Approved: NI Yfirf / Chkd: NI Hluti af: / Part of:	IPU410-RECTIFIER BUILDINGS B5/S2 GRATING AND COVER PLATES, DETAILS AND SECTIONS STRUTURAL STEEL UB12 RioTintoAlcan ISAL Akan Iceland Ltd Stjórarneyki IS-222 Hafnarfjörður Ísland	Flokkur nr.: Blað nr.: Nasta bl.nr.: Kostn.nr.-Ceno. / Blm.nr.-Eq.no: 4011 13982 ISAL Tekn.nr. ISAL /Dra.no. of ISAL Breyt./Rev: 251370 A
			Útg nr	Rev no	Lýsing	Description	Dagsetning	Date	Har/Þun	Des/Drw	Yfirf	Old	Notk heim	Suppl Rel	Notk heim	ISAL Rel																			
2		Record drawing		2012.09.12		HS		NI																											
ISAL Yfirfarið og skráð, dags / ISAL Checked, date ISAL Samþykkt, dags / ISAL Approved, date																																			