


EXISTING PLAN VIEW 1:50

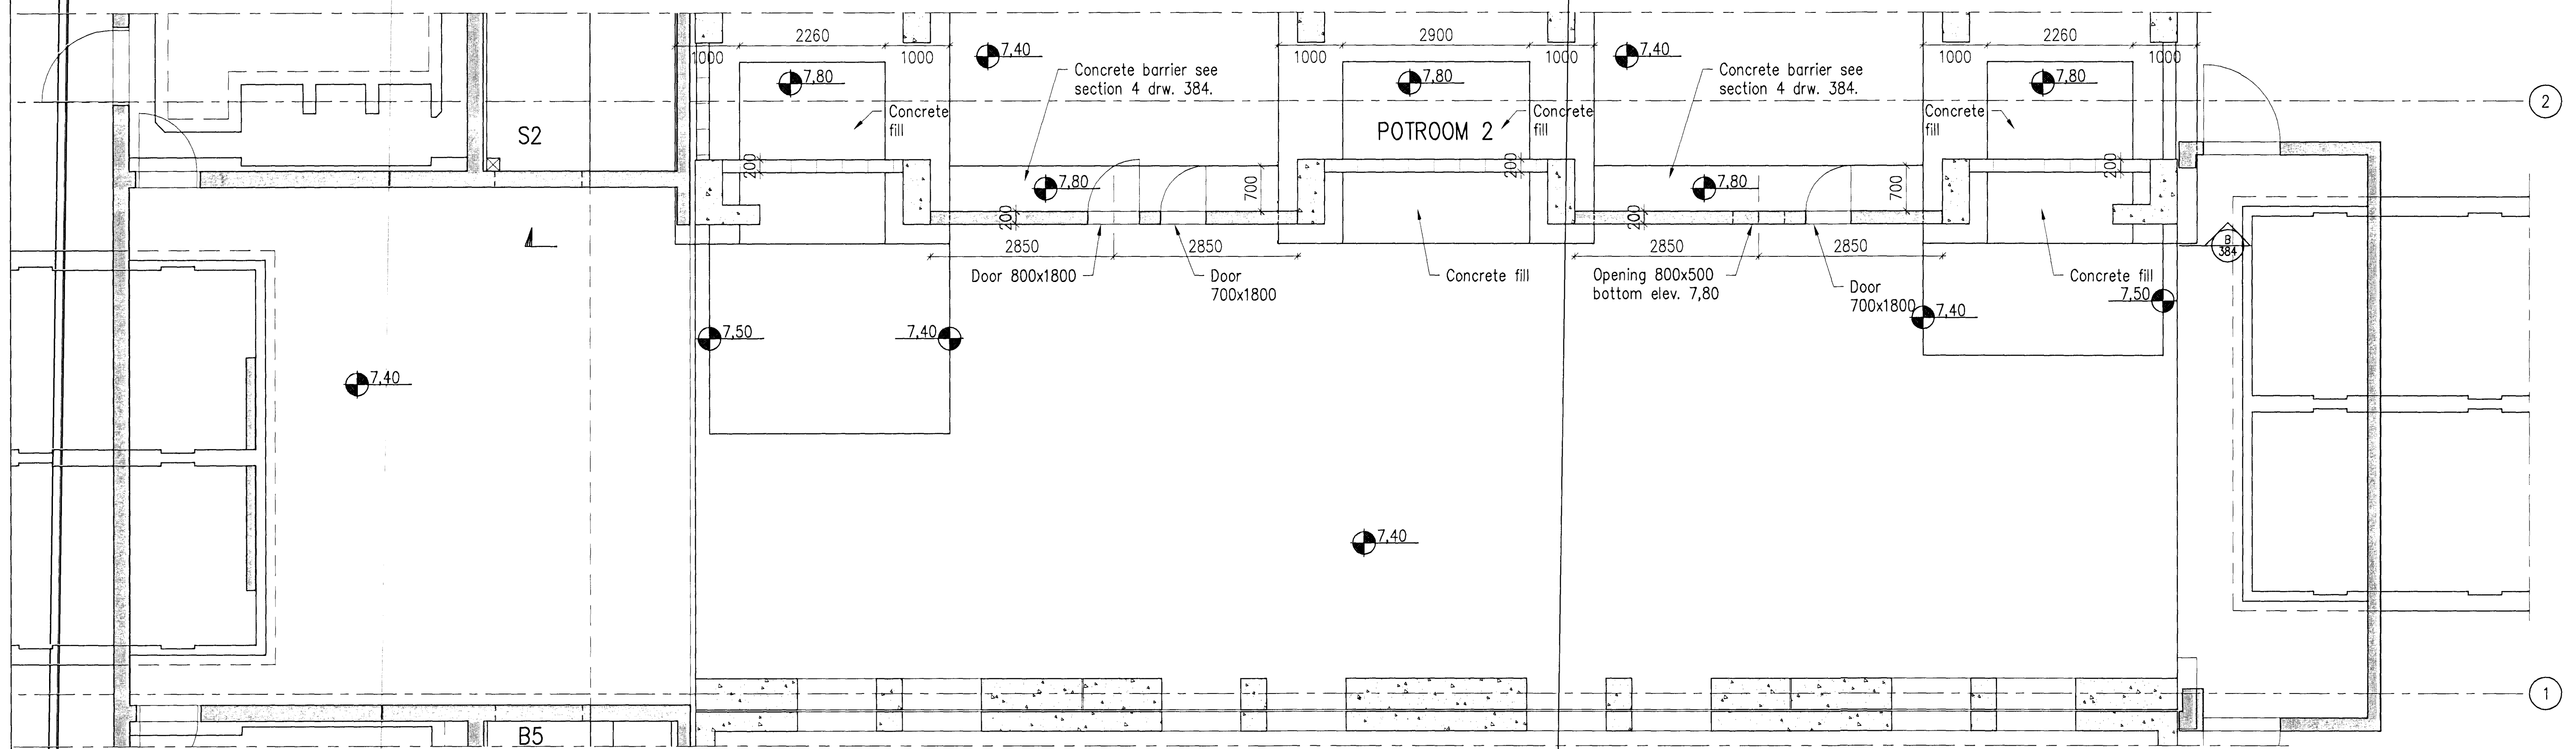

NEW PLAN VIEW 1:50

Samþykkt bann  
01 OCT 2012  
Byggingafultráðinn í Hafnarvík  
Eh. Sigurður Steinar Jóhannsson

Nick Indriðsson  
Kt. 181144-3949 NI

Skýringar:  
Legend:  
Concrete cover 30 mm.  
Concrete: C30/37.  
Reinforcement: B500C.  
NB: No equipment shown on this drawing.

6	Record drawing	2012.09.13	GMG	NI	ESJ	MSJ
Útg. nr.	Útg. Descr.	Dagsetning	Ham / Tm	Yfir	Notk. heim	Notk. heim
Rev. no.	Description	Date	Des/Draw	Chk	Suppl	Rel

This drawing is the property of Rio Tinto Alcan Iceland Ltd. and handed out for personal use only. It may neither be copied nor made available to others without permission of Rio Tinto Alcan Iceland Ltd. The receiver is liable for any misuse.

Starb. Formát: A1 Mkv. Scale: 1:50  
Dimensions without tolerances according to ISO 2768-1 medium.

Dagsetning / Date: 2011.07.14  
Hannað / Designed: SE  
Tekin / Drawn: LOB  
Tilgjafi / Supplier: HRV  
Tilgjafi / Supplier: HRV  
Tilgjafi / Supplier: HRV  
Tilgjafi / Supplier: HRV

IPU 410-RECTIFIER BUILDINGS-POTROOM 2  
COLLECTOR BUSBAR ROOMS  
LAYOUT  
FORM WORK

Flokkur nr.: 4011  
Blað nr.: 13982  
Nasta blinn.:  
Kostn. nr. - Dæmi. / BSN nr. - Eign. númer: 4011 13982  
AKS UB12  
Tilgjafi: ISAL / Drw. no. of ISAL: 251322  
Breyt./Rev.: A

**Rio Tinto Alcan**  
Alcan Iceland Ltd  
Straumavík  
IS-222 Hafnarvíkur  
Ísland

ISAL Yfirbúð og skráð. dags. / ISAL Checked, date  
ISAL Samþykkt. dags. / ISAL Approval, date