



Níels Indriðason
 Kt. 181144-3949
 NI


34 DETAIL
 215 1 pc.

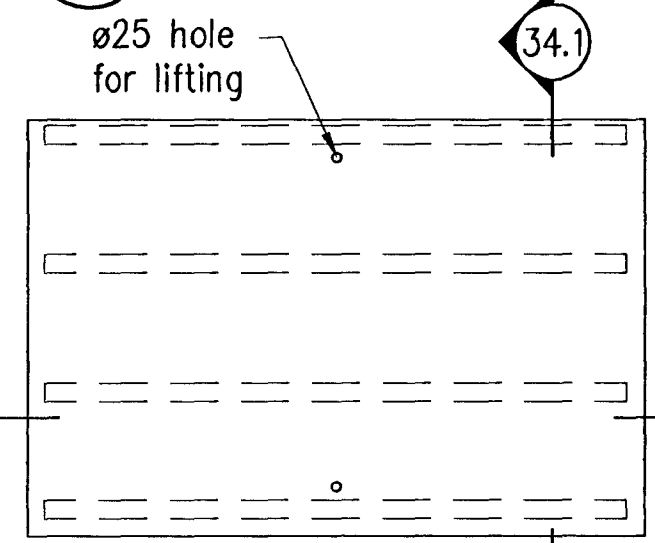


34.1 SECTION

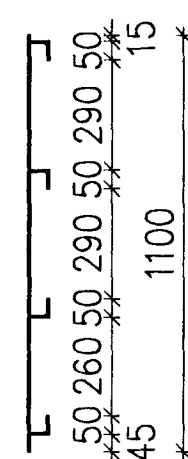


34.2 SECTION

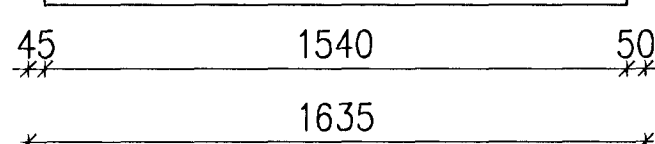


35 DETAIL
 215 1 pc.

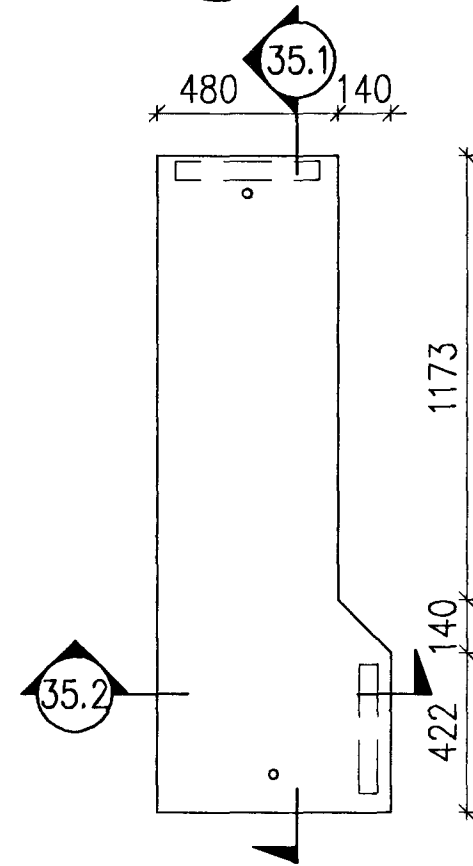


35.1 SECTION

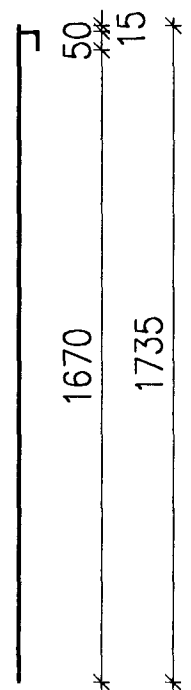


35.2 SECTION

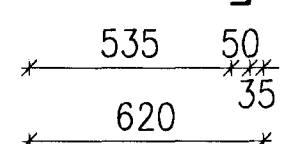


36 DETAIL
 215 1 pc.

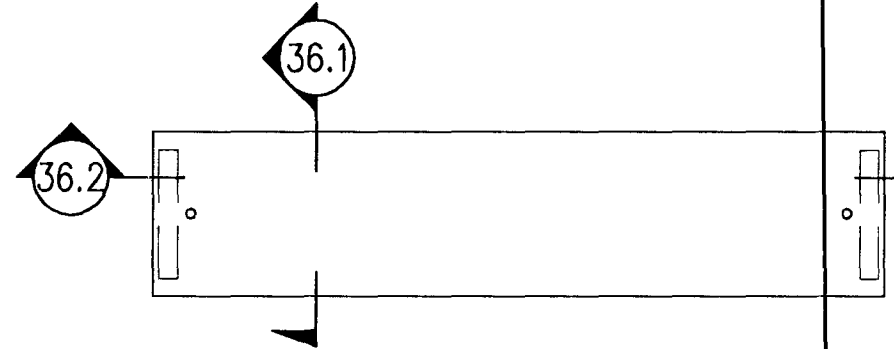


36.1 SECTION

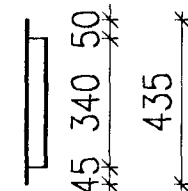


36.2 SECTION

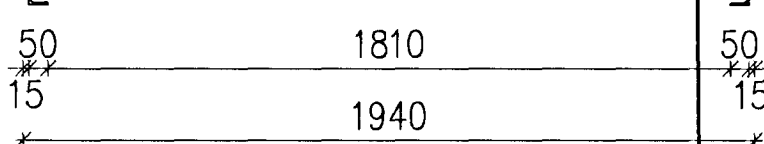


37 DETAIL
 215 2 pcs.

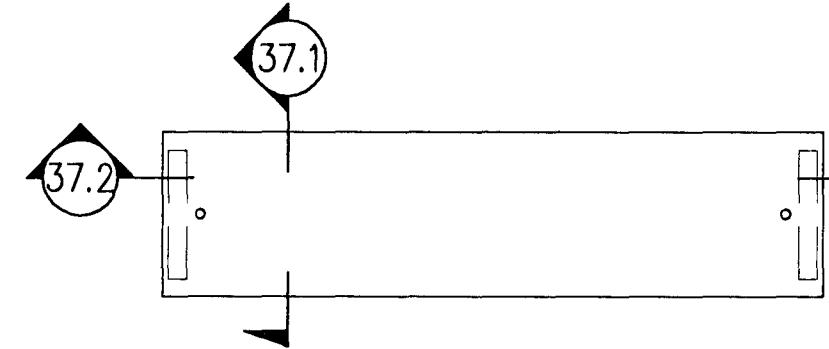


37.2 SECTION

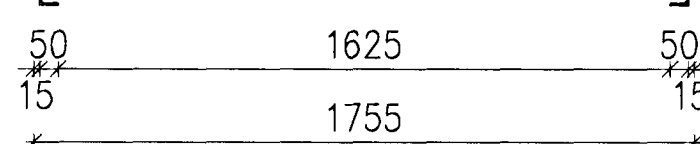


38 DETAIL
 215

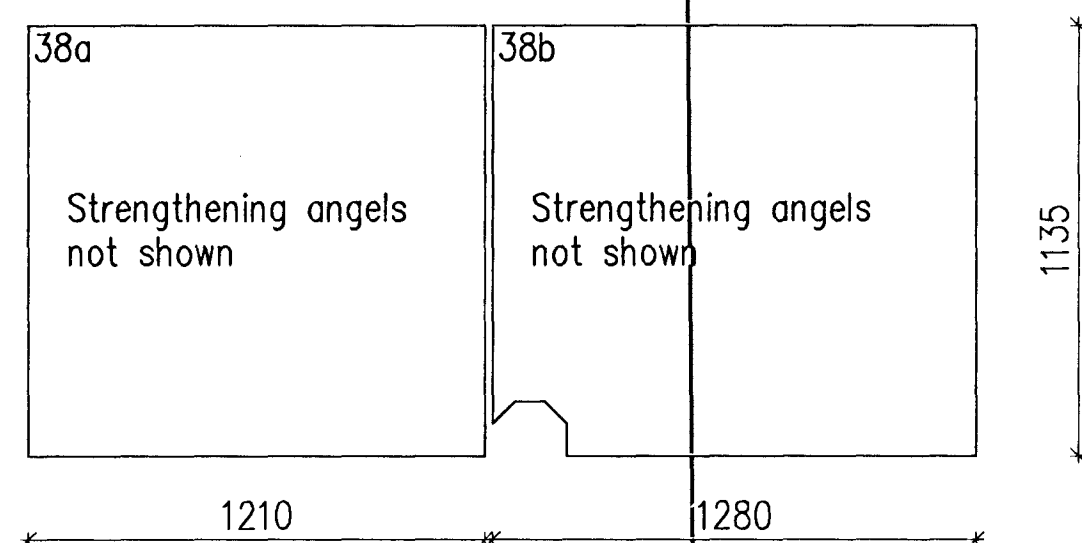


39 DETAIL
 215 1 pc.

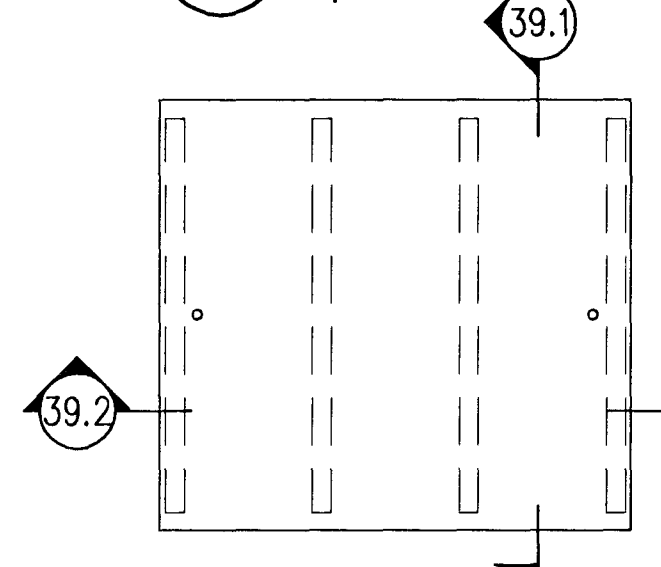


39.1 SECTION

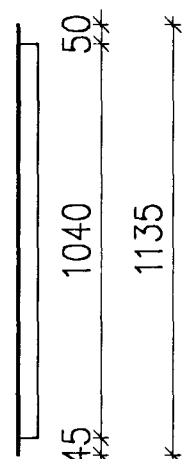


39.2 SECTION

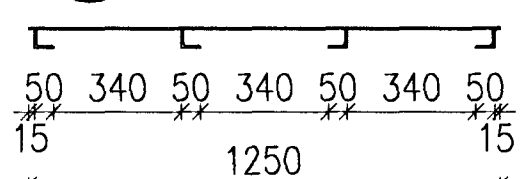


40 DETAIL
 215 1 pc.

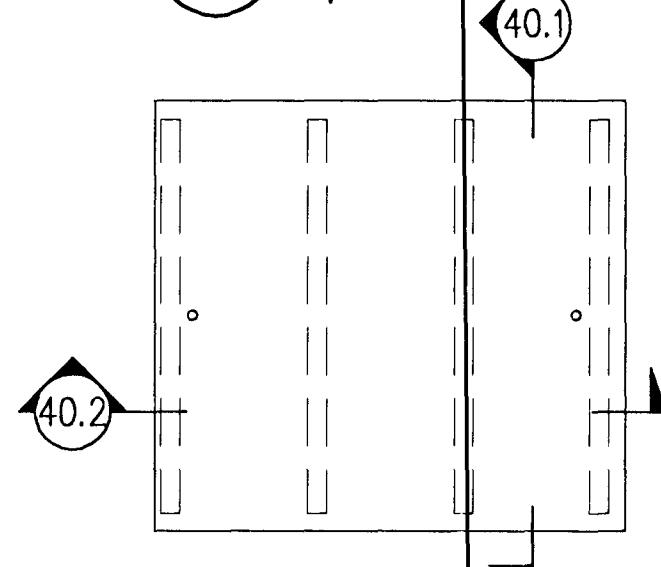


40.1 SECTION

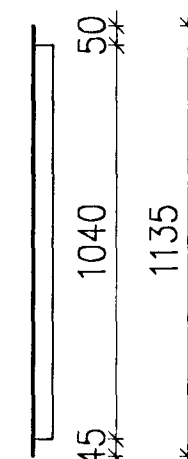


40.2 SECTION

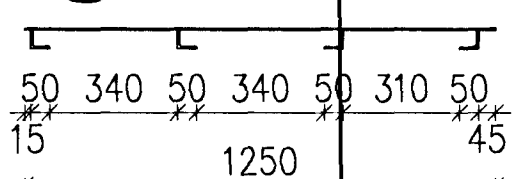


41 DETAIL
 215

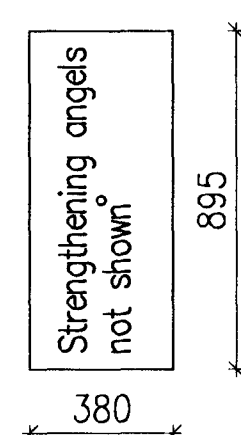


42 DETAIL
 215

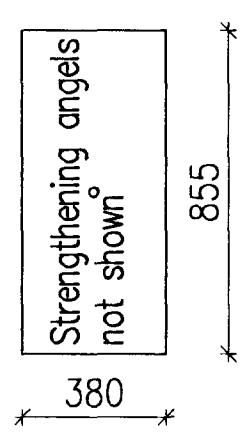


43 DETAIL
 215

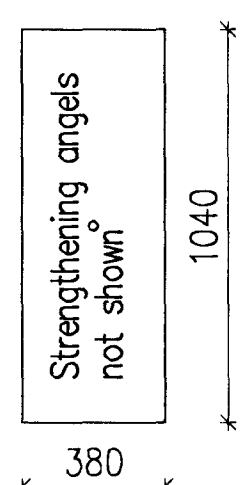


44 DETAIL
 215

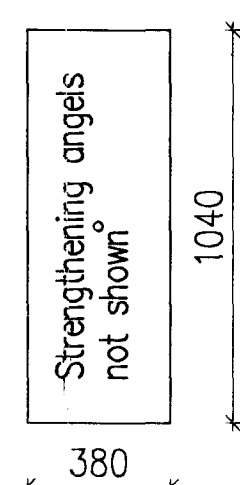

45 DETAIL
 215

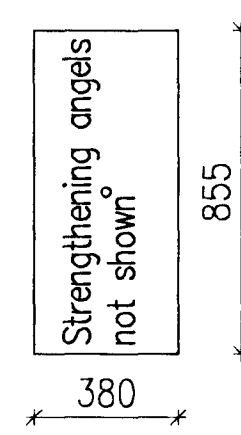

46 DETAIL
 215

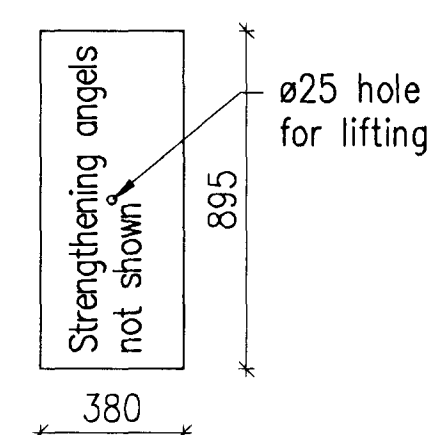

Skýringar:
 Legend: Plates are aluminium chequered plates 5/7.
 Angels are aluminium 50x50x5 welded to plates.
 All dimensions shall be checked on site.

Sl. nr.	Revisión	Útgáfudagur	Útgerðing	Stað	Stærð	Mál	Skilgreining
2		2012.09.12	HS	NI	BS	MS	Record drawing

This drawing is the property of Rio Tinto Alcan Iceland Ltd. and handed out for personal use only. It may neither be copied nor made available to others without permission of Rio Tinto Alcan Iceland Ltd. The receiver is liable for any misuse.

Stærð: A1
 Mál: 1:20
 Skilgreining: Dimensions without tolerances according to ISO 2768-1 medium.

HRVA HATCH
 ISAL PRODUCTION UPGRADE

Dagsetning / Date: 2011.09.14	Flokkur nr.: IPU410-RECTIFIER BUILDINGS	Blað nr.: A5/S1	Nesta bl. nr.: 13981
Höfundur / Designed: HS	Tekni / Drawn: LDB	Kostnaður - Cost. / Bðn. nr. - Eq. no: 4011	
Verktaki / Supplier: HRV	Teikningar / Dwg. type: STRUCTURAL STEEL	AKS UB11	
Tekni nr. verktaka / Supplier drw. no: IDP-410-ZA-015-220	Tekni nr. ISAL / Drw. no. of ISAL: 251357	Breyt./Rev.: A	
Samþykkt / Approved: NI	Yfirl. / Chkd: NI		

