


STÆKKUN STEYPUKÁLA 1996	
KJALLARI	1080 M <sup>2</sup>
ADALHÆÐ	4138 M <sup>2</sup>
MILLIHÆÐ	433 M <sup>2</sup>

Samþykkt þann  
30 SEPT. 2003  
Byggingenfulltrúinn í Hafnarfirði  
Fr. Kristján Þorárinsson

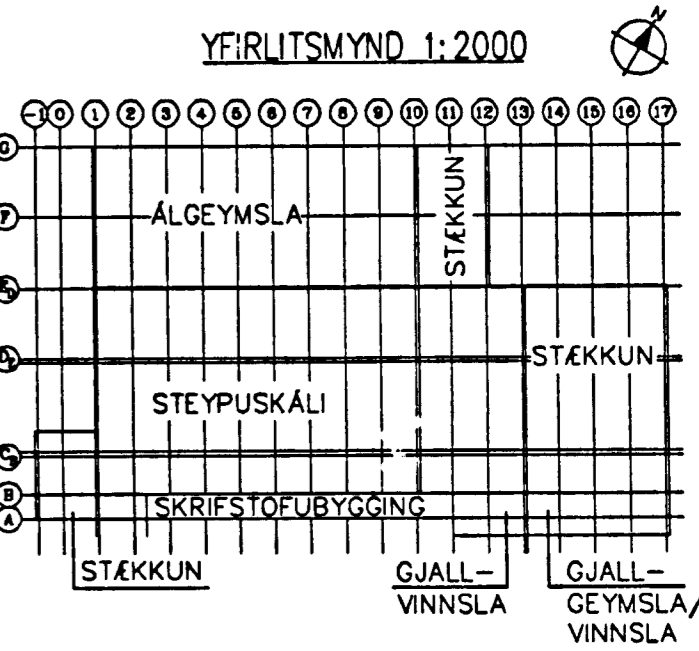

Alcan á Íslandi hf.			
Skráning matshluta bygginga í Straumsvík			
STEYPUKÁLI	123154	12	
Helli byggingar	Fastanúmer	Landnúmer	Matshlutanúmer
VST Verkræðistofa Sigurðar Thoroddsen hf. kt. 611276-0289			
Niels Indriðason W			2003-09-19
Niels Indriðason kt. 181144-3949			Dagsetning

Skýptur suðri: tilheyrir ekki M.H.L.12

REV. NO.	DATE	REVISION	BY	APP.	REV. NO.	DATE	REVISION	BY	APP.	NOTES	REFERENCE DRAWING	DRAWING NUMBER
2	29.11.1997	EINS OG BYGGT ER, "AS BUILT"		UH								
1	3.9.1996	STÆKKUN SVALASVÆÐIS ÓR 10M Í 17M		UH								
0												

ICELANDIC ALUMINIUM COMPANY LTD

ALUSUISSE ALESA

ALUSUISSE ENGINEERING LTD. ZÜRICH SWITZERLAND

VERKFRÆÐISTOFAN ÖNN SF. TÆKNITHJONUSTAN SF.

STÆKKUN STEYPUKÁLA GRUNNMÝND GRUNNMÝND KJALLARA

79000-34404

193604 6010BA1226

REVISION 2

This drawing is our property and given for personal use only. It may not be copied or made available to others without our permission. The receiver is responsible for any misuse.

