



Níels Indriðason  
 Kt. 181144-3949  
 NI


1 DETAIL  
 215

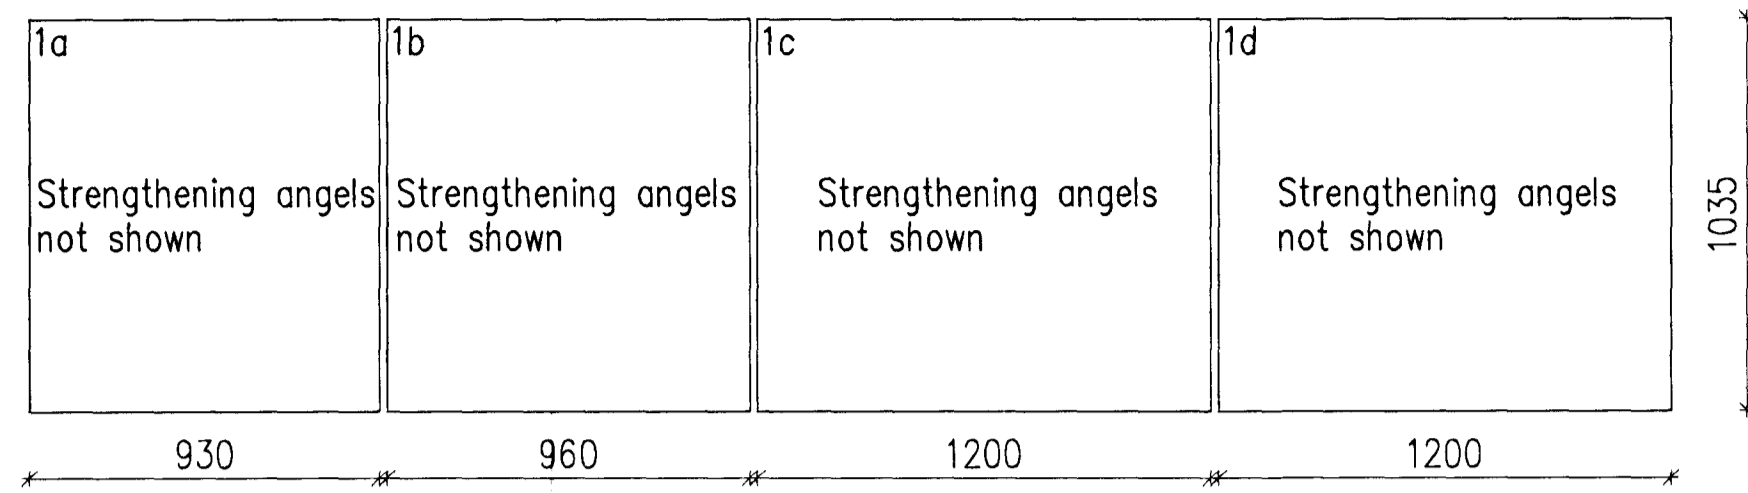


2 DETAIL  
 215 1 pc.

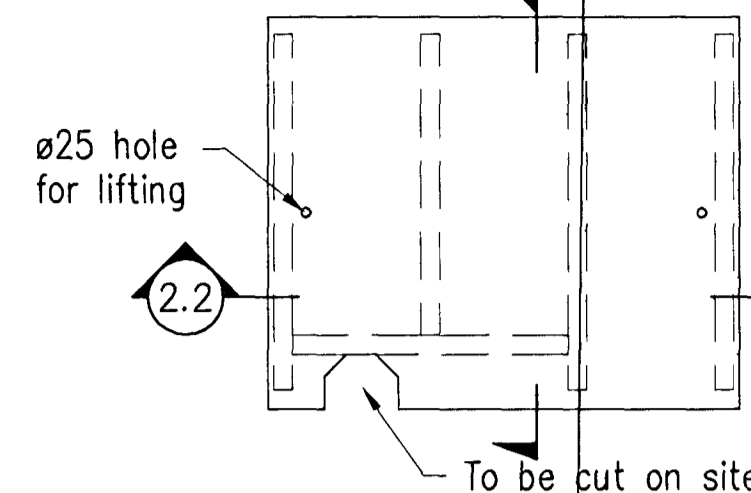


2.1 SECTION

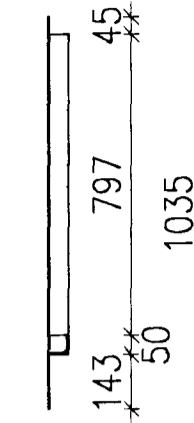


2.2 SECTION

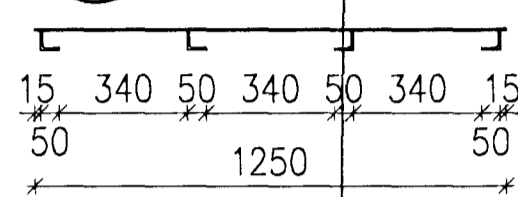


3 DETAIL  
 215 1 pc.

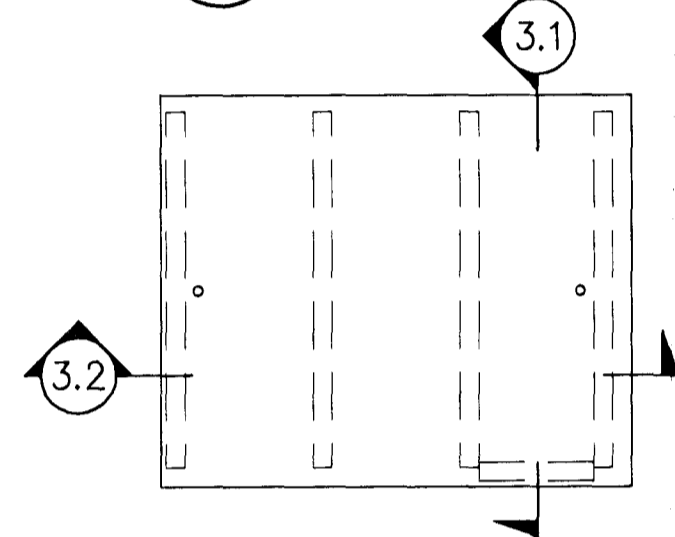


3.1 SECTION

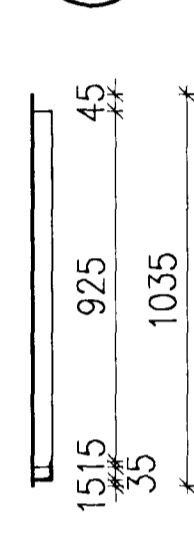


3.2 SECTION

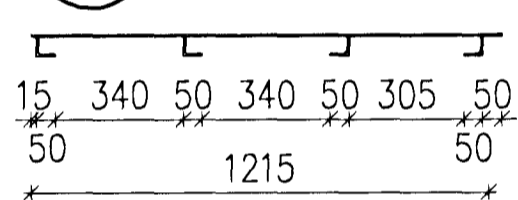


4 DETAIL  
 215 1 pc.

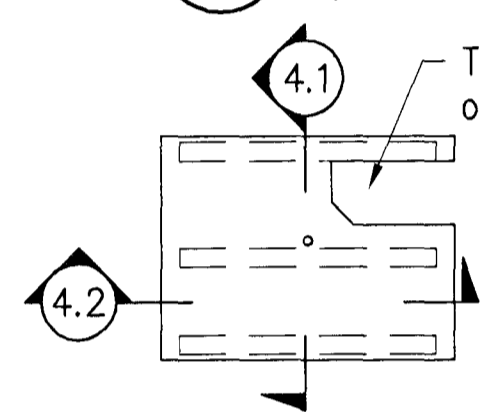


4.1 SECTION

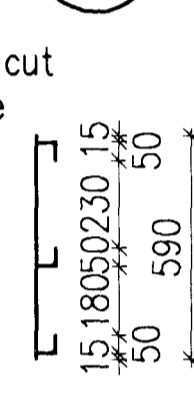


4.2 SECTION

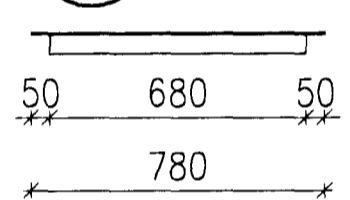


5 DETAIL  
 215 1 pc.

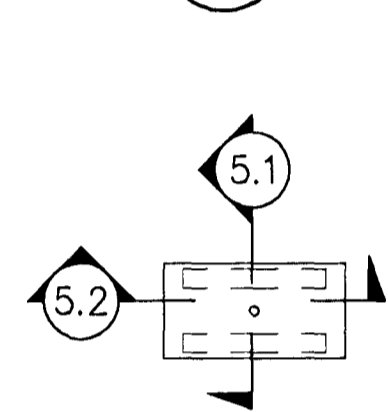


5.1 SECTION

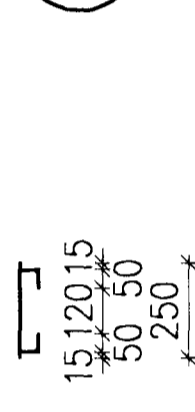

5.2 SECTION

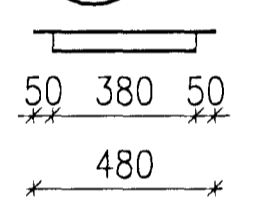


6 DETAIL  
 215 1 pc.

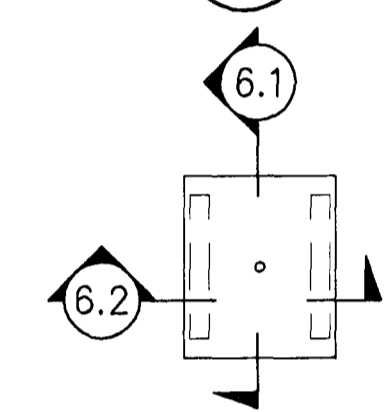


6.1 SECTION




6.2 SECTION

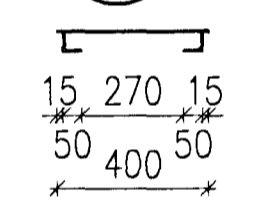


7 DETAIL  
 215 1 pc.

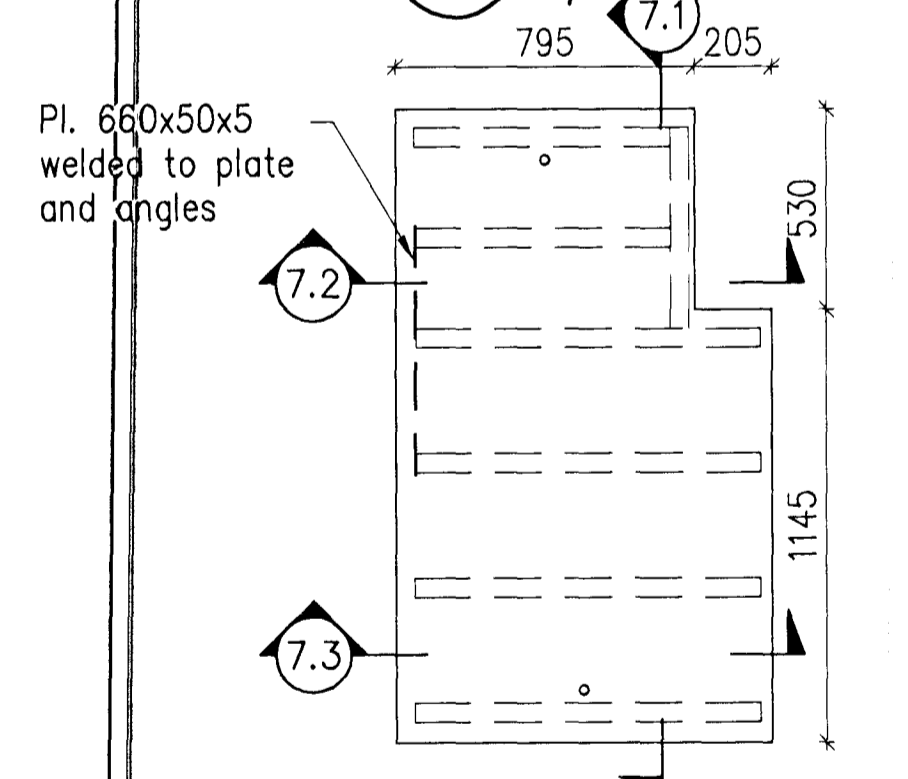


7.1 SECTION

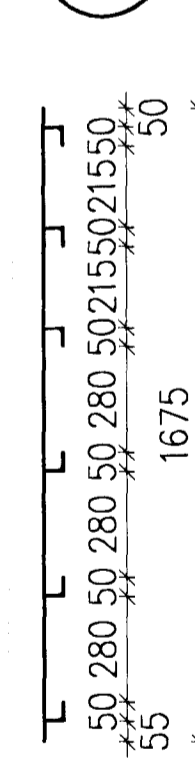


7.2 SECTION

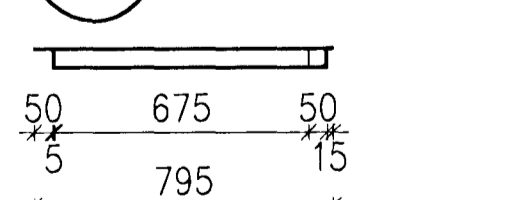


7.3 SECTION

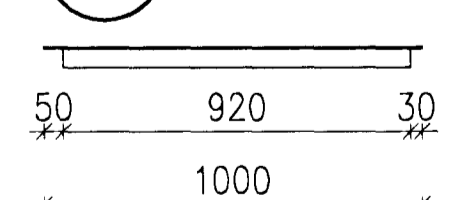


8 DETAIL  
 215 1 pc.

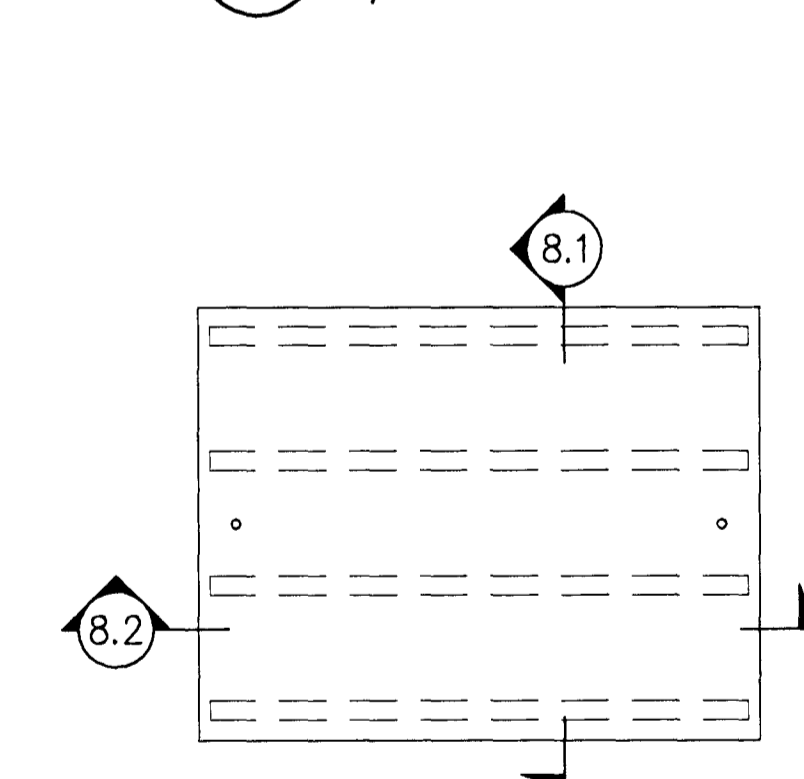


8.1 SECTION

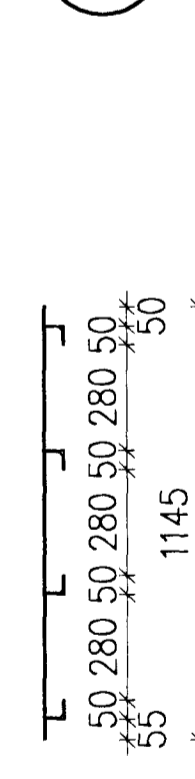


8.2 SECTION

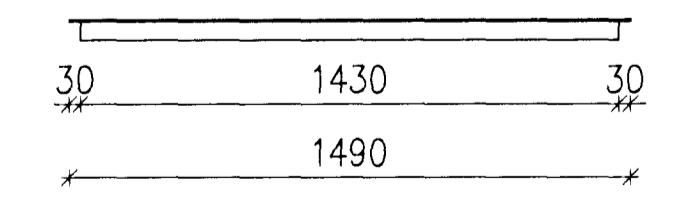


9 DETAIL  
 215 1 pc.

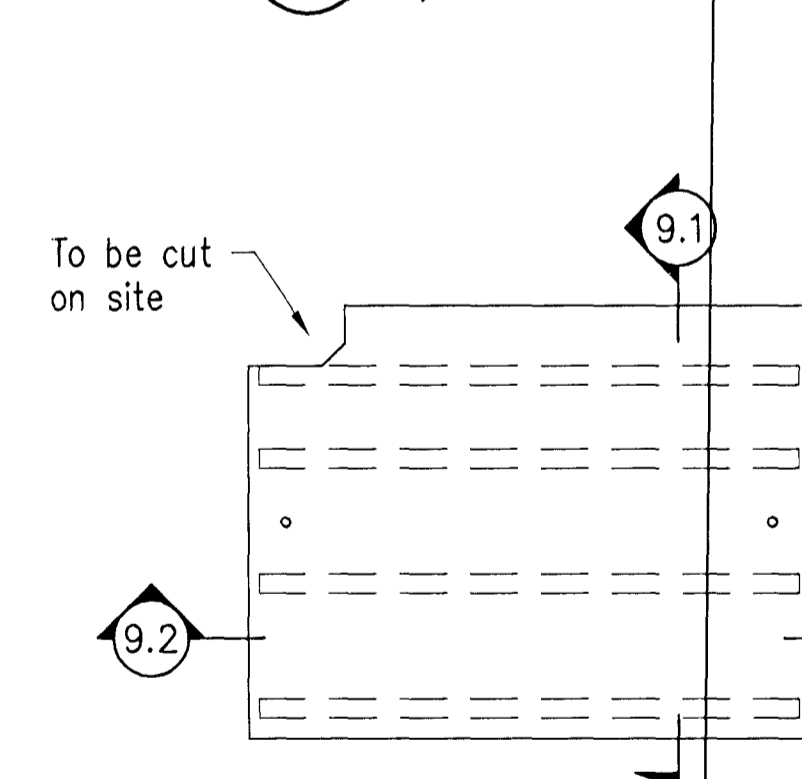


9.1 SECTION

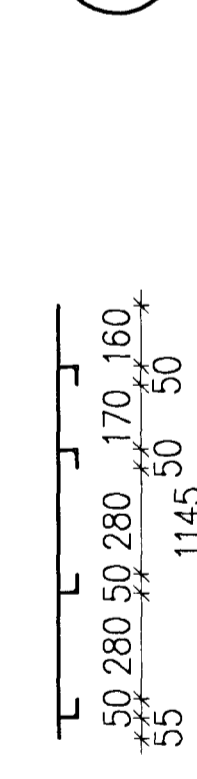


9.2 SECTION

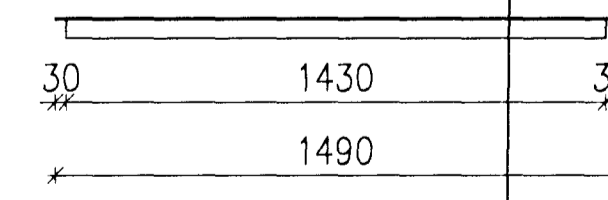



10 DETAIL  
 215 1 pc.

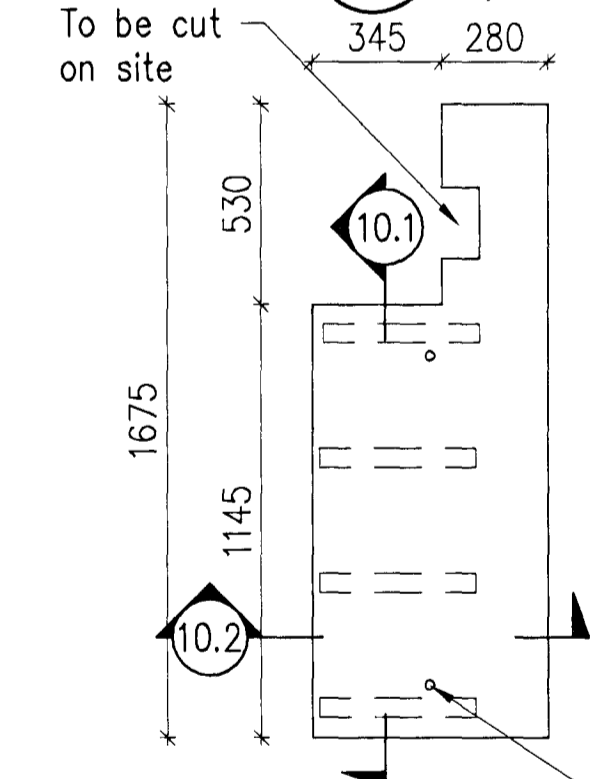

10.1 SECTION

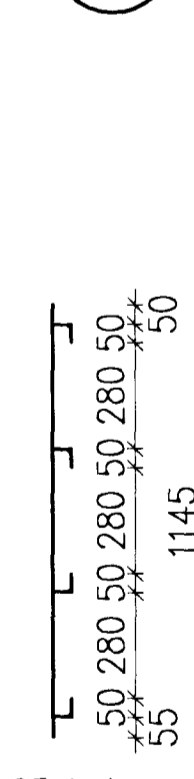

10.2 SECTION

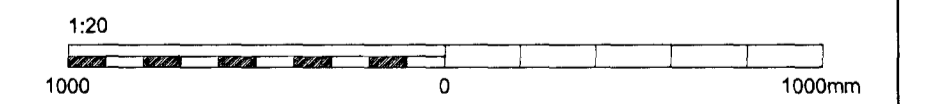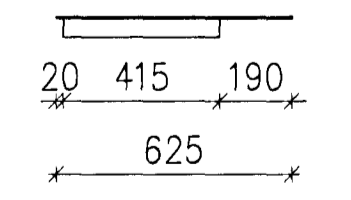

Skýringar: Plates are aluminium chequered plates 5/7.  
 Legend: Angels are aluminium 50x50x5 welded to plates.  
 All dimensions shall be checked on site.

2	Record drawing	2012.09.12	HS	NI	BS	HS
Ég nr	Lýsing	Dagsetning	Notað	Yfir	Notað	Notað
Rev no	Description	Date	Des/Dr	Dkd	Notk hem	ISAL Ref

This drawing is the property of Rio Tinto Alcan Iceland Ltd and handed out for personal use only. It may neither be copied nor made available to others without permission of Rio Tinto Alcan Iceland Ltd. The receiver is liable for any misuse.	
Blátt: A1	Mkv.: 1:20
Form: A1	Scale: 1:20
Dimensions without tolerances according to ISO 2768-1 medium.	

Dagsetning / Date: 2011.09.14		IPU410-RECTIFIER BUILDINGS	
Hannað / Designed: HS	Tekin / Drawn: LDB	A5/S1	
Verktaki / Supplier: HRV	Teikningar / Draw. type: HRV	GRATING AND COVER PLATES, DETAILS AND SECTIONS	
Tel.nr. verktaka / Supplier drw.no: IDP-410-ZA-015-217		Teikn.nr. / ISAL / Draw.no. of ISAL: 4011 13981	
Samþykkt / Approved: NI		Teikn. / ISAL / Draw.no. of ISAL: 4011 13981	
Flúti af: / Part of:		Teikn. / ISAL / Draw.no. of ISAL: 4011 13981	
HRVA HATCH		Rio Tinto Alcan	
ISAL PRODUCTION UPGRADE		Alcan Iceland Ltd	
		Strymsvík	
		IS-222 Hafnarholti	
		Iceland	
		251354	
		A	