
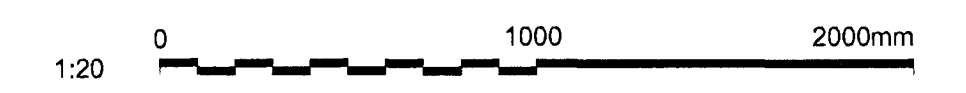


Samþykkt bann
 01 OCT 2012
 Byggingafulltrúinn / Hafnarbúi
 Fh. Sigurður Steinar Jónsson

Níels Indriðason
 Kt. 181144-3949 NI

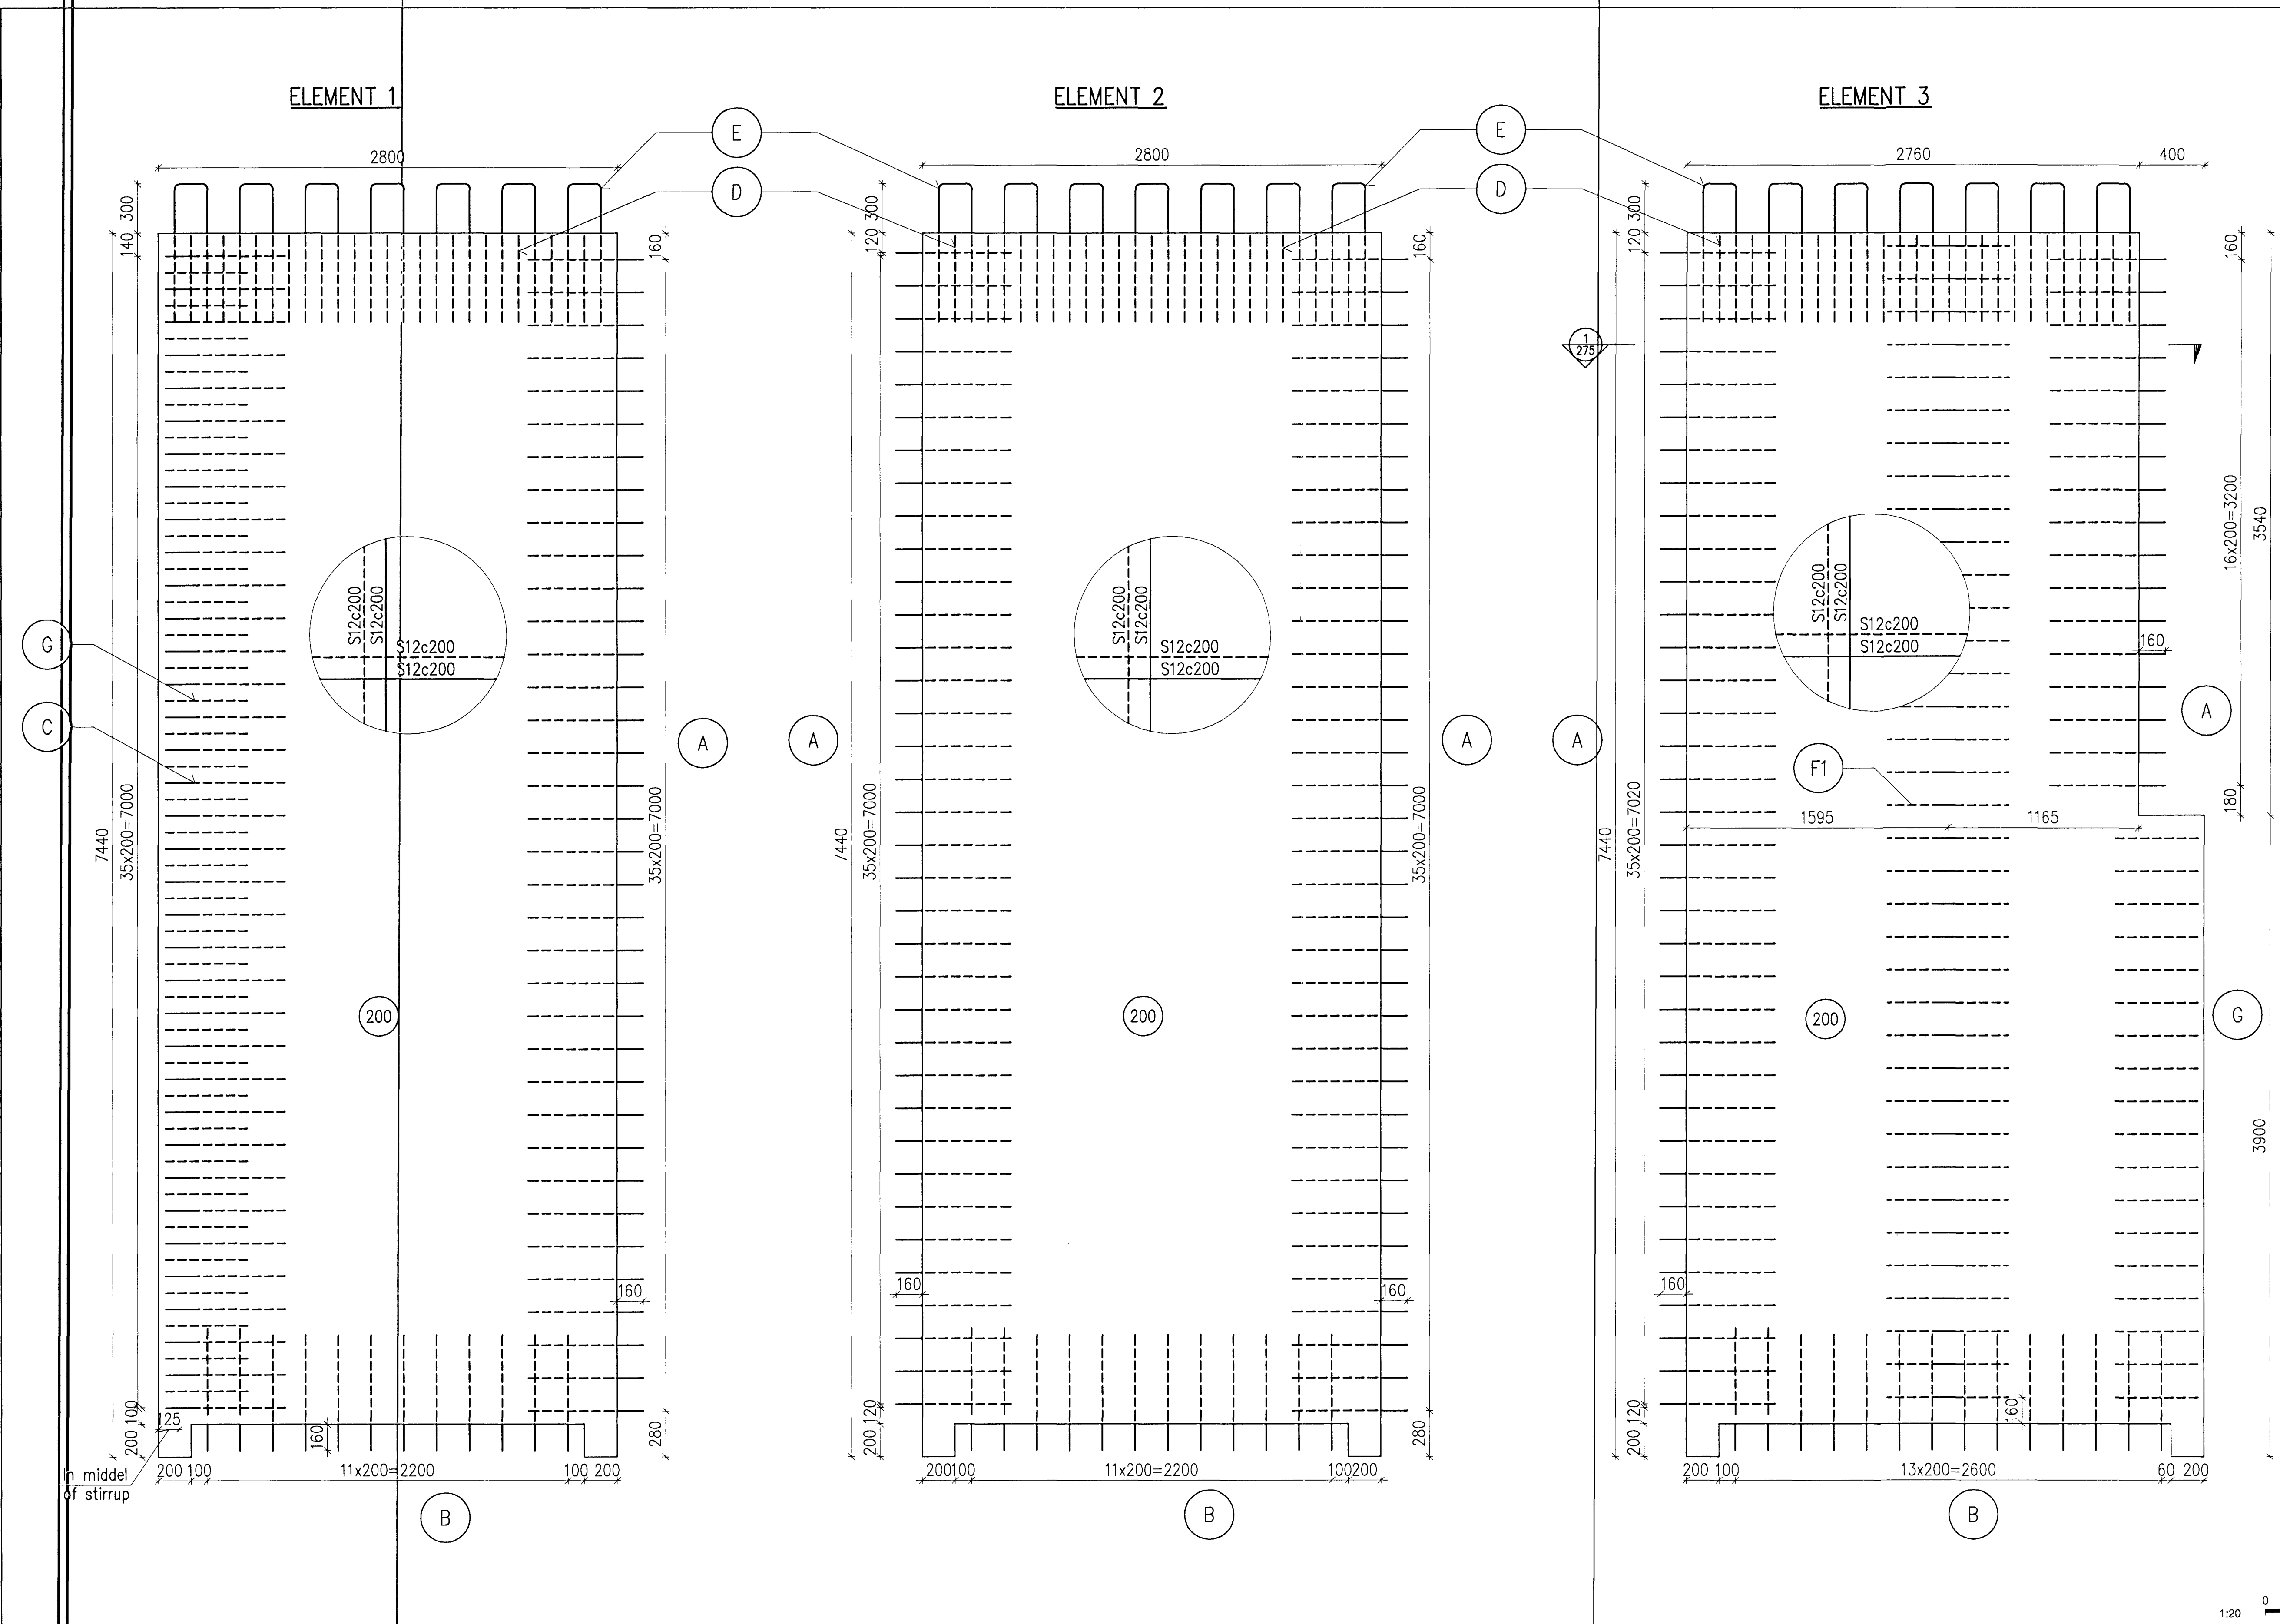

Skýringar Legend: Stirrups details see drawing 272.

| Dlg nr / Rev no | Lýsing / Description | Dagsetning / Date | Hor/Tin / Des/Drw | Yfir / Ckd | Notk heim / Suppl Rel | Notk heim / ISAL Rel |
|-----------------|----------------------|-------------------|-------------------|------------|-----------------------|----------------------|
| 3 | Record drawing | 2012.09.12 | HS | NI | BSJ | RES |

This drawing is the property of Rio Tinto Alcan Iceland Ltd and handed out for personal use only. It may neither be copied nor made available to others without permission of Rio Tinto Alcan Iceland Ltd. The receiver is liable for any misuse.
 Skala / Format: A1 Mkv. / Scale: 1:20
 Dimensions without tolerances according to ISO 2768-1 medium.



Dagsetning / Date: 2011.03.03
 Hönnuð / Designed: HS
 Tækn / Drawn: ÁFV
 Verktaki / Supplier: HRV
 Tækn.nr.verktaka / Supplier drw.no: IDP-410-CA-015-273
 Símbúi / Approved: NI
 Hluti af / Part of:

IPU 410 - RECTIFIER BUILDINGS
 A5/S1
 PRECAST ELEMENTS
 REINFORCEMENT

RioTintoAlcan

Flokkur nr.: 4011 Blað nr.: 13981
 Kosta.nr.-Cena. / Búna.nr.-Eq.no
 Tækn.nr. ISAL / Drw.no. of ISAL: 251273
 Breyt./Rev.: A

ISAL, Samþykkt, dags / ISAL Checked, date
 ISAL, Samþykkt, dags / ISAL Approval, date