


Sambýkkt þann
 1 OCT 2012
 Byggingafrúðinn í Hafnarfirði
 F.h. Sigurður Steinarr Jónsson

Nick Indriðason
 Kt. 181144-3949
 NI


A
 331 1:50

A
 331 1:20

A
 331 1:20

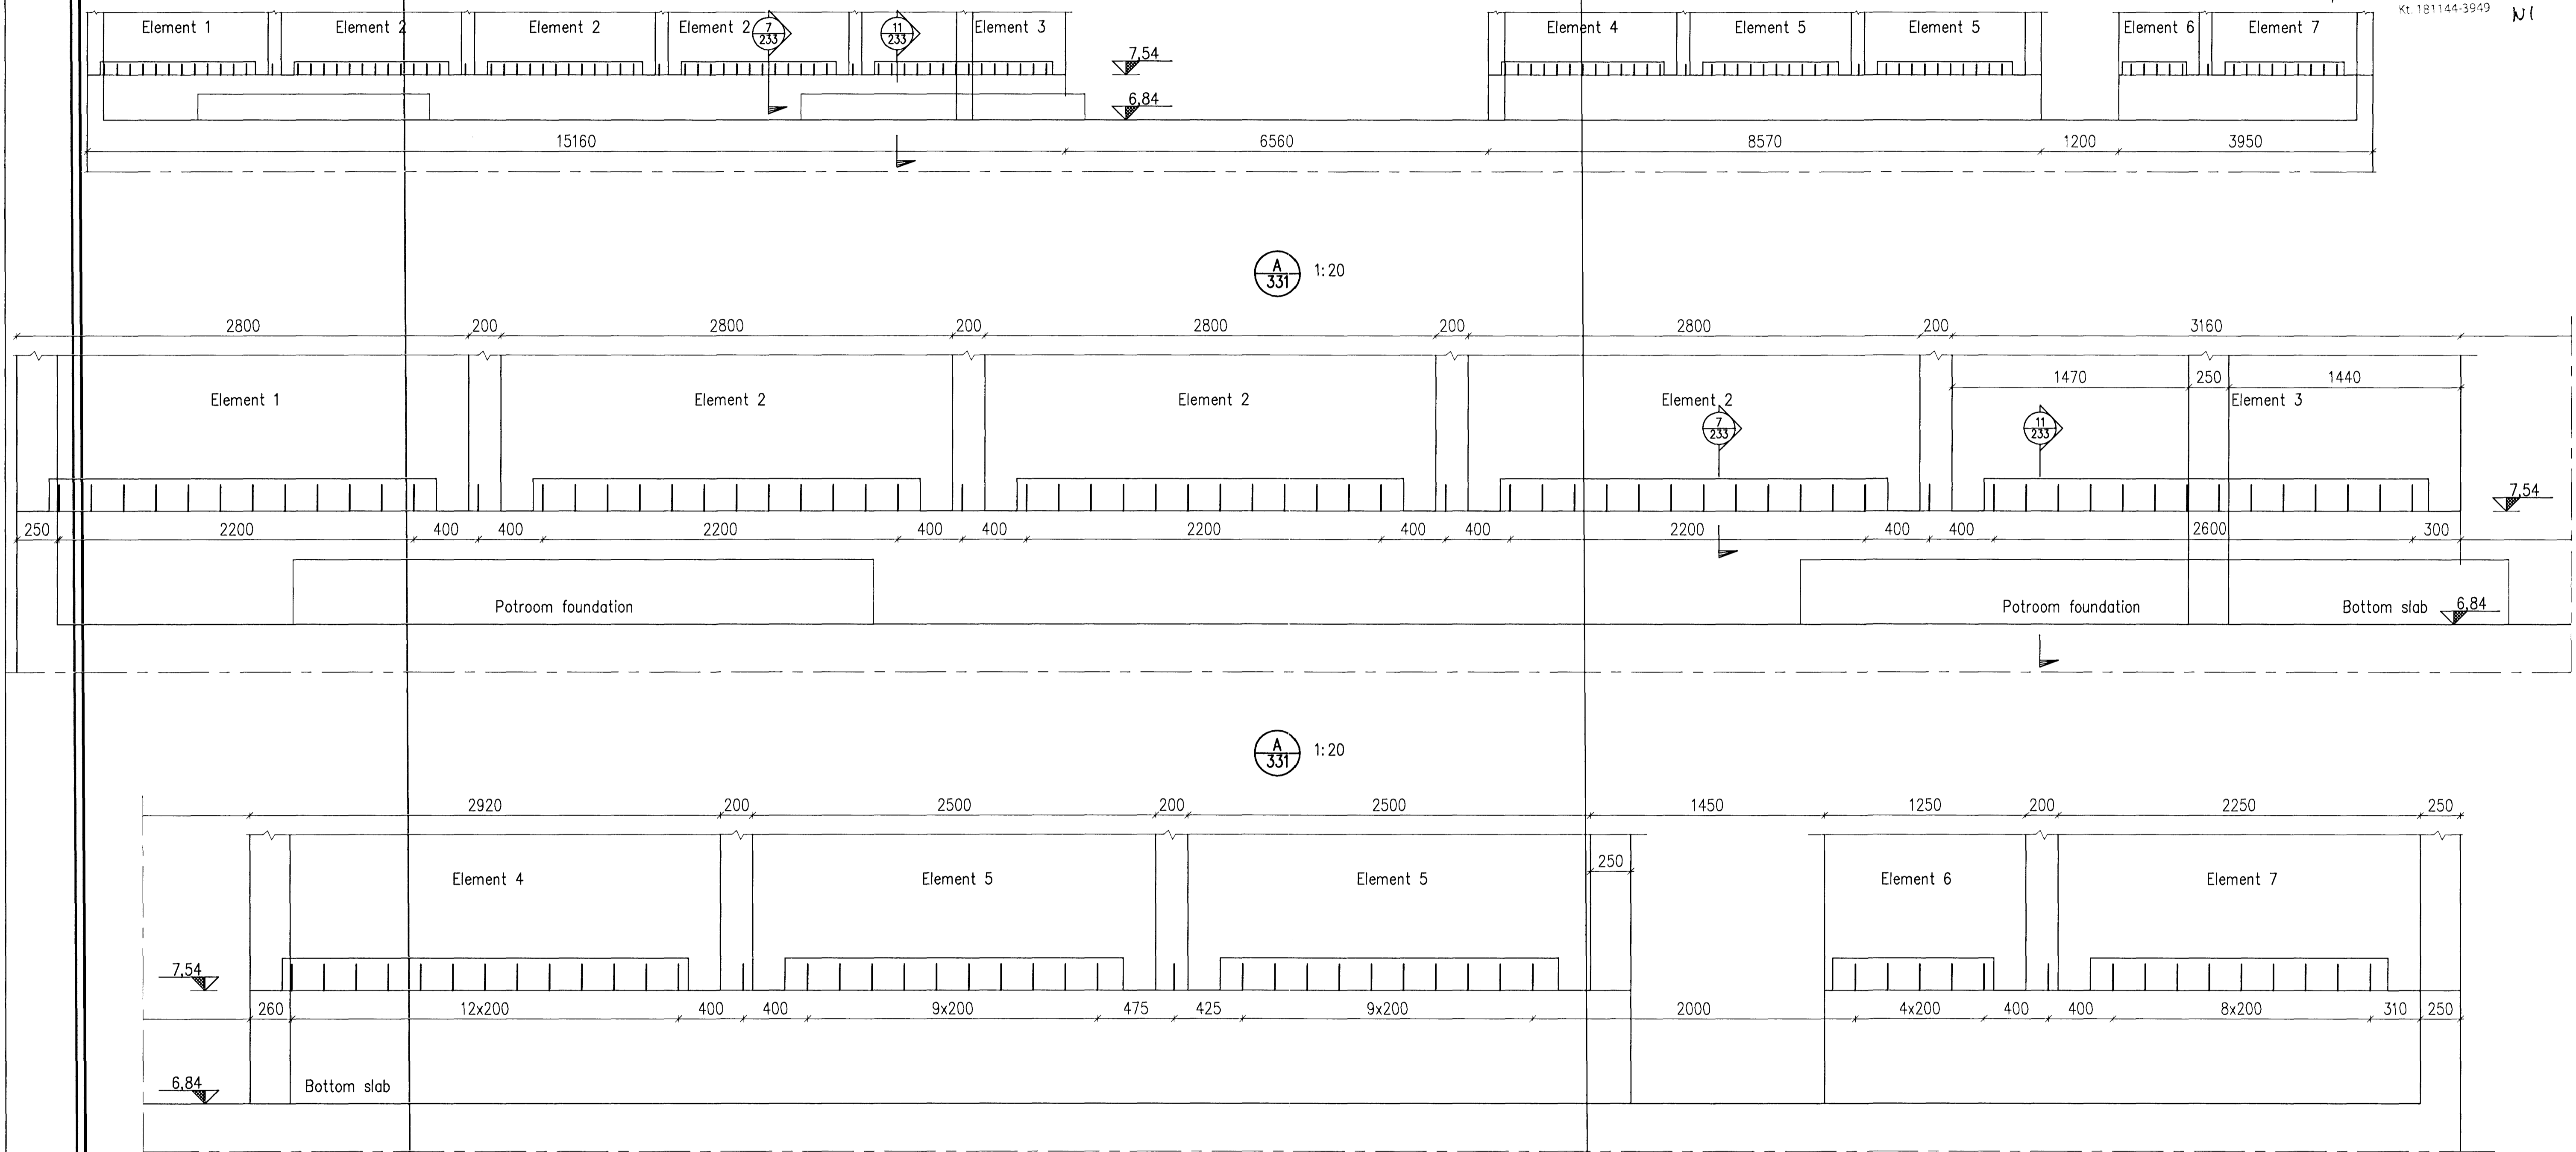

Location of stirrups in wall fundament connecting precast elements.

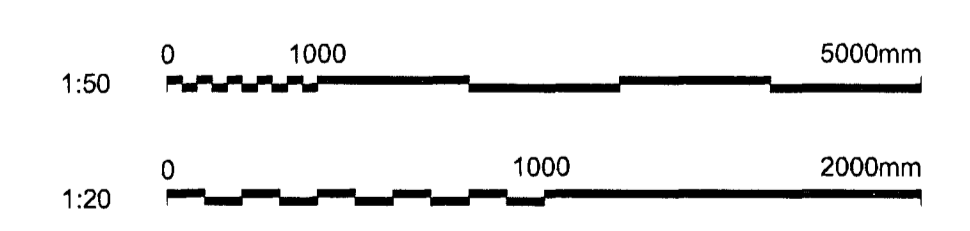

Skýringar:
 Legend:
 Stirrups details see drawing 272.
 All dimensions shall be checked on site.

2	Record drawing	2012.09.12	HS	NI	AK	NR
Dwg. nr	Lýsing	Dagsetning	Han./Tm	Yfir	Notk. heim	Notk. heim
Rev. no	Description	Date	Des./Dw	Chk	Suppl. Pl	ISAL. Rel

This drawing is the property of Rio Tinto Alcan Iceland Ltd. and is loaned out for personal use only. It may neither be copied nor made available to others without permission of Rio Tinto Alcan Iceland Ltd. The receiver is liable for any misuse.

Scale: 1:50/20
 Dimensions without tolerances according to ISO 2768-1 medium.

HRV HATCH
 JOINT VENTURE
 ISAL PRODUCTION BRANDS

Dagsetning / Date	2011.03.03	Flokkur nr.:	IPU 410 - RECTIFIER BUILDINGS
Hannað / Designed	HS	Blöð nr.:	A5/S1
Tekni / Drawn	AFV	Kostn.nr.-Cena. / Búg.nr.-Eq.no	4011 13981
Verktaki / Supplier	HRV	AKS	UB11
Tekn.nr.verktaka / Supplier drw.no.	IDP-410-CA-015-271	Tekn.nr. ISAL / Drw.no. of ISAL	251271
Samþykkt / Approved	NI	Breyt./Rev.	A
Hluti af: / Part of:		ISAL Yfirfarið og skráð, dags / ISAL Checked, date	ISAL Sambýkkt, dags / ISAL Approval, date