


Samþykkt þann


01 OCT 2012

Byggingafræðingur / Höfnafræðingur
Fh. Sigurður Steinar Jónsson

Nick Indrisarov
Kt. 181144-3949 NI

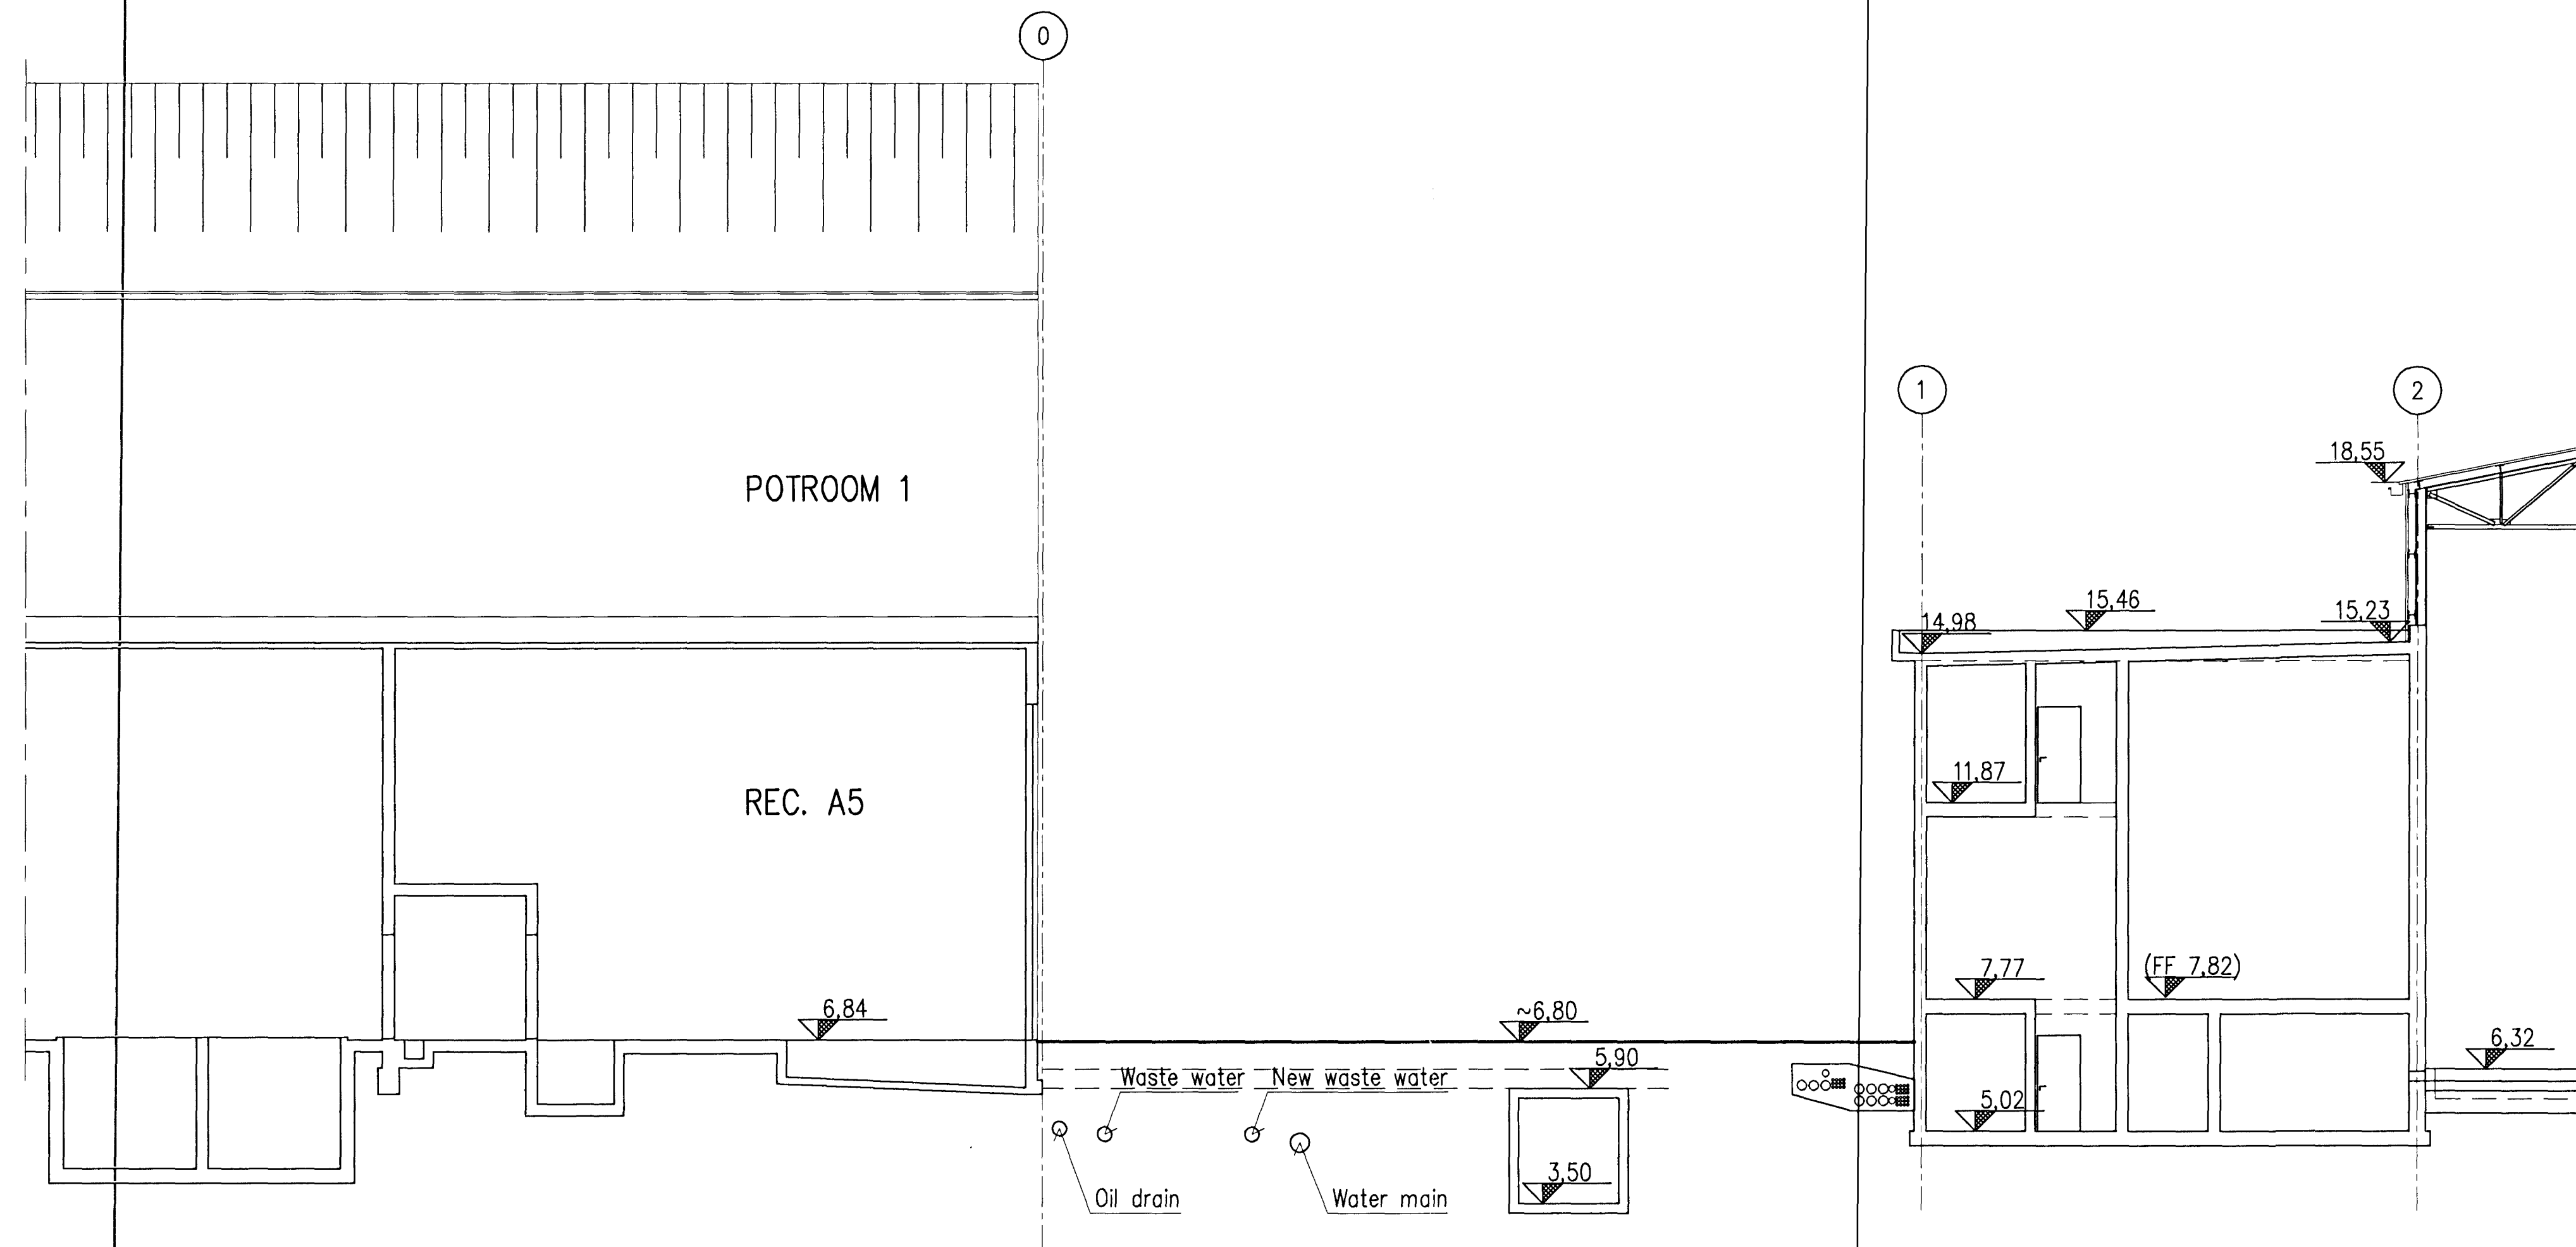

B
256

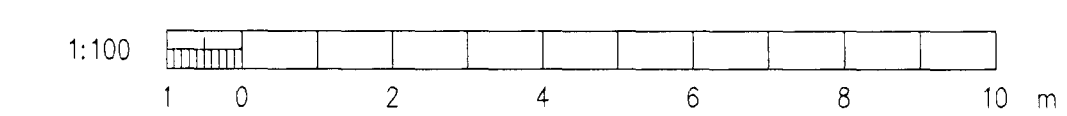

Skýringar Legend										This drawing is the property of Rio Tinto Alcan Iceland Ltd. and handed out for personal use only. It may neither be copied nor made available to others without permission of Rio Tinto Alcan Iceland Ltd. The receiver is liable for any misuse. Scale: 1:100 Dimensions without tolerances according to ISO 2768-1 medium.		Dagsetning / Date: 2009.09.01 Hannað / Designed: NI Teikn / Drawn: AFV		IPU 410 - SUBSTATION EMBEDDED CONDUITS AND MANHOLES SECTION B		Blöð nr.: 4011	Næsta blinn.: 01188
													Verktaki / Supplier: HRV Tekn.nr. verktaka / Supplier drw.no: IDP-410-CA-015-258 Samþykkt / Approved: NI Yfirlit / Checked: NI	Tegelteikningar / Dwg. type: UB01	ISAL Alcan Iceland Ltd Stafráttverk IS-222 Hálfarþórur Ísland	ISAL / Drw.no. of ISAL: 251265 Breyt./Rev.: A	ISAL Yfirfarð og skrð. dags / ISAL Checked, date ISAL Samþykkt. dags / ISAL Approval, date
	13	Record drawing	2012.09.12	NI	NI	NI	NI	NI	NI								
	Útg. nr. Rev. no.	Lýsing Description	Dagsetning Date	Höf./Bn Des./Dra	Yfirlit Chk.	Nauk heim Supvl. Ref.	Nauk heim ISAL. Ref.										