


- Bundles of pipes 1 - 4 : ○○○○
- Bundles of pipes 5 : ○○○○
- Bundles of pipes 6 - 9 : ○○○○
- NOTES:
 ○ Pipe ø200
 ○ Pipe ø140
 ○ Pipe ø110
 ○ Pipe ø63
 — Pipe ø63
- Concrete: C30/37;XF3-09

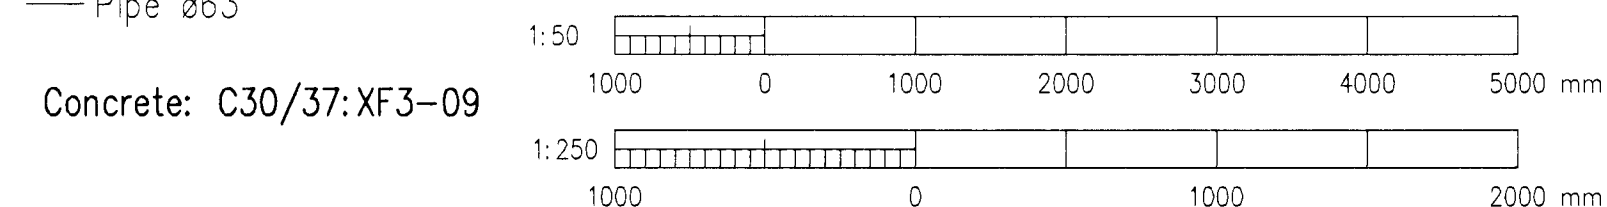

- Skýringar Legend:
- ① Existing cables pipe to be moved and re-installed to new location
 - ② Joint point new/existing pipe
 - ③ See ISAL drw. 186.511 outdoor electrical cableways
 - ④ Existing DP, BR2E See ISAL drw 186511
 - ⑤ New 7xø110mm PEH
 - ⑥ New 6xø110mm PEH
- Cable conduits added.
 See DRW. IDP-410-CA-015-031

23	Record drawing		2012.09.12	NI	NI	BA	REB
Stig nr	Rev no	Lýsing	Dagsetning	Man/Fin	Yfir	Notk	Notk
		Description	Date	Des/Drw	Chk	name	name
						Suppl	ISAL
						Rel	Rel

This drawing is the property of Rio Tinto Alcan Iceland Ltd. and handed out for personal use only. It may neither be copied nor made available to others without permission of Rio Tinto Alcan Iceland Ltd. The receiver is liable for any misuse.

Scale: 1:50, 250

Dimensions without tolerances according to ISO 2768-1 medium.

HRV HATCH
 ISAL PRODUCTION UPGRADE

Dagsetning / Date: 2008.10.01

Hönnuð / Designed: NI

Tekni / Drawn: AFV

Verktaki / Supplier: HRV

Tekni-ervertaka / Supplier drw.no: IDP-410-CA-015-256

Sambærkt / Approved: NI

Hluti af / Part of:

IPU410-POWER AREA
EMBEDDED CONDUITS AND MANHOLES

Flakkur nr.: 4011

Bláð nr.: 01188

Nasta blnr.:

Tag tekið / Drawn type: LAYOUT AND SECTIONS

AKS UB01

Rio Tinto Alcan

ISAL Alcan Iceland Ltd. Straumsvík IS-222 Hafnarfordur Ísland

Tekni nr. ISAL / Drw.no. of ISAL: 251263

Breyt./Rev.: A

ISAL Yfirfarið og skrifað, dags / ISAL Checked, date

ISAL Samþykkt, dags / ISAL Approval, date