
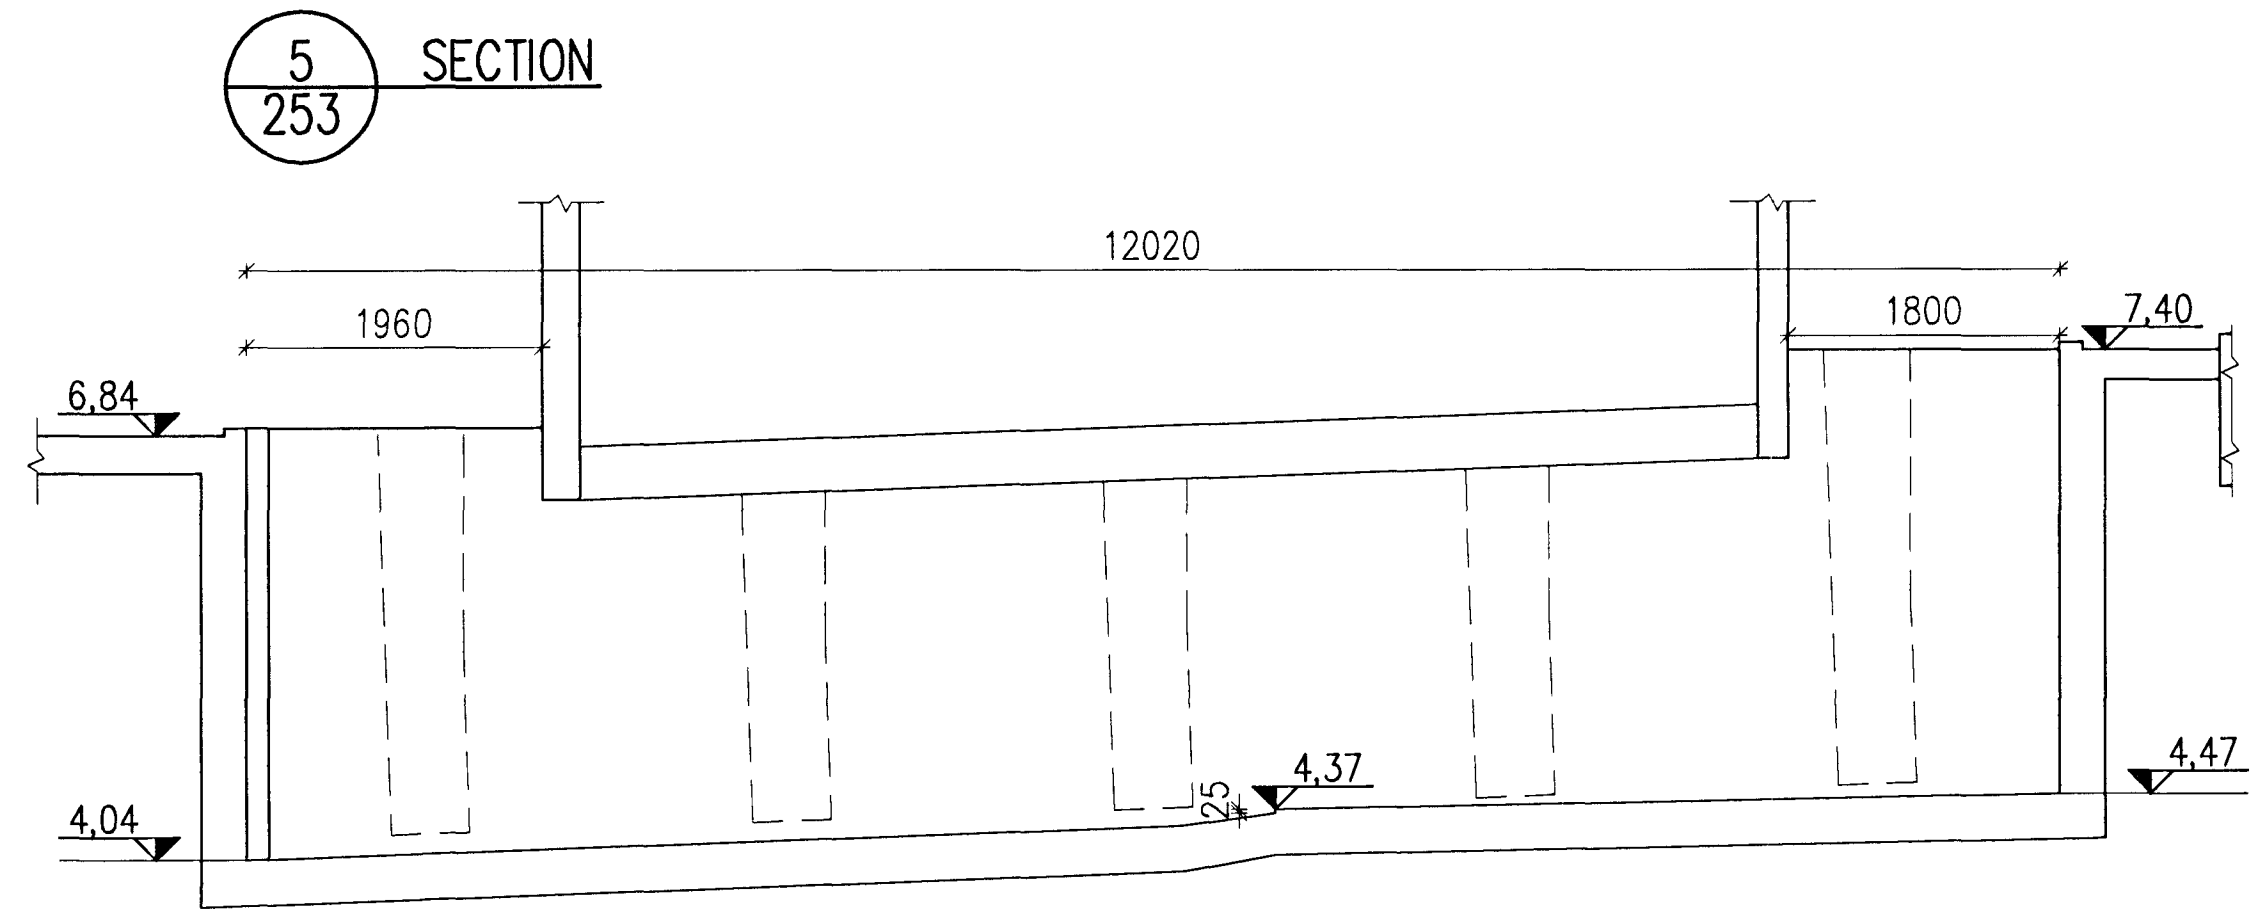


Samþykkt þann
 01 OCT 2012
 Byggingaálfurinn (Hafþórsson)
 F.h. Sigurður Steinar Jónsson

Nick Indriðsson
 Kt. 181144-3949 NI

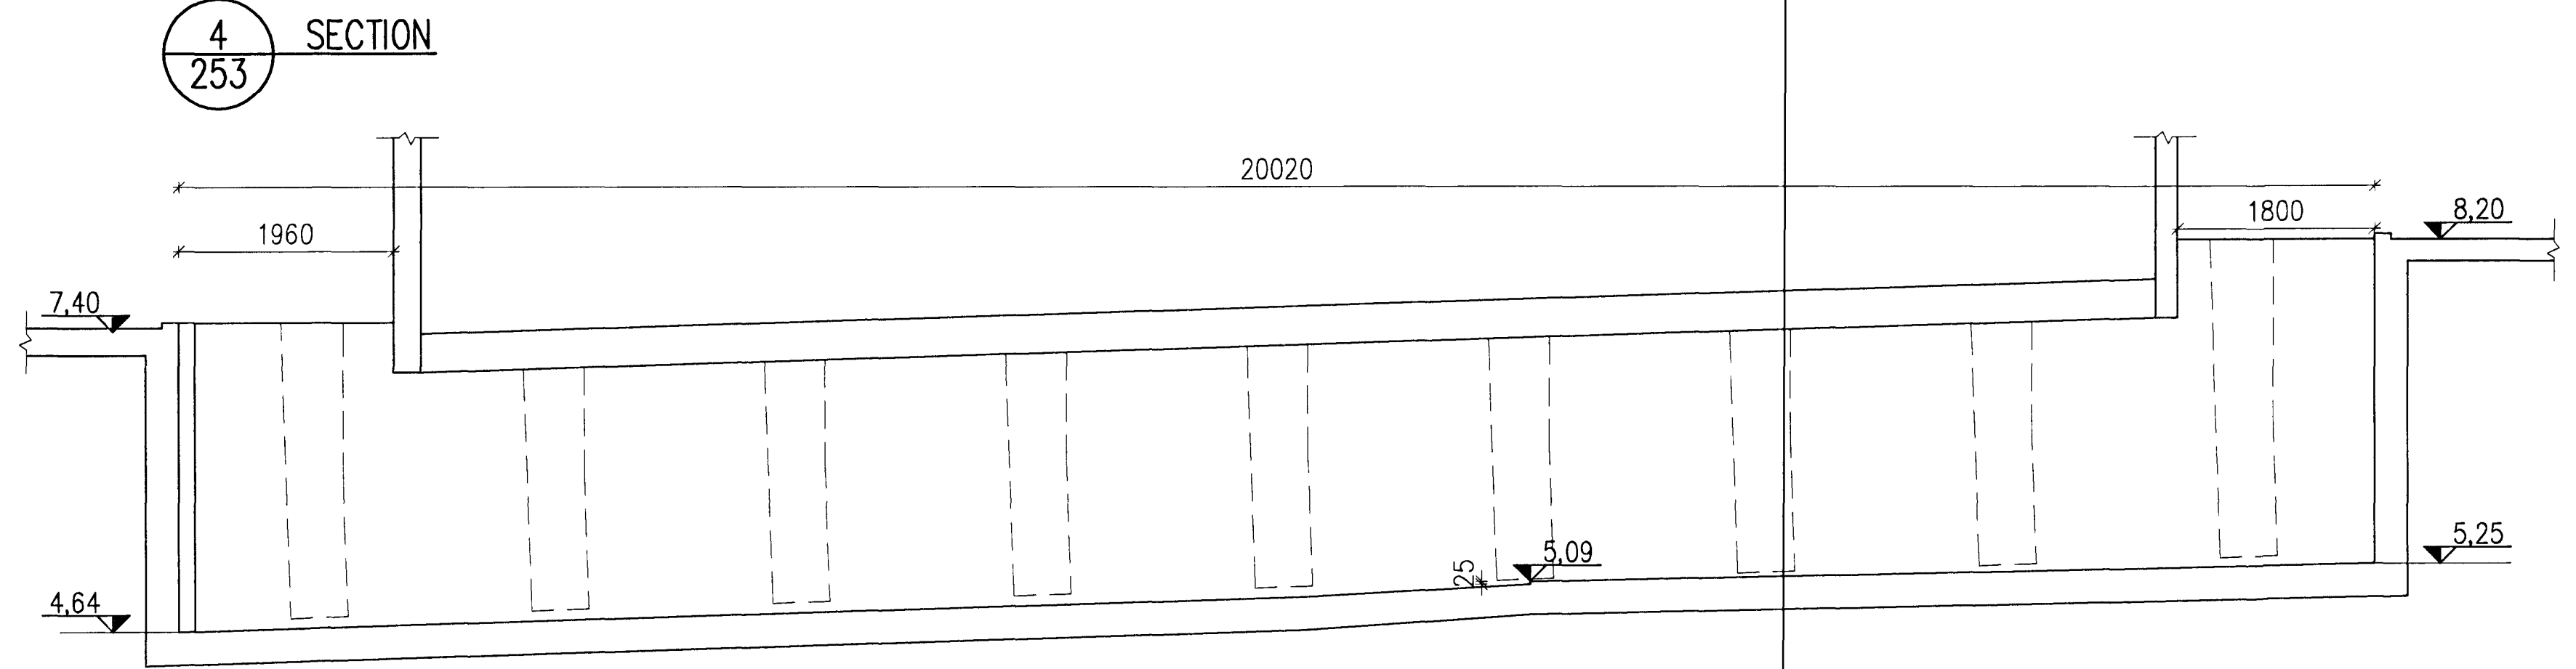

Skýringar
 Legend:

Útg. nr. Rev. no.	Lýsing Description	Dagsetning Date	Höf./Dín Des./Drw.	Yfir Ckd.	Notk. heim Suppl. Ref.	Notk. heim ISAL Ref.
1	Record drawing	2012.09.12	HS/AFV	NI	NS	NS

This drawing is the property of Rio Tinto Alcan Iceland Ltd. and handed out for personal use only. It may neither be copied nor made available to others without permission of Rio Tinto Alcan Iceland Ltd. The receiver is liable for any misuse.

Skjáfr.
 Formát: A1 Scale: 1:50
 Dimensions without tolerances according to ISO 2768-1 medium.



Dagsetning / Date 2012.09.12	Hannað / Designed NI	Tekni / Drawn AFV
Verktaki / Supplier HRV	Tekn.númer / Supplier drw.no. IDP-410-CA-015-255	Samþykkt / Approved NI
Flúti af: / Part of:	Yfir / Chkd NI	

IPU 410-RECTIFIER BUILDINGS A5/S1 AND B5/S2 SECTIONS		Flakkur nr.: 4011	Blað nr.: 16961	Næsta bl. nr.: 16961
BUSBAR TUNNELS		AKS UB21		
RioTintoAlcan		ISAL Tehn.nr. / Drw.no. of ISAL 251262	Breyt./Rev. A	
ISAL Yfirráð og skráð, dags / ISAL Checked, date		ISAL Samþykkt, dags / ISAL Approved, date		