


Samþykkt þann
 01 OCT 2012
 Byggingafráttirinn / Hólar
 F.h. Sigurður Steinar Jónsson

Níels Indriðason
 Kt. 181144-3949
 NI

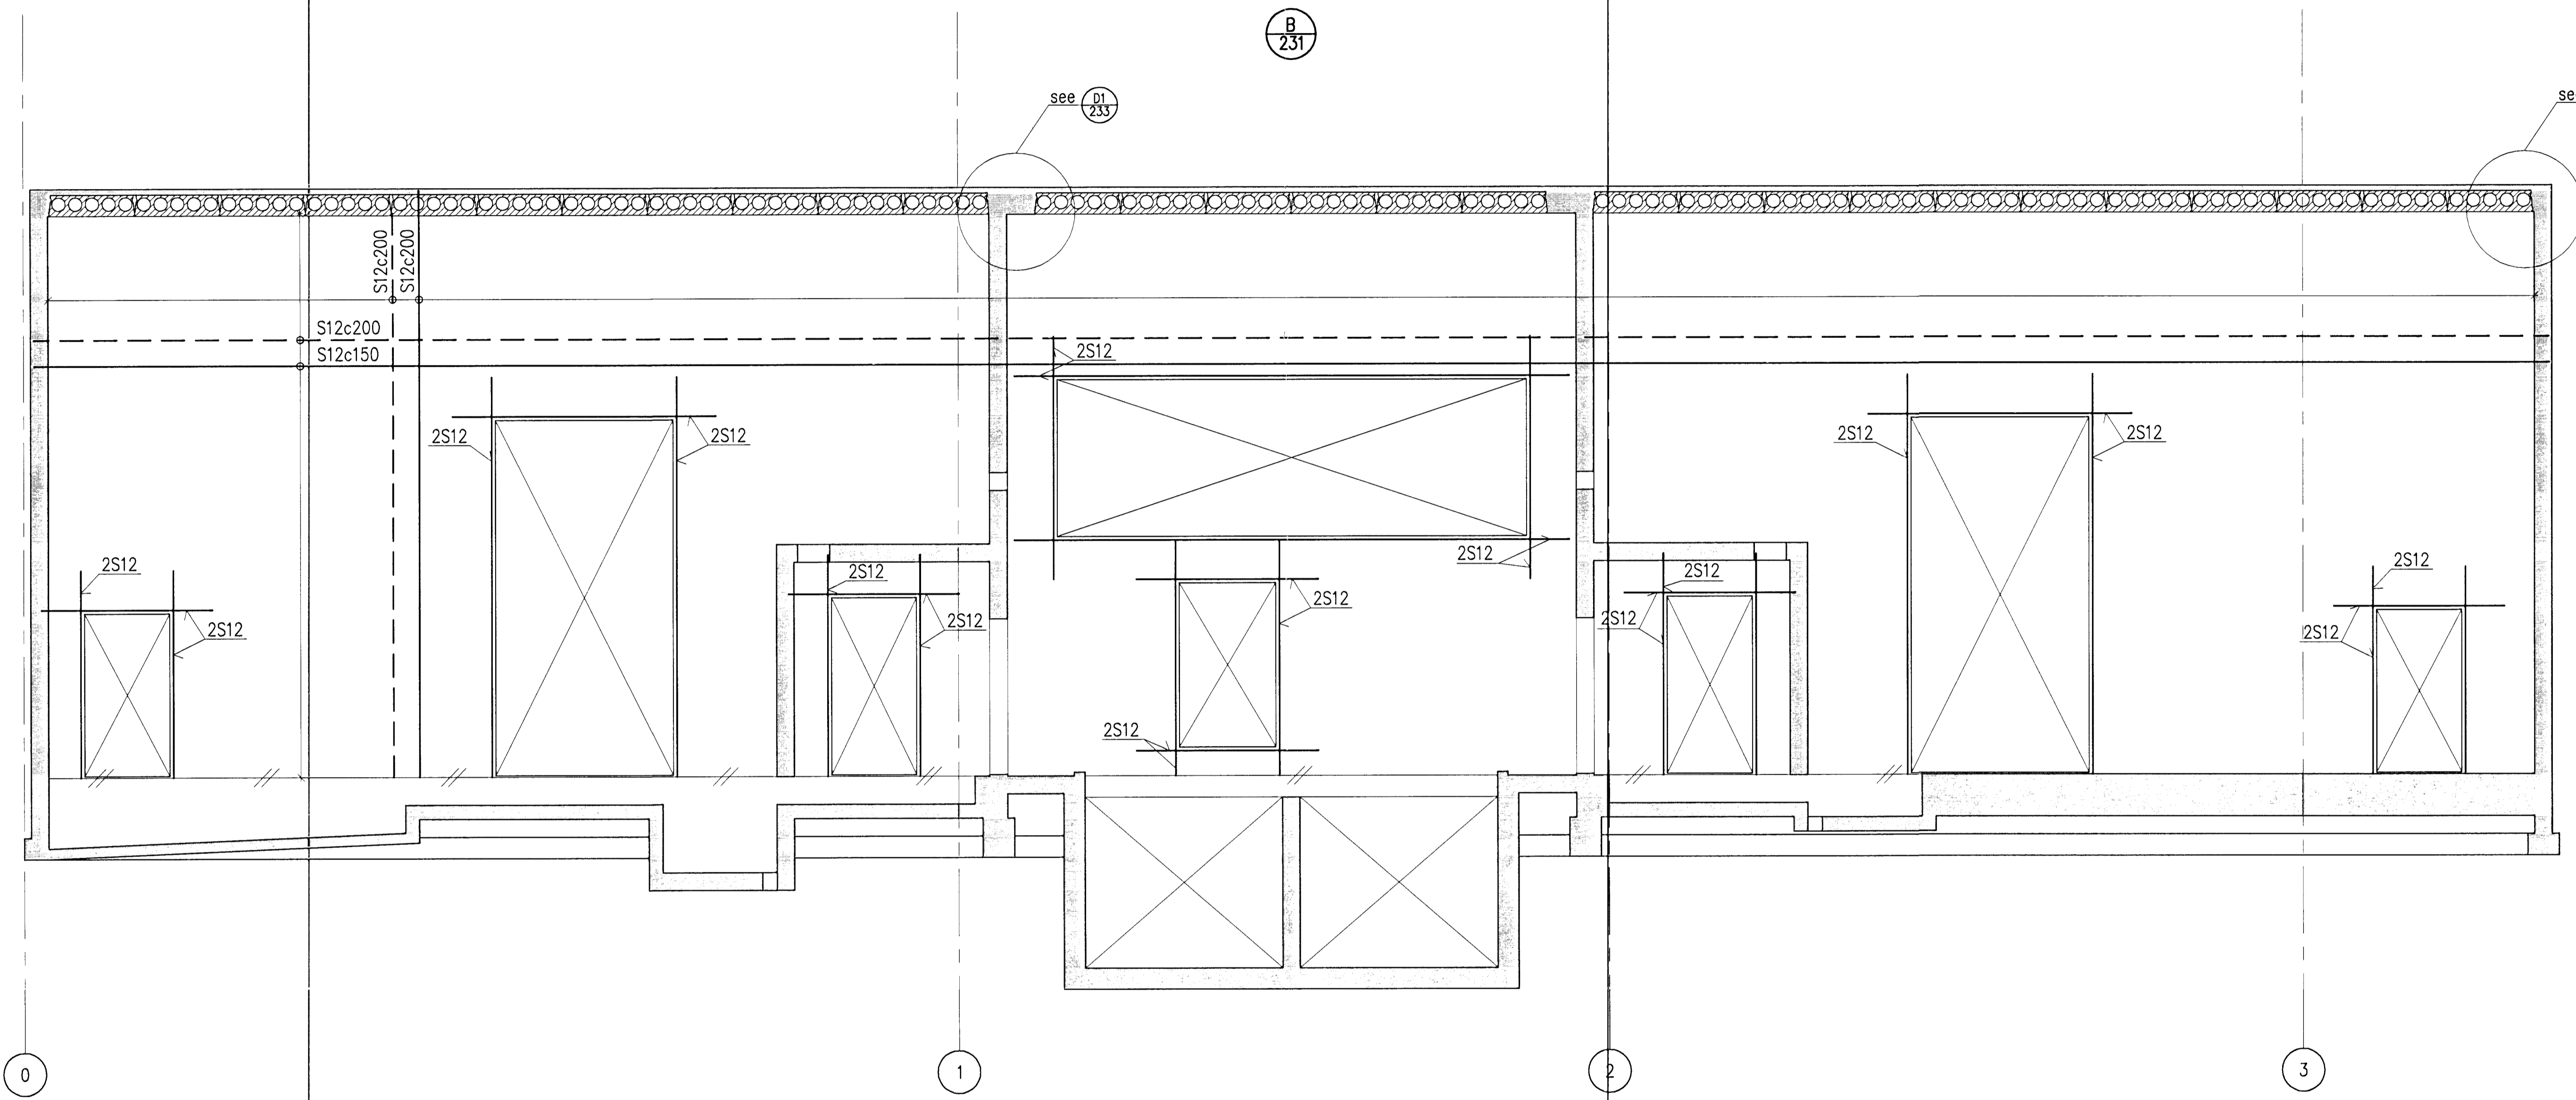

Skýringar: Legend:						This drawing is the property of Rio Tinto Alcan Iceland Ltd and is handed out for personal use only. It may neither be copied nor made available to others without permission of Rio Tinto Alcan Iceland Ltd. The receiver is liable for any misuse. Scale: 1:50 Dimensions without tolerances according to ISO 2768-1 medium.		Dagsetting / Date 2008.10.01		IPU410-RECTIFIER BUILDINGS A5/S1 WALLS SIDE VIEW 2/3		Flokkur nr.:	Bláð nr.:	Nasta bl. nr.:
								Hönnuð / Designed HS	Teikn / Drawn LDB	Kostn.nr.-Cena. / Bláð nr.-Eq.no 4011 13981				
							Verktaki / Supplier HRV	Teg.teikningar / Dwg. type REINFORCEMENT		ISAL RioTintoAlcan Alcan Iceland Ltd Straumavík IS-222 Hafnarfordur Iceland		ISAL 251250	ISAL / Drw.no. of ISAL UB11	Breyt./Rev. A
							Hlut. of. / Part of:		ISAL Yfirlið og skráð, dags / ISAL Checked, date		ISAL Samþykkt, dags / ISAL Approved, date			
17	Record drawing	2012.09.12	HS	NI	BS	MS								
Fig. nr. Rev. no.	Lýsing Description	Dagsetning Date	Hönn./Dn. Des./Dwn.	Yfirlið Ckd.	Notk. heim. Suppl. Rel.	Notk. heim. ISAL. Rel.								