


Sambýkkt þann
 01 OCT 2012
 Bryggjufulltrúiinn / Hafið
 Fh. Sigurður Steinar Jónsson


Níels Indriðason
 Kt. 181144-3949 NI

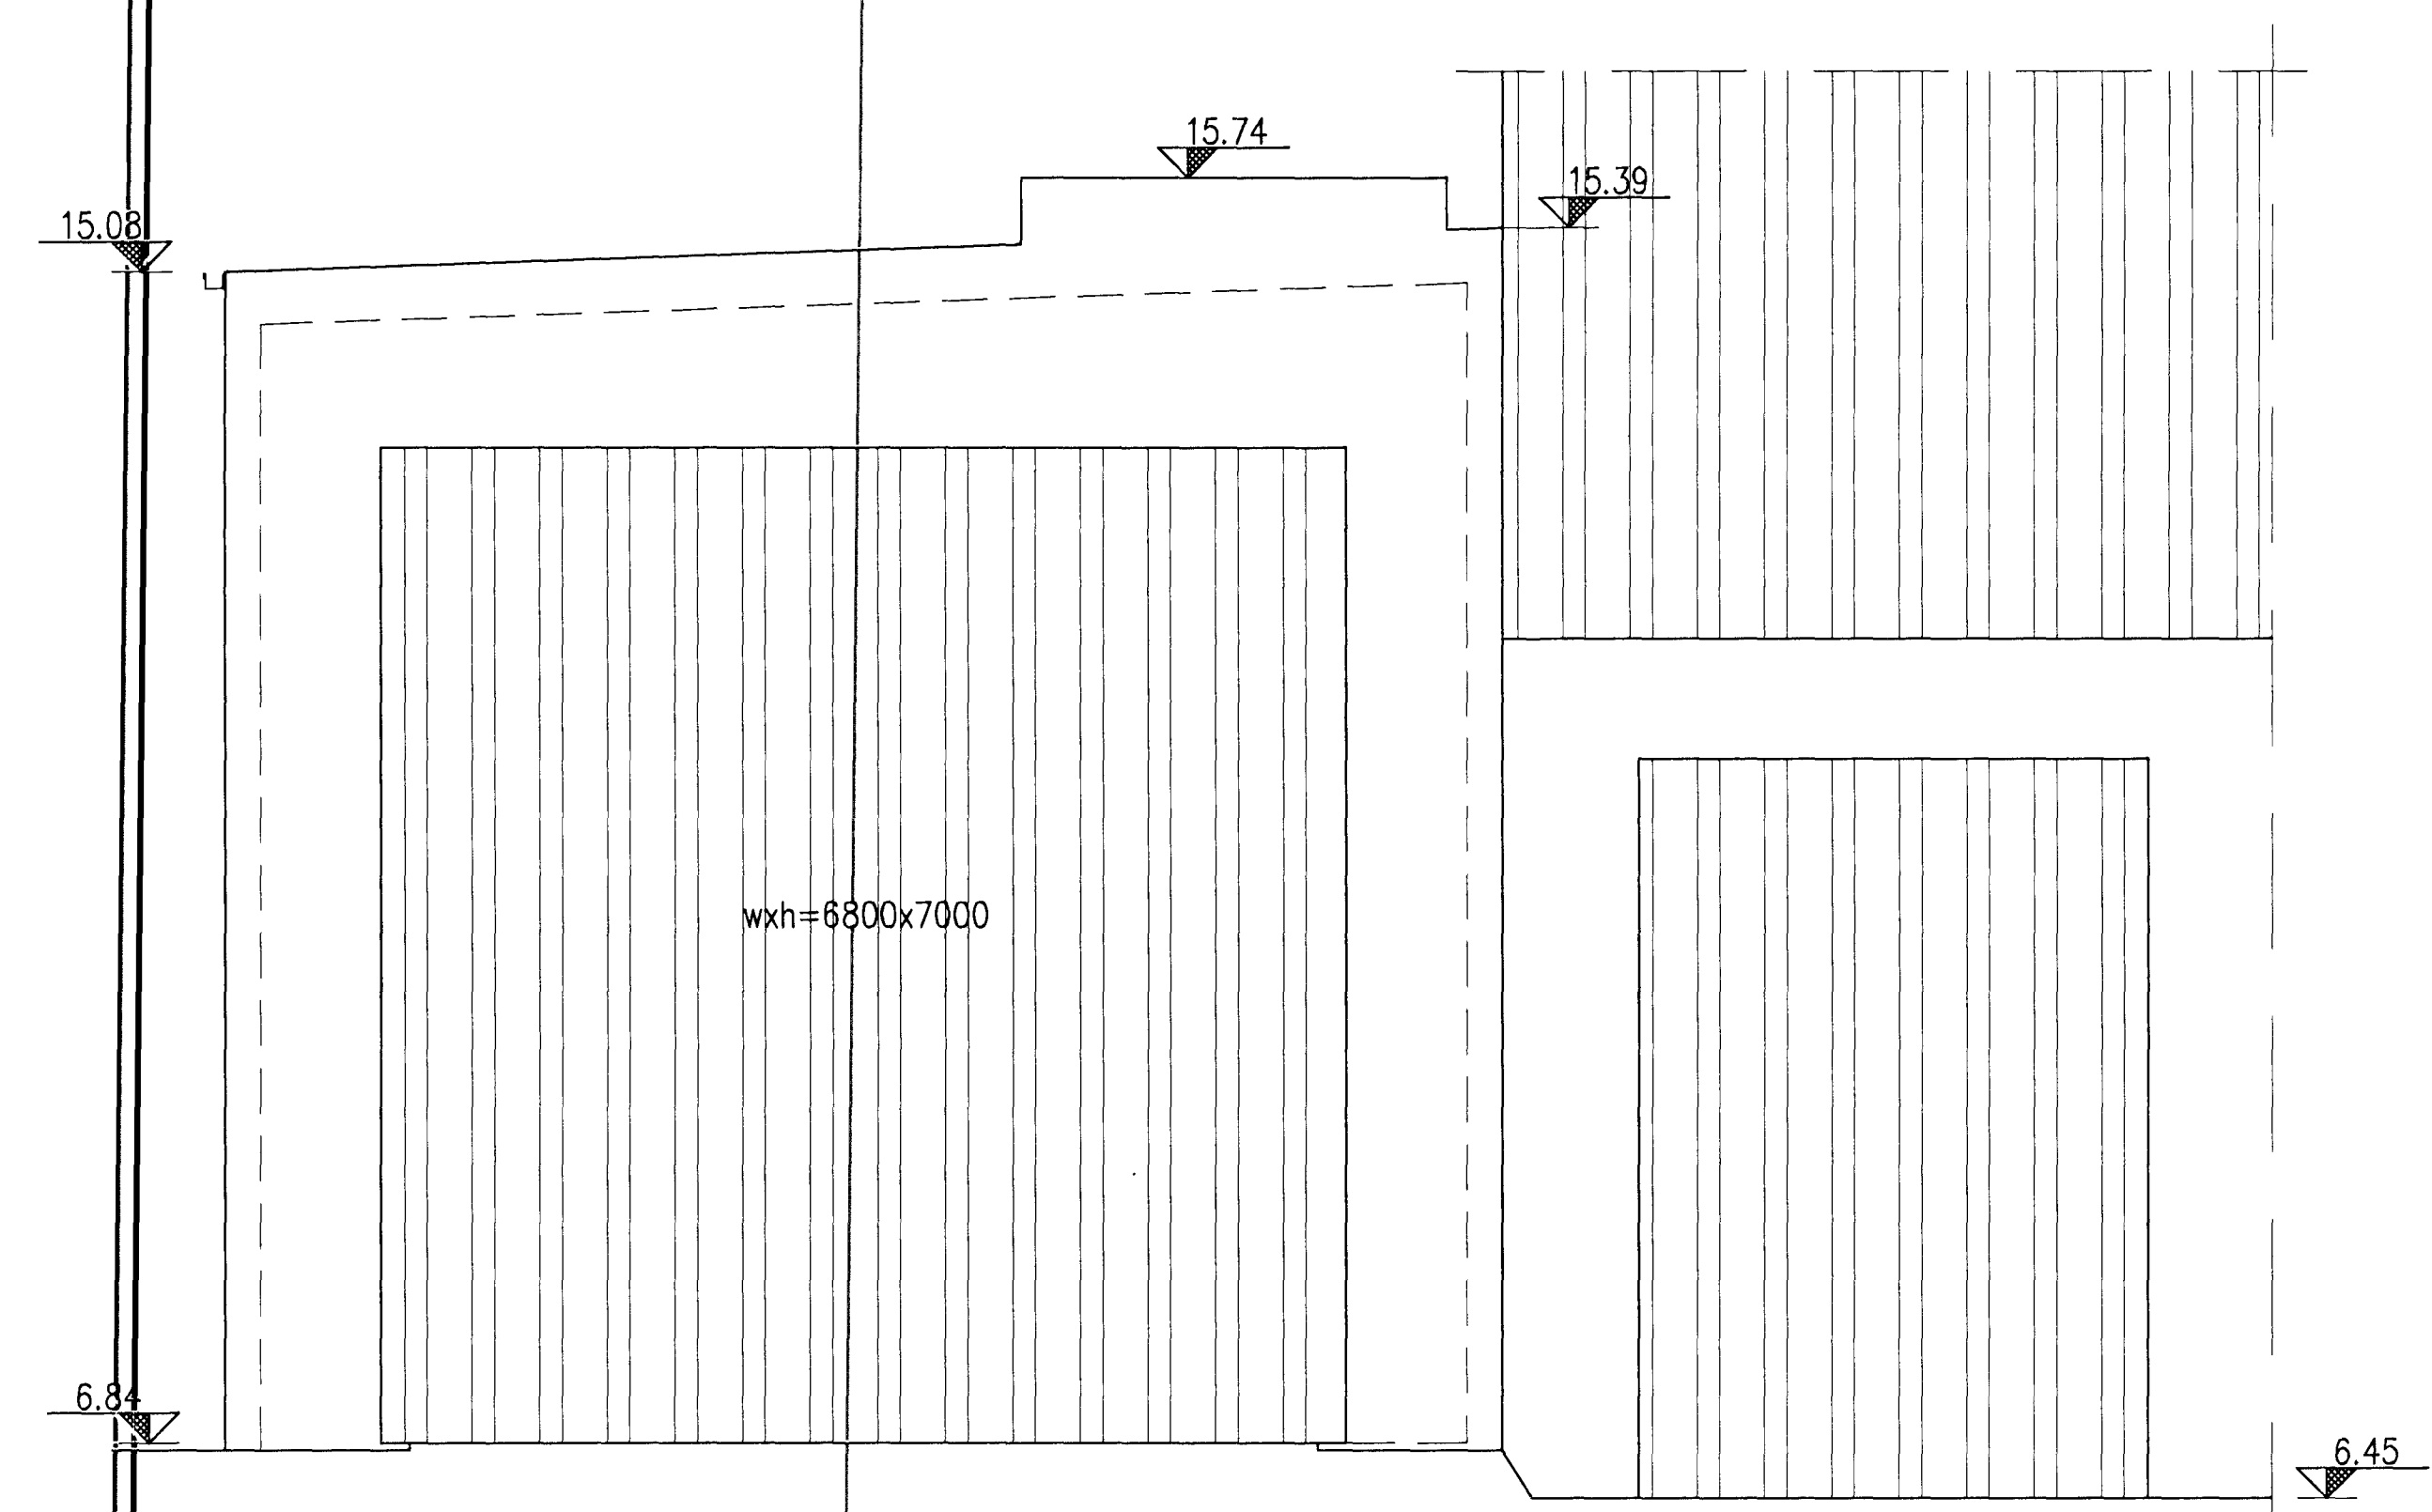



RECTIFIER A5+S1

RECTIFIER A4
 POTROOM 1

SIDE VIEW 1:50

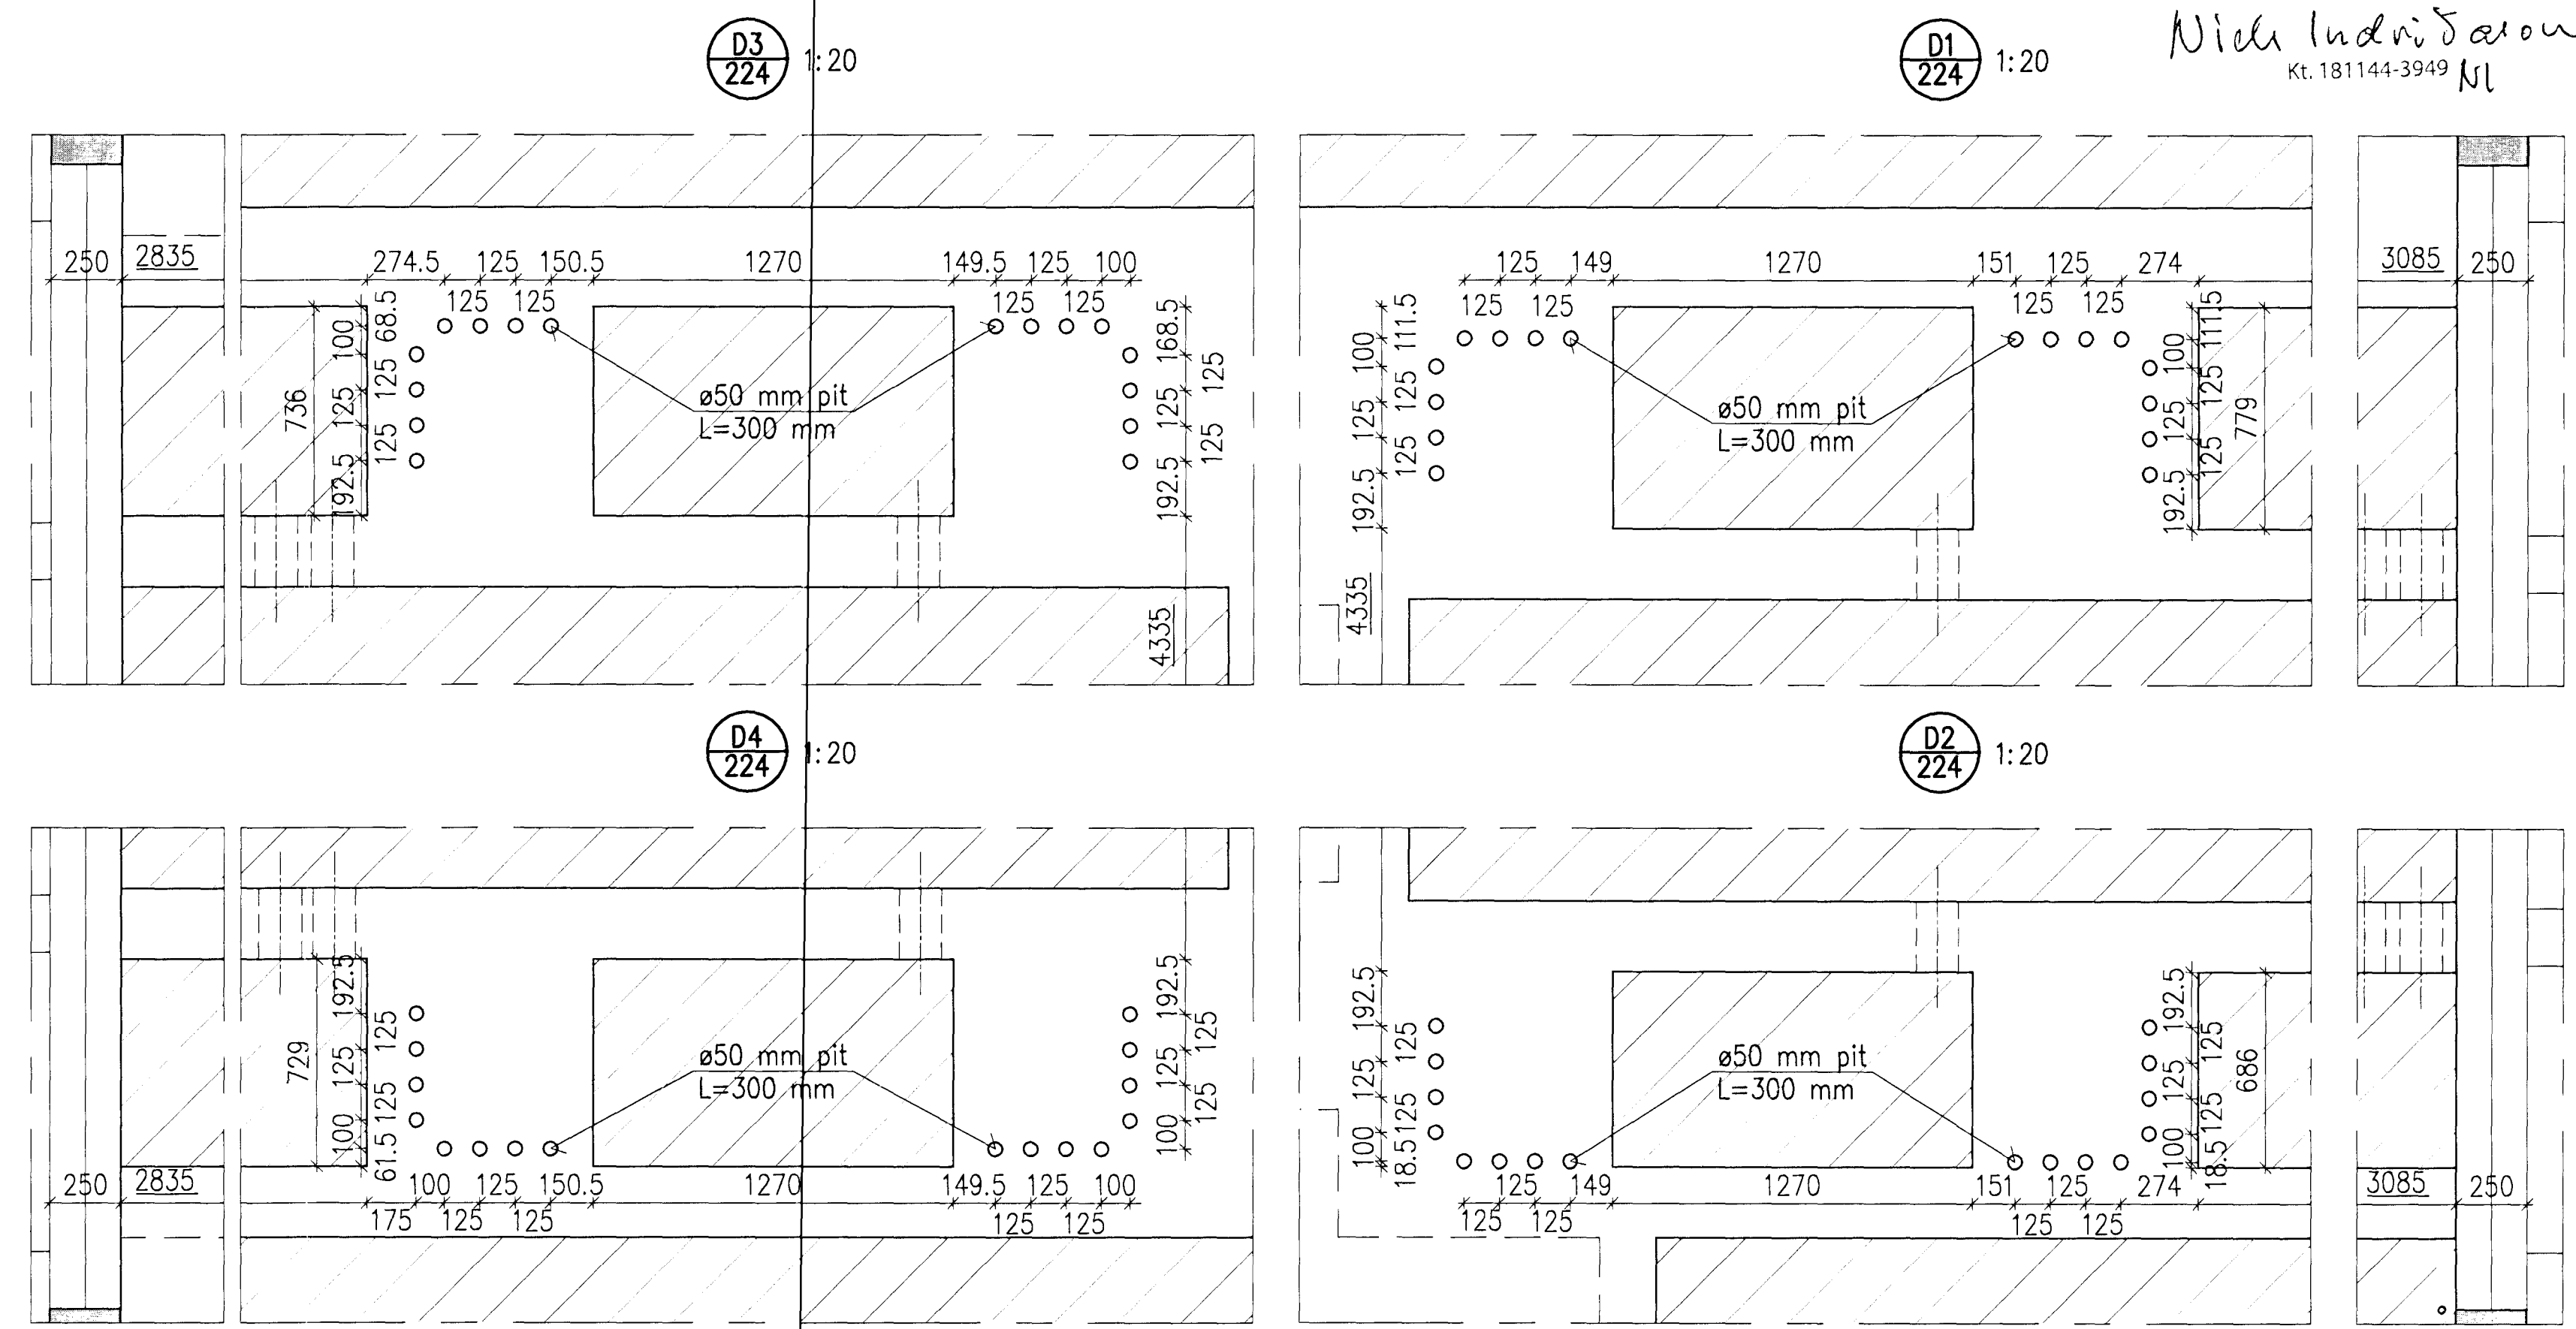

Dimensions of holes must be taken with great precision. Holes can be made with PEH pipes who will be removed/drilled out afterwards.

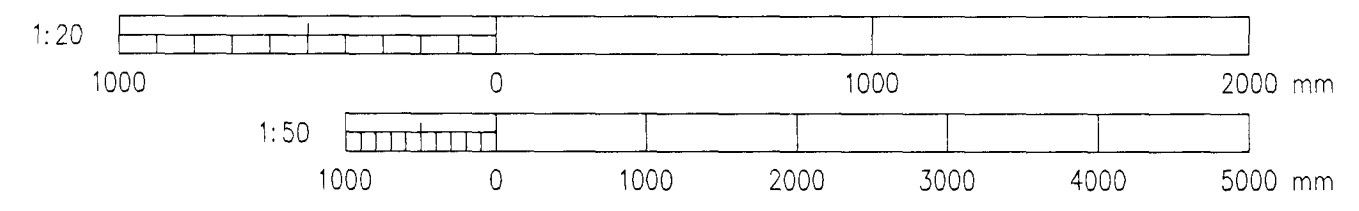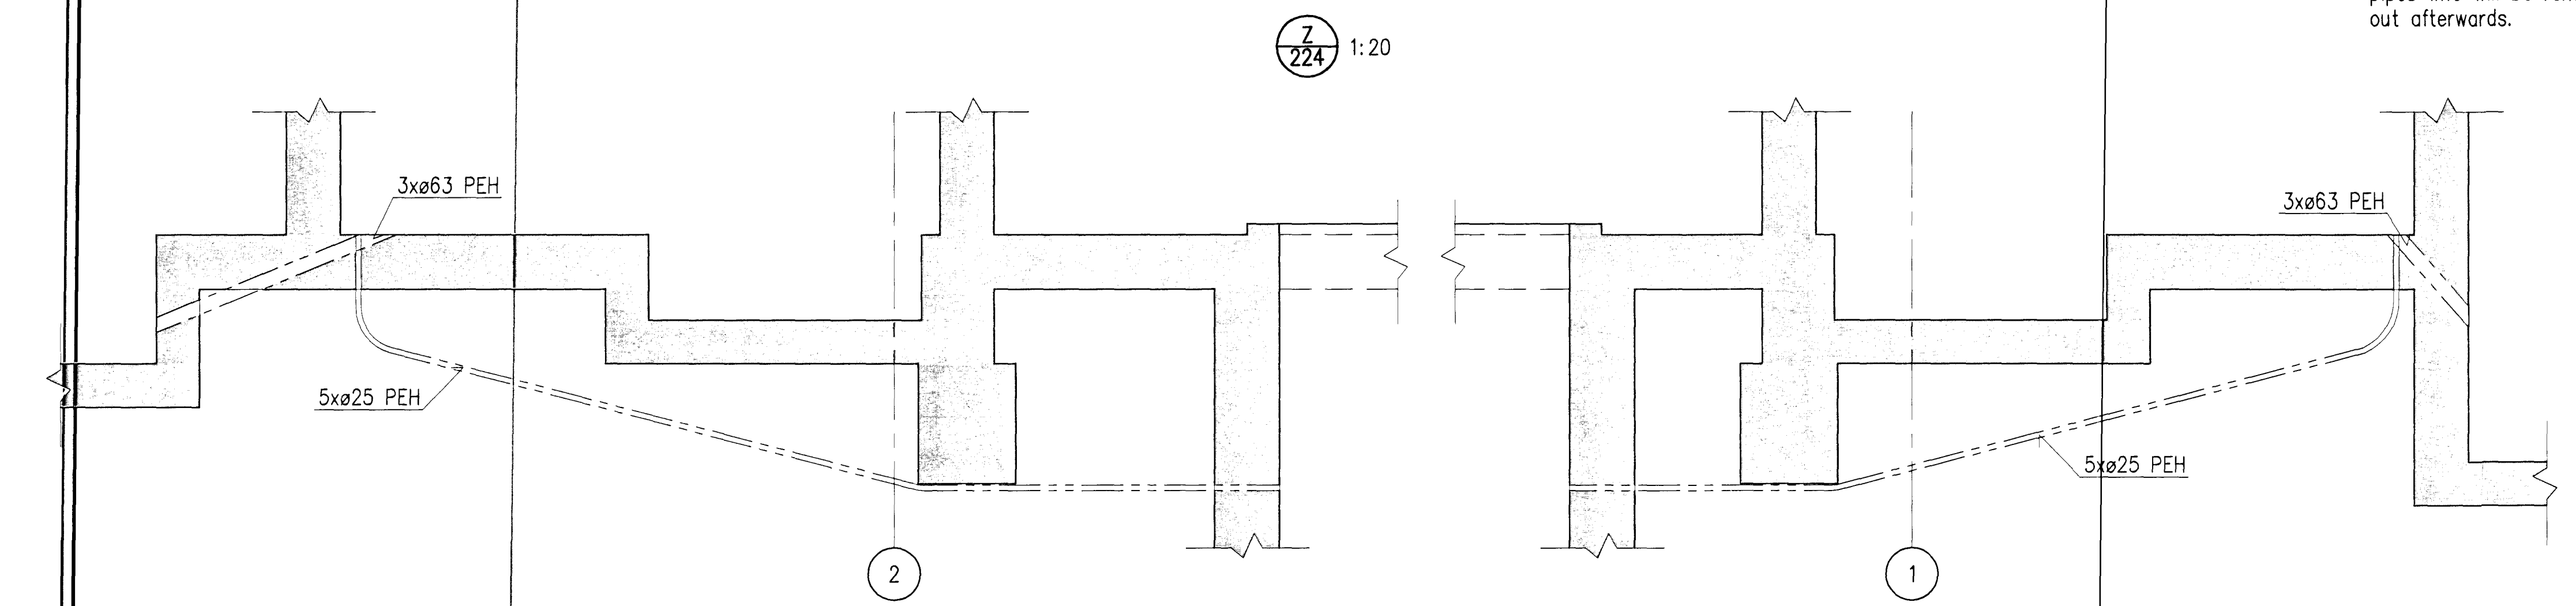

Skýringar: Legenda	<table border="1"> <tr> <td>16</td> <td>Record drawing</td> <td>2012.09.12</td> <td>HS</td> <td>NI</td> <td>MS</td> <td>MS</td> </tr> <tr> <td>Fig. nr</td> <td>Description</td> <td>Dagsetning</td> <td>Des./Drw</td> <td>Yfir</td> <td>Notk. heim</td> <td>Notk. heim</td> </tr> <tr> <td>Rev. no.</td> <td></td> <td>Date</td> <td></td> <td>Chk</td> <td>Suppl. Rel</td> <td>ISAL Rel</td> </tr> </table>	16	Record drawing	2012.09.12	HS	NI	MS	MS	Fig. nr	Description	Dagsetning	Des./Drw	Yfir	Notk. heim	Notk. heim	Rev. no.		Date		Chk	Suppl. Rel	ISAL Rel	<p>This drawing is the property of Rio Tinto Alcan Iceland Ltd and handed out for personal use only. It may neither be copied nor made available to others without permission of Rio Tinto Alcan Iceland Ltd. The receiver is liable for any misuse.</p> <p>Stærð: A1 Mkv.: Scale: 1:20, 1:50 Dimensions without tolerances according to ISO 2768-1 medium.</p>		Dagsetning / Date 2009.01.22	IPU410-RECTIFIER BUILDINGS A5/S1		Flokkur nr. / Blað nr. / Nasta bl. nr.
		16	Record drawing	2012.09.12	HS	NI	MS	MS																				
Fig. nr	Description	Dagsetning	Des./Drw	Yfir	Notk. heim	Notk. heim																						
Rev. no.		Date		Chk	Suppl. Rel	ISAL Rel																						
Hönnuð / Designed HS	Tekni / Drawn LDB	Kostn. nr. - Eign. / Búna. nr. - Eigna																										
		Tækniráðgjafi / Supplier HRV		SIDE VIEW 2/2, FASTENING FOR TRANSFORMER		4011	13981																					
		Tækniráðgjafi / Approved NI		FORM WORK		AKS UB11																						
		Húti of. / Part of:				ISAL Teknir. ISAL / Drw. no. of ISAL Breyt./Rev. 251242 A																						