



Sambýkkt þann
01 OCT 2012
Byggingafulltrúnaður / Höfundur
Fl. Sigurður Steinarrásson

Níels Indriðason
Kt. 181144-3949
NI

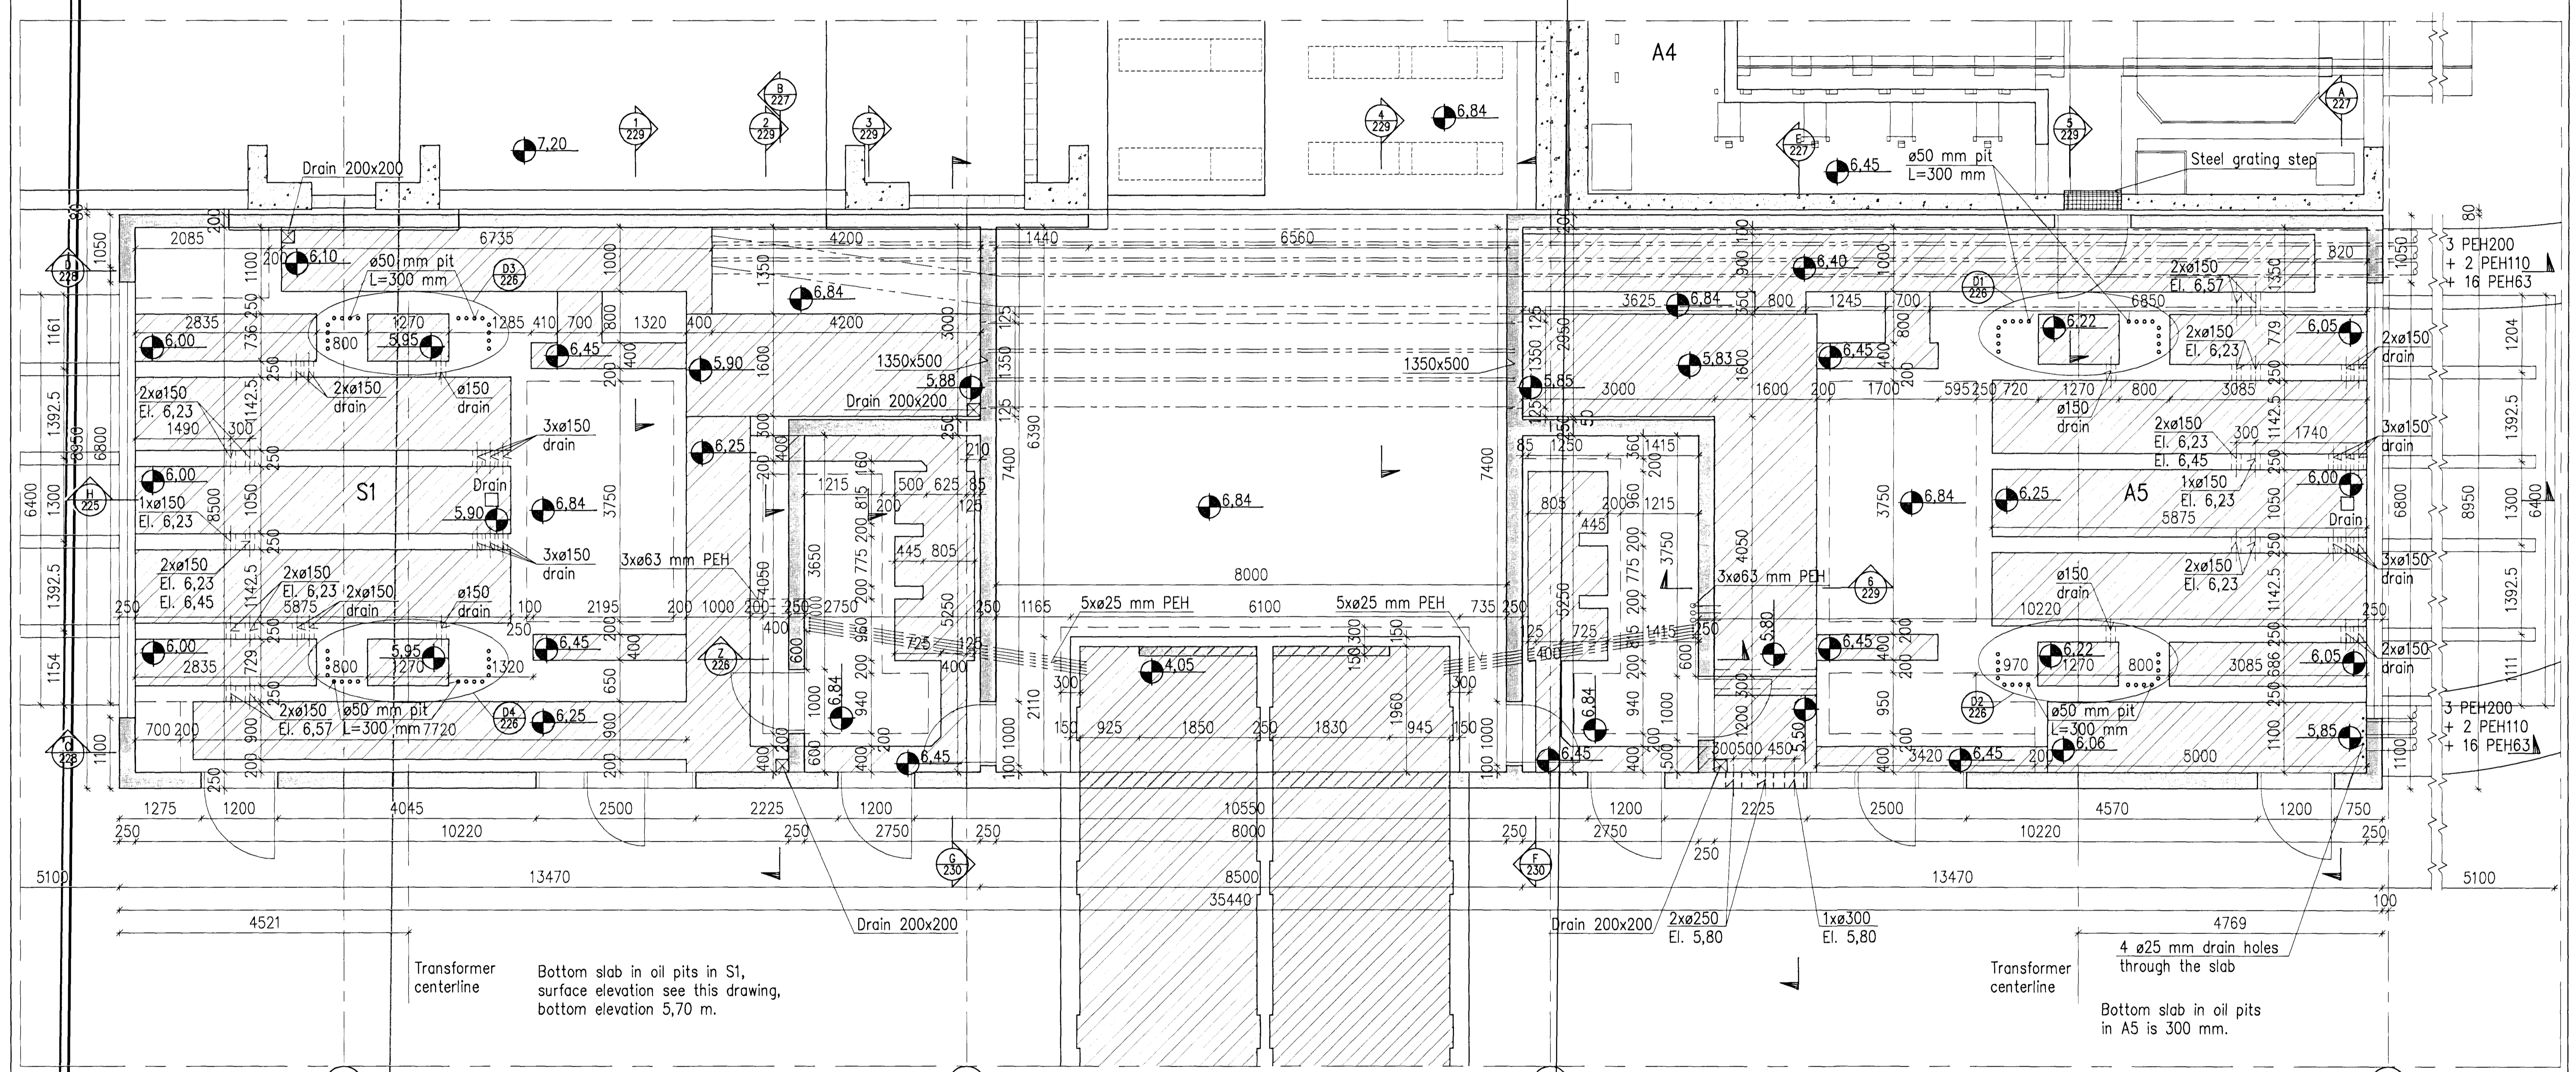

PLAN VIEW 1:50

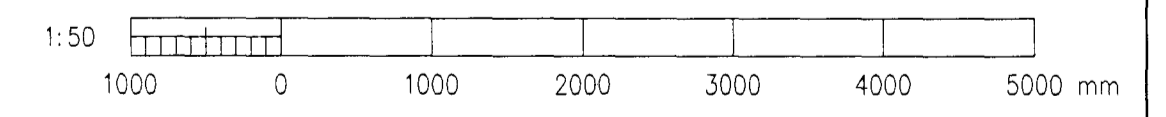

Skýringar: Legend Conduits Elevations of openings for pipes are at center of openings.	This drawing is the property of Rio Tinto Alcan Iceland Ltd. and handed out for personal use only. It may neither be copied nor made available to others without permission of Rio Tinto Alcan Iceland Ltd. The receiver is liable for any misuse.		Dagsetning / Date 2009.01.22		IPU410-RECTIFIER BUILDINGS A5/S1 PLAN VIEW		Fokkur nr.: / Blað nr.: 4011 / 13981			
	19 Record drawing Ljósir / Description 2012.09.12 HS NI 84 155		Formgt: A1 Mkv.: 1:50 Scale: Dimensions without tolerances according to ISO 2768-1 medium.		Verktaki / Supplier HRV HRV		Teg. teikningar / Dwg. type: FORM WORK		AKS UB11	
Rio Tinto Alcan			Tekn. nr. / ISAL / Dwg. no. of ISAL 251240		ISAL Alcan Kollafell Ltd Straumsvík IS-222 Hafnarfordur Ísland		Tekn. nr. / ISAL / Dwg. no. of ISAL 251240		Breyt./Rev. A	