


12031944

Samþykkt þann
 01 OCT 2012
 Byggingafráttir /
 F.h. Sigurður Steinar Jónsson

Níðri Indriðason
 Kt. 181144-3949

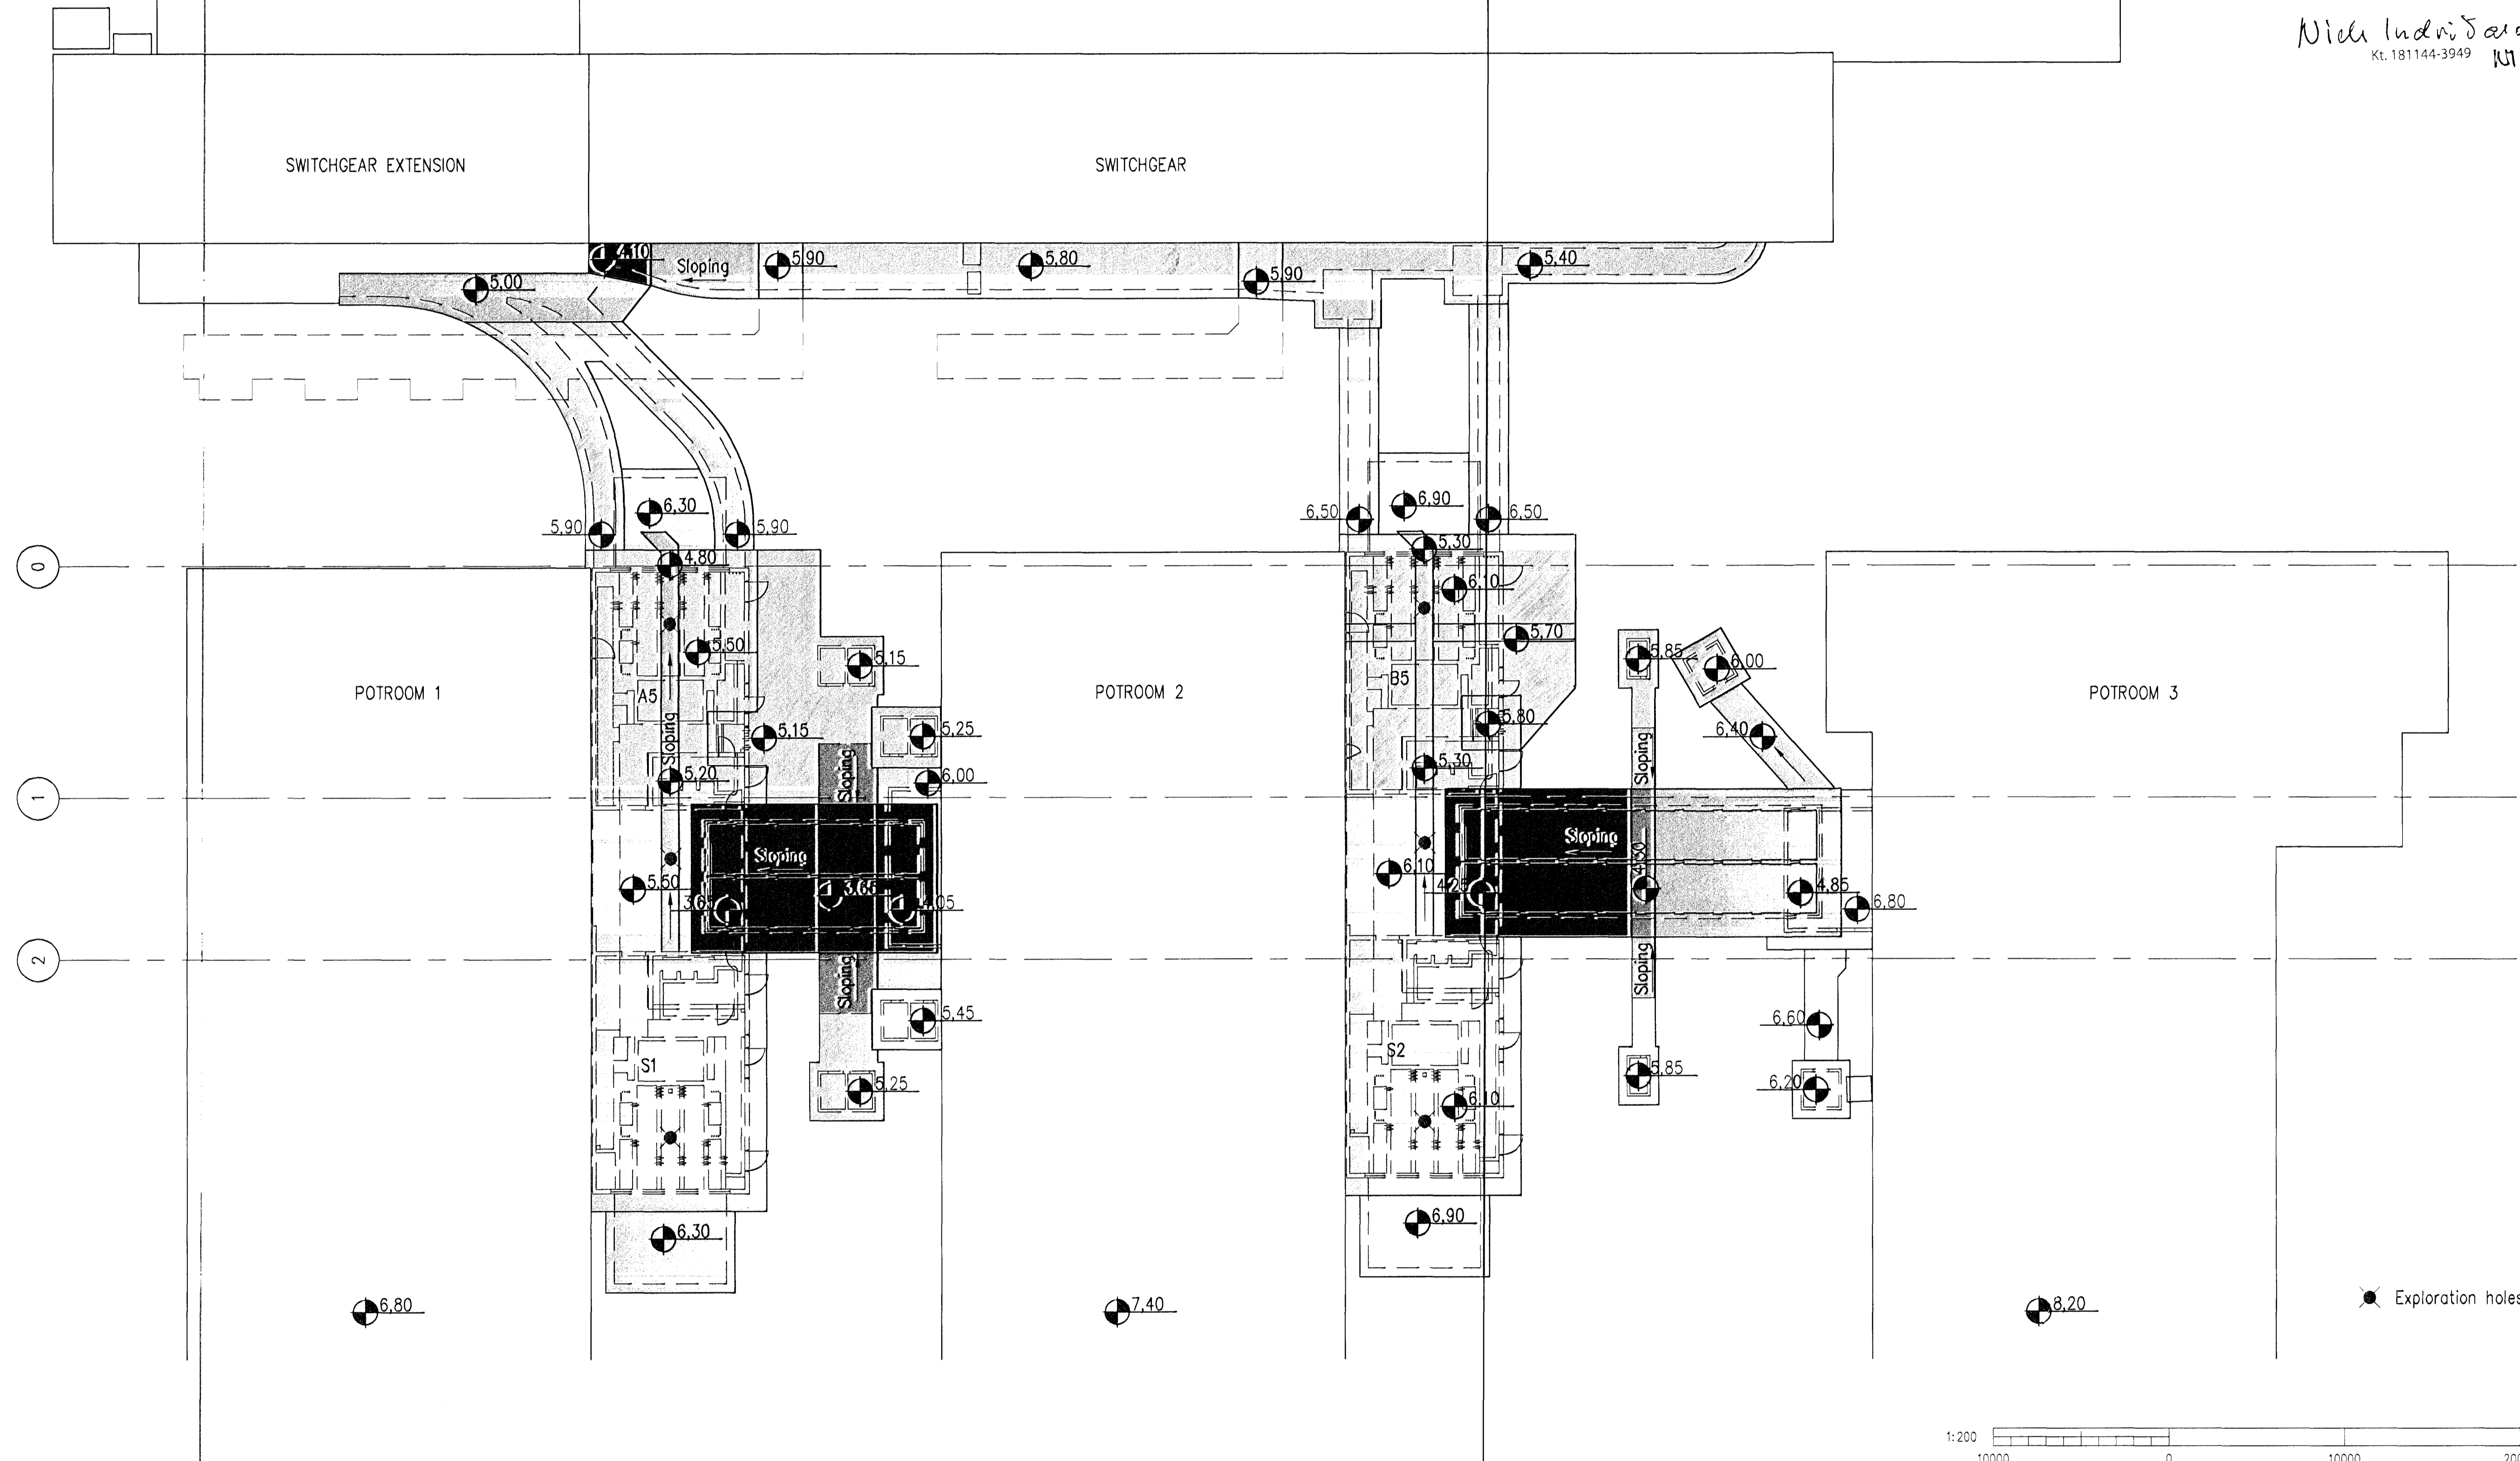

Skýringar
 Legend

Dagsetning / Date	Hor./Tín / Des./Dwg	Yfir / Dkt	Notk. heim / Suppl. Rel	Notk. heim / ISAL Rel
2012.09.12	HS	NI	BS	ISAL
16	Record drawing			

This drawing is the property of Rio Tinto Alcan Iceland Ltd. and handed out for personal use only. It may neither be copied nor made available to others without permission of Rio Tinto Alcan Iceland Ltd. The receiver is liable for any misuse.
 Scale: 1:200
 Dimensions without tolerances according to ISO 2768-1 medium.



Dagsetning / Date	2008.10.01
Hannað / Designed	HS
Tekni / Drawn	LDB
Verttaki / Supplier	HRV
Tekni.nr./verttaka / Supplier drw.no.	IDP-410-C5-015-221
Samþykkt / Approved	NI
Yfir / Chkd	NI
HLÚT af / Part of:	

IPU410-RECTIFIER BUILDINGS
 A5/S1, B5/S2, RECTIFIER BUILDINGS,
 CABLE COND. AND BUSBAR TUNNEL, PLAN

RioTinto Alcan

Flokkur nr. /	Blað nr. /	Næsta bl. nr. /
4011	13982	
Kostn.nr.-Cono. /	Bðn.nr.-Eq.no	
AKS	UB12	
Tekni.nr. ISAL / Drw.no. of ISAL	Breyt./Rev.	
251204	A	