


WELAND GRATING H6 40/3, TOP – PLAN VIEW, 1:50

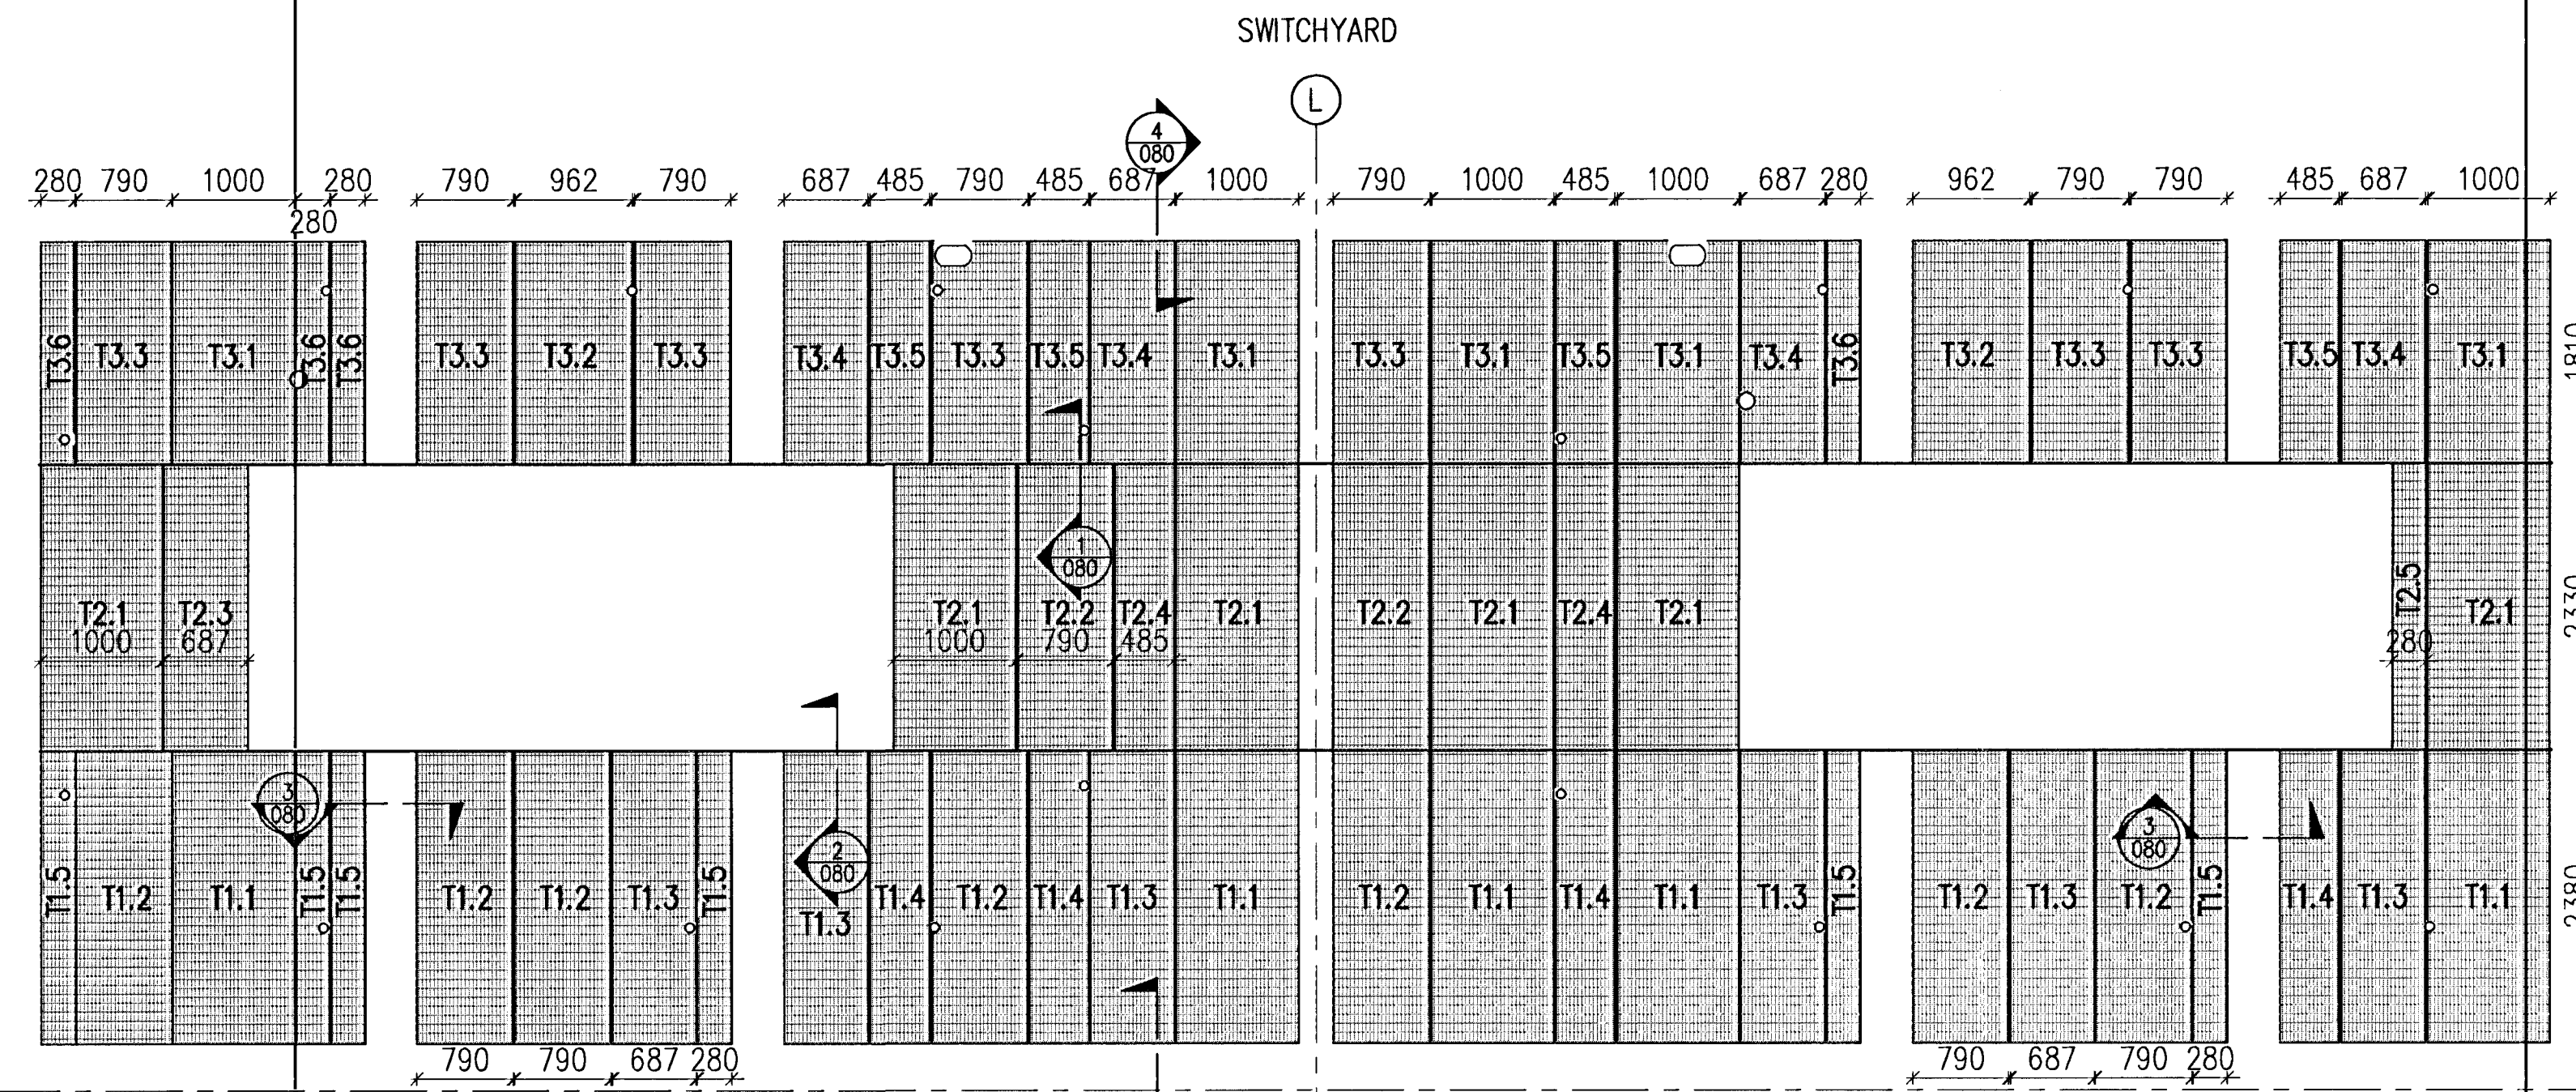


GRATING SIZES – TOP

Nr.	Length	Width	Pcs.	Note
T1.1	2380	1000	5	1 pcs with cutout
T1.2	2380	790	7	2 pcs with cutout
T1.3	2380	687	6	3 pcs with cutout
T1.4	2380	485	4	2 pcs with cutout
T1.5	2380	280	6	2 pcs with cutout
T2.1	2330	1000	6	
T2.2	2330	790	2	
T2.3	2330	687	1	
T2.4	2330	485	2	
T2.5	2330	280	1	
T3.1	1810	1000	5	3 pcs with cutout
T3.2	1810	962	2	1 pcs with cutout
T3.3	1810	790	7	4 pcs with cutout
T3.4	1810	687	4	2 pcs with cutout
T3.5	1810	485	4	3 pcs with cutout
T3.6	1810	280	4	2 pcs with cutout


Nicki Indriðsson
Kt. 181144-3949
NI

WELAND GRATING H6 40/3, BOTTOM – PLAN VIEW, 1:50

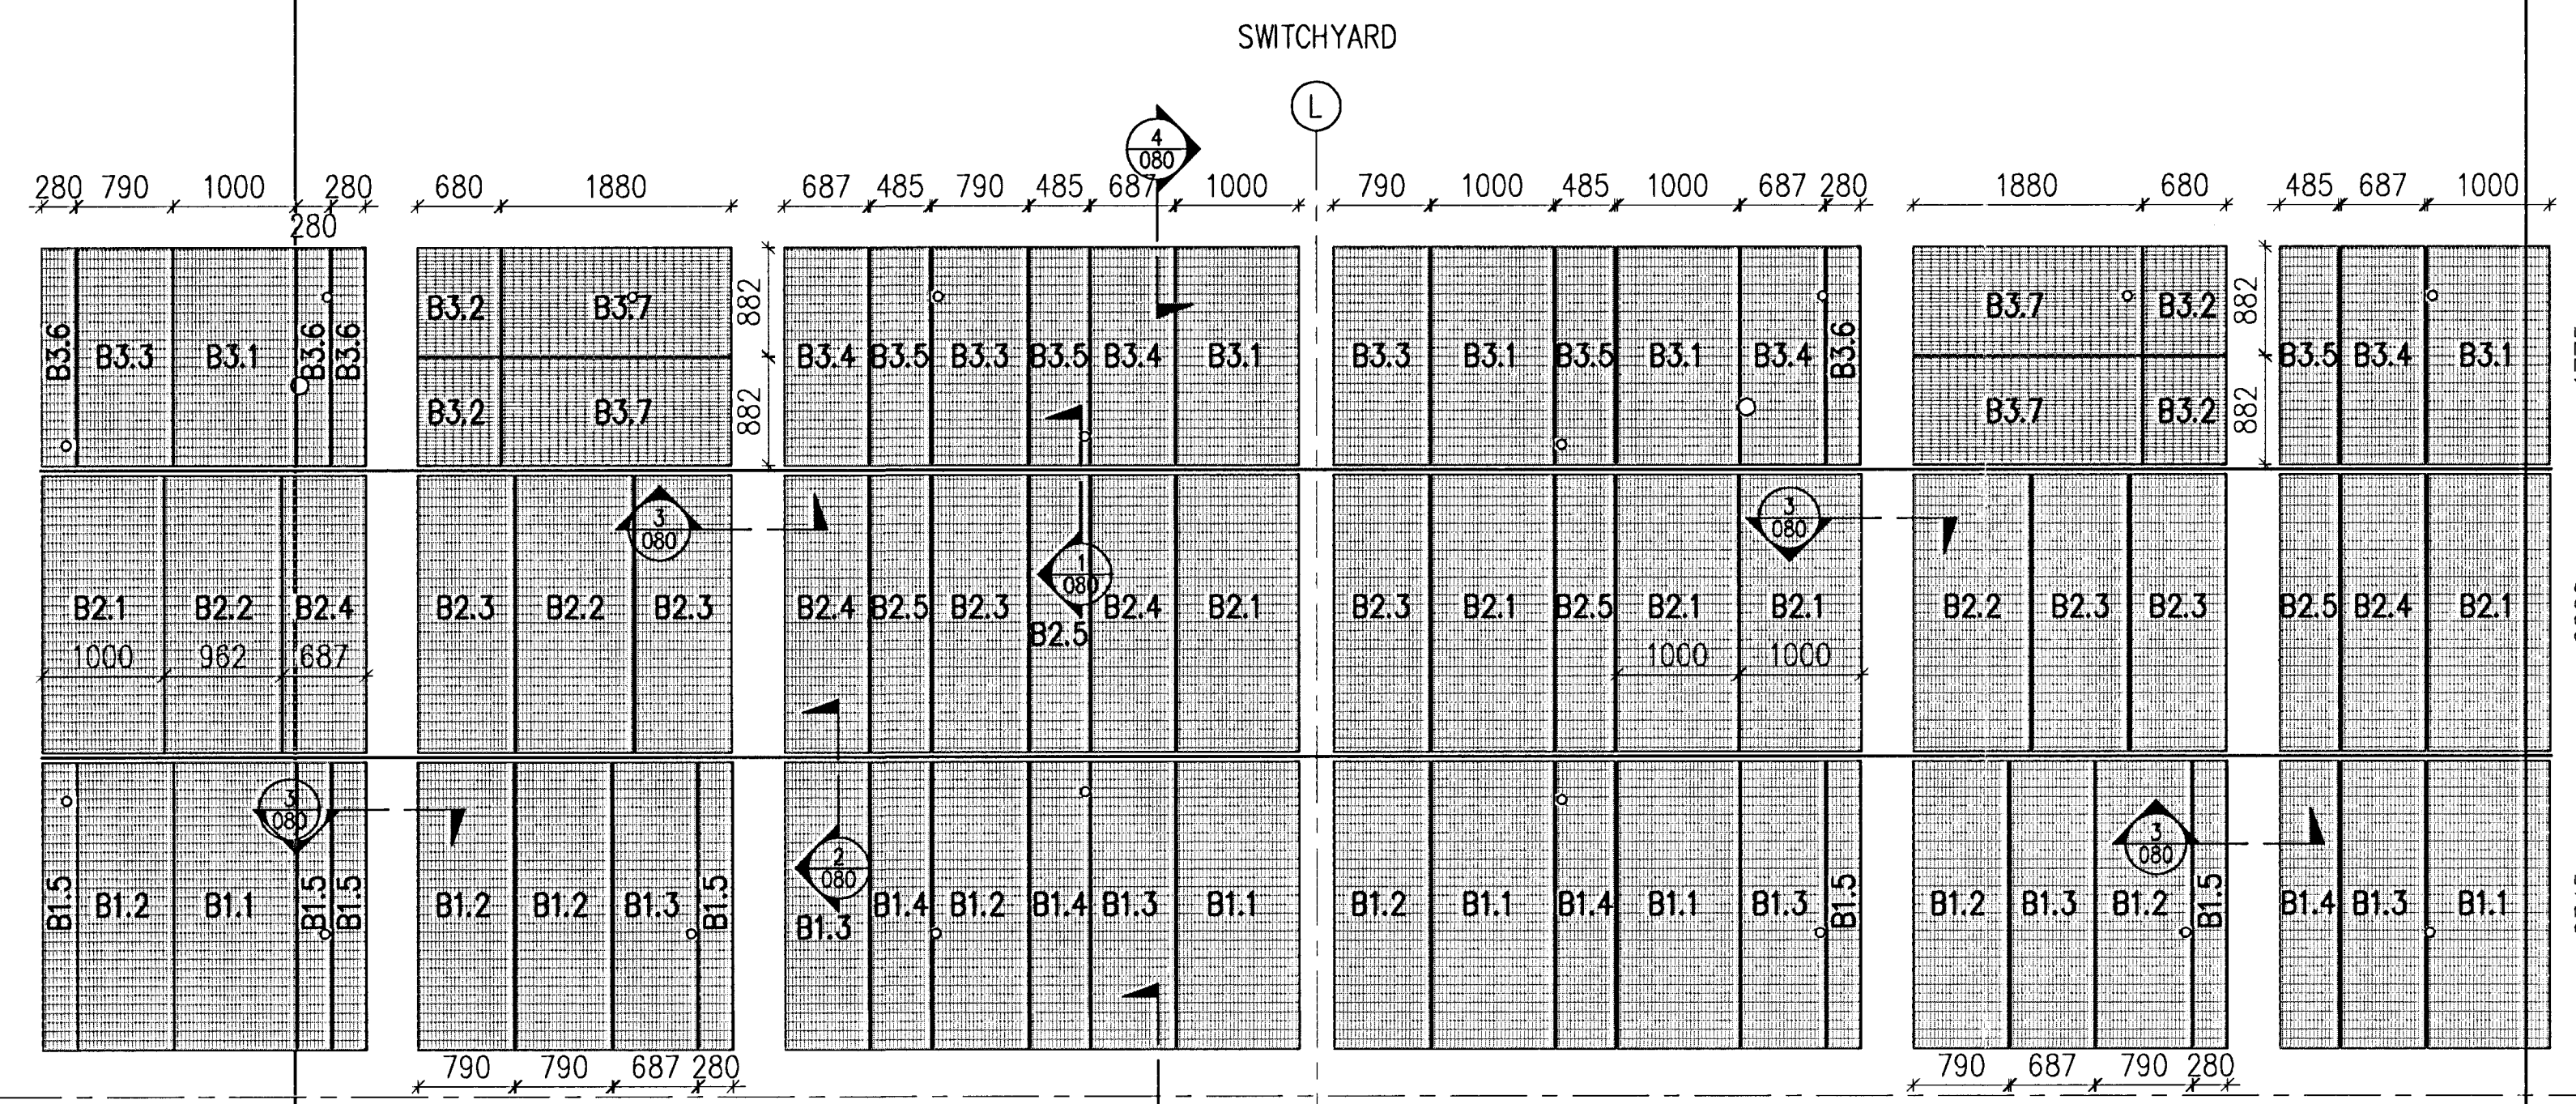

GRATING SIZES – BOTTOM

Nr.	Length	Width	Pcs.	Note
B1.1	2345	1000	5	1 pcs with cutout
B1.2	2345	790	7	2 pcs with cutout
B1.3	2345	687	6	3 pcs with cutout
B1.4	2345	485	4	2 pcs with cutout
B1.5	2345	280	6	2 pcs with cutout
B2.1	2260	1000	6	
B2.2	2260	962	3	
B2.3	2260	790	6	
B2.4	2260	687	4	
B2.5	2260	485	4	
B3.1	1775	1000	5	3 pcs with cutout
B3.2	680	882	4	
B3.3	1775	790	3	1 pcs with cutout
B3.4	1775	687	4	2 pcs with cutout
B3.5	1775	485	4	2 pcs with cutout
B3.6	1775	280	4	2 pcs with cutout
B3.7	1880	882	4	2 pcs with cutout

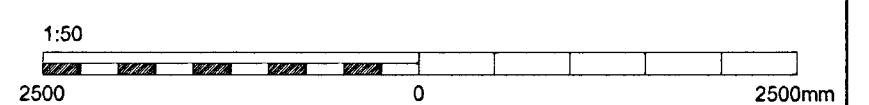

Skýringar: GENERAL NOTES

Legend:
Steel: S235
Bolts: 8.8
All grating, support angles and beams and anchorbolts to be hot dip galvanized, min 80µ.

Grating: Weland H6 40/3 Mesh size 34x75 or similar.
All dimensions shall be checked on site.

C:\IDP\01\IDP\400 - Reduction\410 Substation\Drawings\Civil\IDP-410-ZA-015-081.dwg

Útg nr	Rev no	Lýsing	Útgáfa	Dagsetning	Stofun	Yfir	Notk heim	Notk heim
Útg nr	Rev no	Description	Date	Des/Drw	Scale	Old	Suppl	Rel
2		Record Drawing	2012.07.03	GMG	NI	skg	retr	

This drawing is the property of Rio Tinto Alcan Iceland Ltd. and handed out for personal use only. It may neither be copied nor made available to others without permission of Rio Tinto Alcan Iceland Ltd. The receiver is liable for any misuse.

Scale: 1:50
Dimensions without tolerances according to ISO 2768-1 medium.



Dagsetning / Date	2011.09.14	IPU 410 – SUBSTATION	Flokkur nr.:	Blað nr.:	Nasta bl. nr.:
Hannað / Designed	GMG	220 kV SWITCHYARD BLD.	Kostn.nr.-Cena. /	Bún.nr.-Eq.no	
Verktaki / Supplier	HRV	STEEL GRATING IN OIL PITS, GRATING	4011	01188	
Tekn.nr.verktaka / Supplier drw.no.	IDP-410-ZA-015-081	STRUCUTURAL STEEL	AKS	UB01	
Smbúikt / Approved	NI		Tekn.nr. ISAL / Drw.no. of ISAL	Breyt./Rev.	
Hluti af: / Part of:		Rio Tinto Alcan	251348	A	