


Samþykkt þann
 01 OCT 2012
 Byggingafulltrúinn / Húsnæðing
 Fh. Sigurdur Steinar Jónsson


Nick Indriðsson
 Kt. 181144-3949 NI

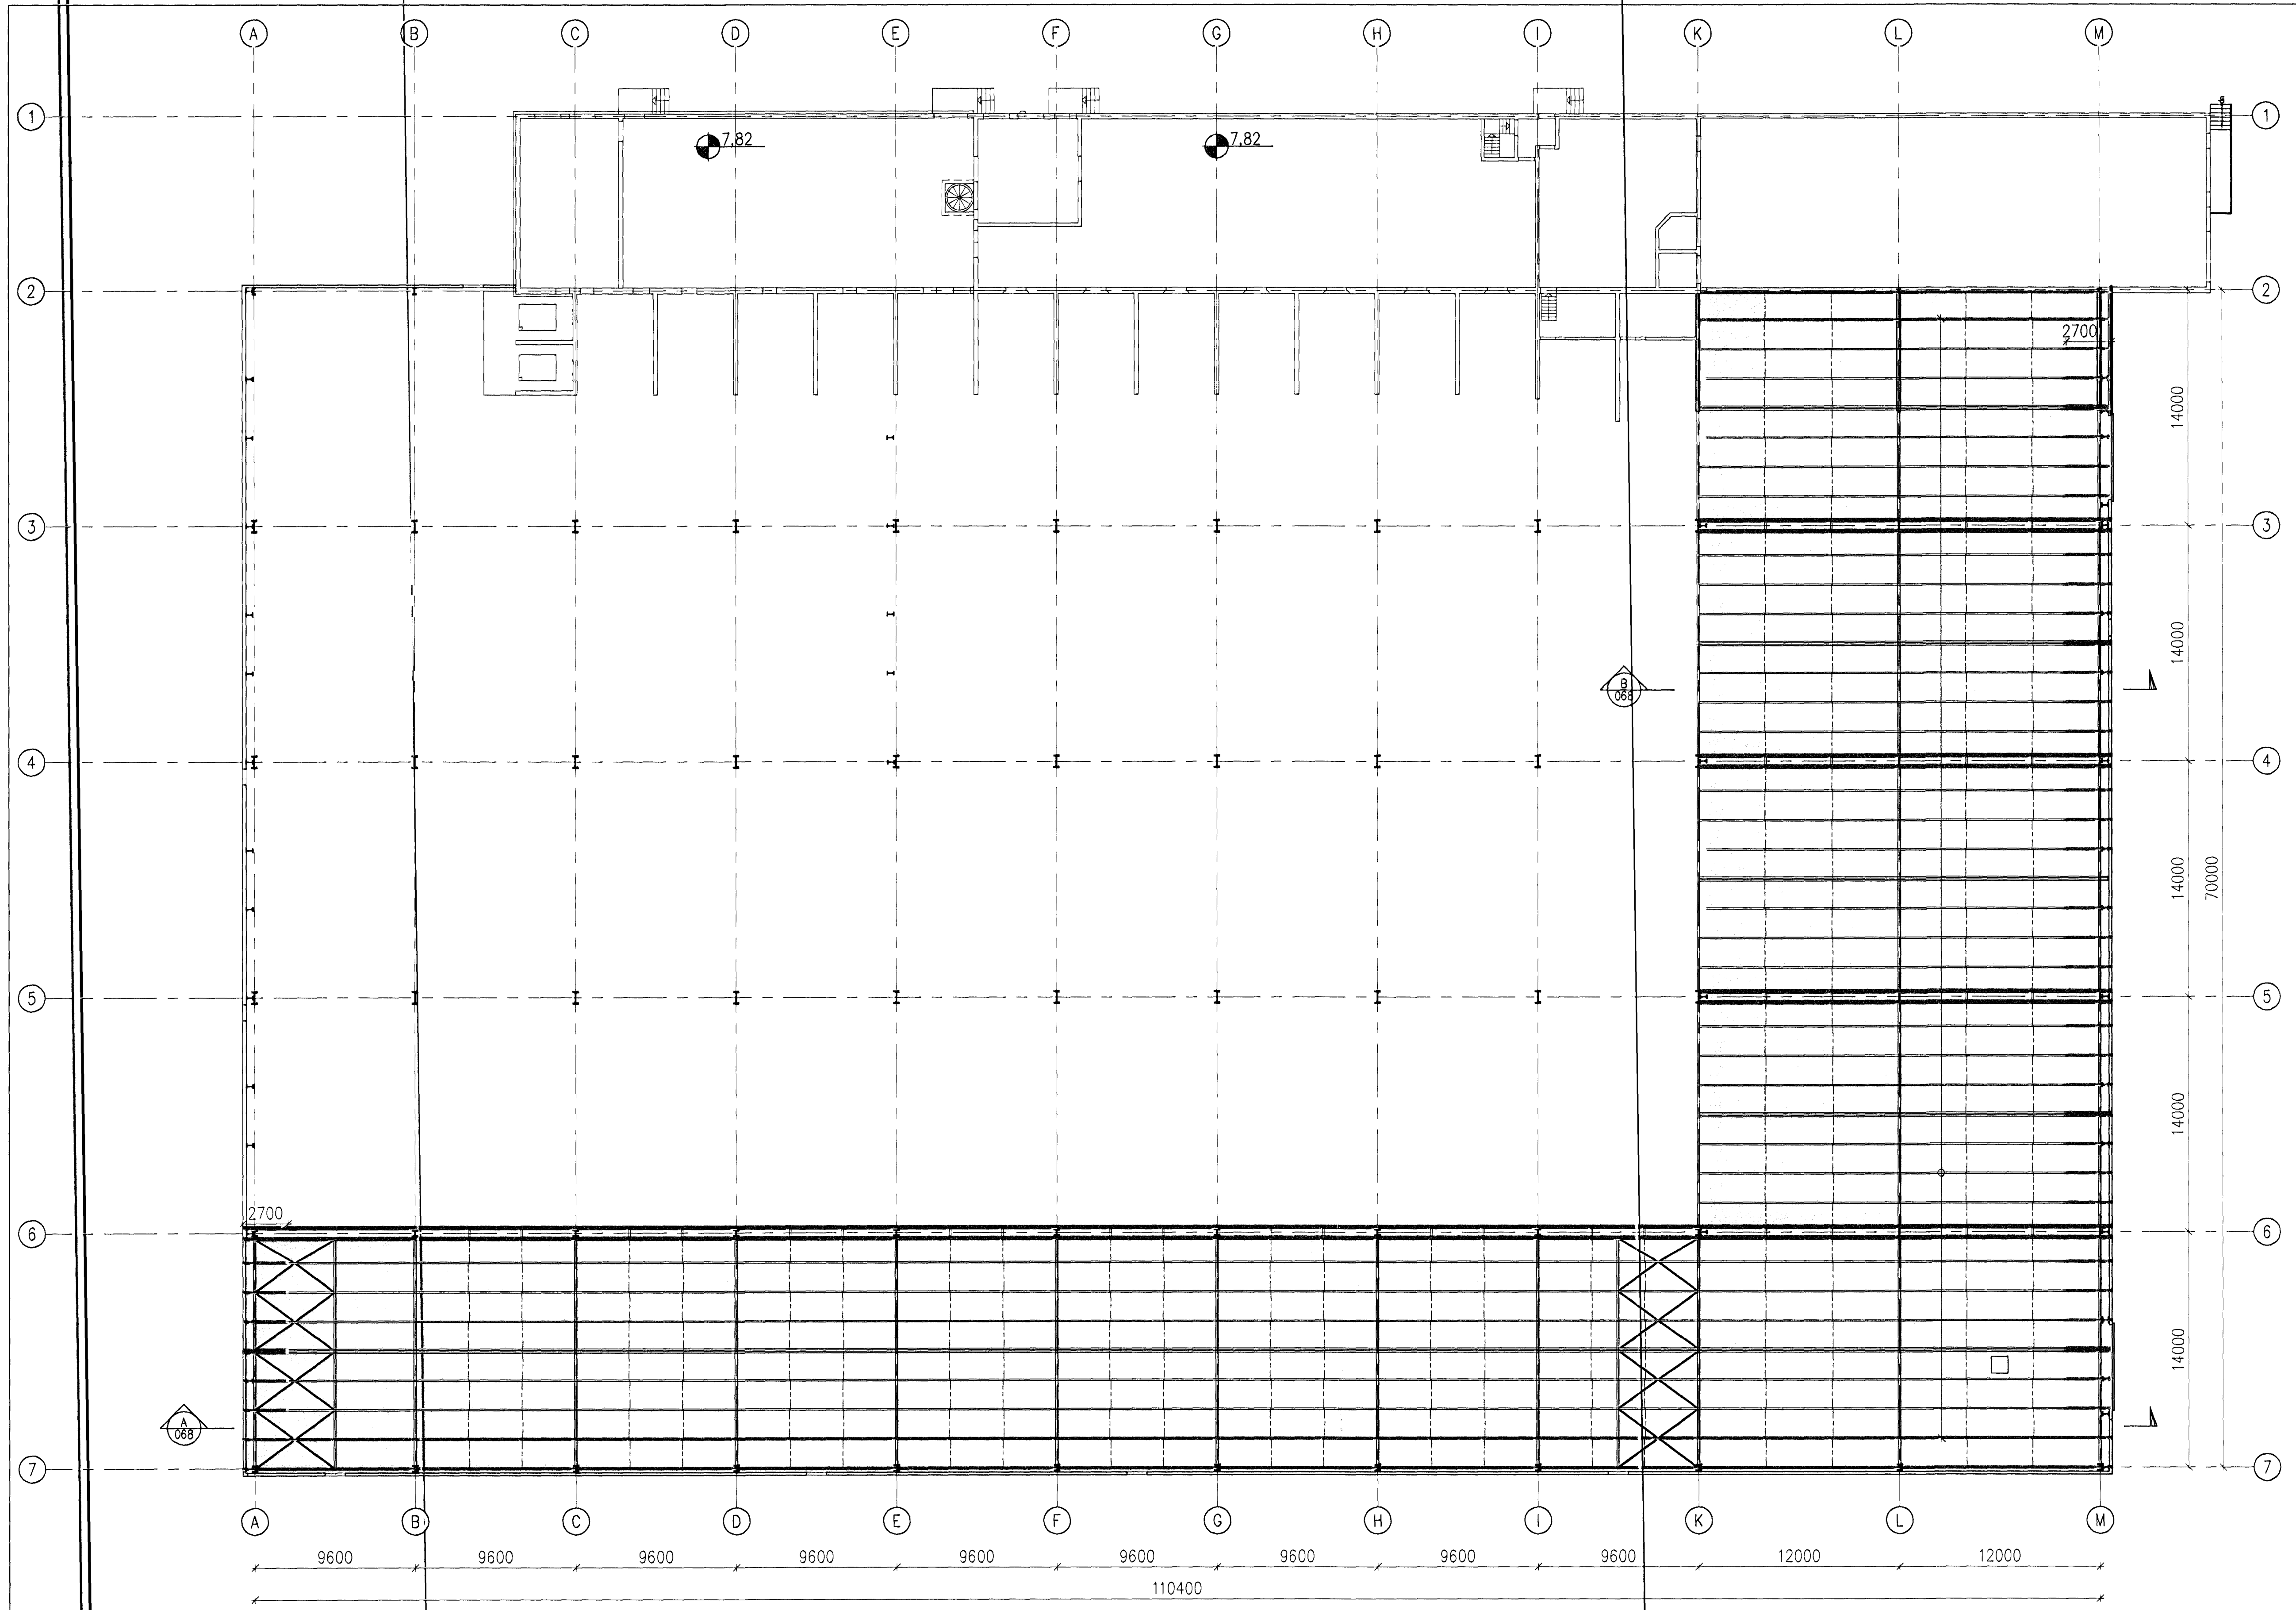

EXTENSION

FASTENING OF CLADDING TO PURLINS
 — c/c160
 — c/c320

RB: Roof beam
 see drw. 067

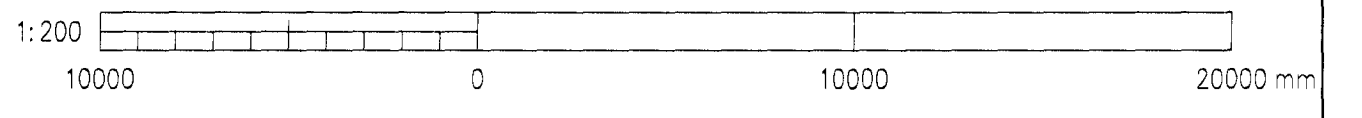

| | | | | | | | | | | | | | | | | | | |
|-----------------------|--|-------------|----------------|-------|---------|----------|-------|-----|------|-----|------|----------------------------------|---------------------------|--|--|---------------------------|----------------------------|---------------------------|
| Skýringar: Legend: | This drawing is the property of Rio Tinto Alcan Iceland Ltd. and is not to be copied or made available to others without permission of Rio Tinto Alcan Iceland Ltd. The receiver is liable for any misuse. | | | | | | | | | | | Dagssetning / Date 2011.01.18 | | IPU 410 - SUBSTATION 220 kV SWITCHYARD BLD. FASTENING OF ROOF CLADDING | | Flökkur nr.: 4011 | Blöð nr.: 01188 | Nasta þinnr.: 01188 |
| | Starf: A1 Skala: 1:200 Mælingar án þolmála samkvæmt ISO 2768-1 medium. | | | | | | | | | | | Tilkennir / Supplier HRV | Tæknir. / Designer LDB | Tæknir. / Supplier HRV | Tæknir. / Supplier IPU-410-ZA-015-072 | Tæknir. / Supplier AKS | Tæknir. / Supplier UB01 | Tæknir. / Supplier AKS |
| 12 | Record Drawing | 2012.06.11 | HS | NI | BS | MS | | | | | | | | | | | | |
| Site no | Rev no | Description | Designing Date | Drawn | Checked | Approved | Suppl | Rel | ISAL | Rel | ISAL | Rel | ISAL | Rel | ISAL | Rel | ISAL | Rel |