


Samþykkt þann  
 01 OCT 2012  
 Byggingafráttirinn / Hólar  
 Fh. Sigurður Steinar Jónsson

Níels Indriðason  
 Kt. 181144-3949 NI

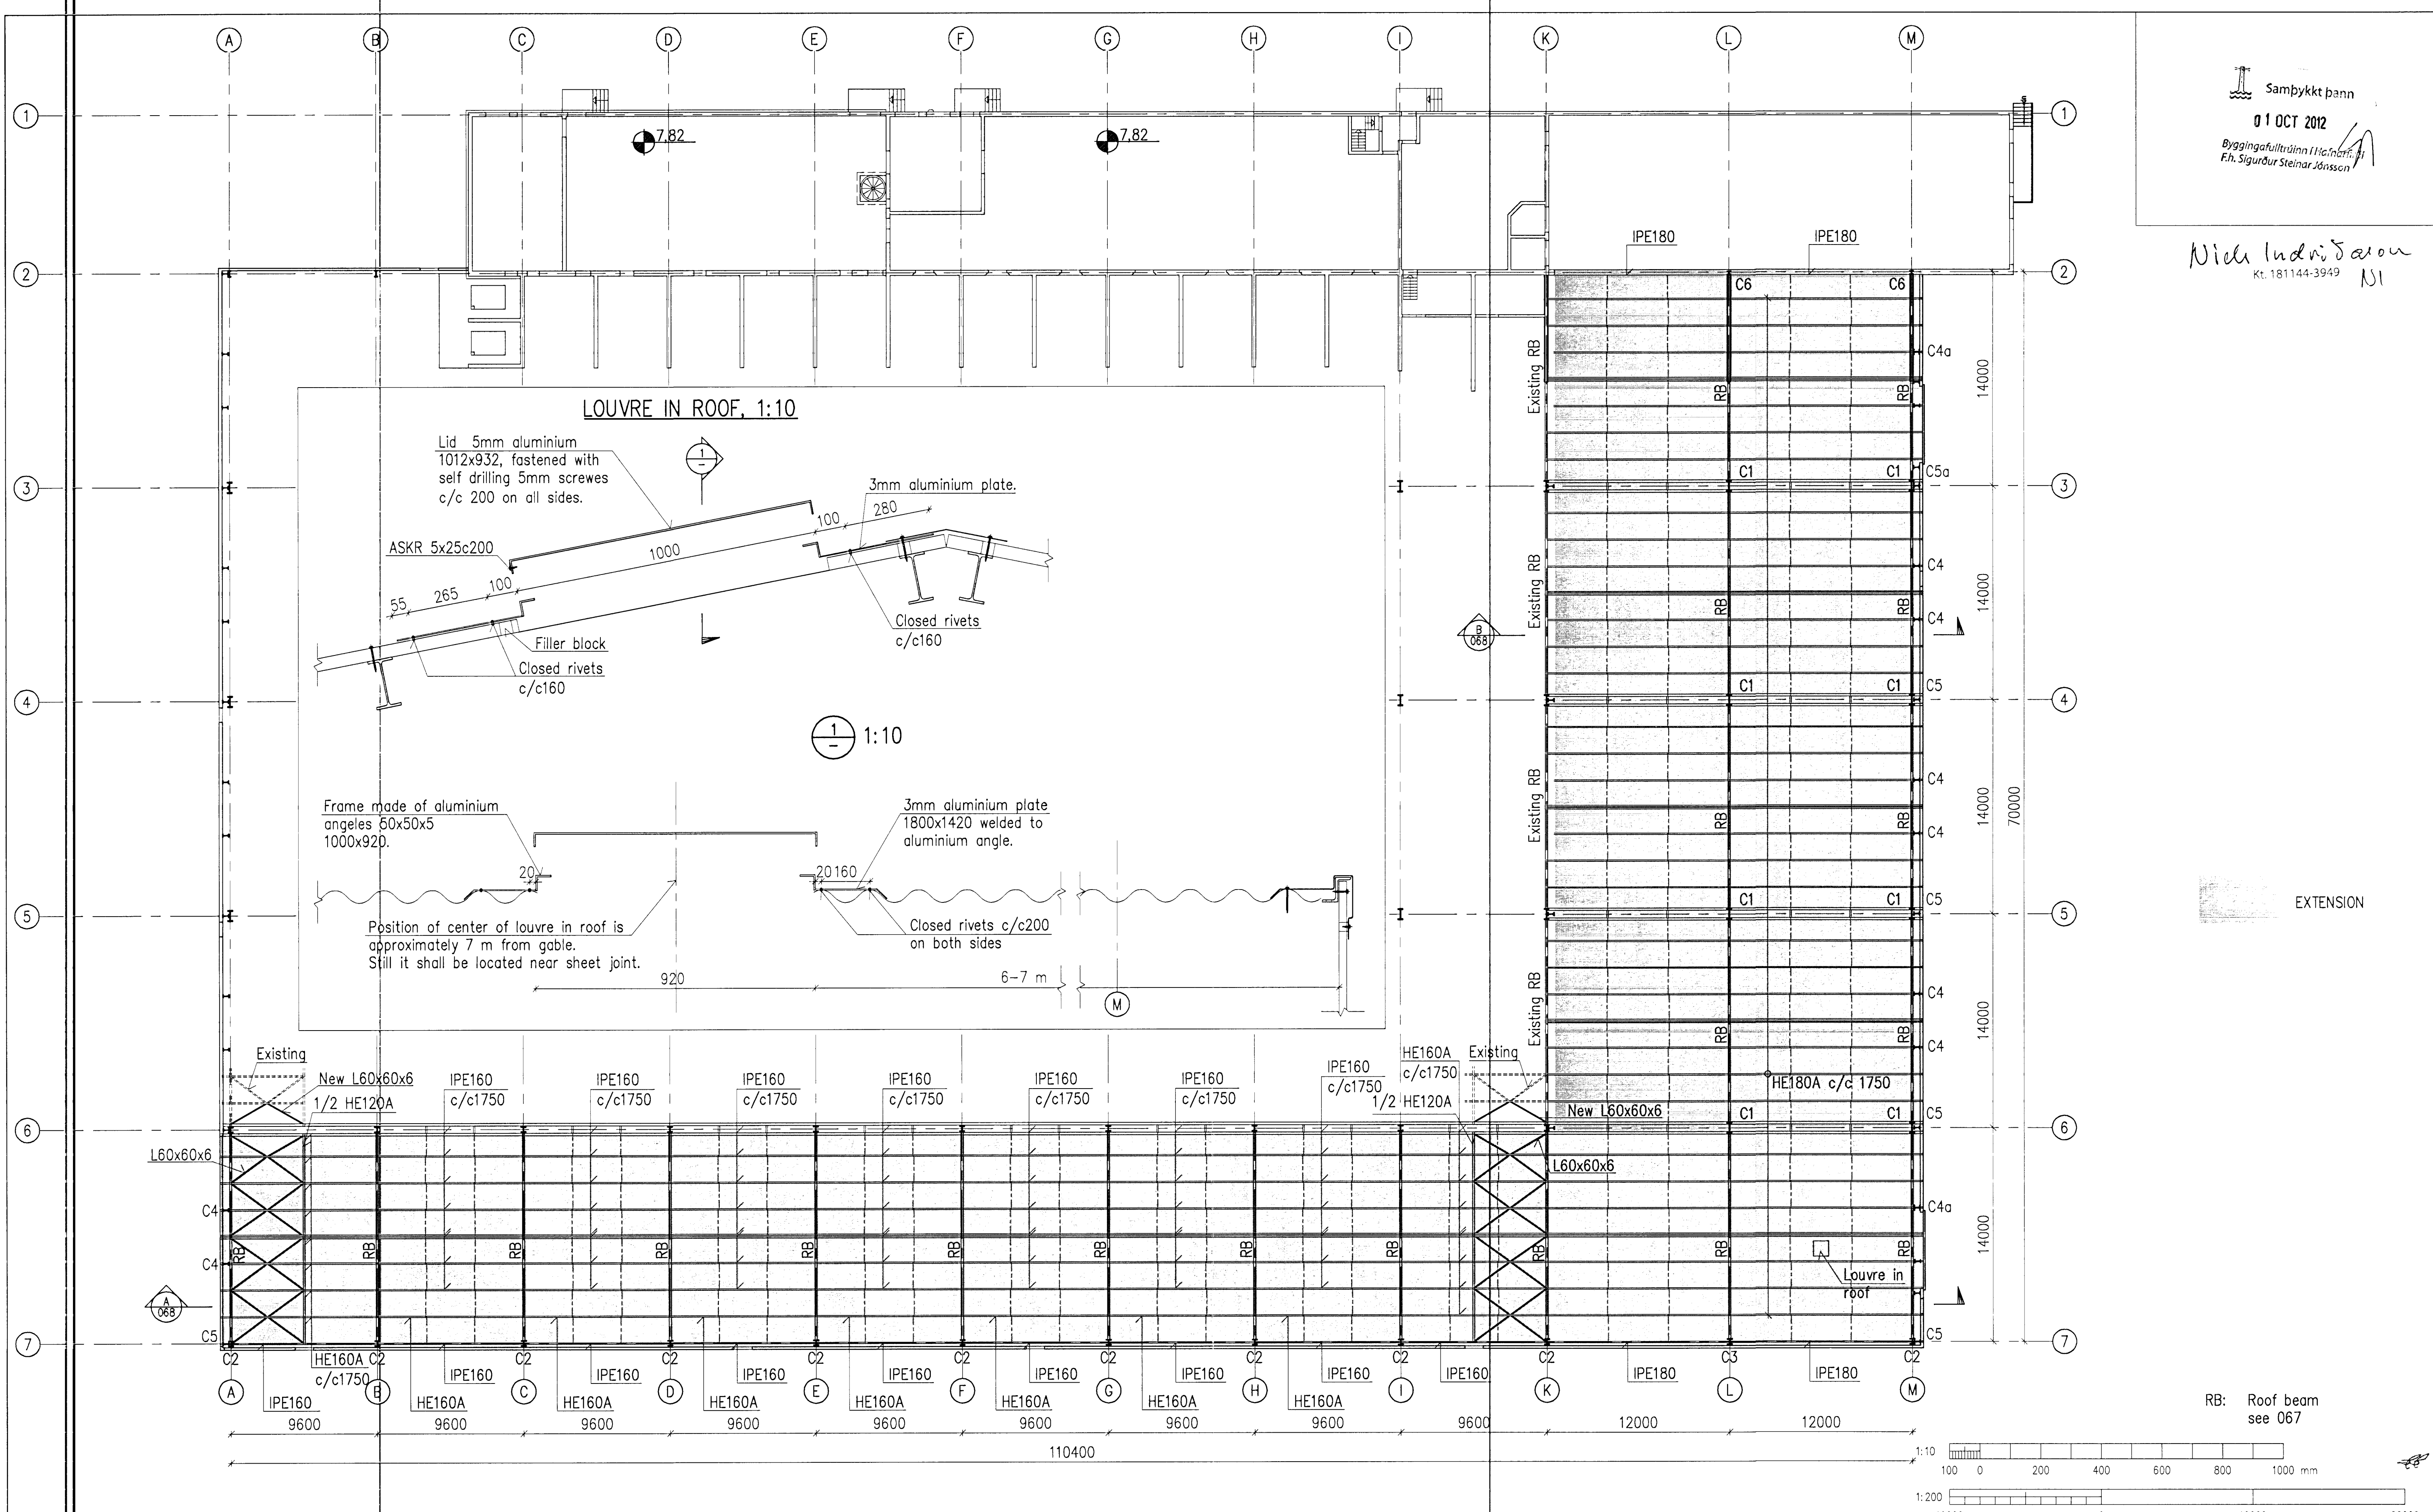

EXTENSION


RB: Roof beam  
 see 067

Skýringar  
 Legend:

15	Record Drawing	2012.06.11	HS	NI	HS	NI	HS
Útg nr	Rev no	Lýsing	Description	Dagsetning	Date	Har/fin	Des/Drw

This drawing is the property of Rio Tinto Alcan Iceland Ltd. and is loaned out for personal use only. It may neither be copied nor made available to others without permission of Rio Tinto Alcan Iceland Ltd. The receiver is liable for any misuse.

Scale: 1:10/200  
 Dimensions without tolerances according to ISO 2768-1 medium.

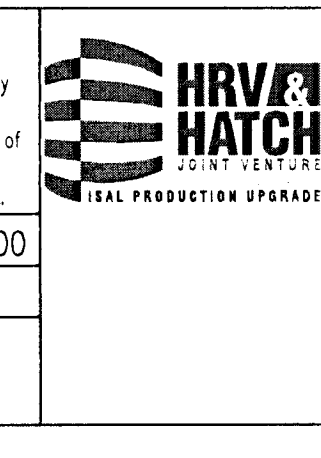

Dagsetning / Date: 2008.10.01  
 Hannað / Designed: HS  
 Tækn / Drawn: LDB  
 Verktaki / Supplier: HRV  
 Tækn.nr.verktaka / Supplier drw.no: IDP-410-ZA-015-061  
 Samþykkt / Approved: NI  
 Flúti of: / Part of:

IPU 410 - SUBSTATION 220 kV SWITCHYARD BLD. COLUMNS, BEAMS & PURLINS, PLAN VIEW		Flökkur nr.: 4011	Bláð nr.: 01188	Nasta bl.nr.:
STRUCUTURAL STEEL		AKS UB01		
RioTintoAlcan		Tækn.nr. ISAL /Drw.no of ISAL: 251332		
ISAL Yfirfarð og skrúð, dags / ISAL Checked, date		ISAL Samþykkt, dags / ISAL Approved, date		